

CITY OF ALBUQUERQUE

Planning Department
Alan Varela, Director



Mayor Timothy M. Keller

October 2, 2025

David Soule, PE
Rio Grande Engineering
PO Box 93924
Albuquerque, NM 87199

**RE: Lot 14 Block 5 Unit 19 SAD 228
6505 Azor Rd. NW
Volcano Cliffs Subdivision
Grading and Drainage Plan
Engineers Stamp Date 6/12/2024 (D10D003H14)
Pad Certification 12/21/2024
CO Certification Date: 9/24/2025**

PO Box 1293

Mr. Soule,

Albuquerque

Based on the Certification received on 9/24/2025, the site is acceptable for release of Certificate of Occupancy by Hydrology.

NM 87103

If you have any questions, you can contact me at 924-3695 or Rudy Rael at 924-3977.

www.cabq.gov

Sincerely,

Tiequan Chen, P.E.
Principal Engineer, Hydrology
Planning Department, Development Review Services

RR/TC
C: File D10D003H14

Weighted E Method

Basin	Area (sf)	Area (acres)	Treatment				100-Year, 6-hr.			24 hour Volume (ac-ft)
			Treatment A (% acres)	Treatment B (% acres)	Treatment C (% acres)	Treatment D (% acres)	Weighted E (ac-ft)	Volume (ac-ft)	Flow cfs	
ALLOWED	12171.00	0.279	0%	24%	40%	36%	1.362	0.032	0.88	0.038
PROPOSED	12171.00	0.279	0%	22%	43%	35%	1.353	0.032	0.88	0.038
COMPARISON										0.000

Equations:

Weighted E = Ea*Aa + Eb*Ab + Ec*Ac + Ed*Ad / (Total Area)

Volume = Weighted E * Total Area

Flow = Qa * Aa + Qb * Ab + Qc * Ac + Qd * Ad

Where for 100-year, 6-hour storm- zone 1

Ea= 0.55	Qa= 1.54
Eb= 0.73	Qb= 2.16
Ec= 0.95	Qc= 2.87
Ed= 2.24	Qd= 4.12

ONSITE Conditions

FIRST FLUSH WATER QUALITY VOLUME	REQUIRED (CF)	PROVIDED (CF)
WATER QUALITY FLOOD CONTROL	0	0

Narrative


This site is within the SAD 228 Master Drainage plan boundaries. The site is to maintain existing patterns and drain to the adjacent roadway to the south per the master drainage plan. The site does conform to the SAD 227 developed conditions assumptions, therefore ponding is not required. Due to clear sign of rock we have kept the pad as high as possible to avoid the rock. All flows generated drains to street. This plan is in conformance to the master drainage plan

I, DAVID SOULE HAVE PERSONALLY INSPECTED THE SITE. I HEREBY CERTIFY THE PAD HAS BEEN CONSTRUCTED SUCH THAT IT IS IN SUBSTANTIAL CONFORMANCE TO THE APPROVED GRADING PLAN DATED BASED UPON APPROVAL FROM DESIGN ENGINEER THE PAD HAS BEEN CONSTRUCTED 12" HIGHER. THE DRAINAGE CONCEPT HAS NOT CHANGED. I CERTIFY THE PAD IS AT A GRADE THAT CONFORMS TO THE APPROVED PLAN AND ACCEPTABLE FOR RELEASE OF BUILDING PERMIT




EROSION CONTROL NOTES:

- CONTRACTOR IS RESPONSIBLE FOR OBTAINING A TOPSOIL DISTURBANCE PERMIT PRIOR TO BEGINNING WORK.
- CONTRACTOR IS RESPONSIBLE FOR MAINTAINING RUN-OFF ON SITE DURING CONSTRUCTION.
- CONTRACTOR IS RESPONSIBLE FOR CLEANING ALL SEDIMENT THAT GETS INTO EXISTING RIGHT-OF-WAY.
- REPAIR OF DAMAGED FACILITIES AND CLEANUP OF SEDIMENT ACCUMULATIONS ON ADJACENT PROPERTIES AND IN PUBLIC FACILITIES IS THE RESPONSIBILITY OF THE CONTRACTOR.
- ALL EXPOSED EARTH SURFACES MUST BE PROTECTED FROM WIND AND WATER EROSION PRIOR TO FINAL ACCEPTANCE OF ANY PROJECT.

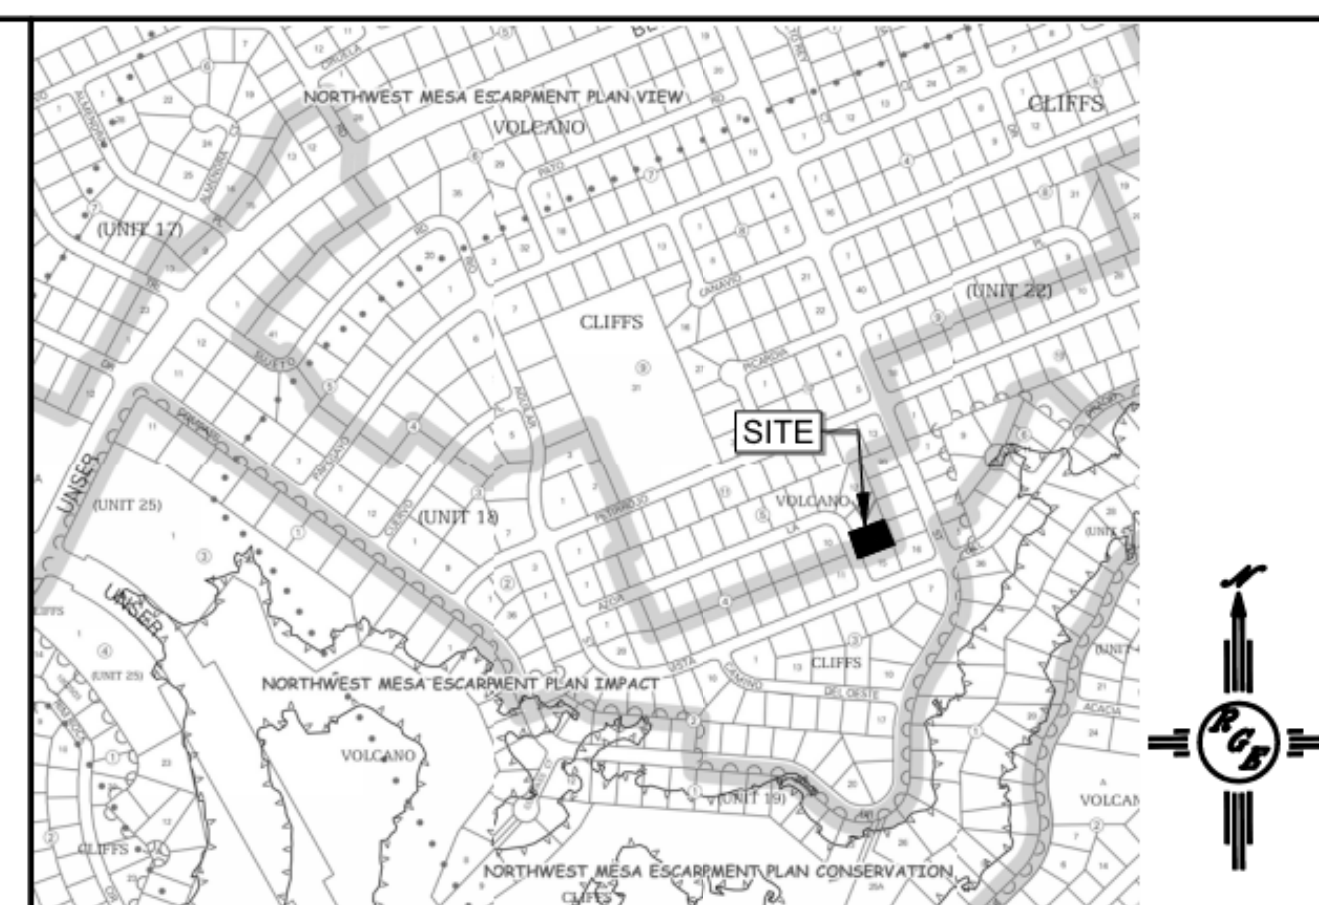

VICINITY MAP:

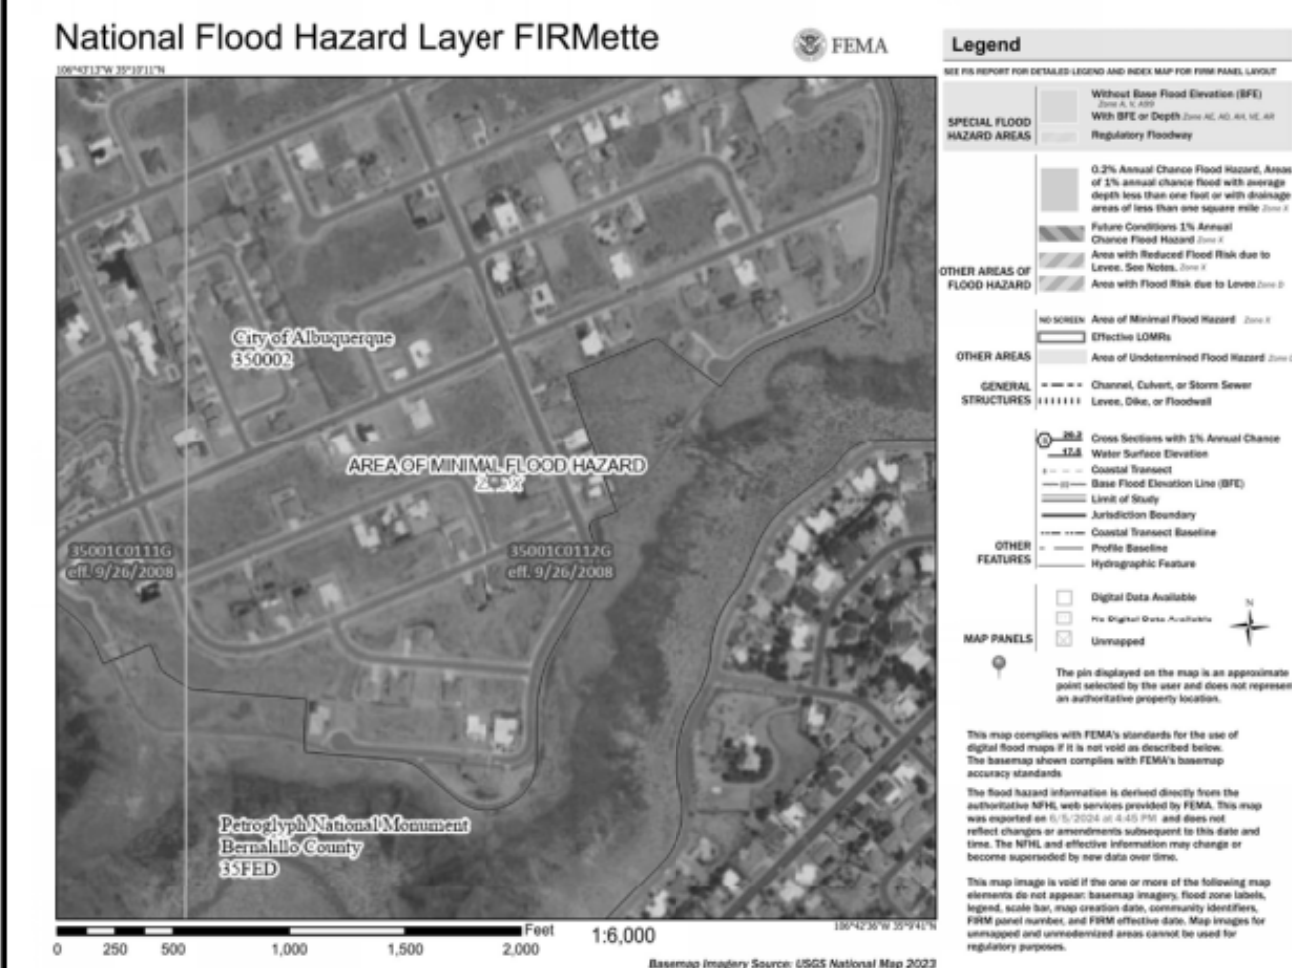

FIRM MAP:

LEGAL DESCRIPTION:

LOT 14 BLOCK 5 VOLCANO CLIFFS UNIT 19

NOTES:

- ALL SPOT ELEVATIONS REPRESENT FLOWLINE ELEVATION UNLESS OTHERWISE NOTED.
- ALL SLOPES SHALL BE 3:1 MAX. AND GRAVEL OR NATIVE SEEDING PRIOR TO CO.
- ANY PERIMETER WALLS MUST BE PERMITTED SEPARATELY ALL RETAINING WALL DESIGN SHALL BE BY OTHERS.
- SURVEY INFORMATION PROVIDED BY COMMUNITY SCIENCES CORPORATION USING NAVD DATUM 1988.
- LONG TERM MAINTAINANCE OF ALL PONDS, SWALES AND OVERFLOWS IS REQUIRED
- A PAD ELEVATION CERTIFICATION SHALL BE REQUIRED PRIOR TO RELEASE OF BUILDING PERMIT.


LEGEND

---XXXX---	EXISTING CONTOUR
.....XXXX.....	EXISTING INDEX CONTOUR
-----XXXX-----	PROPOSED CONTOUR
-----XXXX-----	PROPOSED INDEX CONTOUR
•XXXX	EXISTING SPOT ELEVATION
●XXXX	PROPOSED SPOT ELEVATION
---	BOUNDARY
---	ADJACENT BOUNDARY
=====	EXISTING CURB AND GUTTER
----->	PROPOSED EARTHEN SWALE
----->	PROPOSED RETAINING WALL
[Hatched]	PROPOSED GRAVEL
[Dotted]	PROPOSED CONCRETE
[Cobble]	PROPOSED 2' WIDE COBBLE SWALE

I David Soule, NMPE 14522, of the firm Rio Grande Engineering hereby certify that this project has been graded and will drain in substantial compliance with and in accordance with the design intend of the approved plan dated 6/4/24 The certification is submitted in support of a request for CERTIFICATE OR OCCUPANCY. The record information presented heron is not necessarily complete and intended only to verify substantial compliance of the grading and drainage aspects of this project.



9/24/25

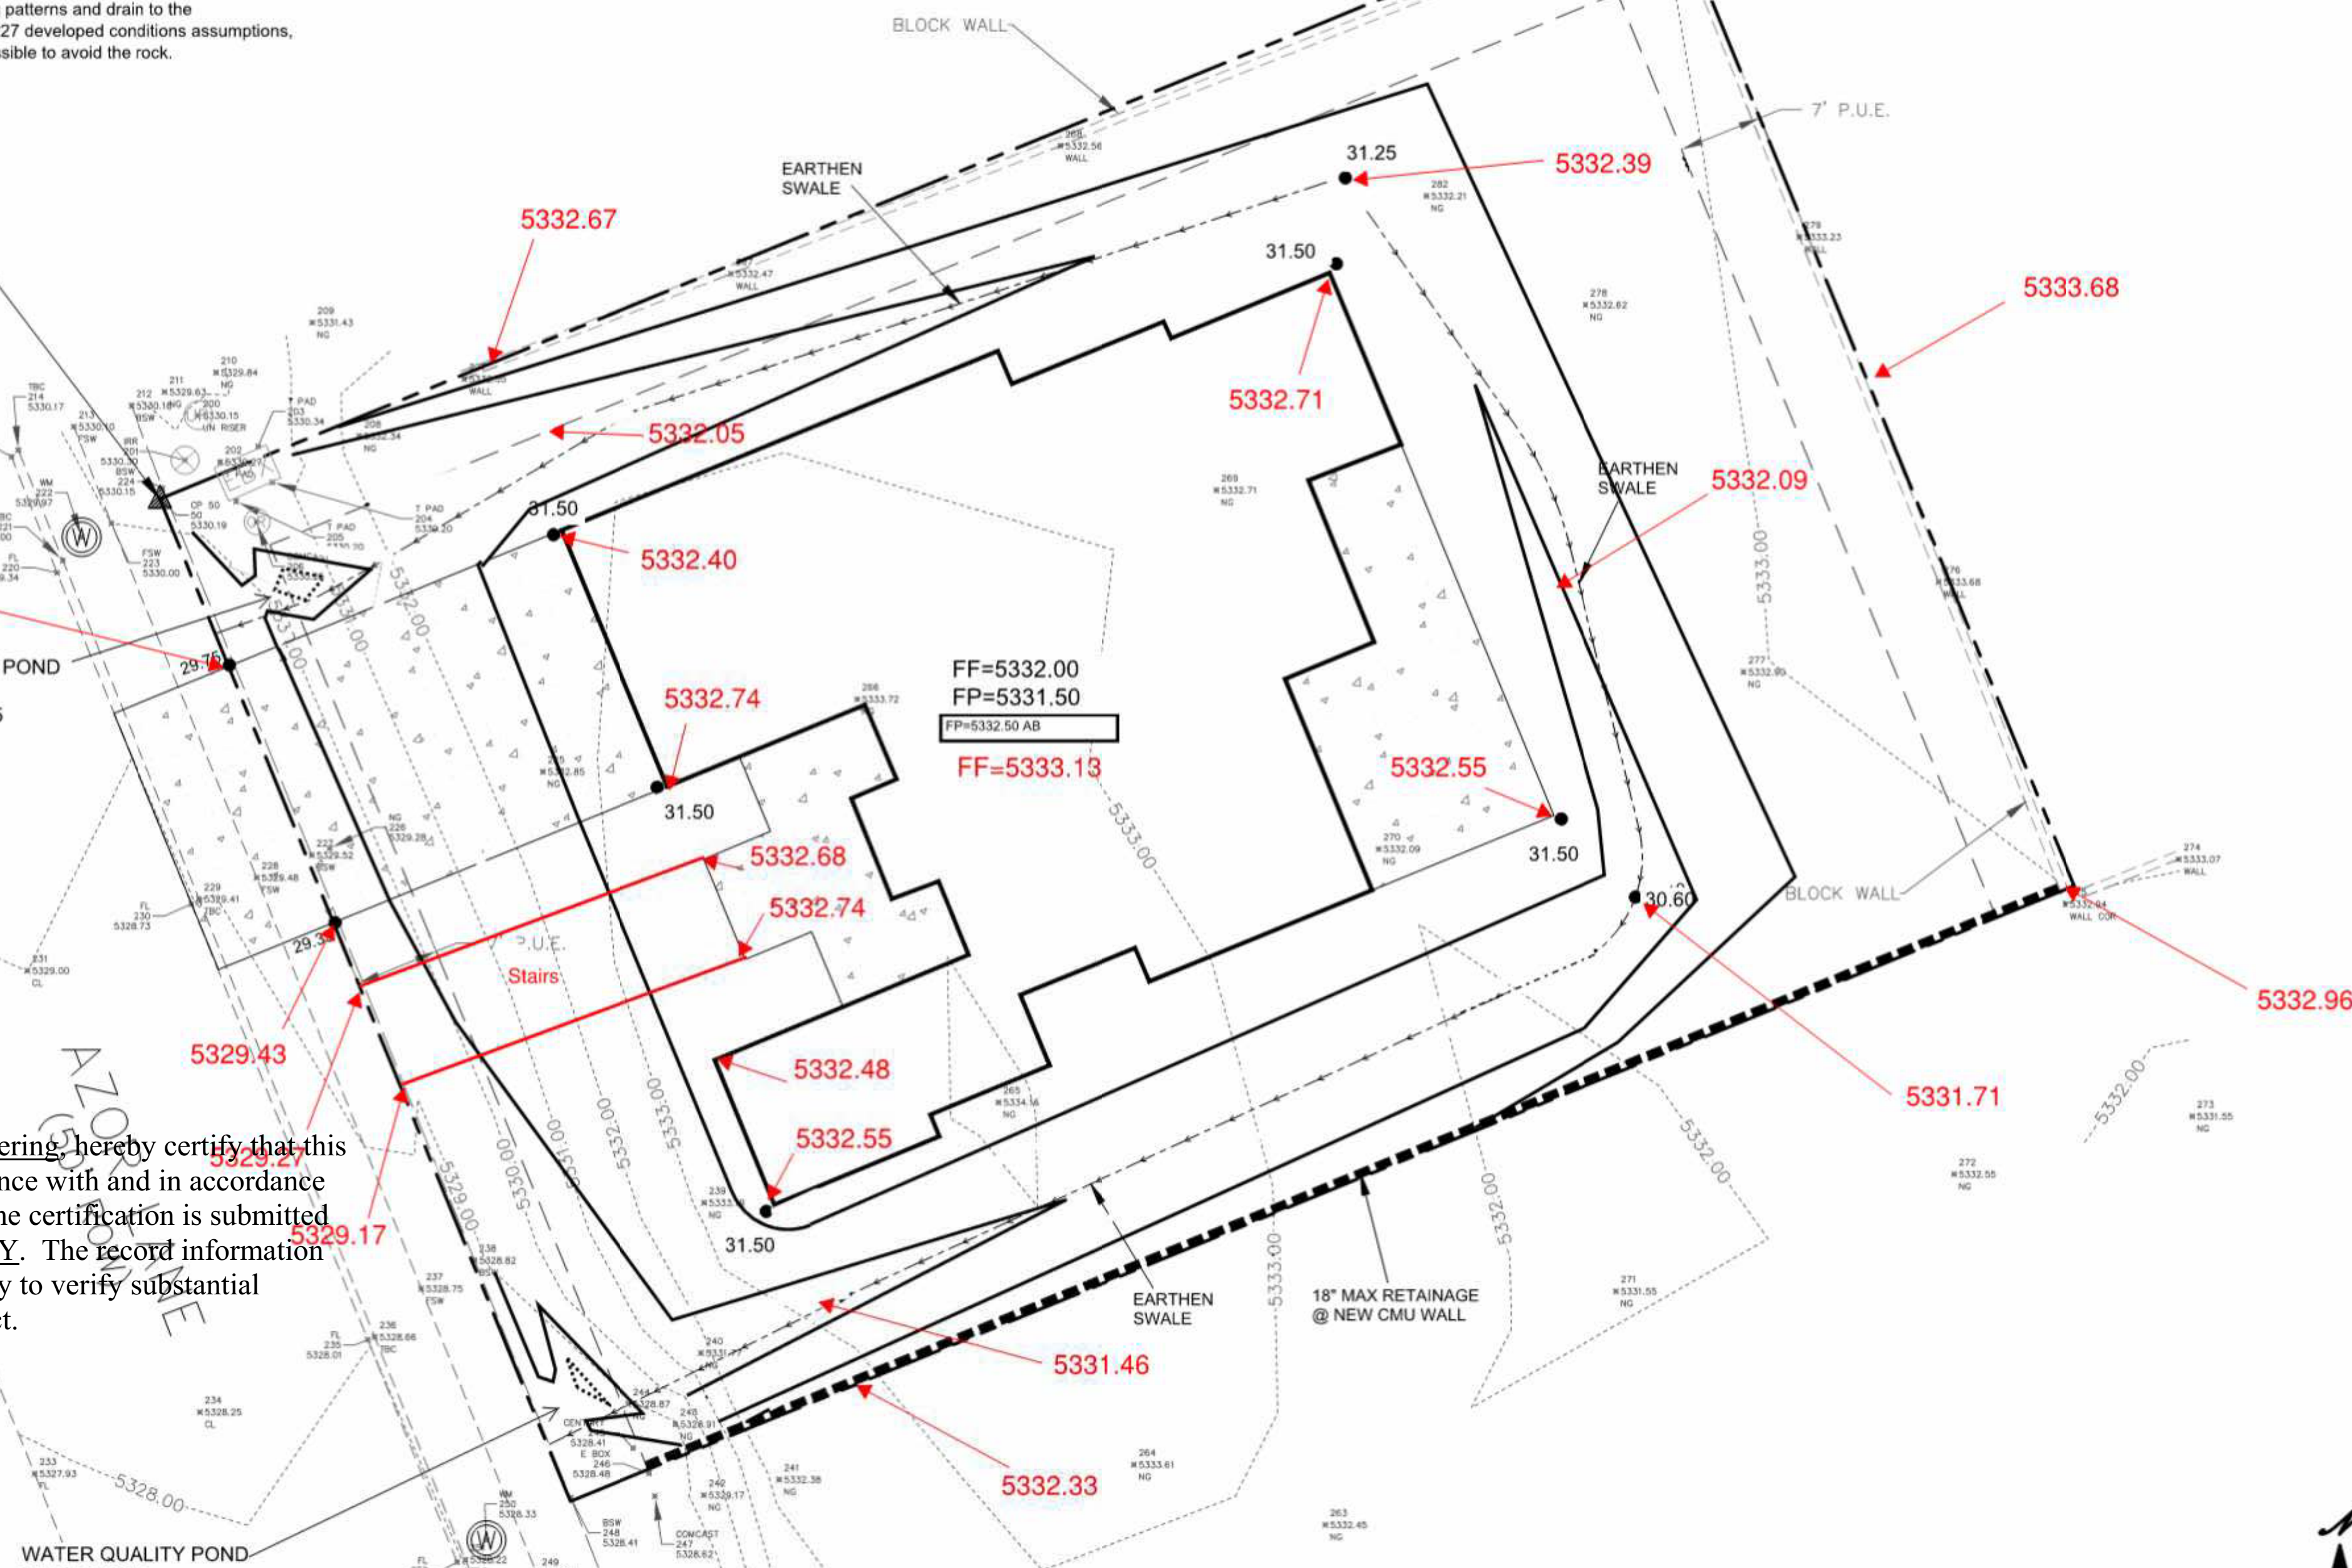

WATER QUALITY POND
TOP=5528.75
BOTTOM=5528.25
VOLUME= 13 CF

WATER QUALITY POND
TOP=5529.75
BOTTOM=5529.25
VOLUME= 12 CF


"ASBUILT"




9/24/2025

DATE:

CONSTRUCT ALL SWALES AND EROSION PROTECTION (SHOWN HATCHED) BELOW ADJACENT GRADE TO ENSURE RUNOFF CAN BE CAPTURED AND CONVEYED PROPERLY.

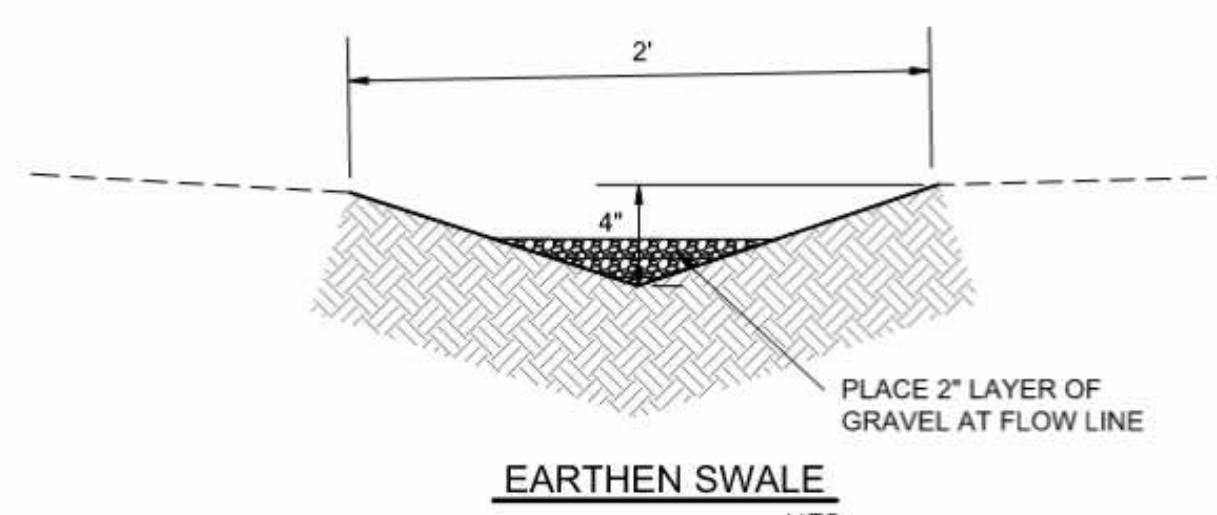

EARTHEN SWALE
NTS

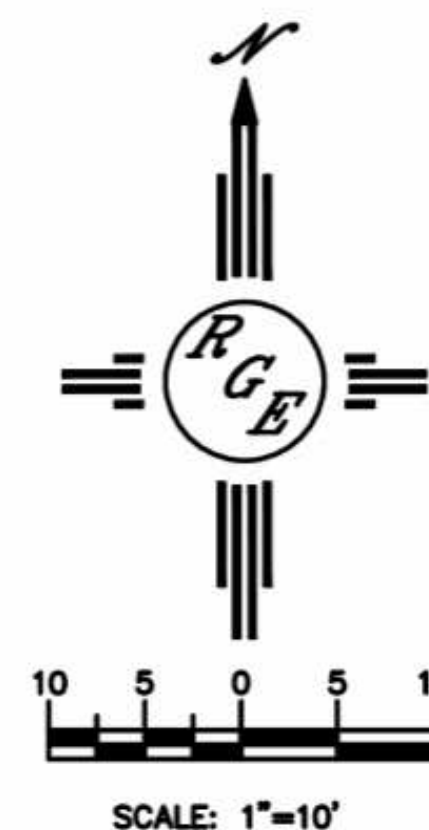

CAUTION:

EXISTING UTILITIES ARE NOT SHOWN. IT SHALL BE THE SOLE RESPONSIBILITY OF THE CONTRACTOR TO CONDUCT ALL NECESSARY FIELD INVESTIGATIONS PRIOR TO ANY EXCAVATION TO DETERMINE THE ACTUAL LOCATION OF UTILITIES & OTHER IMPROVEMENTS.

ENGINEER'S SEAL DAVID SOULE NEW MEXICO 14522 REGISTERED PROFESSIONAL ENGINEER 6/12/24	LOT 14 BLK 5 U 19 VC 6505 AZOR LANE GRADING AND DRAINAGE PLAN Rio Grande Engineering PO BOX 93924 ALBUQUERQUE, NM 87199 (505) 321-9009	DRAWN BY DEM DATE 6-6-24 Lot 14 Blk 5 U 19 VC.DWG SHEET # C1 JOB #
--	--	--