

CITY OF ALBUQUERQUE

Planning Department
Alan Varela, Director



Mayor Timothy M. Keller

January 12, 2023

Jackie McDowell, PE
McDowell Engineering, Inc.
7820 Beverly Hills Ave NE
Albuquerque, NM 87121

**RE: Lot 2 Block 9 Unit 20, S.A.D. 228
Volcano Cliffs Subdivision
6605 Petirrojo Dr. NW
Grading and Drainage Plan
Engineers Stamp Date 12/20/2022
Certificate of Occupancy Date: 1/10/2023 (D10D003I2)**

PO Box 1293

Ms. McDowell,

Albuquerque

Based upon the information provided in your submittal received 1/11/2023, this plan is approved for Certificate of Occupancy by Hydrology

If you have any questions, please contact me at 924-3695 or Rudy Rael at 924-3977.

NM 87103

Sincerely,

www.cabq.gov

Tiequan Chen, P.E.
Principal Engineer, Hydrology
Planning Department, Development Review Services

RR/TC
C: D10D003I2

Weighted E Method

										100-Year, 6-hr.				24 hour	
Basin	Area (sf)	Area (acres)	Treatment A		Treatment B		Treatment C		Treatment D	Weighted E (ac-ft)	Volume (ac-ft)	Flow cfs	Volume (ac-ft)		
			%	(acres)	%	(acres)	%	(acres)						%	(acres)
ALLOWED	27355.00	0.628	0%	0	20%	0.126	46%	0.2889	34%	0.214	1.259	0.066	2.02	0.074	
PROPOSED	27355.00	0.628	0%	0	20%	0.126	34%	0.2135	46%	0.289	1.377	0.072	2.13	0.083	
COMPARISON												0.006		0.009	

Equations:

Weighted E = Ea*Aa + Eb*Ab + Ec*Ac + Ed*Ad / (Total Area)

Volume = Weighted D * Total Area

Flow = Qa * Aa + Qb * Ab + Qc * Ac + Qd * Ad

Where for 100-year, 6-hour storm- zone 1

Ea= 0.44	Qa= 1.29
Eb= 0.67	Qb= 2.03
Ec= 0.99	Qc= 2.87
Ed= 1.97	Qd= 4.37


ONSITE Conditions

FIRST FLUSH WATER QUALITY VOLUME

	REQUIRED (CF)	PROVIDED (CF)
WATER QUALITY	0	706
FLOOD CONTROL	394	706


Narrative

This site is within the SAD 228 Master Drainage plan boundaries. The site is to maintain existing patterns and drain to the adjacent roadway. The site does exceed the SAD 228 developed conditions assumptions therefore ponding is required. Upland flow has the ability to enter the site from the rear yard of the lot to the north and west, this flow is allowed to pass. This plan is in conformance to the master drainage plan.

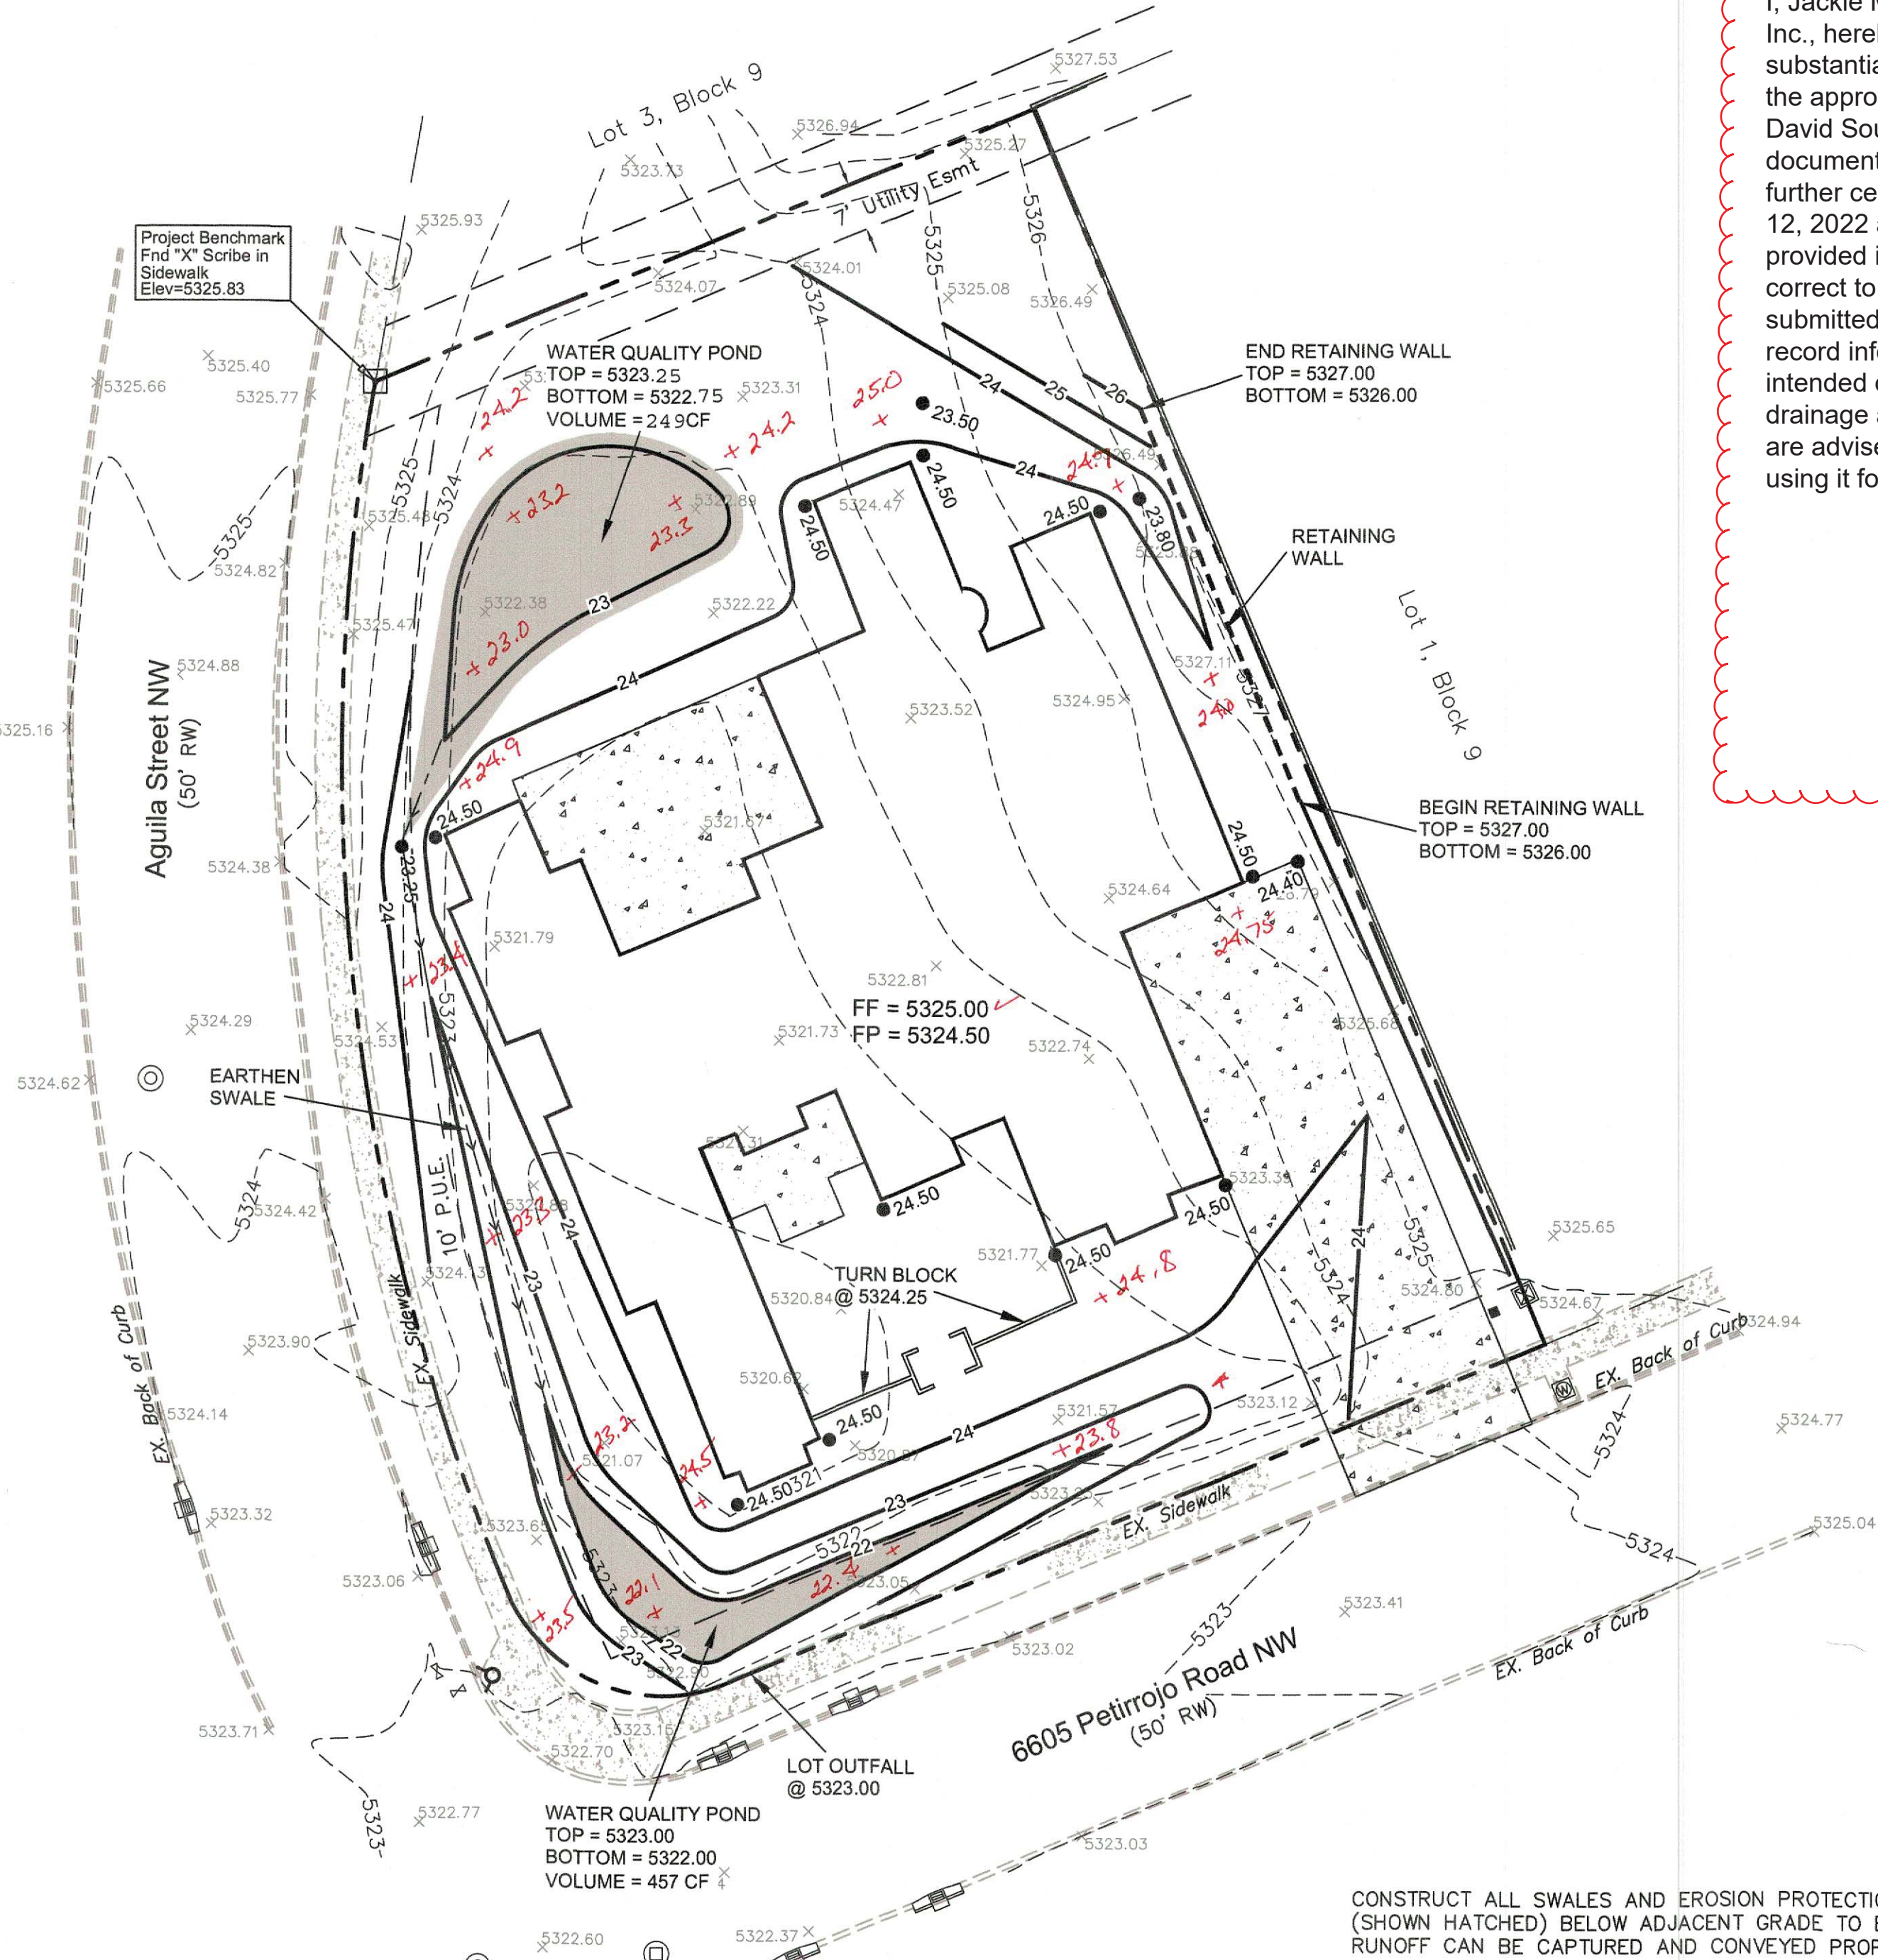

Elevations shown are based on field information taken on 12-5-22

Anthony L. Harris
12-12-22

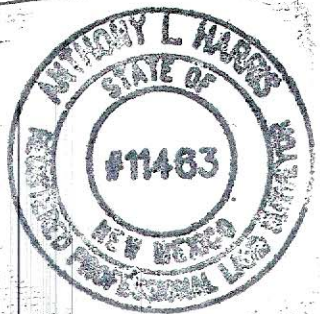

CAUTION:

EXISTING UTILITIES ARE NOT SHOWN. IT SHALL BE THE SOLE RESPONSIBILITY OF THE CONTRACTOR TO CONDUCT ALL NECESSARY FIELD INVESTIGATIONS PRIOR TO ANY EXCAVATION TO DETERMINE THE ACTUAL LOCATION OF UTILITIES & OTHER IMPROVEMENTS.


EROSION CONTROL NOTES:

1. CONTRACTOR IS RESPONSIBLE FOR OBTAINING A TOPSOIL DISTURBANCE PERMIT PRIOR TO BEGINNING WORK.
2. CONTRACTOR IS RESPONSIBLE FOR MAINTAINING RUN-OFF ON SITE DURING CONSTRUCTION.
3. CONTRACTOR IS RESPONSIBLE FOR CLEANING ALL SEDIMENT THAT GETS INTO EXISTING RIGHT-OF-WAY.
4. REPAIR OF DAMAGED FACILITIES AND CLEANUP OF SEDIMENT ACCUMULATIONS ON ADJACENT PROPERTIES AND IN PUBLIC FACILITIES IS THE RESPONSIBILITY OF THE CONTRACTOR.
5. ALL EXPOSED EARTH SURFACES MUST BE PROTECTED FROM WIND AND WATER EROSION PRIOR TO FINAL ACCEPTANCE OF ANY PROJECT.


DRAINAGE CERTIFICATION FOR CERTIFICATE OF OCCUPANCY (CO) WITH SURVEY WORK BY PROFESSIONAL SURVEYOR I, Jackie McDowell, NMPE #10903, of the firm McDowell Engineering, Inc., hereby certify that this project has been graded and will drain in substantial compliance with and in accordance with the design intent of the approved plan dated 3-1-21, and pad certification dated 4-8-22 by David Soule. The record information edited onto the original design document has been obtained by Anthony Harris, NMPS #11463. I further certify that I have personally visited the project site on December 12, 2022 and have determined by visual inspection that the survey data provided is representative of actual site conditions and is true and correct to the best of my knowledge and belief. This certification is submitted in support of a request for Certificate of Occupancy. The record information presented hereon is not necessarily complete and intended only to verify substantial compliance of the grading and drainage aspects of this project. Those relying on the record document are advised to obtain independent verification of its accuracy before using it for any other purpose.



AS-BUILT CERTIF. FOR CO, 12-13-22

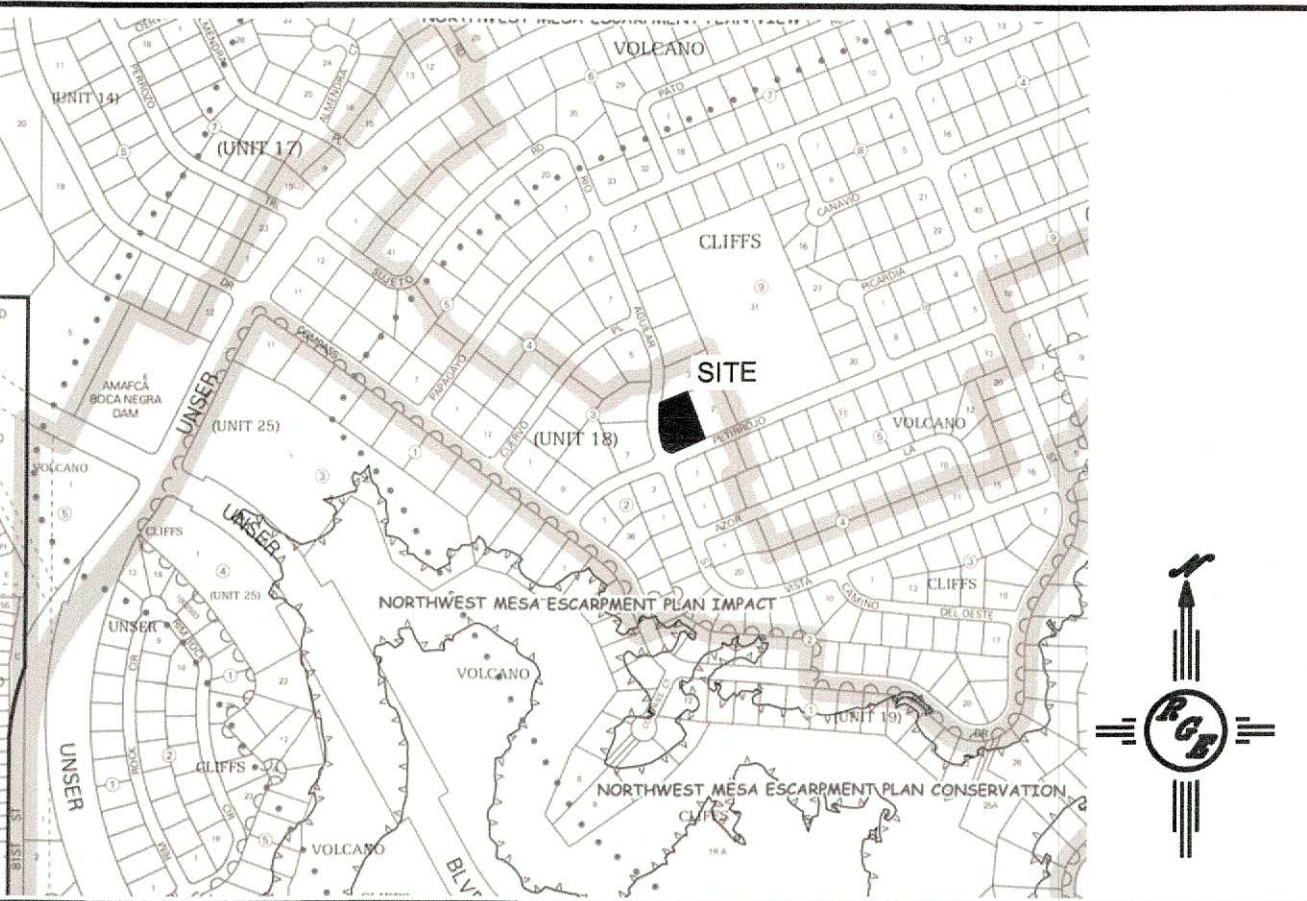

VICINITY MAP: D-10-Z

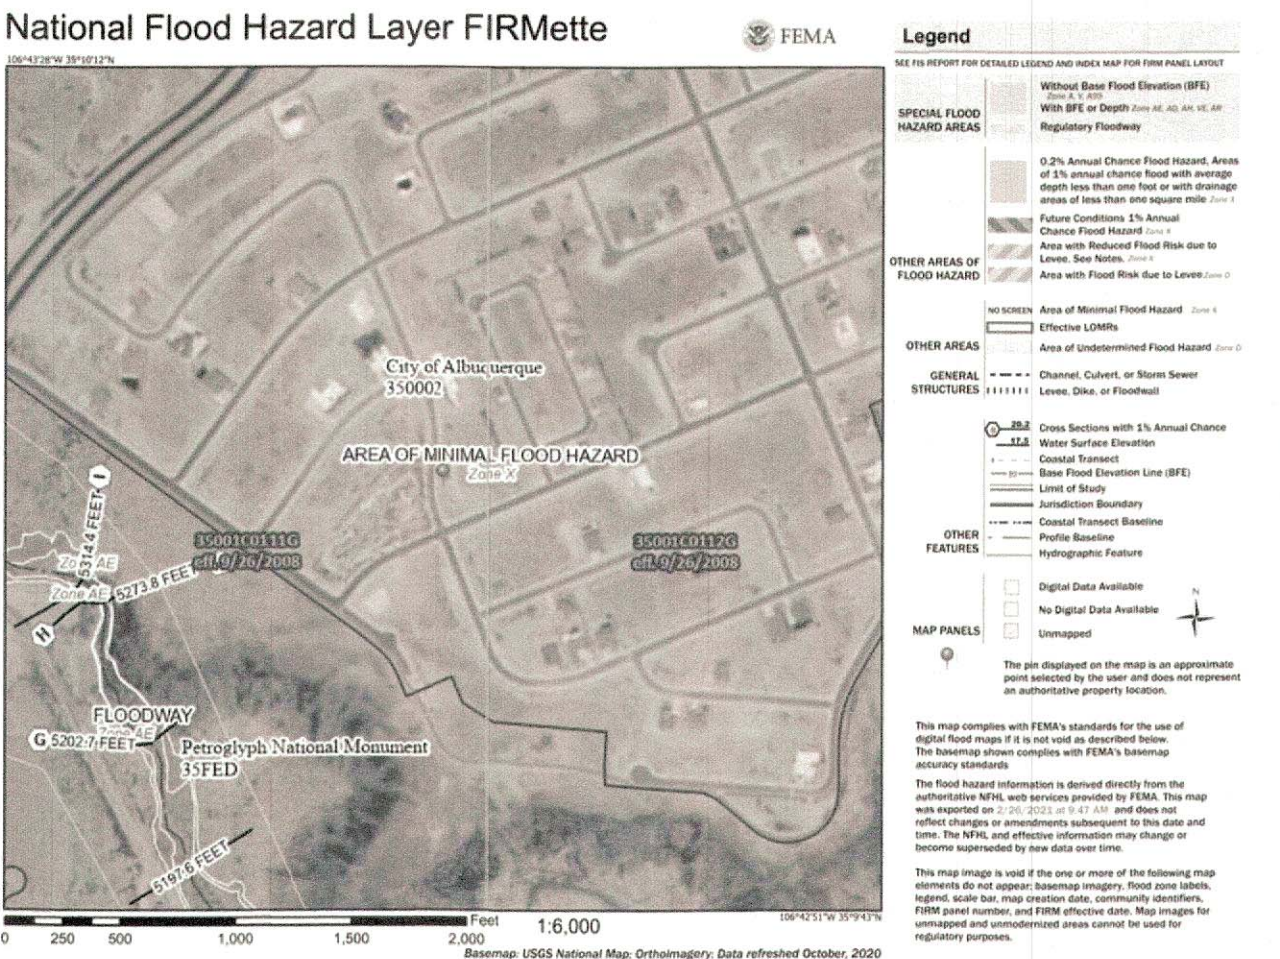

FIRM MAP:

LEGAL DESCRIPTION:

LOT 02 BLOCK 09 UNIT 18 VOLCANO CLIFFS SUBDIVISION
CITY OF ALBUQUERQUE, BERNALILLO COUNTY, NEW MEXICO



NOTES:

1. ALL SPOT ELEVATIONS REPRESENT FLOWLINE ELEVATION UNLESS OTHERWISE NOTED.
2. ALL SLOPES SHALL BE 3:1 MAX. AND GRAVEL OR NATIVE SEEDING PRIOR TO CO.
3. ANY PERIMETER WALLS MUST BE PERMITTED SEPARATELY ALL RETAINING WALL DESIGN SHALL BE BY OTHERS.
4. SURVEY INFORMATION PROVIDED BY COMMUNITY SCIENCES CORPORATION USING NAVD DATUM 1988.
5. A PAD ELEVATION CERTIFICATION SHALL BE REQUIRED PRIOR TO RELEASE OF BUILDING PERMIT.

LEGEND

---	EXISTING CONTOUR
---	EXISTING INDEX CONTOUR
---	PROPOSED CONTOUR
---	PROPOSED INDEX CONTOUR
+	EXISTING SPOT ELEVATION
•	PROPOSED SPOT ELEVATION
---	BOUNDARY
---	ADJACENT BOUNDARY
=====	EXISTING CURB AND GUTTER
---	PROPOSED EARTHEN SWALE
---	PROPOSED RETAINING WALL
---	PROPOSED CONCRETE

CONSTRUCT ALL SWALES AND EROSION PROTECTION (SHOWN HATCHED) BELOW ADJACENT GRADE TO ENSURE RUNOFF CAN BE CAPTURED AND CONVEYED PROPERLY.

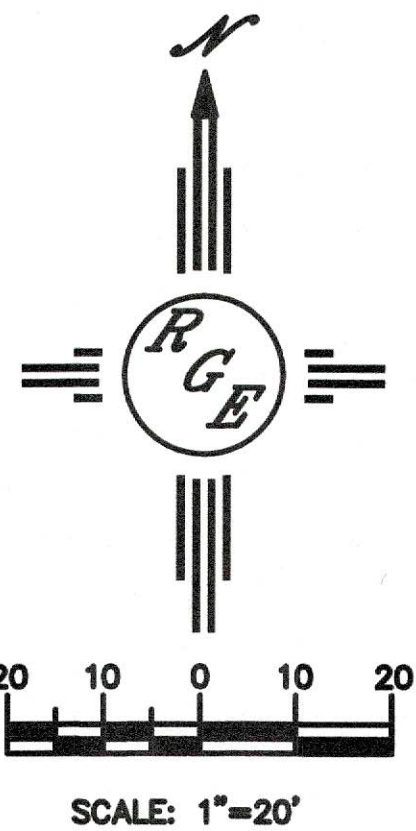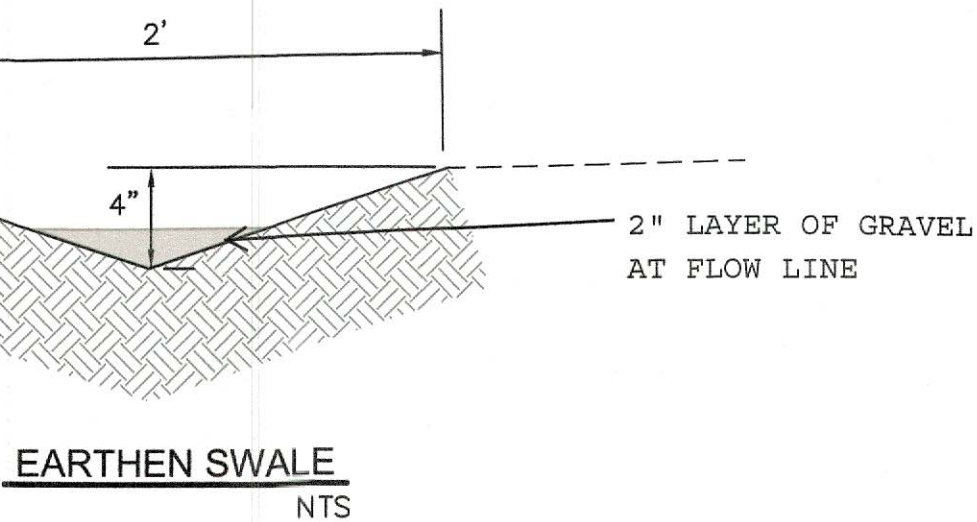

ENGINEER'S SEAL 	LOT 02 BLK 09 UN 18 VC 6605 PETIRROJO ROAD NW	DRAWN BY DEM DATE 2-27-21
	GRADING AND DRAINAGE PLAN	Lot 02 Blk 09 Un 18 VC.DWG
DAVID SOULE P.E. #14522	 Rio Grande Engineering PO BOX 93924 ALBUQUERQUE, NM 87199 (505) 321-9098	SHEET # C1
		JOB #

ZONE 1

Areas: (acres)	Existing	Proposed
Treatment A	0.63	0.00
Treatment B	0.00	0.13
Treatment C	0.00	0.25
Treatment D	0.00	0.25
Total (acres) =	0.63	0.63

Volume	100 year Existing	100 year Proposed	10 year Existing	10 year Proposed	2 year Existing	2 year Proposed
Volume (acre-feet) =	0.023	0.069	0.004	0.037	0.000	0.018
Volume (cubic feet) =	1,006	3,002	183	1,628	0	767

FIRST FLUSH REQUIRED POND VOL = $0.34"/(12"/FT) * (0.25 \text{ AC} * 43560 \text{ SF/AC}) = 309 \text{ CF}$

Total Q(p), cfs:	100 year Existing Q(p)*A	100 year Proposed Q(p)*A	10 year Existing Q(p)*A	10 year Proposed Q(p)*A	2 year Existing Q(p)*A	2 year Proposed Q(p)*A
Treatment A	0.81	0.00	0.15	0.00	0.00	0.00
Treatment B	0.00	0.26	0.00	0.10	0.00	0.00
Treatment C	0.00	0.72	0.00	0.37	0.00	0.12
Treatment D	0.00	1.09	0.00	0.72	0.00	0.42
Total Q (cfs) =	0.81	2.07	0.15	1.19	0.00	0.54