

GENERAL DRAINAGE PLAN NOTES:

1. It is recommended that the Owner obtain a Geotechnical Evaluation of the on-site soils prior to foundation/structural design.
2. This plan recommends positive drainage away from all structures to prohibit ponding of runoff adjacent to the structure. Future alterations of the grades next to the structures are not recommended.
3. Irrigation within 10 feet of any proposed structure is not recommended. Irrigation water adjacent to the structures could cause settlement.
4. This plan establishes on-site drainage and assumes no responsibility for subsurface analysis, foundation or structural design, or utility design.
5. Local codes may require all footings to be placed in natural undisturbed soil. If the contractor plans to place footings on engineered fill, a certification by a registered Professional Engineer is recommended.
6. It is recommended that the Owner obtain the services of a Geotechnical Engineer to test and inspect all earthwork aspects of the project.
7. The property boundary shown on this plan is given for information only to describe the project limits. Property boundary information shown hereon does not constitute a boundary survey.
8. All work shall be constructed in accordance with the City of Albuquerque Standard Specifications for Public Works Construction with updates.
9. All work on this project shall be performed in accordance with applicable Federal, State, and Local laws, rules, and regulations concerning construction safety and health.
10. Contactor shall ensure that no site soils/sediment or silt enters the right-of-ways during construction.
11. Areas disturbed due to construction shall be restored per City of Albuquerque Spec. 1012 native seed mix.


SURVEY NOTES:
PROJECT LOCATION
6620 SUJETO ROAD NW, ALBUQUERQUE, NEW MEXICO
SURVEY INFORMATION
TOPOGRAPHIC SURVEY PERFORMED AND COMPILED BY TERRA LAND SURVEYS, LLC. CORRALES, NEW MEXICO AUGUST 2020.
PROJECT BENCHMARK
PROJECT BENCHMARK IS A USGLO SECTION CORNER DISC SET IN A 12 INCH CONCRETE POST POURED AROUND THE ORIGINAL IRON PIPE 1 FOOT ABOVE GROUND STAMPED, "S21, S22, S28, S27, T11, R2E, 1911," TO REACH THE STATION BENCHMARK FROM THE INTERSECTION OF MONTANO ROAD AND UNSER BOULEVARD NORTHWEST, TRAVEL NORTHWEST ON UNSER BOULEVARD 0.78 MILES TO MOLTEN ROCK ROAD NORTHWEST, TURN LEFT AND TRAVEL 320 FEET TO 81ST STREET NORTHWEST AND THE STATION IS LOCATED ON THE SOUTHEAST QUADRANT OF THE INTERSECTION. ELEVATION = 5,330.151 FEET.
TEMPORARY PROJECT BENCHMARK
PROJECT BENCHMARK CP 150 IS A TERRA LAND SURVEY 1/2" REBAR WITH PLASTIC CAP STAMPED "TERRA CONTROL" ELEVATION = 5,334.45 FEET (NAVD 1988 VERTICAL DATUM).
NOTES
1. FIELD SURVEY PERFORMED IN AUGUST 2020.
2. TOPOGRAPHIC SURVEY WAS COMPILED UTILIZING SURFACE COORDINATES REFERENCED TO NAD 1983 NEW MEXICO CENTRAL ZONE. PRIMARY HORIZONTAL AND VERTICAL CONTROL WAS ESTABLISHED UTILIZING GPS RTK METHODS. COMBINED GROUND TO GRID FACTOR IS 0.999671106 SCALED AROUND 0.0.
3. ELEVATIONS SHOWN FOR PIPES ARE INVERT ELEVATIONS UNLESS OTHERWISE SPECIFIED.
4. CONTOURS SHOWN HEREON ARE AT A ONE FOOT INTERVAL REFERENCED TO THE NAVD 88 VERTICAL DATUM.
5. THE UNDERGROUND UTILITIES SHOWN HAVE BEEN LOCATED FROM FIELD SURVEY INFORMATION. THE SURVEYOR MAKES NO GUARANTEE THAT THE UNDERGROUND UTILITIES SHOWN COMPRISE ALL OF THE UTILITIES IN THE AREA, EITHER IN SERVICE OR ABANDONED. THE SURVEYOR FURTHER DOES NOT WARRANT THAT THE UNDERGROUND UTILITIES SHOWN ARE IN THE EXACT LOCATION INDICATED ALTHOUGH HE DOES CERTIFY THAT THEY ARE LOCATED AS ACCURATELY AS POSSIBLE FROM THE INFORMATION AVAILABLE.
6. PIPE SIZES AND MATERIAL TYPES FOR MANHOLES SHOWN HAVE BEEN LOCATED FROM FIELD SURVEYS AND VISUAL INSPECTIONS. THE SURVEYOR MAKES NO GUARANTEE THAT THE PIPE SIZES AND MATERIAL TYPES ARE EXACT BUT DOES CERTIFY THAT THEY ARE LOCATED AS ACCURATELY AS POSSIBLE FROM THE INFORMATION AVAILABLE.
7. THIS IS NOT A BOUNDARY SURVEY. PROPERTY LINES SHOWN ARE FOR ORIENTATION ONLY.

STANDARD GRADING NOTE: THE MAXIMUM GRADED SIDE SLOPE SHALL NOT EXCEED 3 FEET (HORIZONTALLY) TO 1 FOOT (VERTICALLY). AREAS DISTURBED BY GRADING WHICH WILL NOT BE TREATED WITH LANDSCAPING SHALL BE SEEDED.

STANDARD WALL AND PAD CERTIFICATION NOTES:
ALL PERMITTER GARDEN WALLS SHALL BE PERMITTED SEPARATELY.
A PAD CERTIFICATION IS REQUIRED BEFORE THE BUILDING PERMIT IS RELEASED.


This is the plan to be used for any garden walls and any openings in the walls shall be placed 3" above final grade in the rear yard to allow for cross lot drainage from west to east (upstream to downstream).

PROPERTY LINE WALLS AND GARDEN WALLS SHALL HAVE TURNED BLOCKS OR WEEP HOLES FOR DRAINAGE. ALL OPENINGS IN THE

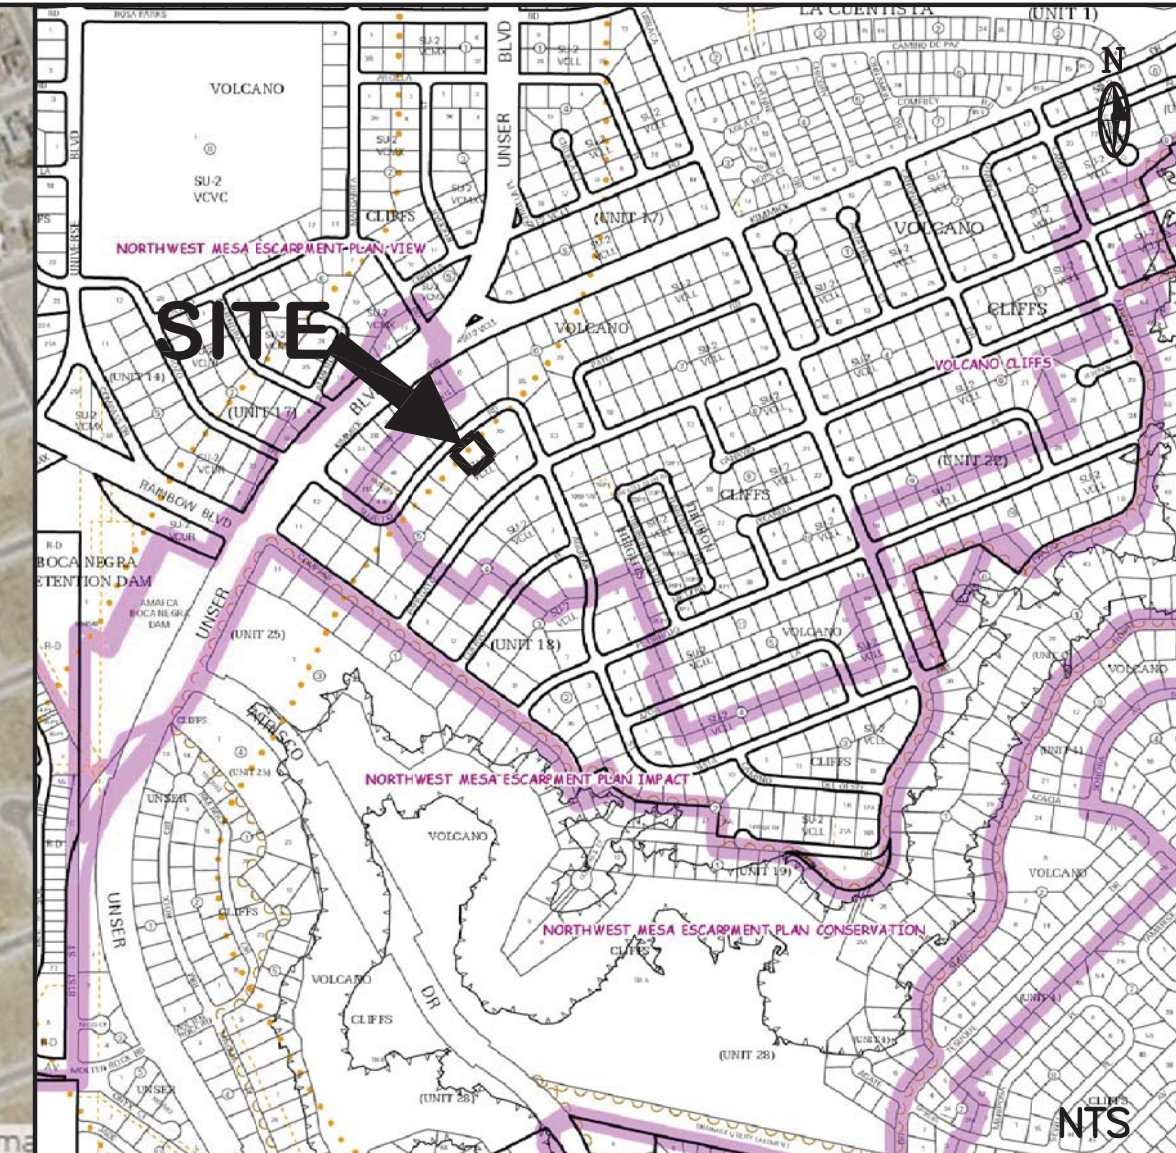

VICINITY MAP ZONE ATLAS D-10

LEGEND	
EXISTING	PROPOSED
CONTOUR	6045
PROPERTY LINE	
ROAD	
SETBACK	
RETAINING WALL/WALL	
SPOT ELEVATION	

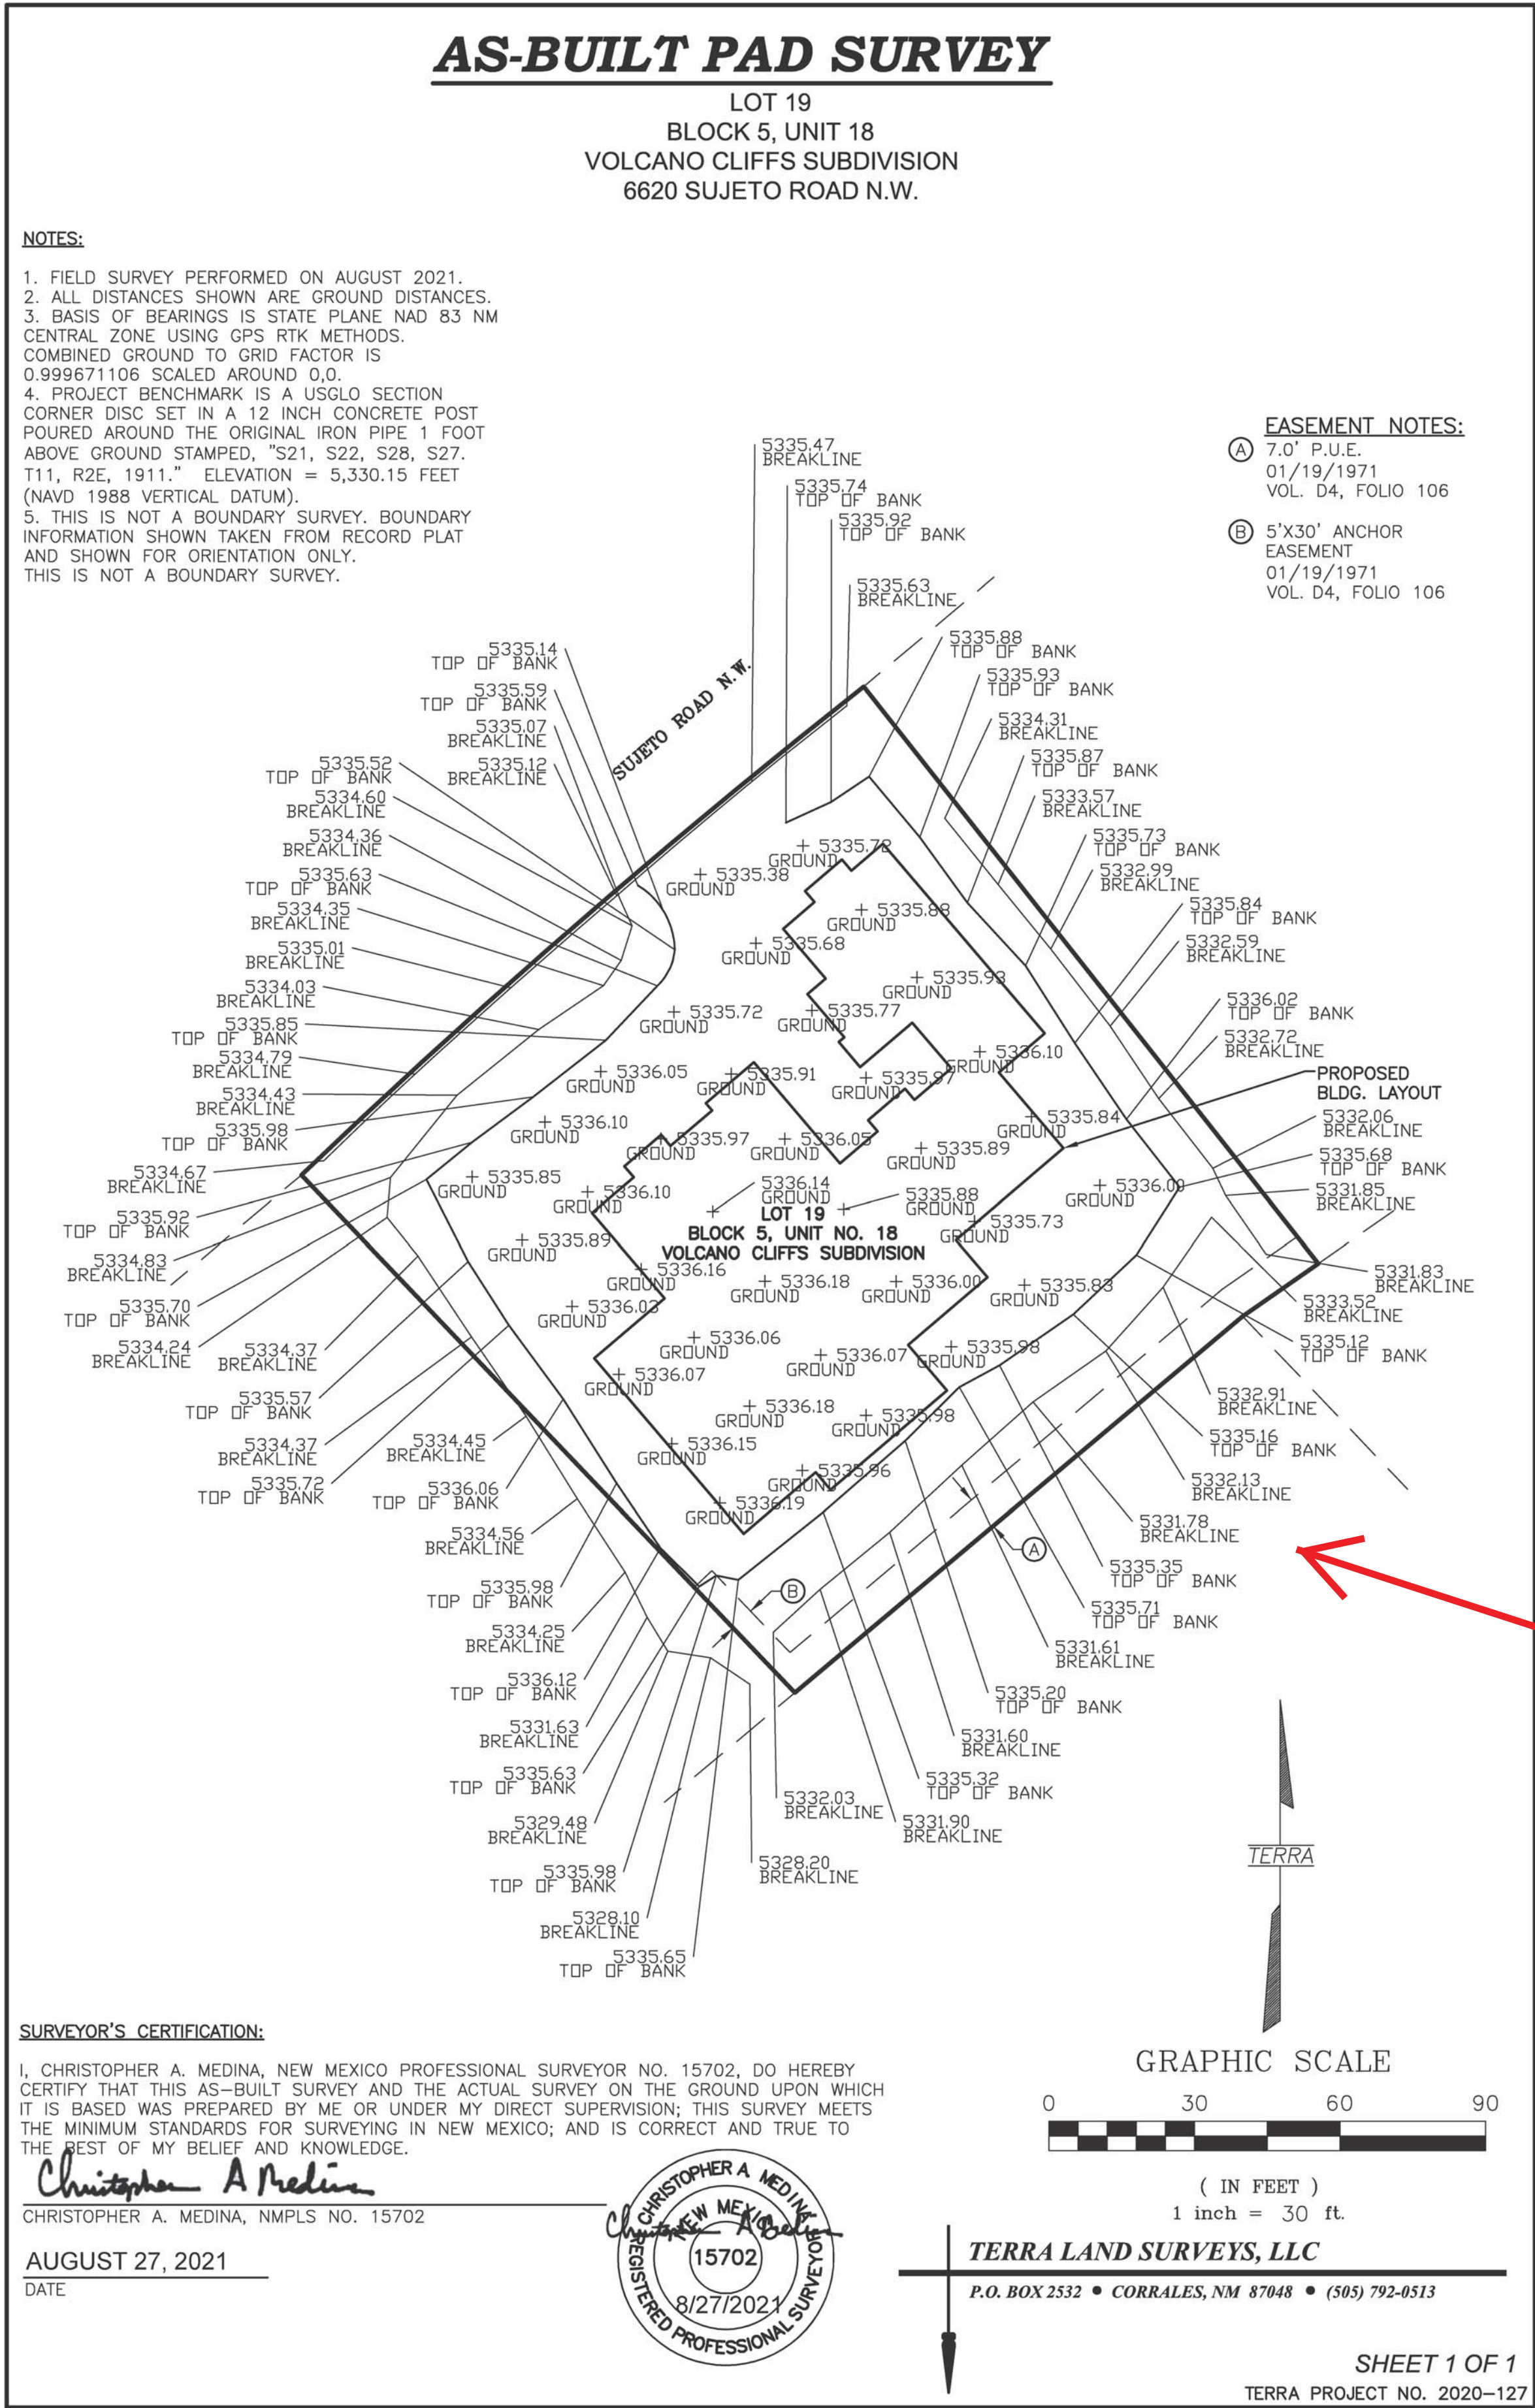

SURVEYOR'S CERTIFICATION:
I, CHRISTOPHER A. MEDINA, NEW MEXICO PROFESSIONAL SURVEYOR NO. 15702, DO HEREBY CERTIFY THAT THIS AS-BUILT SURVEY AND THE ACTUAL SURVEY ON THE GROUND UPON WHICH IT IS BASED WAS PREPARED BY ME OR UNDER MY DIRECT SUPERVISION; THIS SURVEY MEETS THE MINIMUM STANDARDS FOR SURVEYING IN NEW MEXICO; AND IS CORRECT AND TRUE TO THE BEST OF MY BELIEF AND KNOWLEDGE.
Christopher A. Medina
CHRISTOPHER A. MEDINA, NMPLS NO. 15702
AUGUST 27, 2021
DATE

TERRA LAND SURVEYS, LLC
P.O. BOX 2532 • CORRALES, NM 87048 • (505) 792-0513
SHEET 1 OF 1
TERRA PROJECT NO. 2020-127

9-10-20

8-28-21 PAD CERTIFICATION

ENGINEER'S CERTIFICATION:
I, Jackie S. McDowell, hereby certify that I personally inspected the site shown on this plan on September 3, 2020 and as of that date it appeared that no filling, grading, or excavation had occurred thereon since completion of the topographic survey used to prepare this plan.

6620 SUJETO ROAD NW, ALBUQUERQUE, NM 87120
CITY OF ALBUQUERQUE, BERNALILLO COUNTY NEW MEXICO

LOT 19, BLOCK 5, UNIT 18
VOLCANO CLIFFS SUBDIVISION

OLIVAS, JONATHAN (M. SANCHEZ) - GRADING & DRAINAGE PLAN

McDowell Engineering, Inc.
7820 BEVERLY HILLS AVE. NE ALBUQUERQUE, NM 87122
TELE: 505-828-2430 • FAX: 505-821-4857

Designed JSM	Drawn STAFF	Checked JSM	Sheet of
File OL10120L	Date SEPTEMBER, 2020	1	1