

City of Albuquerque


Planning Department Development & Building Services Division

DRAINAGE AND TRANSPORTATION INFORMATION SHEET (REV 11/2018)

Project Title:	Building Permit #		Hydrology File #:	
DRB#:	EPC#:		Work Order#:	
Legal Description:				
City Address:				
Applicant:			Contact:	
Address:				
			E-mail:	
Owner:			Contact:	
Address:				
			E-mail:	
TYPE OF SUBMITTAL:PLA	Γ (# OF LOTS)	RESIDENCE	_ DRB SITE ADMIN SITE	
IS THIS A RESUBMITTAL?:	Yes	No		
DEPARTMENT: TRAFFIC/ T	RANSPORTATION _	HYDROLOG	Y/ DRAINAGE	
Check all that Apply: TYPE OF SUBMITTAL: ENGINEER/ARCHITECT CERTON CONCEPTUAL G & D PLAN GRADING PLAN DRAINAGE MASTER PLAN DRAINAGE REPORT FLOODPLAIN DEVELOPMENTON ELEVATION CERTIFICATE CLOMR/LOMR TRAFFIC CIRCULATION LAY TRAFFIC IMPACT STUDY (TIEST) OTHER (SPECIFY) PRE-DESIGN MEETING?	PERMIT APPLIC OUT (TCL)	BUILI CERT PRELI SITE I SITE I FINAI SIA/ F FOUN GRAD SO-19 PAVII GRAD WORK CLOM FLOO	APPROVAL/ACCEPTANCE SOUGHT: DING PERMIT APPROVAL IFICATE OF OCCUPANCY IMINARY PLAT APPROVAL PLAN FOR SUB'D APPROVAL PLAN FOR BLDG. PERMIT APPROVAL RELEASE OF FINANCIAL GUARANTEE IDATION PERMIT APPROVAL DING PERMIT APPROVAL APPROVAL APPROVAL OF PERMIT APPROVAL	
DATE SUBMITTED:	By:			

COA STAFF: ELECTRONIC SUBMITTAL RECEIVED:____

FEE PAID:

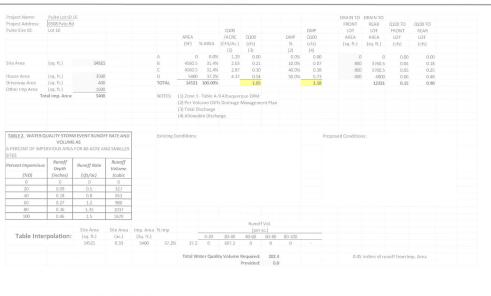

Cut/Fill Summary

Cut Factor	Fill Factor	2d Area	Cut	Fill .	Net	
1.00	1.00	14520.53 Sq. Ft.	15.00 Cu. Yd.	1524.34 Cu. Yd.	1509.33 Cu. Yd. <fill< th=""><th></th></fill<>	
		14520.53 Sq. Ft.	15.00 Cu. Yd.	1524.34 Cu. 1d.	1509.33 Cu. Yd. <fi11></fi11>	
				/	I service the service of the service	
	\		J	W.		
		\/	- ROAD N			
		3	8 PATO ROAD N	_		DRA
-		650		(100,000)	5343.40	I, SHELI
					4	HEREBY

AINAGE CERTIFICATION

N143-

06.1 SPOT ELEVATION

Asbullt Legend

I, SHELDON GREER P.E., NIMPE 17154, OF THE ENGINEERING FIRM RESPEC, HEREBY CERTIFY THAT THIS PROJECT HAS BEEN GRADED AND WILL DRAIN IN SUBSTANTIAL COMPLIANCE WITH AND IN ACCORDANCE WITH THE DESIGN INTENT OF THE APPROVED PLAN DATED 09/09/2021. THE RECORD INFORMATION EDITED ONTO THE ORIGINAL DESIGN DOCUMENT HAS BEEN OBTAINED THOMAS W. PATRICK, MARS 12651, OF THE FIRM COMMUNITY SCIENCE SERVICES. I FURTHER CERTIFY THAT I HAVE PERSONALLY VISITED THE PROJECT SITE ON 8/22/22 AND HAVE DETERMINED BY VISUAL INSPECTION THAT THE SURVIEY DATA PROVIDED IS REPRESENTATIVE OF ACTUAL SITE CONDITIONS AND IS TRUE AND CORRECT TO THE BEST OF MY KNOWLEDGE AND BELIEF. THIS CERTIFICATION IS SUBMITTED IN SUPPORT OF A REQUEST FOR CERTIFICATE OF OCCUPANCY. THE RECORD INFORMATION PRESENTED HEREON IS NOT NECESSARILY COMPLETE AND INTENDED ONLY TO VERIEY SUBSTANTIAL NECESSARILY COMPLETE AND INTERDED ONLY TO VERIFY SUBSTAINTIAL COMPLIANCE OF THE GRADING AND DRAINAGE ASPECTS OF THIS PROJECT. THOSE RELYING ON THIS RECORD DOCUMENT ARE ADVISED TO OBTAIN INDEPENDENT VERIFICATION OF ITS ACCURACY BEFORE USING IT FOR ANY OTHER PURPOSE.

Asbuilt Lot 7. Block 7

Volcano Cliffs Unit 18

Sciences
Corporation
Land Surveyir

Land Surveying (505) 897 0000

Not To Scale

SITE







-BOTTOM OF POND=5339 70

PAD CERTIFICATION

I SHELDON GREER P.E., NMPE 17154, OF THE ENGINEERING FIRM RESPEC. HEREBY CERTIFY, BASED ON SURVEY DATA PROVIDED BY BRIAN MARTINEZ, NMRPS 18374, THAT THE AS CONSTRUCTED PAD ELEVATION IS WITHIN 0.2" OF THE DESIGN ELEVATION AND THAT THE HORIZONTAL LIMITS OF THE AS

SHELDON E GREER PE 17154



- GENERAL NOTES: ALL WORK DETAILED ON THESE PLANS TO BE PERFORMED UNDER THE CONTRACT SHALL EXCEPT AS OTHERWISE STATED OR PROVIDED HEREIN, BE CONSTRUCTED IN ACCORDANCE WITH THE CITY O ALBUQUERQUE STANDARD SPECIFICATIONS FOR PUBLIC WORKS, 1986 EDITION, UPDATE NO. 8 VOL. 1 AND 2
- THE EROSION PROTECTION SPECIFIED THIS PLAN IS THE MINIMUM RECOMMENDED. THE OWNER IS ENCOURAGED TO INCORPORATE EROSION RESISTANT LANDSCAPING ON AREAS WHERE EROSION MAY OCCUR SUCH AS SLOPES AND SWALES. THE OWNER IS RESPONSIBLE FOR THE INSTALLATION AND MAINTENANCE OF ALL EROSION CONTROL FEATURES NECESSARY TO PRESERVE THE DESIGN INTENT OF THE GRADING PLAN
- THE DRAINAGE INFRASTRUCTURE SHOWN ON THIS PLAN IS THE RESPONSIBILITY OF THE PROPERTY OWNER.
- ALL DISTURBED AREAS OUTSIDE THE BUILDING PAD MUST BE RESEEDED OR LANDSCAPED.
- TWO (2) WORKING DAYS PRIOR TO ANY EXCAVATION, CONTRACTOR MUST CONTACT LINE LOCATING SERVICE, (260-1990) FOR LOCATION OF EXISTING UTILITIES.
- PRIOR TO CONSTRUCTION, THE CONTRACTOR SHALL EXCAVATE AND VERIFY THE HORIZONTAL AND VERTICAL LOCATIONS OF ALL OBSTRUCTIONS AND EXISTING PAVEMENT, SHOULD A CONFLICT EXIST, THE CONTRACTOR SHALL NOTIFY ENGINEER OR SURVEYOR SO THAT THE CONFLICT CAN BE RESOLVED WITH A MINIMUM OF DELAY.

THE ENGINEER HAS UNDERTAKEN LIMITED FIELD VERIFICATION OF THE LOCATION, DEPTH, SIZE, OR TYPE OF EXISTING UNDERGROUND UTILITY LINES, MAKES NO REPRESENTATION PERTAINING THERETO AND ASSUMES NO RESPONSIBILITY OR LIABILITY THEREFOR THE CONTRACTOR SHALL INFORM ITSELF OF THE LOCATION OF ANY UTILITY LINE IN OR NEAR THE ARE OF WORK IN ADVANCE OF AND DURING EXCAVATION WORK. THE CONTRACTOR IS FULLY RESPONSIBLE FOR ANY AND ALL DAMAGE CAUSED BY ITS FAILURE TO LOCATE, IDENTIFY, AND PRESERVE ANY AND ALL EXISTING UTILITIES. THE CONTRACTOR SHALL COMPLY WITH STATE STATUTES, MUNICIPAL AND LOCAL ORDINANCES, IN PLANNING AND CONDUCTING EXCAVATION, WHETHER BY CALLING OR NOTIFYING THE UTILITIES, COMPLYING WITH "BLUE STAKES" PROCEDURES, OR OTHERWISE.

THESE DRAWINGS DO NOT INCLUDE THE NECESSARY COMPONENTS FOR CONSTRUCTION SAFETY WHICH SHALL REMAIN THE RESPONSIBILITY OF THE CONTRACTOR

THIS DOCUMENT, AND THE IDEAS AND DESIGNS INCORPORATED HEREIN, ARE INTENDED FOR USE ON THIS PROJECT AND IS NOT TO BE USED, IN WHOLE OR IN PART, FOR ANY OTHER PROJECT WITHOUT THE WRITTEN AUTHORIZATION OF RESPEC INC. IN THE EVENT OF UNAUTHORIZED USE, THE USER ASSUMES ALL RESPONSIBILITY AND LIABILITY WHICH RESULTS.

EROSION CONTROL NOTES:

- THE CONTRACTOR IS RESPONSIBLE FOR OBTAINING A TOPSOIL DISTURBANCE PERMIT PRIOR TO BEGINNING
- 2. CONTRACTOR IS RESPONSIBLE FOR MAINTAINING RUN-OFF ON SITE DURING CONSTRUCTION.
- CONTRACTOR IS RESPONSIBLE FOR CLEANING ALL SEDIMENT THAT GETS INTO EXISTING RIGHT-OF-WAY
- REPAIR OF DAMAGED FACILITIES AND CLEANUP OF SEDIMENT ACCUMULATIONS ON ADJACENT PROPERTIES AND IN PUBLIC FACILITIES IS THE RESPONSIBILITIES OF THE CONTRACTOR.
- ALL EXPOSED EARTH SURFACES MUST BE PROTECTED FROM WIND AND WATER EROSION PRIOR TO FINAL (CITY) ACCEPTANCE OF ANY PROJECT



- EXISTING PROPERTY LINE
- EXISTING 10' P.U.E.

 EXISTING STANDARD CURB AND GUTTER
- EXISTING SIDEWALK

- HIGH POINT OF SWALE
- MATCH DRIVEWAY TO BACK OF EXISTING SIDEWALK
 IF PERIMETER WALL INSTALLED THEN PROVIDE TURNED BLOCK TO
- ALLOW FOR CROSS LOT DRAINAGE
 PROPOSED DRIVEWAY LOCATION. DRIVEWAY PERMIT BY OTHERS

 11. EXISTING WALL ADJACENT TO PROPERTY (RETAINING WALL MAY HAVE
- TO BE ADJUSTED WHEN EXISTING WALL ARE ENCOUNTERED.)

VOLCANO CLIFFS 6508 PATO RD PULTE ID 16

AND GRADING / DRAINAGE |

PERMIT GRADING

SHEET NUMBER