

CITY OF ALBUQUERQUE

Planning Department

Brennon Williams, Director



Mayor Timothy M. Keller

October 11, 2019

Don Briggs, P.E.
Don Briggs Engineering
5324 Oakledge Ct. NW
Albuquerque, New Mexico 87120

**RE: Lot 25 Block 6 Unit 18 SAD 228
6519 Pato Rd. NW
Volcano Cliffs Subdivision
Grading and Drainage Plan
Engineers Stamp Date 9/9/19 (D10D003M25)**

Dear Mr. Briggs,

Based upon the information provided in your submittal received 10/9/19, this plan cannot be approved for Grading Permit until the following comments are addressed.

- Remove the dirt from the street and off the sidewalk. Dirt is not allowed to be used as a curb ramp, lumber or millings must be used to keep dirt, debris or sediment out of ponding areas.

PO Box 1293

Prior to building permit approval a pad certification must be obtained.

Albuquerque


Prior to Certificate of Occupancy release, Engineer Certification per the DPM checklist of this plan will be required.

NM 87103

If you have any questions, please contact me at 924-3999 or Rudy Rael at 924-3977.

Sincerely,

www.cabq.gov

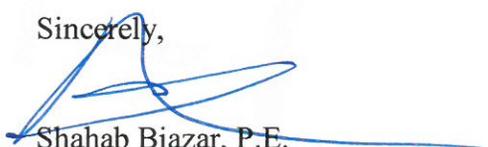
Shahab Biazar, P.E.
City Engineer, Hydrology
Division Manager

RR/SB
C: File



City of Albuquerque

Planning Department

Development & Building Services Division

DRAINAGE AND TRANSPORTATION INFORMATION SHEET (REV 11/2018)

Project Title: _____ **Building Permit #:** _____ **Hydrology File #:** _____

DRB#: _____ **EPC#:** _____ **Work Order#:** _____

Legal Description: _____

City Address: _____

Applicant: _____ **Contact:** _____

Address: _____

Phone#: _____ **Fax#:** _____ **E-mail:** _____

Owner: _____ **Contact:** _____

Address: _____

Phone#: _____ **Fax#:** _____ **E-mail:** _____

TYPE OF SUBMITTAL: _____ PLAT (___# OF LOTS) _____ RESIDENCE _____ DRB SITE _____ ADMIN SITE

IS THIS A RESUBMITTAL?: _____ Yes _____ No

DEPARTMENT: _____ TRAFFIC/ TRANSPORTATION _____ HYDROLOGY/ DRAINAGE

Check all that Apply:

TYPE OF SUBMITTAL:

- _____ ENGINEER/ARCHITECT CERTIFICATION
- _____ PAD CERTIFICATION
- _____ CONCEPTUAL G & D PLAN
- _____ GRADING PLAN
- _____ DRAINAGE MASTER PLAN
- _____ DRAINAGE REPORT
- _____ FLOODPLAIN DEVELOPMENT PERMIT APPLIC
- _____ ELEVATION CERTIFICATE
- _____ CLOMR/LOMR
- _____ TRAFFIC CIRCULATION LAYOUT (TCL)
- _____ TRAFFIC IMPACT STUDY (TIS)
- _____ OTHER (SPECIFY) _____
- _____ PRE-DESIGN MEETING?

TYPE OF APPROVAL/ACCEPTANCE SOUGHT:


- _____ BUILDING PERMIT APPROVAL
- _____ CERTIFICATE OF OCCUPANCY
- _____ PRELIMINARY PLAT APPROVAL
- _____ SITE PLAN FOR SUB'D APPROVAL
- _____ SITE PLAN FOR BLDG. PERMIT APPROVAL
- _____ FINAL PLAT APPROVAL
- _____ SIA/ RELEASE OF FINANCIAL GUARANTEE
- _____ FOUNDATION PERMIT APPROVAL
- _____ GRADING PERMIT APPROVAL
- _____ SO-19 APPROVAL
- _____ PAVING PERMIT APPROVAL
- _____ GRADING/ PAD CERTIFICATION
- _____ WORK ORDER APPROVAL
- _____ CLOMR/LOMR
- _____ FLOODPLAIN DEVELOPMENT PERMIT
- _____ OTHER (SPECIFY) _____

DATE SUBMITTED: _____ **By:** _____

COA STAFF:

ELECTRONIC SUBMITTAL RECEIVED: _____

FEE PAID: _____

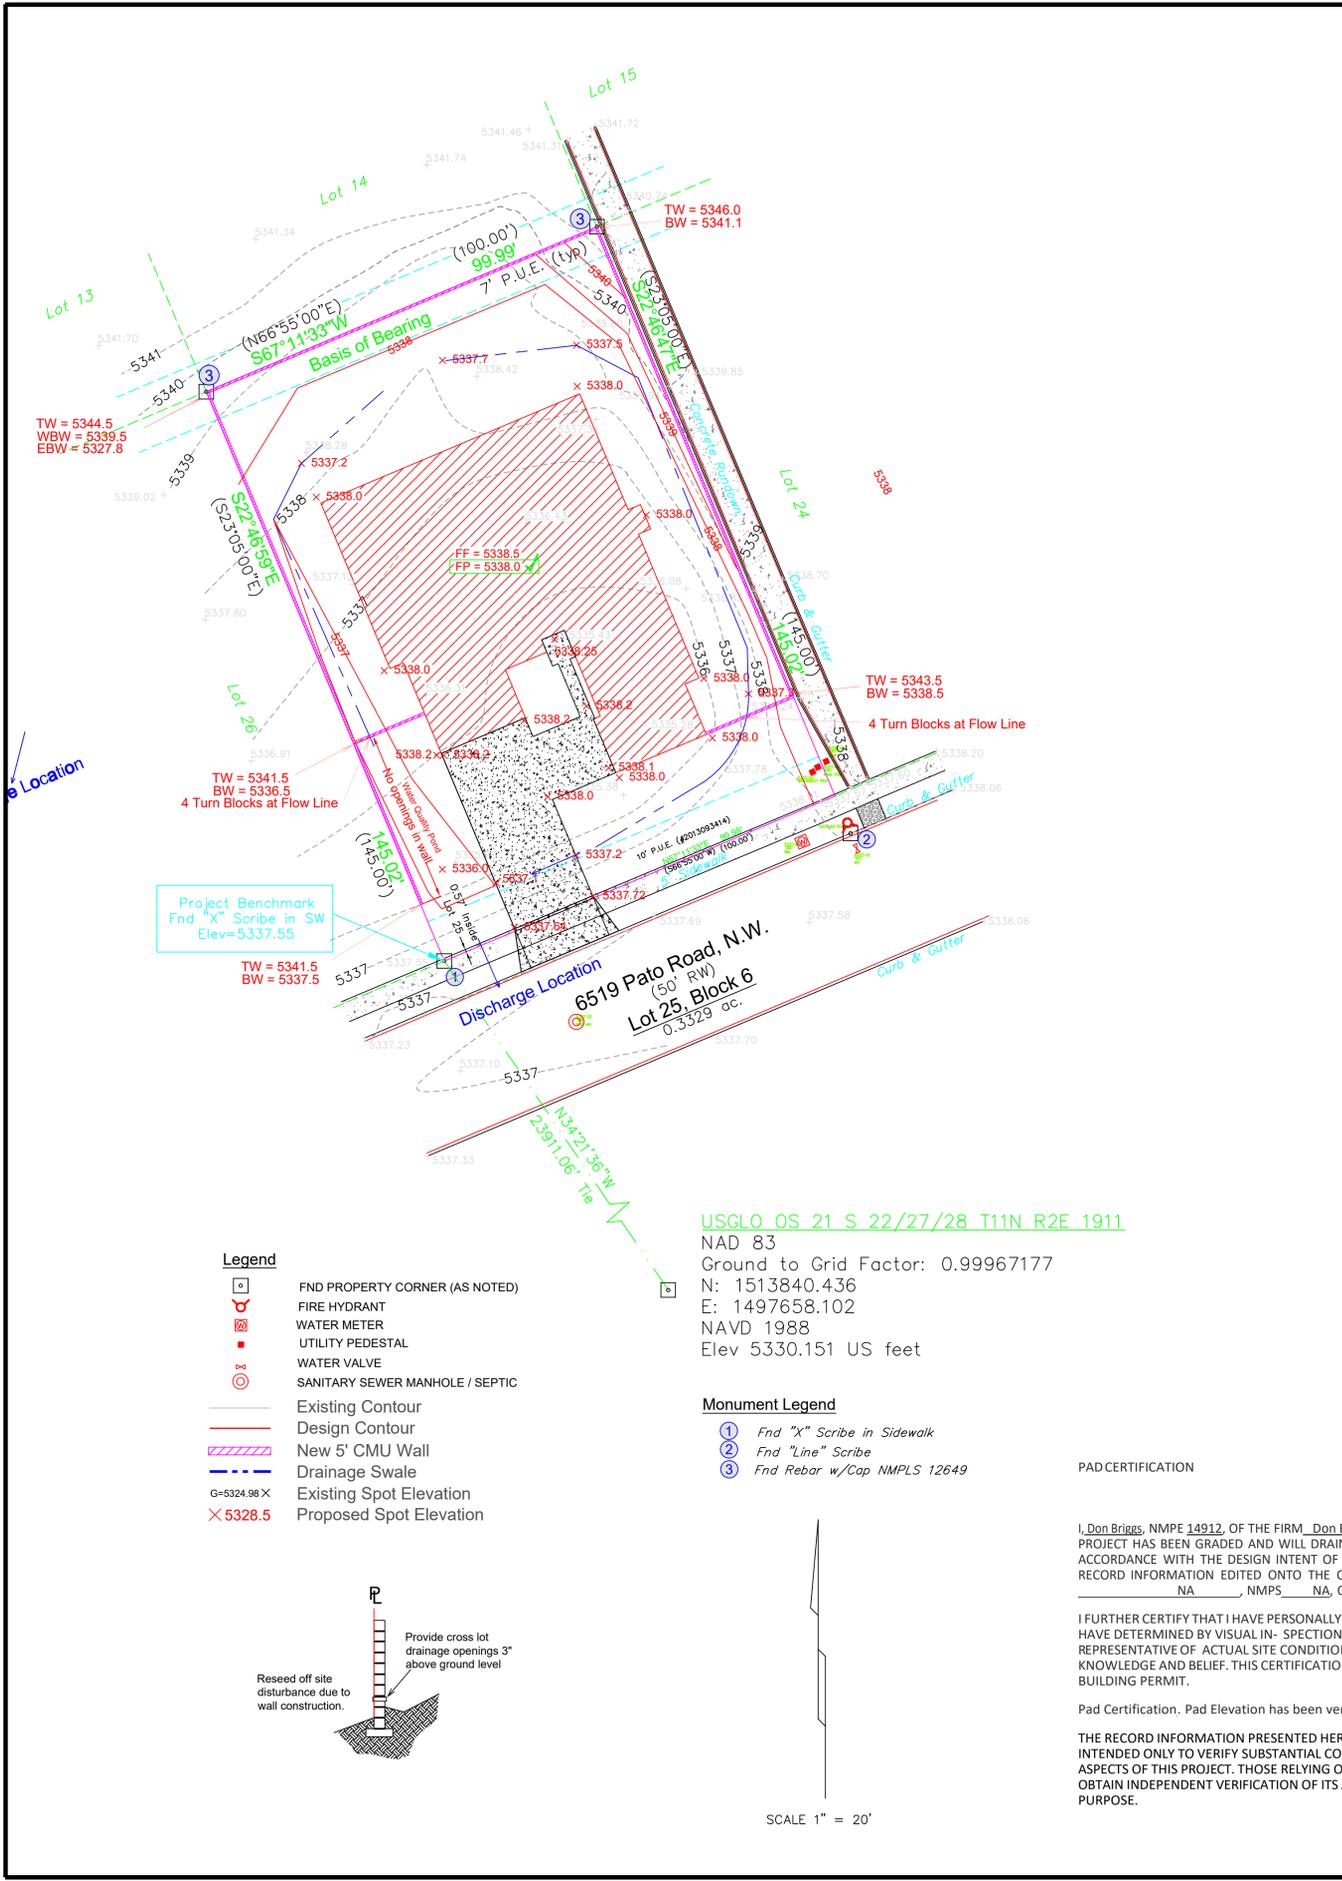

DRAINAGE NARRATIVE

This grading & drainage plan was prepared to support a building permit application for a new residence located at 6519 Pato Rd. NW. A review of the City Hydrology records indicate development of this property is governed by the Drainage Report for SAD 228 (D10-D003). This report indicates allowable land treatment values of 0% A, 10% B, 40% C, and 50% D. If developed discharge rates exceed what is allowable using these land treatment values, mitigation measures will be required. This plan was prepared using the hydrology methodology presented in Chapter 22.2 of the City of Albuquerque's Development Process Manual (abbreviated method).

The site is a 0.33 acre parcel located in Precipitation Zone 1 and Floodzone X (Unshaded). It slopes from the east to the west at about 5%. The site accepts runoff from the property to the west.

The hydrology analysis indicates the developed conditions will not increase discharge rates over what is allowed so mitigation measures are not required. All onsite flows are directed to the front yard landscaping then to the street.

As water quality retention ponding was not provided with the construction of the subdivision, water quality ponding is required for this development. Water quality ponding is provided in the front yard landscaping.

- NOTE:**
1. Pad Certification is required prior to issuance of Building Permit.
 2. A final inspection by Hydrology is required before a Certificate of Occupancy is released.
 3. Provide openings in CMU wall 3" above ground to allow cross lot drainage.

GENERAL NOTES

Contractor is responsible for utility spots and controlling sediment deposition and erosion during construction.

A concrete washout bin must be provided as per City of Albuquerque MS4 Permit requirements.

All disturbed area due to construction must be reseeded or landscaped following construction.

Hydrology Calculations
6519 Pato Rd. NW

Land Treatment	Percent	Area (ac.)	Excess Precipitation (in.)	Unit Peak Discharge (cfs/ac)	Runoff Volume (ac. ft.)	Peak Discharge (cfs)	Comments
A	0.00%	0.00	0.44	1.29	0.00	0.00	Natural Ground/Pond
B	10.00%	0.03	0.67	2.03	0.00	0.00	Landscaped Areas
C	40.00%	0.13	0.59	2.87	0.01	0.38	Compacted earth
D	50.00%	0.17	1.57	4.37	0.03	0.73	Impervious Areas
TOTAL	100.00%	0.33	1.45		0.04	1.18	

Proposed: 0.33 ac., 14501.124 sq ft, Determined by DB

Land Treatment	Percent	Area (ac.)	Excess Precipitation (in.)	Unit Peak Discharge (cfs/ac)	Runoff Volume (ac. ft.)	Peak Discharge (cfs)	Comments
A	0.00%	0.00	0.44	1.29	0.00	0.00	Natural Ground/Pond
B	8.28%	0.03	0.67	2.03	0.00	0.00	Landscaped Areas
C	51.98%	0.17	0.59	2.87	0.01	0.50	Compacted earth
D	39.74%	0.13	1.57	4.37	0.02	0.58	Impervious Areas
TOTAL	100.00%	0.33	1.35		0.04	1.13	

PONDING REQUIREMENT = 1635.02 - 1749.80 = -114.78 cu ft. PONDING NOT REQUIRED

Water Quality Retention Volume = 0.34" x 5763.44 sq ft = 163.30 cu ft.
Water Quality Retention Volume Provided = 162.35 cu ft.

WATER QUALITY POND VOLUME

ELEVATION (ft)	AREA (sq ft)	AVE AREA (sq ft)	DEPTH (ft)	VOLUME (cu ft)	CUMULATIVE VOLUME (cu ft)	COMMENTS
5336.50	0.00	347.05	0.50	173.53	173.53	
5337.00	694.11					
MAX VOLUME					173.53	

USGLO OS 21 S 22/27/28 T11N R2E 1911 NAD 83
Ground to Grid Factor: 0.99967177
N: 1513840.436
E: 1497658.102
NAVD 1988
Elev 5330.151 US feet

Monument Legend

- 1 Fnd "X" Scribe in Sidewalk
- 2 Fnd "Line" Scribe
- 3 Fnd Rebar w/Cap NMPLS 12649

Legend

- FND PROPERTY CORNER (AS NOTED)
- ⊕ FIRE HYDRANT
- ⊕ WATER METER
- ⊕ UTILITY PEDESTAL
- ⊕ WATER VALVE
- ⊕ SANITARY SEWER MANHOLE / SEPTIC
- Existing Contour
- Design Contour
- ▨ New 5' CMU Wall
- Drainage Swale
- Existing Spot Elevation
- × Proposed Spot Elevation

SCALE 1" = 20'

RESEEDING NOTE: Reseed off site disturbance due to wall construction. Provide cross lot drainage openings 3" above ground level.



PAD CERTIFICATION

I, Don Briggs, NMPE 14912, OF THE FIRM, Don Briggs Engineering LLC, HEREBY CERTIFY THAT THIS PROJECT HAS BEEN GRADED AND WILL DRAIN IN SUBSTANTIAL COMPLIANCE WITH AND IN ACCORDANCE WITH THE DESIGN INTENT OF THE APPROVED PLAN DATED 9/9/2019, THE RECORD INFORMATION EDITED ONTO THE ORIGINAL DESIGN DOCUMENT HAS BEEN OBTAINED BY NA, NMPS NA, OF THE FIRM NA.

I FURTHER CERTIFY THAT I HAVE PERSONALLY VISITED THE PROJECT SITE ON 10/8/2019 AND HAVE DETERMINED BY VISUAL INSPECTION THAT THE SURVEY DATA PROVIDED IS REPRESENTATIVE OF ACTUAL SITE CONDITIONS AND IS TRUE AND CORRECT TO THE BEST OF MY KNOWLEDGE AND BELIEF. THIS CERTIFICATION IS SUBMITTED IN SUPPORT OF A REQUEST FOR BUILDING PERMIT.

Pad Certification. Pad Elevation has been verified by level survey by the engineer.

THE RECORD INFORMATION PRESENTED HEREON IS NOT NECESSARILY COMPLETE AND INTENDED ONLY TO VERIFY SUBSTANTIAL COMPLIANCE OF THE GRADING AND DRAINAGE ASPECTS OF THIS PROJECT. THOSE RELYING ON THIS RECORD DOCUMENT ARE ADVISED TO OBTAIN INDEPENDENT VERIFICATION OF ITS ACCURACY BEFORE USING IT FOR ANY OTHER PURPOSE.

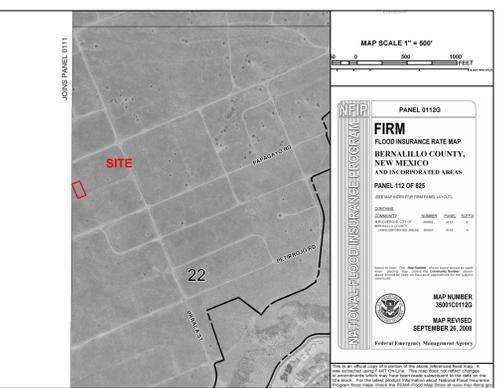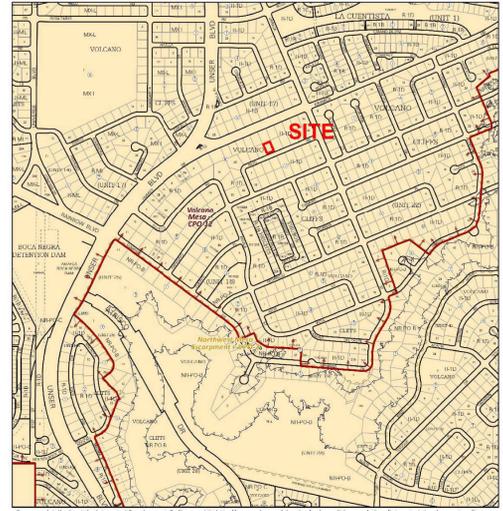

AS BUILT INFORMATION

CONTRACTOR	DATE
WORK STARTED BY	DATE
ACCEPTANCE BY	DATE
FIELD LOCATION BY	DATE
DRAWING BY	DATE
CORRECTED BY	DATE
RECORDED BY	DATE
NO.	NO.

BENCHMARKS

NO.	DATE

FIELD NOTES

NO.	DATE



REVISIONS

NO.	DATE	REMARKS

DESIGNED BY DB DATE 9/5/2019
DRAWN BY DB DATE 9/5/2019
CHECKED BY DATE

DON BRIGGS Engineering LLC
505-249-4843
donbriggsengineering@gmail.com
5324 Oakledge Ct. NW, Albuquerque, NM 87120

TITLE: 6519 Pato Rd. NW Grading & Drainage Plan

Design Review Committee	City Engineer Approval	Mo. / Day / Yr.	Mo. / Day / Yr.

City Project No. **D10D003M25** Zone Map No. Sheet Of

