
CITY OF ALBUQUERQUE

Planning Department Alan Varela, Director

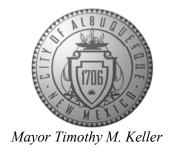

May 9, 2022

Jackie McDowell, PE McDowell Engineering, Inc. 7820 Beverly Hills Ave NE Albuquerque, NM 87121

RE: Lot 27 Block 6 Unit 18, S.A.D. 228

Volcano Cliffs Subdivision

6527 Pato Rd. NW

Grading and Drainage Plan Engineers Stamp Date 7/9/2020

CO Cert Date: 5/6/2022 (D10D003M27)

PO Box 1293 Ms. McDowell,

Based upon the information provided in your submittal received 5/9/2022, this plan is approved

for Certificate of Occupancy by Hydrology

Albuquerque

If you have any questions, please contact me at 924-3986 or Rudy Rael at 924-3977.

Sincerely,

www.cabq.gov Ernest Armijo, P.E.

Principal Engineer, Planning Dept. Development Review Services



City of Albuquerque


Planning Department

Development & Building Services Division

DRAINAGE AND TRANSPORTATION INFORMATION SHEET (REV 6/2018)

Project Title: ADRIAN MARTINEZ - LOT 27 G&D	Building Permit #:	Hydrology File #: D10D003M27
DRB#:		Work Order#:
Legal Description: LOT 27, BLOCK 6, UNIT 18,	VOLCANO CLIFFS SUB'D	
City Address: 6527 PATO RD. NW, Albuquerque, N	NM 87120	
Applicant: MCDOWELL ENGINEERING, INC.		Contact: JACKIE MCDOWELL
Address: 7820 BEVERLY HILLS AVE. NE, ALBUQU	ERQUE, NM 87122	
Phone#: 505-828-2430	_ Fax#: 505-821-4857	E-mail: jackmcdowell@comcast.net
Other Contact: ADRIAN MARTINEZ		Contact: ADRIAN MARTINEZ
Address: 9320 SAGUARO ST. NW		
Phone#: 505-350-8920	_ Fax#:	E-mail: umz10@hotmail.com
TYPE OF DEVELOPMENT:PLAT	(# of lots) X RESIDENCE	DRB SITE ADMIN SITE
IS THIS A RESUBMITTAL? Yes	X No	
DEPARTMENT TRANSPORTATION	X HYDROLOGY/DRAINAGE	
Check all that Apply:	TYPE OF APPROVBUILDING PE	AL/ACCEPTANCE SOUGHT:
TYPE OF SUBMITTAL:	X CERTIFICATE	OF OCCUPANCY
X ENGINEER/ARCHITECT CERTIFICATIO PAD CERTIFICATION		
CONCEPTUAL G & D PLAN		Y PLAT APPROVAL
GRADING PLAN		OR SUB'D APPROVAL
DRAINAGE REPORT		OR BLDG. PERMIT APPROVAL
DRAINAGE MASTER PLAN	FINAL PLAT	APPROVAL
FLOODPLAIN DEVELOPMENT PERMIT A ELEVATION CERTIFICATE CLOMR/LOMR TRAFFIC GIRCHY ATTION LANGUET (TEXT	SIA/ RELEASE FOUNDATION GRADING PEI	E OF FINANCIAL GUARANTEE PERMIT APPROVAL RMIT APPROVAL
TRAFFIC CIRCULATION LAYOUT (TCL	SO-19 APPRO	VAL
TRAFFIC IMPACT STUDY (TIS) STREET LIGHT LAYOUT	PAVING PERM	MIT APPROVAL
OTHER (SPECIFY)		D CERTIFICATION
PRE-DESIGN MEETING?	WORK ORDER	
TRE-DESIGN WIEETING:	CLOMR/LOMF	
		DEVELOPMENT PERMIT
	OTHER (SPEC	ZIFY)
DATE SUBMITTED: <u>5-6-22</u>	By: JACKIE MCDOWELL	
COA STAFF:	ELECTRONIC SUBMITTAL RECEIVED:	

FEE PAID:_____

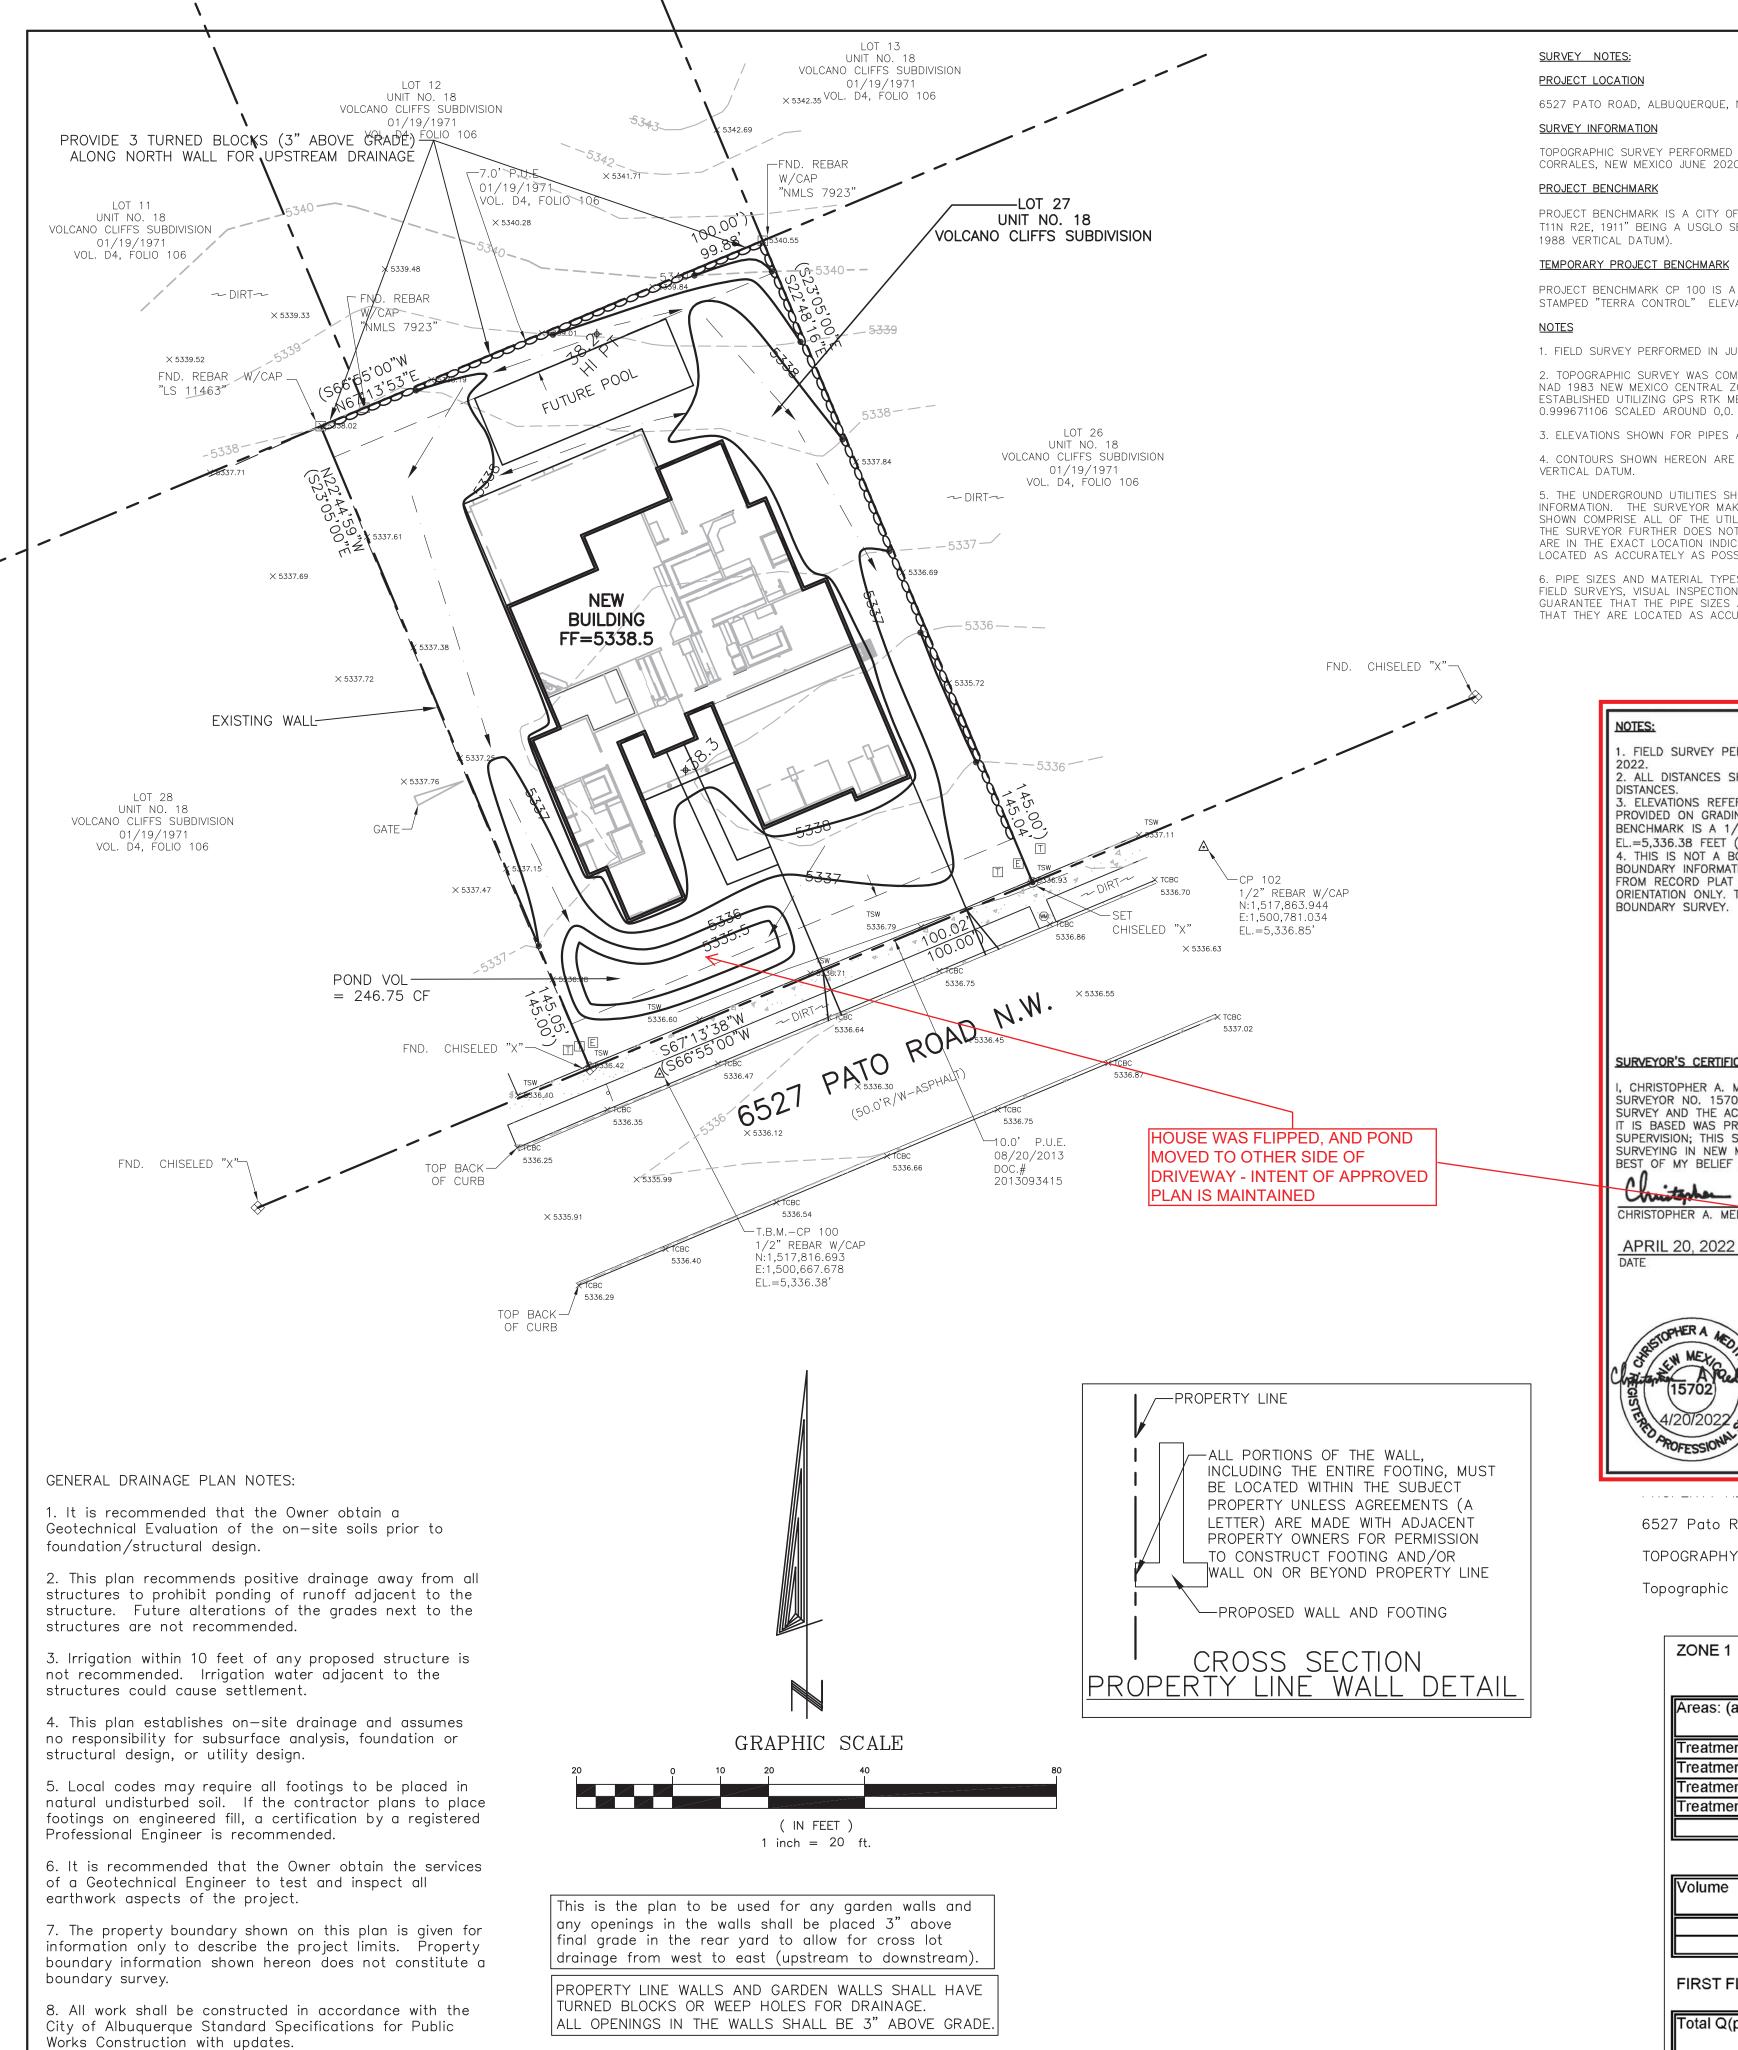

SURVEY NOTES:

PROJECT LOCATION

6527 PATO ROAD, ALBUQUERQUE, NEW MEXICO

SURVEY INFORMATION

TOPOGRAPHIC SURVEY PERFORMED AND COMPILED BY TERRA LAND SURVEYS, LLC. CORRALES, NEW MEXICO JUNE 2020.

PROJECT BENCHMARK

PROJECT BENCHMARK IS A CITY OF ALBUQUERQUE CONTROL STATION "S21, S22, S28, S27, T11N R2E, 1911" BEING A USGLO SECTION CORNER ELEVATION = 5,330.151 FEET (NAVD 1988 VERTICAL DATUM).


PROJECT BENCHMARK CP 100 IS A TERRA LAND SURVEY 1/2" REBAR WITH PLASTIC CAP STAMPED "TERRA CONTROL" ELEVATION = 5,336.38 FEET (NAVD 1988 VERTICAL DATUM).


1. FIELD SURVEY PERFORMED IN JUNE 2020. 2. TOPOGRAPHIC SURVEY WAS COMPILED UTILIZING SURFACE COORDINATES REFERENCED TO NAD 1983 NEW MEXICO CENTRAL ZONE. PRIMARY HORIZONTAL AND VERTICAL CONTROL WAS ESTABLISHED UTILIZING GPS RTK METHODS. COMBINED GROUND TO GRID FACTOR IS

3. ELEVATIONS SHOWN FOR PIPES ARE INVERT ELEVATIONS UNLESS OTHERWISE SPECIFIED. 4. CONTOURS SHOWN HEREON ARE AT A ONE FOOT INTERVAL REFERENCED TO THE NAVD 88

5. THE UNDERGROUND UTILITIES SHOWN HAVE BEEN LOCATED FROM FIELD SURVEY INFORMATION. THE SURVEYOR MAKES NO GUARANTEE THAT THE UNDERGROUND UTILITIES SHOWN COMPRISE ALL OF THE UTILITIES IN THE AREA. EITHER IN SERVICE OR ABANDONED. THE SURVEYOR FURTHER DOES NOT WARRANT THAT THE UNDERGROUND UTILITIES SHOWN ARE IN THE EXACT LOCATION INDICATED ALTHOUGH HE DOES CERTIFY THAT THEY ARE LOCATED AS ACCURATELY AS POSSIBLE FROM THE INFORMATION AVAILABLE

6. PIPE SIZES AND MATERIAL TYPES FOR MANHOLES SHOWN HAVE BEEN LOCATED FROM FIELD SURVEYS, VISUAL INSPECTIONS AND EXISTING DRAWINGS. THE SURVEYOR MAKES NO GUARANTEE THAT THE PIPE SIZES AND MATERIAL TYPES ARE EXACT BUT DOES CERTIFY THAT THEY ARE LOCATED AS ACCURATELY AS POSSIBLE FROM THE INFORMATION AVAILABLE.

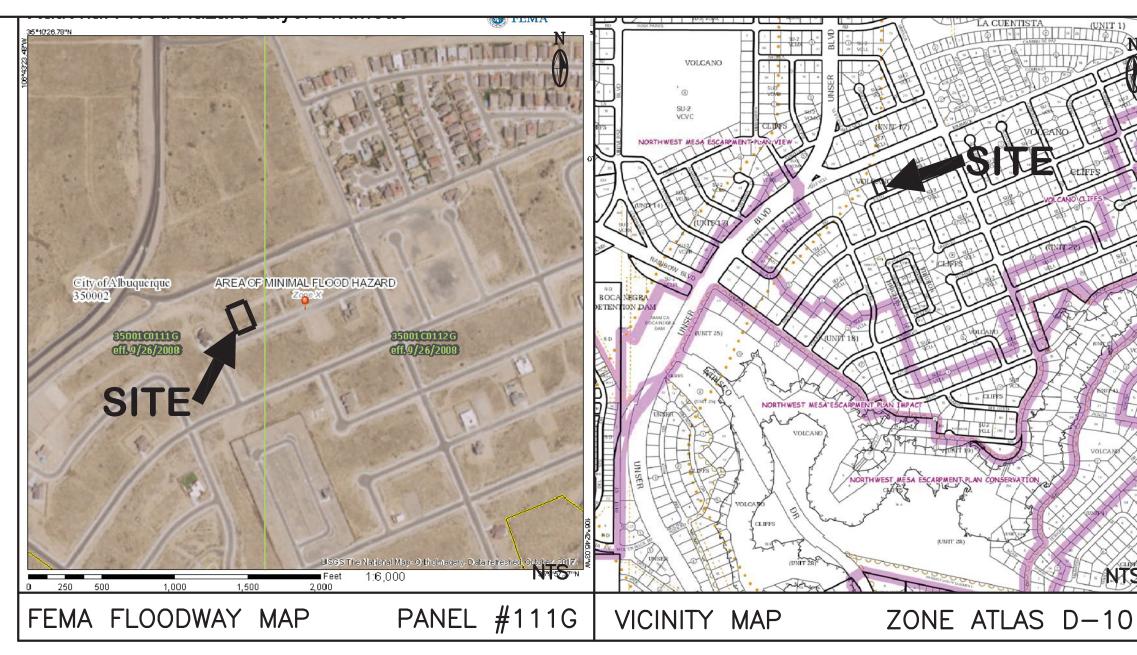

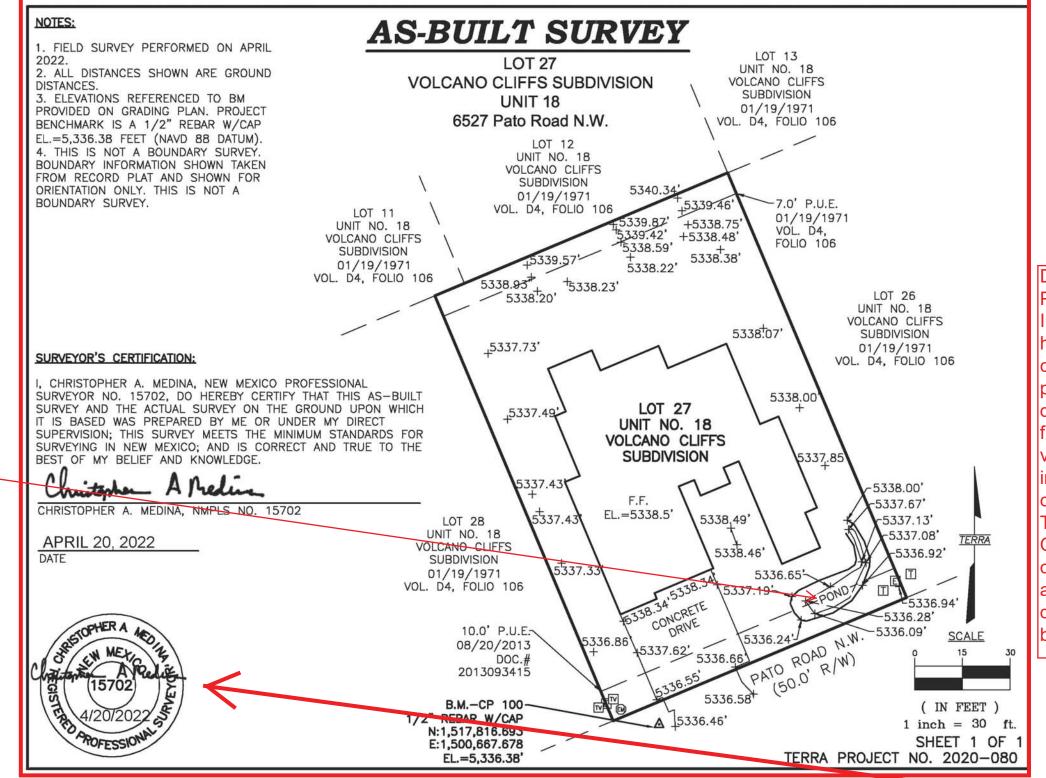

LEGEND PROPOSED **EXISTING** -----

DRAINAGE CERTIFICATION WITH SURVEY WORK BY PROFESSIONAL SURVEYOR

Jackie Mcdowell, NMPE #10903, of the firm McDowell Engineering, Inc. hereby certify that this project has been graded and will drain in substantia compliance with and in accordance with the design intent of the approved plan dated 7-9-20. The record information edited onto the original design document has been obtained by Chrisotpher Medina, NMPS #15702 of the firm Terra Land Surveys, LLC. I further certify that I have personally visited the project site on May 6, 2022 and have determined by visual inspection that the survey data provided is representative of actual site conditions and is true and correct to the best of my knowledge and belief. This certification is submitted in support of a request for Certificate of Occupancy. The record information presented hereon is not necessarily complete and intended only to verify substantial compliance of the grading and drainage aspects of this project. Those relying on the record document are advised to obtain independent verification of its accuracy before using it for any other purpose.



AS-BUILT CERTIFICATION 5-6-22

6527 Pato Rd. NW

Treatment A

reatment B

reatment C

Freatment D

TOPOGRAPHY:

Topographic information provided by Christopher Medina dated June 2020.

				P(360) =		inches	
				P(10 day) =	3.67	inches	
Areas: (acres)				1	POND VOLUME PROVIDED:		
	Existing	Proposed		ELEV.	AREA	VOL. (CF	
Treatment A		0.33	0.00		5336	663	
Treatment B		0.00	0.00				246.75
Treatment C		0.00	0.18		5335.5	324	
Treatment D		0.00	0.15				
Total (acres) =	0.33	0.33					
) / a l · · · · · a		100 year		10 year Existing	10 year Proposed	2 year Existing	2 year
Volume		Existing	Proposed	Existing	rioposeu	LAISTING	Proposed
volume	Volume (acre-feet) =	Existing 0.012 527	0.039	0.002	0.022		

Q(p)*A

Q(p)*A

0.08

0.00

0.08

Q(p)*A

0.43

0.70

0.00

0.00

Q(p)*A

Total Q (cfs) =

0.43

0.43

ENGINEER'S CERTIFICATION:

I, Jackie S. McDowell, hereby certify that I personally inspected the site shown on this plan on July 1, 2020 and as of that date it appeared that no filling, grading, or excavation had occurred thereon since completion of the topographic survey used to prepare this plan.

6527 PATO RD. NW. ALBUQUERQUE, NM 87120

CITY OF ALBUQUERQUE, BERNALILLO COUNTY

LOT 27, BLOCK 6, UNIT 18 VOLCANO CLIFFS SUBDIVISION

NEW MEXICO

MARTINEZ, ADRIAN - GRADING & DRAINAGE PLAN

McDowell Engineering, 9nc.

TELE: 505-828-2430 • FAX: 505-821-4857 Checked JSM signed JSM Drawn STAFF JULY,2020

STANDARD WALL AND PAD CERTIFICATION NOTES:

ALL PERMITER GARDEN WALLS SHALL BE PERMITTED SEPARATELY.

STANDARD GRADING NOTE: THE MAXIMUM GRADED SIDE SLOPE SHALL NOT

GRADING WHICH WILL NOT BE TREATED WITH LANDSCAPING SHALL BE SEEDED.

EXCEED 3 FEET (HORIZONTALLY) TO 1 FOOT (VERTICALLY). AREAS DISTURBED BY

silt enters the righ—of—ways during construction. A PAD CERTIFICATION IS REQUIRED BEFORE THE BUILDING PERMIT IS RELEASED. 11. Areas disturbed due to construction shall be restored

9. All work on this project shall be performed in

accordance with applicable Federal, State, and Local laws,

rules, and regulations concerning construction safety and

10. Contactor shall ensure that no site soils/sediment or

per City of Albuquerque Spec. 1012 native seed mix.