

CITY OF ALBUQUERQUE

Planning Department
Suzanne Lubar, Director



Mayor Richard J. Berry

November 29, 2017

Jackie McDowell, PE
McDowell Engineering, Inc.
7820 Beverly Hills Ave NE
Albuquerque, NM 87121

**Re: Lot 31 Block 6 Unit 18 Volcano Cliffs, S.A.D. 228
6543 Pato Rd. NW
Request Permanent C.O. – Accepted
Engineer's Stamp dated: 6-22-17 (D10D003M31)
Certification dated: 10/30/17**

Dear Ms. McDowell,

PO Box 1293

Based on the Certification received 11/29/2017, the site is acceptable for release of Certificate of Occupancy by Hydrology.

Albuquerque

If you have any questions, you can contact me at 924-3986 or Rudy Rael at 924-3977.

NM 87103

Sincerely,

www.cabq.gov

James D. Hughes, P.E.
Principal Engineer, Hydrology
Planning Department

RR/JDH

C: email

Survey Notes:
The Bearings and Distances are Record as shown on Record Plat with Horizontal Coordinates rotated to record
All monuments were found and shown on the Plot Plan
Distance measurements are at ground with units in U.S. Feet
Field Data collected using GPS-RTK techniques using an independent base station and rover
This property is subject to all easements, restrictions and reservations of record
The survey does not affect existing public or private easements whether recorded or unrecorded
This survey is not a boundary survey and does not meet the New Mexico Minimum Standards for Boundary Surveys
It may or may not reveal encroachments, overlaps, conflicts in boundary lines, shortages in area or other matters which would be disclosed by an accurate Boundary Survey
This Topographic Survey is based on previous property surveys
No monuments were set
This is not a Boundary Survey or a Right-of-Way




Apparent property corners, Right-of-Way lines or property lines as shown are Derived from Record Survey Plats, Right-of-Way Maps, or Deeds referenced hereon and are not guaranteed or to be relied on for the establishment of property lines. Elevations are based on the monument ACS BM14-D10 gathered using GPS-RTK methods and verified using a NGS-OPUS fast static solution

I, CHRISTOPHER A. MEDINA, N.M.P.L.S. NO. 15702, DO HEREBY CERTIFY THAT THE AS-BUILT INFORMATION SHOWN AND THE ACTUAL SURVEY WHICH IT WAS DERIVED FROM WAS PERFORMED BY ME OR UNDER MY DIRECT SUPERVISION AND THAT THE INFORMATION SHOWN IS TRUE AND CORRECT TO THE BEST OF MY KNOWLEDGE AND BELIEF.

Christopher A. Medina 11/22/2017
CHRISTOPHER A. MEDINA, N.M.P.L.S. NO. 15702 DATE

Topographic Survey
For Grading and Drainage
Address 6543 Pato Road NW Albuquerque, NM
Lot 31 Block 6, Volcano Cliffs, Unit 18
Albuquerque, Bernalillo County, NM
Book D4 Page 106, 01/19/1971
June 2017

STANDARD GRADING NOTE:
THE MAXIMUM GRADED SIDE SLOPE SHALL NOT EXCEED 3 FEET (HORIZONTALLY) TO 1 FOOT (VERTICALLY). AREAS DISTURBED BY GRADING WHICH WILL NOT BE TREATED WITH LANDSCAPING SHALL BE SEEDDED.

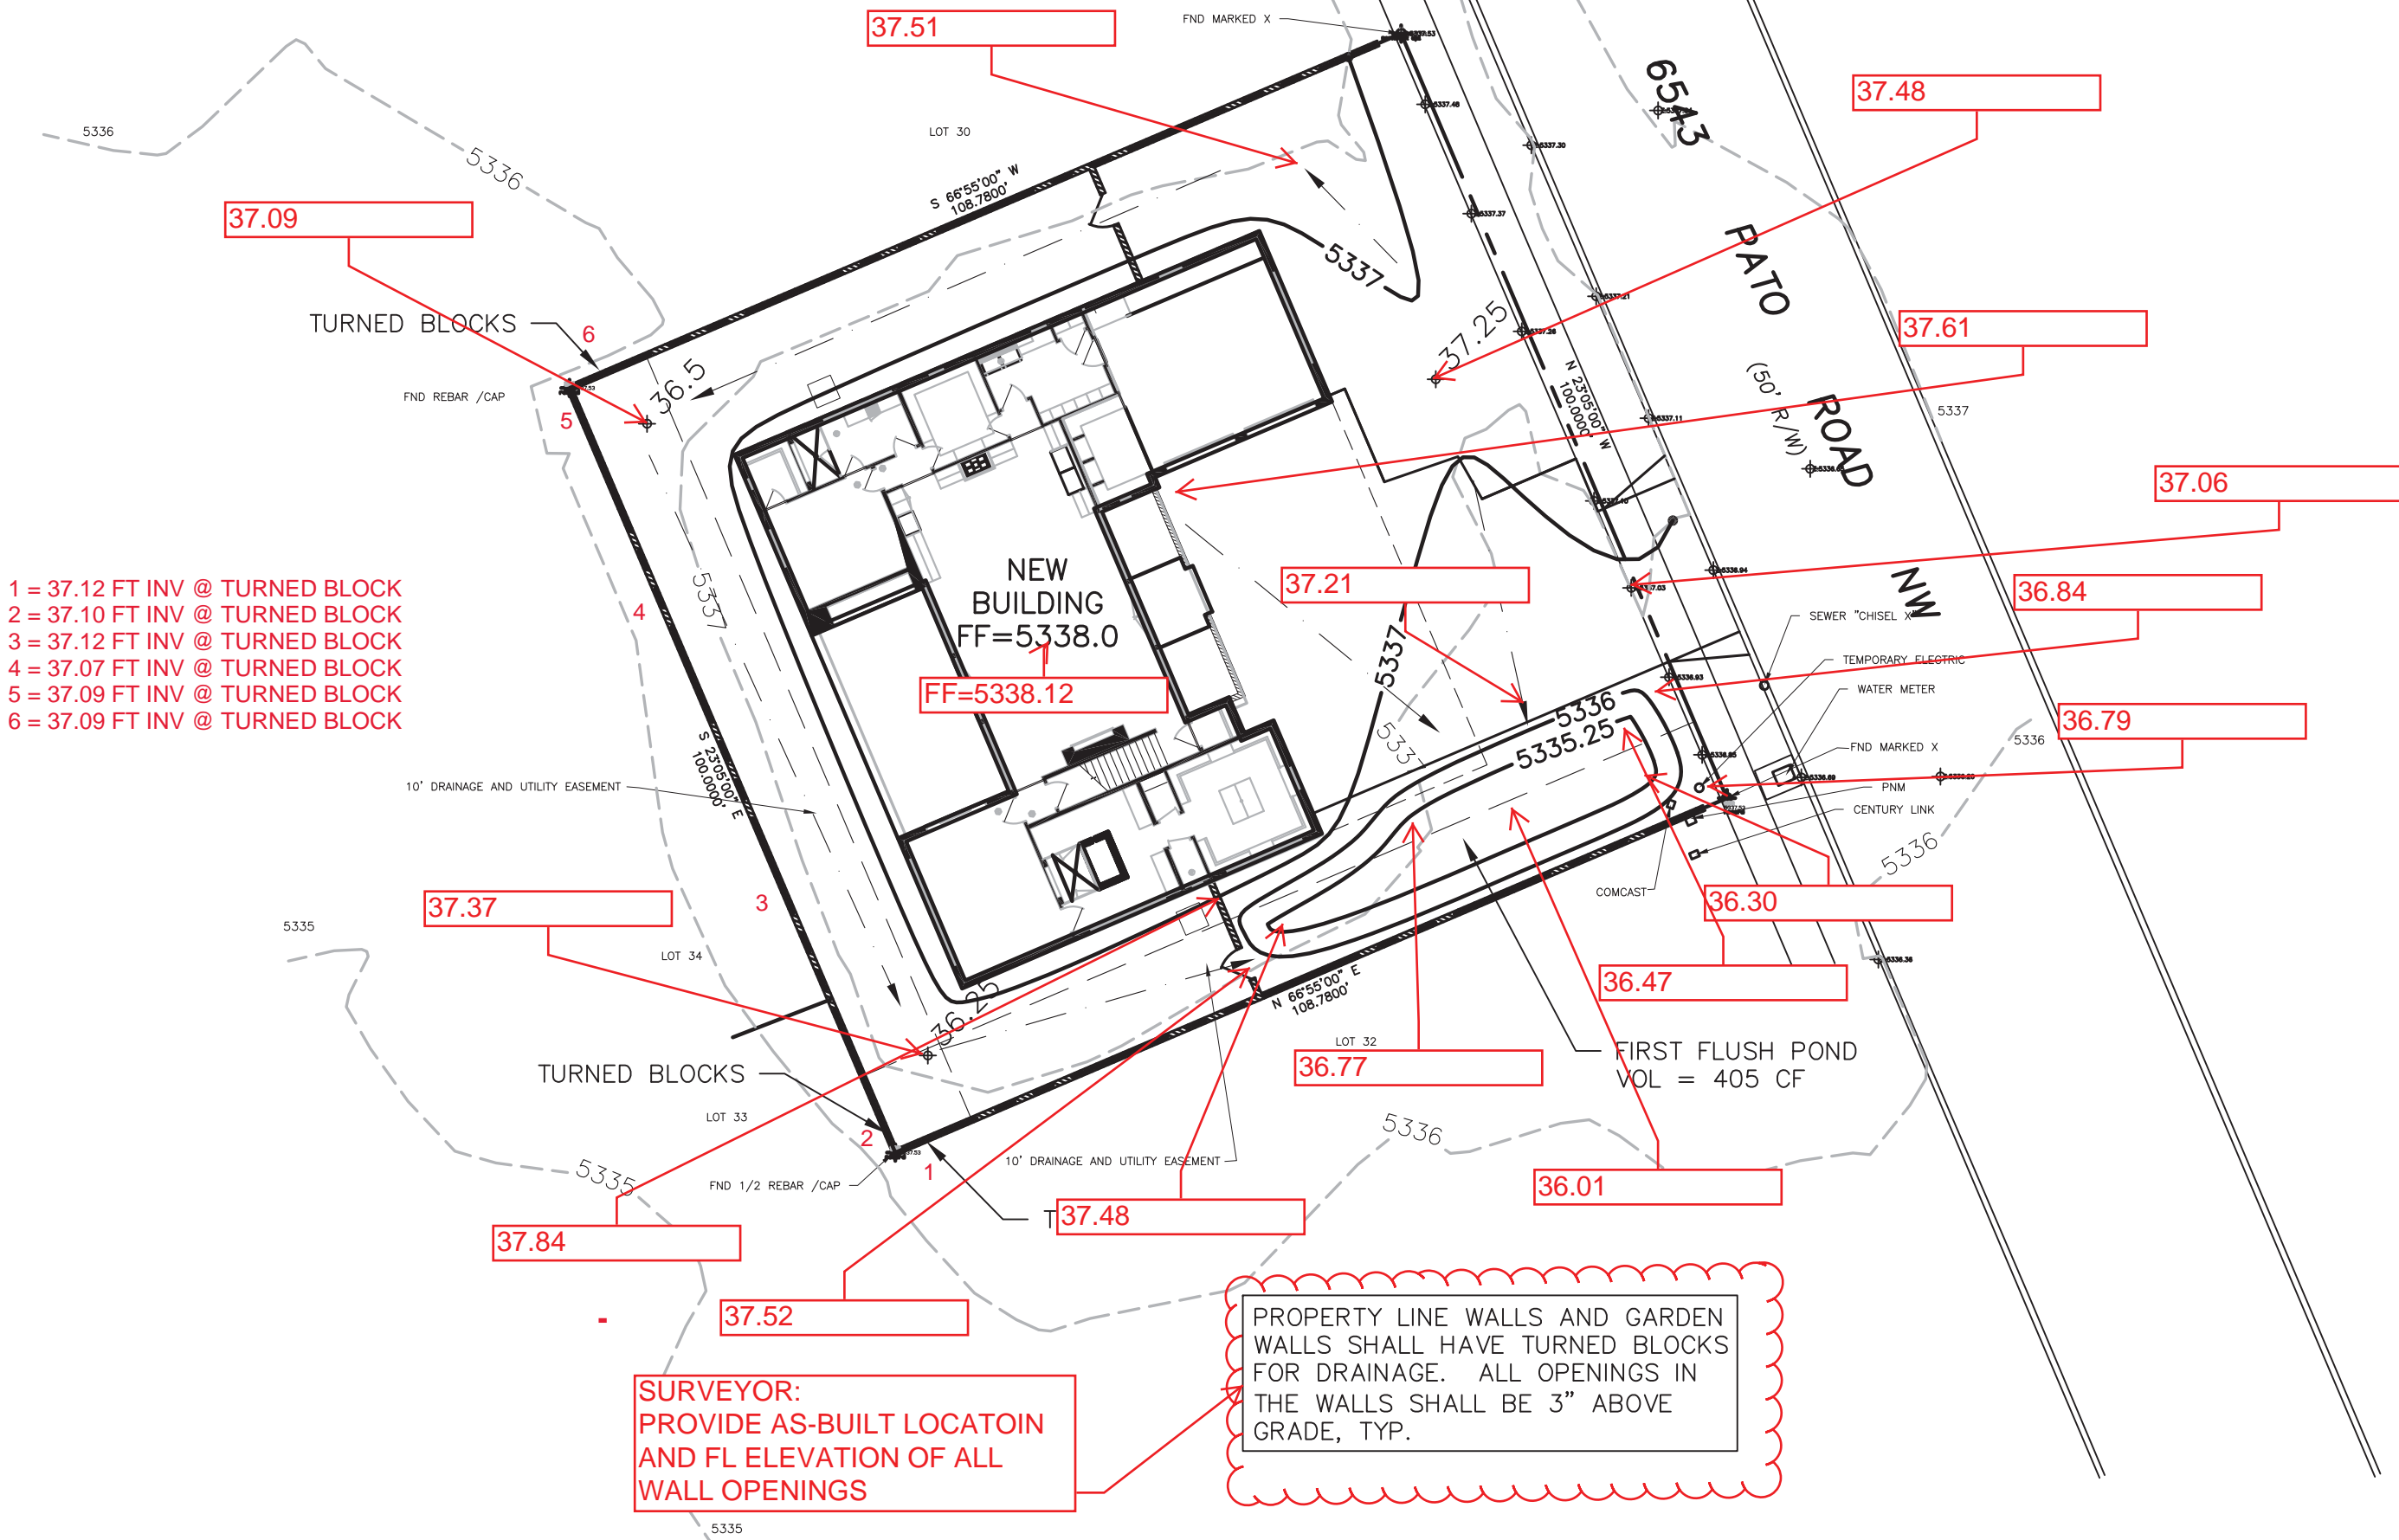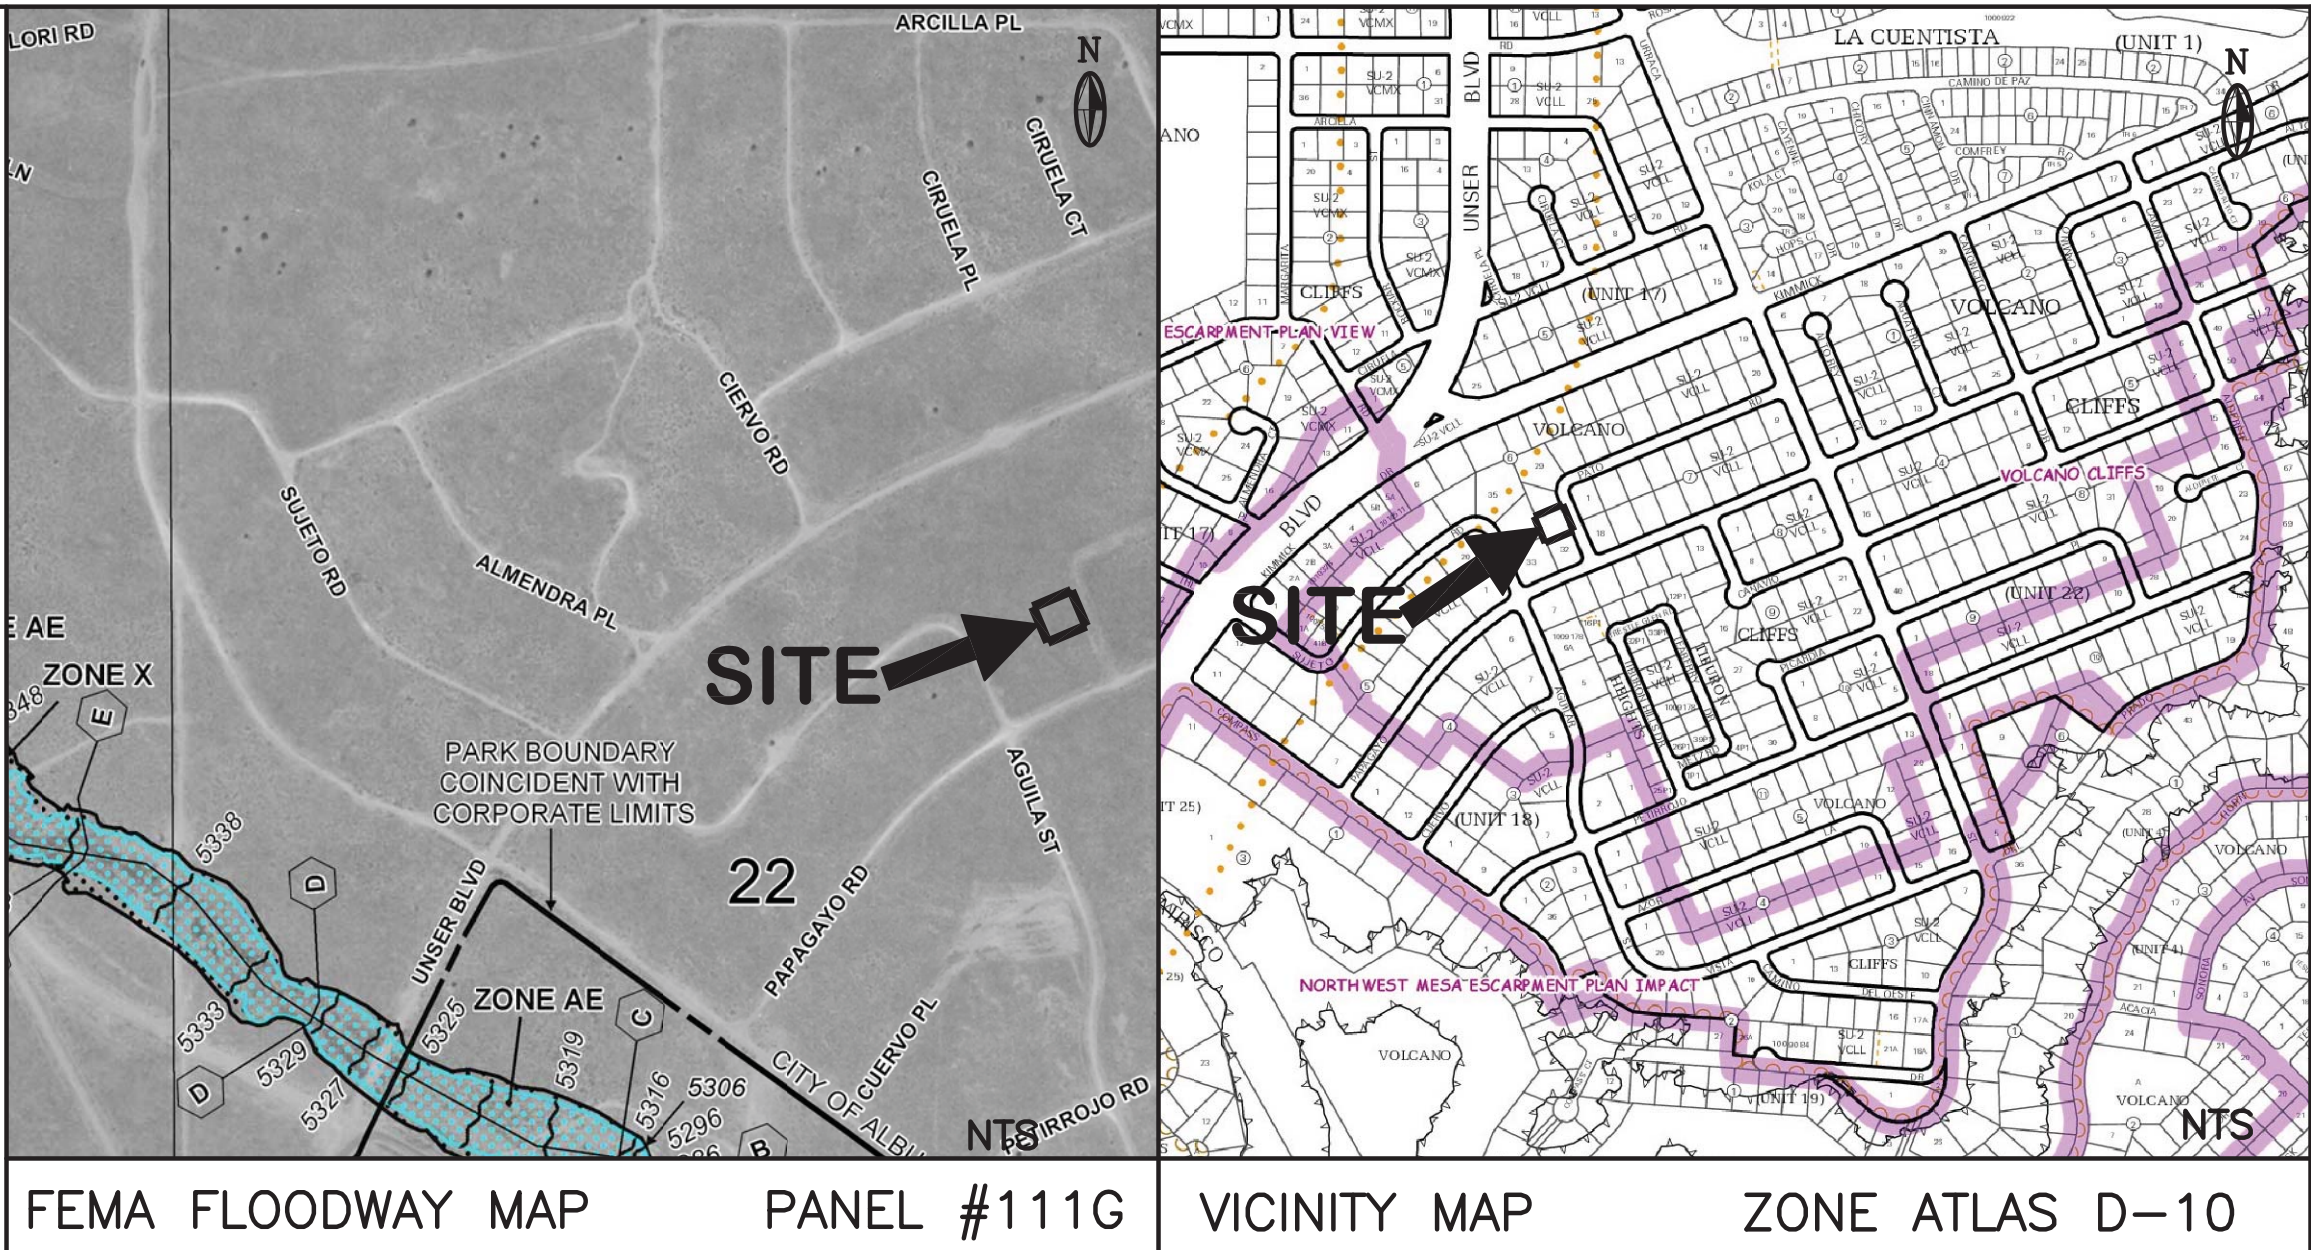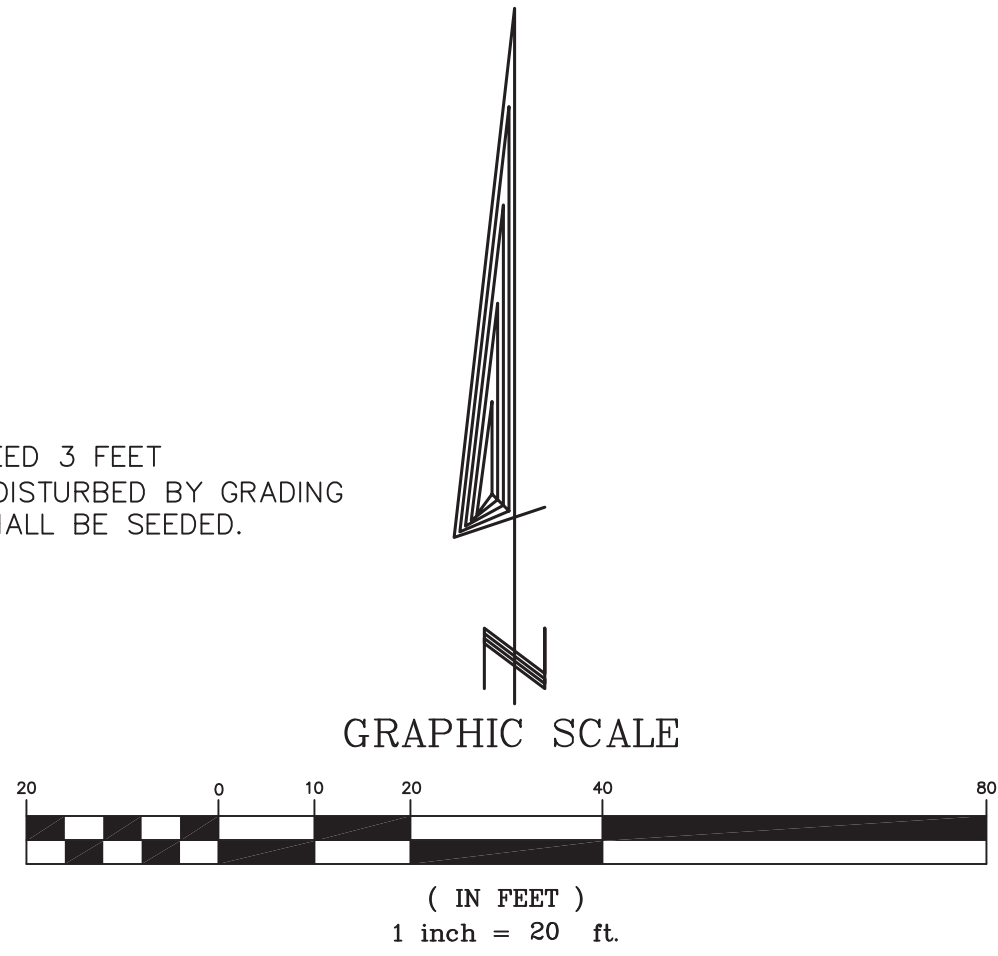


ZONE 1						
Areas: (acres)	Existing		Proposed		POND VOLUME PROVIDED:	
	Existing		Proposed		ELEV.	VOL. (CF)
Treatment A	0.25		0.00		5336	720
Treatment B	0.00		0.12			
Treatment C	0.00		0.00		5335.25	361
Treatment D	0.00		0.13			
Total (acres) =	0.25		0.25			405.375

Volume	100 year		10 year		2 year	
	Existing	Proposed	Existing	Proposed	Existing	Proposed
Volume (acre-feet) =	0.009	0.028	0.002	0.016	0.000	0.008
Volume (cubic feet) =	399	1,221	73	681	0	344

FIRST FLUSH REQUIRED POND VOL = 0.34"/(12"/FT)*(0.25AC * 43560 SF/AC) = 309 CF

Total Q(p), cfs:	100 year		10 year		2 year	
	Existing Q(p)*A	Proposed Q(p)*A	Existing Q(p)*A	Proposed Q(p)*A	Existing Q(p)*A	Proposed Q(p)*A
Treatment A	0.32	0.00	0.06	0.00	0.00	0.00
Treatment B	0.00	0.24	0.00	0.09	0.00	0.00
Treatment C	0.00	0.00	0.00	0.00	0.00	0.00
Treatment D	0.00	0.57	0.00	0.38	0.00	0.22
Total Q (cfs) =	0.32	0.81	0.06	0.47	0.00	0.22

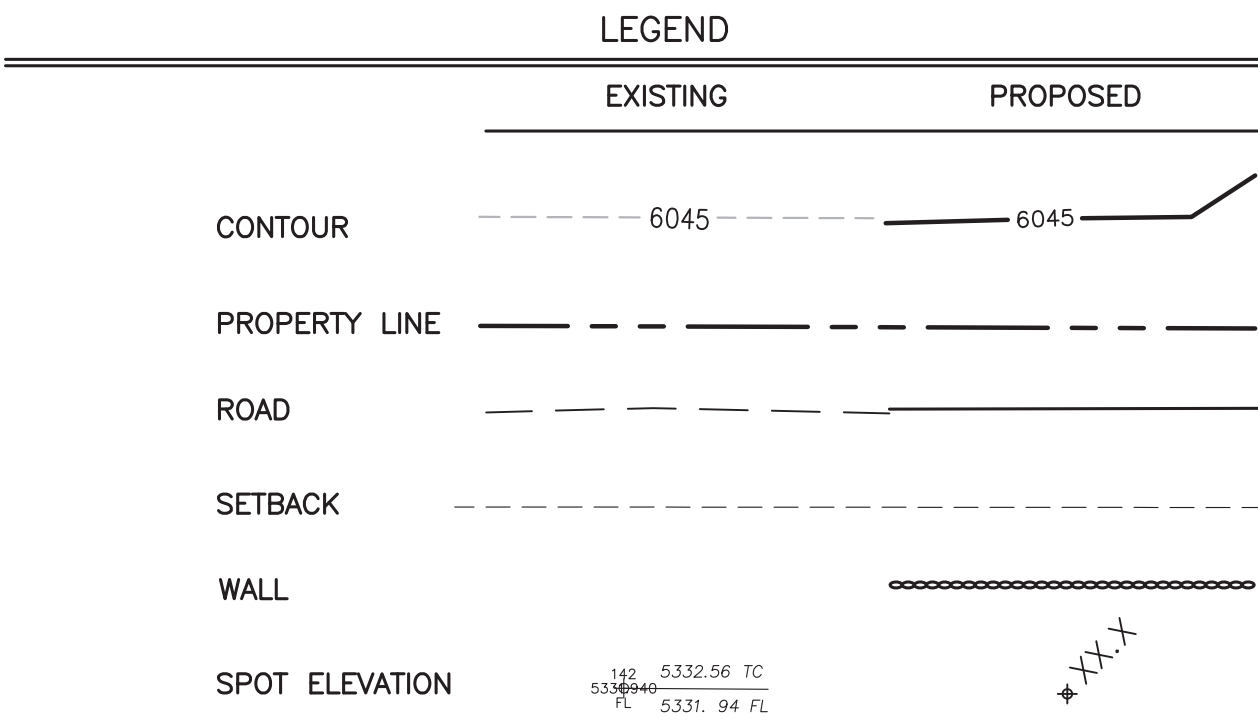

DRAINAGE CERTIFICATION WITH SURVEY WORK BY PROFESSIONAL SURVEYOR
I, Jackie McDowell, NMPE #10903, of the firm McDowell Engineering, Inc., hereby certify that this project has been graded and will drain in substantial compliance with and in accordance with the design intent of the approved plan dated 6-22-17. The record information edited onto the original design document has been obtained by Christopher Medina, NMPS #15702 of the firm Terra Land Surveys, LLC. I further certify that I have personally visited the project site on November 28, 2017 and have determined by visual inspection that the survey data provided is representative of actual site conditions and is true and correct to the best of my knowledge and belief. This certification is submitted in support of a request for Certificate of Occupancy. The record information presented hereon is not necessarily complete and intended only to verify substantial compliance of the grading and drainage aspects of this project. Those relying on the record document are advised to obtain independent verification of its accuracy before using it for any other purpose.

6-19-17
REV. 6-20-17
REV. 6-22-17
AS-BUILT CERTIFICATION 11-28-17

ENGINEER'S CERTIFICATION:
I, Jackie S. McDowell, hereby certify that I personally inspected the site shown on this plan on June 9, 2017 and as of that date it appeared that no filling, grading, or excavation had occurred thereon since completion of the topographic survey used to prepare this plan.

GENERAL DRAINAGE PLAN NOTES:

- It is recommended that the Owner obtain a Geotechnical Evaluation of the on-site soils prior to foundation/structural design.
- This plan recommends positive drainage away from all structures to prohibit ponding of runoff adjacent to the structure. Future alterations of the grades next to the structures are not recommended.
- Irrigation within 10 feet of any proposed structure is not recommended. Irrigation water adjacent to the structures could cause settlement.
- This plan establishes on-site drainage and assumes no responsibility for subsurface analysis, foundation or structural design, or utility design.
- Local codes may require all footings to be placed in natural undisturbed soil. If the contractor plans to place footings on engineered fill, a certification by a registered Professional Engineer is recommended.
- It is recommended that the Owner obtain the services of a Geotechnical Engineer to test and inspect all earthwork aspects of the project.
- The property boundary shown on this plan is given for information only to describe the project limits. Property boundary information shown hereon does not constitute a boundary survey.
- All work shall be constructed in accordance with the City of Albuquerque Standard Specifications for Public Works Construction with updates.
- All work on this project shall be performed in accordance with applicable Federal, State, and Local laws, rules, and regulations concerning construction safety and health.
- Contact shall ensure that no site soils/sediment or silt enters the right-of-ways during construction.
- Areas disturbed due to construction shall be restored per City of Albuquerque Spec. 1012 native seed mix.

DRAINAGE PLAN

SCOPE:

Pursuant to the latest City of Albuquerque and Bernalillo County Ordinances, the Drainage Plan shown hereon outlines the drainage management criteria for controlling developed runoff on and exiting the project site. A single family home is proposed for the site with associated parking, access, landscaping, and utility improvements.

EXISTING CONDITIONS:

Presently, the 0.25 acre site is undeveloped. The site is bounded on the northeast by Pato Rd. NW, and on the northwest, southwest, and southeast by private property. The site is relatively level in the center and has a gentle slope from the northwest to the southeast. Site topography slopes to the southeast. As shown on FEMA Panel #111G, the site is not located in a 100 year flood plain.

PROPOSED CONDITIONS:

Per the SAD 228 Drainage Report by Wilson & Company, drainage from the lots have been master planned to be intercepted by drainage features downstream of the properties. Current COA Drainage Ordinance requires that ponds must be provided to handle the First Flush volume which has been calculated and is included on this plan. As shown by the plan, the building is located in the center of the lot. No off-site flows enter the site due to existing grades on adjacent lots which transport offsite runoff to public streets around the site. On site flows will drain around the structure via swales, and flow to the southeast to the first flush retention pond. All roof drainage will discharge from the roof to the lot and be directed around the structure to the drainage paths and pond.

Supplemental calculations are shown as part of this Grading and Drainage plan.

CALCULATIONS:

The calculations shown hereon define the 100 year-6 hour design storm falling within the project area under existing and developed conditions. The Hydrology is per "Section 22.2, Hydrology of the Development Process Manual, Volume 2, Design Criteria, for the City of Albuquerque, New Mexico in cooperation with Bernalillo County, New Mexico and the Albuquerque Metropolitan Arroyo Flood Control Authority.

PROPERTY ADDRESS:

6543 Pato Road NW

TOPOGRAPHY:

Topographic information provided by Russell Elliott dated June, 2017.

WALL OPENING CALCULATIONS:

1 Turned Block
Weir Equation
 $Q = CLH^{3/2}$
 $Q(\max) = 0.81 \text{ cfs (total site runoff)}$
 $C=3$
 $H=0.5 \text{ ft}$
 $L=0.5 \text{ ft}$
for 1/2 block, 6" x 6" opening
 $Q=0.53 \text{ cfs capacity, so for the full block, the total block capacity} = 1.06 \text{ cfs}$
therefore, 1 turned block is adequate

STANDARD WALL AND PAD CERTIFICATION NOTES:

ALL PERMITTER GARDEN WALLS SHALL BE PERMITTED SEPARATELY.

A PAD CERTIFICATION IS REQUIRED BEFORE THE BUILDING PERMIT IS RELEASED.

This is the plan to be used for any garden walls and any openings in the walls shall be placed 3" above final grade in the rear yard to allow for cross lot drainage from west to east (upstream to downstream).



City of Albuquerque

Planning Department

Development & Building Services Division

DRAINAGE AND TRANSPORTATION INFORMATION SHEET

(REV 02/2013)

Project Title: _____ Building Permit #: _____ City Drainage #: _____

DRB#: _____ EPC#: _____ Work Order#: _____

Legal Description: _____

City Address: _____

Engineering Firm: _____ Contact: _____

Address: _____

Phone#: _____ Fax#: _____ E-mail: _____

Owner: _____ Contact: _____

Address: _____

Phone#: _____ Fax#: _____ E-mail: _____

Architect: _____ Contact: _____

Address: _____

Phone#: _____ Fax#: _____ E-mail: _____

Surveyor: _____ Contact: _____

Address: _____

Phone#: _____ Fax#: _____ E-mail: _____

Contractor: _____ Contact: _____

Address: _____

Phone#: _____ Fax#: _____ E-mail: _____

TYPE OF SUBMITTAL:

- ☐ DRAINAGE REPORT
- ☐ DRAINAGE PLAN 1st SUBMITTAL
- ☐ DRAINAGE PLAN RESUBMITTAL
- ☐ CONCEPTUAL G & D PLAN
- ☐ GRADING PLAN
- ☐ EROSION & SEDIMENT CONTROL PLAN (ESC)
- ☐ ENGINEER'S CERT (HYDROLOGY)
- ☐ CLOMR/LOMR
- ☐ TRAFFIC CIRCULATION LAYOUT (TCL)
- ☐ ENGINEER'S CERT (TCL)
- ☐ ENGINEER'S CERT (DRB SITE PLAN)
- ☐ ENGINEER'S CERT (ESC)
- ☐ SO-19
- ☐ OTHER (SPECIFY) _____

CHECK TYPE OF APPROVAL/ACCEPTANCE SOUGHT:

- ☐ SIA/FINANCIAL GUARANTEE RELEASE
- ☐ PRELIMINARY PLAT APPROVAL
- ☐ S. DEV. PLAN FOR SUB'D APPROVAL
- ☐ S. DEV. FOR BLDG. PERMIT APPROVAL
- ☐ SECTOR PLAN APPROVAL
- ☐ FINAL PLAT APPROVAL
- ☐ CERTIFICATE OF OCCUPANCY (PERM)
- ☐ CERTIFICATE OF OCCUPANCY (TCL TEMP)
- ☐ FOUNDATION PERMIT APPROVAL
- ☐ BUILDING PERMIT APPROVAL
- ☐ GRADING PERMIT APPROVAL
- ☐ PAVING PERMIT APPROVAL
- ☐ WORK ORDER APPROVAL
- ☐ GRADING CERTIFICATION
- ☐ SO-19 APPROVAL
- ☐ ESC PERMIT APPROVAL
- ☐ ESC CERT. ACCEPTANCE
- ☐ OTHER (SPECIFY) _____

WAS A PRE-DESIGN CONFERENCE ATTENDED: _____ Yes _____ No _____ Copy Provided

DATE SUBMITTED: _____ By: _____

Requests for approvals of Site Development Plans and/or Subdivision Plats shall be accompanied by a drainage submittal. The particular nature, location, and scope to the proposed development defines the degree of drainage detail. One or more of the following levels of submittal may be required based on the following:

1. **Conceptual Grading and Drainage Plan:** Required for approval of Site Development Plans greater than five (5) acres and Sector Plans
2. **Drainage Plans:** Required for building permits, grading permits, paving permits and site plans less than five (5) acres
3. **Drainage Report:** Required for subdivision containing more than ten (10) lots or constituting five (5) acres or more
4. **Erosion and Sediment Control Plan:** Required for any new development and redevelopment site with 1-acre or more of land disturbing area, including project less than 1-acre than are part of a larger common plan of development