## CITY OF ALBUQUERQUE

May 24, 2016



Steve Metro, P.E. Metro Development Inc. 8860 Desert Finch Ln NE Albuquerque, New Mexico 87122

RE: Lot 8 Block 8 Unit 18 Volcano Cliffs SAD 228 6511 Canavio Pl NW Grading and Drainage Plan Engineers Stamp Date 5/20/16 (D10D003O8)

Dear Mr. Metro,

Based upon the information provided in your submittal received 5/20/16, this plan cannot be approved for Grading Permit Revision for Retaining walls until the following comments are addressed.

• Provide flows for this property which exit out to Canavio Pl NW.

- The invert at the NE corner is incorrect; the properties to the east will not be able to release their flows as is required by the master drainage plan.
- Provide a swale from the Northeast corner to the Northwest corner, with a desiltation pond near the sidewalk culvert, unless the swale is made of gravel. The swale should be at least 1 foot away from the property line to avoid compromising the retaining.
- The retaining walls need to be certified by this Engineering Firm or another.
- Provide an as built drawing for the site since grades were changed.

If you have any questions, please contact me at 924-3986 or Rudy Rael at 924-3977.

www.cabq.gov

New Mexico 87103

PO Box 1293

Albuquerque

Abiel Carrillo, P.E.

Principal Engineer, Hydrology

Planning Department

RR/AC C: File

Sincerely,




## City of Albuquerque

## Planning Department Development & Building Services Division

DRAINAGE AND TRANSPORTATION INFORMATION SHEET (REV 69 2013)

Project Title: <u>6511 (anavio PL, NW G+DRE</u> DRB#: EPC#:	Work Order∓:
egal Description: Lot 8, Block 8, Unit 18 VC	
Tity Address: 6511 Canavis PL, NW	
Engineering Firm: Metro Development Inc	Contact: Stew Mctro
Address: 8860 Donet First 1 at	5100011000
Phone#: 505 - 281 · 4553 Fax#:	E-mail: Metro Metro development &
Owner: _ America Home Realty	- 1/
Address: 1912 San Breage Sh, No	Contact: Mia Huynh
	503-7842 F-mail mh. 1. 1 2 4 . 1
Architect:	503. 7842 E-mail mhuyst à concert. 10
Address:	Contact:
Phone#: Fax#:	E-mail:
	L-man:
Other Contact: Address:	Contact:
The section of the se	E-mail:
EPARTMENT:  HYDROLOGY/ DRAINAGE	CHECK TYPE OF APPROVAL/ACCEPTANCE SOUGHT:
DEPARTMENT:  METERINA HYDROLOGY/ DRAINAGE  TRAFFIC/ TRANSPORTATION  MS4/ EROSION & SEDIMENT CONTROL	BUILDING PERMIT APPROVAL CERTIFICATE OF OCCUPANCY
DEPARTMENT:  METERINA HYDROLOGY/ DRAINAGE  TRAFFIC/ TRANSPORTATION  MS4/ EROSION & SEDIMENT CONTROL	BUILDING PERMIT APPROVAL CERTIFICATE OF OCCUPANCY  PRELIMINARY -PLAT APPROVAL SITE PLAN FOR SUB'D APPROVAL
DEPARTMENT:  HYDROLOGY/ DRAINAGE TRAFFIC/ TRANSPORTATION MS4/ EROSION & SEDIMENT CONTROL  YPE OF SUBMITTAL: ENGINEER/ ARCHITECT CERTIFICATION  CONCEPTUAL G & D PLAN	BUILDING PERMIT APPROVAL CERTIFICATE OF OCCUPANCY  PRELIMINARY -PLAT APPROVAL SITE PLAN FOR SUB'D APPROVAL SITE PLAN FOR BLDG. PERMIT APPROVAL
DEPARTMENT:  X HYDROLOGY/ DRAINAGE  TRAFFIC/ TRANSPORTATION  MS4/ EROSION & SEDIMENT CONTROL  TYPE OF SUBMITTAL:  ENGINEER/ ARCHITECT CERTIFICATION  CONCEPTUAL G & D PLAN  GRADING PLAN	BUILDING PERMIT APPROVAL CERTIFICATE OF OCCUPANCY  PRELIMINARY -PLAT APPROVAL SITE PLAN FOR SUB'D APPROVAL SITE PLAN FOR BLDG. PERMIT APPROVAL FINAL PLAT APPROVAL
DEPARTMENT:  X HYDROLOGY/ DRAINAGE  TRAFFIC/ TRANSPORTATION  MS4/ EROSION & SEDIMENT CONTROL  TYPE OF SUBMITTAL:  ENGINEER/ ARCHITECT CERTIFICATION  CONCEPTUAL G & D PLAN  GRADING PLAN  DRAINAGE MASTER PLAN	BUILDING PERMIT APPROVAL CERTIFICATE OF OCCUPANCY  PRELIMINARY -PLAT APPROVAL SITE PLAN FOR SUB'D APPROVAL SITE PLAN FOR BLDG. PERMIT APPROVAL
DEPARTMENT:  HYDROLOGY/ DRAINAGE TRAFFIC/ TRANSPORTATION MS4/ EROSION & SEDIMENT CONTROL  YPE OF SUBMITTAL: ENGINEER/ ARCHITECT CERTIFICATION  CONCEPTUAL G & D PLAN GRADING PLAN DRAINAGE MASTER PLAN DRAINAGE REPORT	BUILDING PERMIT APPROVAL CERTIFICATE OF OCCUPANCY
TRAFFIC/ TRANSPORTATION  MS4/ EROSION & SEDIMENT CONTROL  TYPE OF SUBMITTAL: ENGINEER/ ARCHITECT CERTIFICATION  CONCEPTUAL G & D PLAN GRADING PLAN  DRAINAGE MASTER PLAN	BUILDING PERMIT APPROVAL CERTIFICATE OF OCCUPANCY  PRELIMINARY -PLAT APPROVAL SITE PLAN FOR SUB'D APPROVAL SITE PLAN FOR BLDG. PERMIT APPROVAL FINAL PLAT APPROVAL SIA/ RELEASE OF FINANCIAL GUARANTEE FOUNDATION PERMIT APPROVAL GRADING PERMIT APPROVAL SO-19 APPROVAL
DEPARTMENT:  HYDROLOGY/ DRAINAGE TRAFFIC/ TRANSPORTATION MS4/ EROSION & SEDIMENT CONTROL  YPE OF SUBMITTAL: ENGINEER/ ARCHITECT CERTIFICATION  CONCEPTUAL G & D PLAN GRADING PLAN DRAINAGE MASTER PLAN DRAINAGE REPORT	BUILDING PERMIT APPROVAL CERTIFICATE OF OCCUPANCY  PRELIMINARY -PLAT APPROVAL SITE PLAN FOR SUB'D APPROVAL SITE PLAN FOR BLDG. PERMIT APPROVAL FINAL PLAT APPROVAL SIA/ RELEASE OF FINANCIAL GUARANTEE FOUNDATION PERMIT APPROVAL GRADING PERMIT APPROVAL SO-19 APPROVAL PAVING PERMIT APPROVAL
DEPARTMENT:  HYDROLOGY/ DRAINAGE TRAFFIC/ TRANSPORTATION MS4/ EROSION & SEDIMENT CONTROL  TYPE OF SUBMITTAL: ENGINEER/ ARCHITECT CERTIFICATION  CONCEPTUAL G & D PLAN GRADING PLAN DRAINAGE MASTER PLAN DRAINAGE REPORT CLOMIZIOMR  TRAFFIC CIRCULATION LAYOUT (TCL) TRAFFIC IMPACT STUDY (TIS)	BUILDING PERMIT APPROVAL CERTIFICATE OF OCCUPANCY  PRELIMINARY -PLAT APPROVAL SITE PLAN FOR SUB'D APPROVAL SITE PLAN FOR BLDG. PERMIT APPROVAL FINAL PLAT APPROVAL SIA/ RELEASE OF FINANCIAL GUARANTEE FOUNDATION PERMIT APPROVAL GRADING PERMIT APPROVAL SO-19 APPROVAL PAVING PERMIT APPROVAL GRADING/ PAD CERTIFICATION
DEPARTMENT:  X HYDROLOGY/ DRAINAGE  TRAFFIC/ TRANSPORTATION  MISH EROSION & SEDIMENT CONTROL  TYPE OF SUBMITTAL:  ENGINEER/ ARCHITECT CERTIFICATION  CONCEPTUAL G & D PLAN  GRADING PLAN  DRAINAGE MASTER PLAN  DRAINAGE REPORT  CLOMR/LOMR	BUILDING PERMIT APPROVAL CERTIFICATE OF OCCUPANCY  PRELIMINARY -PLAT APPROVAL SITE PLAN FOR SUB'D APPROVAL SITE PLAN FOR BLDG. PERMIT APPROVAL FINAL PLAT APPROVAL SIAV RELEASE OF FINANCIAL GUARANTEE FOUNDATION PERMIT APPROVAL GRADING PERMIT APPROVAL SO-19 APPROVAL PAVING PERMIT APPROVAL
EPARTMENT:  HYDROLOGY/ DRAINAGE TRAFFIC/ TRANSPORTATION MS4/ EROSION & SEDIMENT CONTROL  YPE OF SUBMITTAL: ENGINEER/ ARCHITECT CERTIFICATION  CONCEPTUAL G & D PLAN GRADING PLAN DRAINAGE MASTER PLAN DRAINAGE REPORT CLOMR/LOMR  TRAFFIC CIRCULATION LAYOUT (TCL) TRAFFIC IMPACT STUDY (TIS) EROSION & SEDIMENT CONTROL PLAN (ESC)	BUILDING PERMIT APPROVAL  CERTIFICATE OF OCCUPANCY  PRELIMINARY -PLAT APPROVAL  SITE PLAN FOR SUB'D APPROVAL  SITE PLAN FOR BLDG. PERMIT APPROVAL  FINAL PLAT APPROVAL  SIA/ RELEASE OF FINANCIAL GUARANTEE  FOUNDATION PERMIT APPROVAL  GRADING PERMIT APPROVAL  SO-19 APPROVAL  PAVING PERMIT APPROVAL  GRADING/ PAD CERTIFICATION  WORK ORDER APPROVAL  CLOMR/LOMR  PRE-DESIGN MEETING
DEPARTMENT:  HYDROLOGY/ DRAINAGE TRAFFIC/ TRANSPORTATION MS4/ EROSION & SEDIMENT CONTROL  TYPE OF SUBMITTAL: ENGINEER/ ARCHITECT CERTIFICATION  CONCEPTUAL G & D PLAN GRADING PLAN DRAINAGE MASTER PLAN DRAINAGE REPORT CLOMIZIOMR  TRAFFIC CIRCULATION LAYOUT (TCL) TRAFFIC IMPACT STUDY (TIS)	BUILDING PERMIT APPROVAL CERTIFICATE OF OCCUPANCY  PRELIMINARY -PLAT APPROVAL SITE PLAN FOR SUB'D APPROVAL SITE PLAN FOR BLDG. PERMIT APPROVAL FINAL PLAT APPROVAL SIA/ RELEASE OF FINANCIAL GUARANTEE FOUNDATION PERMIT APPROVAL GRADING PERMIT APPROVAL SO-19 APPROVAL PAVING PERMIT APPROVAL GRADING/ PAD CERTIFICATION WORK ORDER APPROVAL CLOMR/LOMR

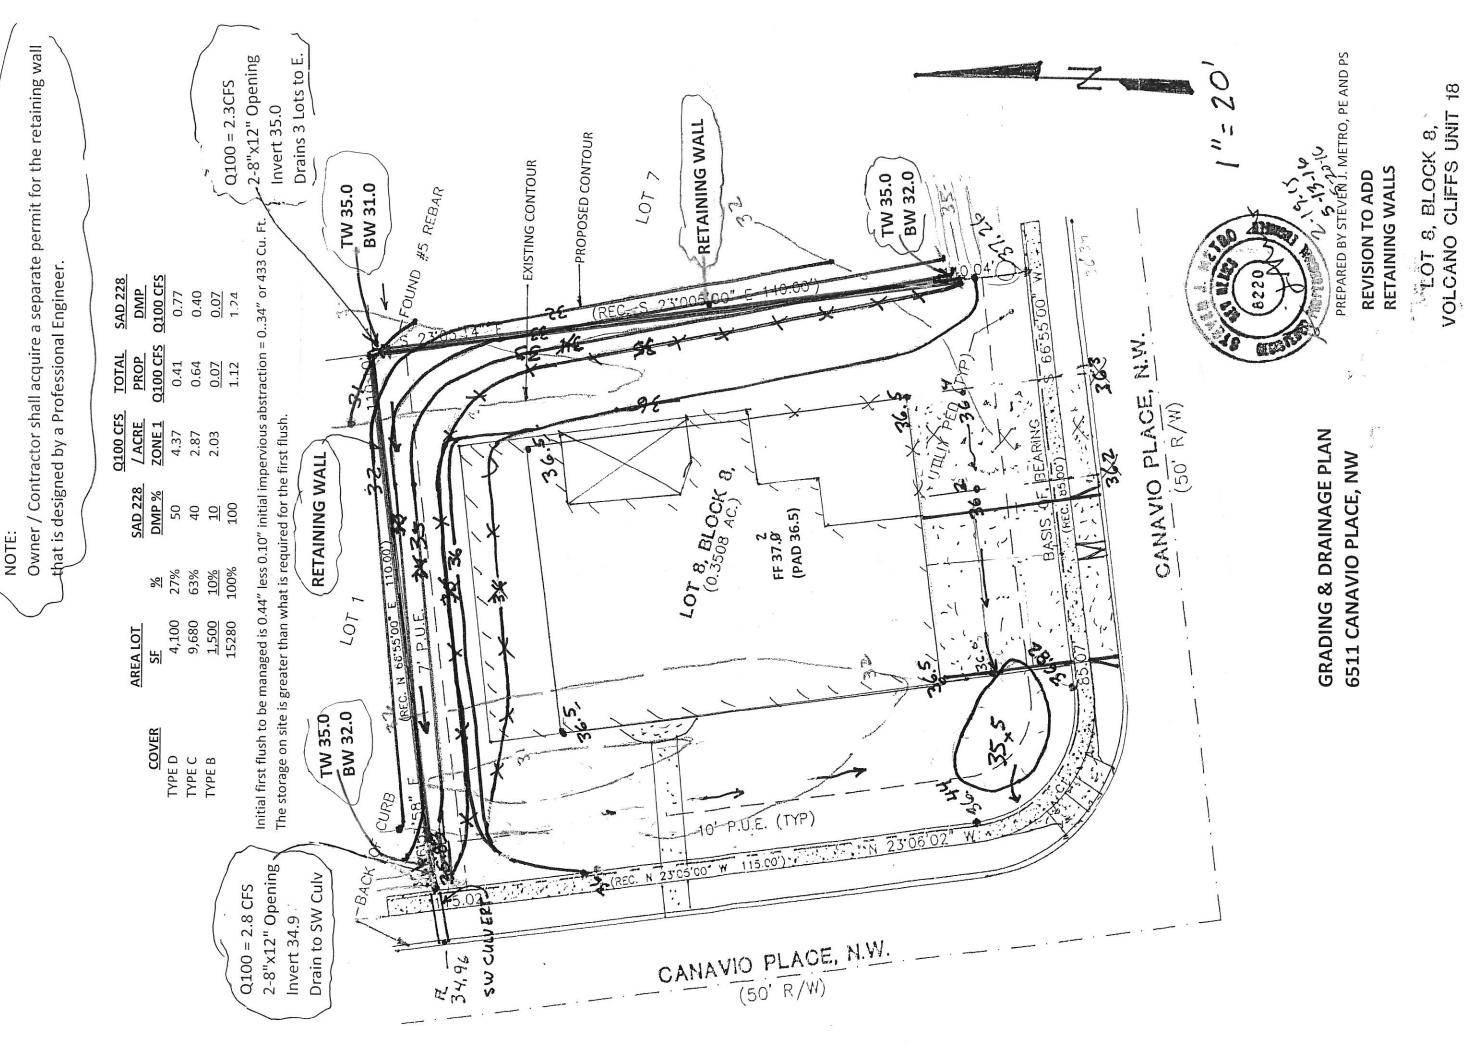

BERNALILLO COUNTY, NEW-MEXICO

CITY OF ALBUQUERQUE