

CITY OF ALBUQUERQUE

Planning Department
Alan Varela, Director



Mayor Timothy M. Keller

September 20, 2024

Shawn Biazar, P.E.
SBS Construction and Engineering, LLC
7632 William Moyers Avenue, NE
Albuquerque, NM 87114

**RE: 6505 Petirrojo NW
Permanent C.O. – Accepted
Engineer’s Certification Dated 9/16/2024
Engineer’s Stamp Date: 01/23/2024
Hydrology File: D10D003P6**

Dear Mr. Soule:

PO Box 1293

Based on the Certification received 09/17/2024 and site visit on 09/20/2024, this letter serves as a “green tag” from Hydrology Section for a Permanent Certificate of Occupancy to be issued by the Building and Safety Division.

Albuquerque

If you have any questions, please contact me at 505-924-3314 or amontoya@cabq.gov.

NM 87103

Sincerely,

www.cabq.gov

Anthony Montoya, Jr., P.E.
Senior Engineer, Hydrology
Planning Department, Development Review Services



City of Albuquerque

Planning Department
Development & Building Services Division

DRAINAGE AND TRANSPORTATION INFORMATION SHEET (REV 6/2018)

Project Title: 6505 PETIRROJO RD., NW Building Permit #: _____ Hydrology File #: D10D003P6
DRB#: _____ EPC#: _____ Work Order#: _____
Legal Description: Lot 6, Block 10, Volcano Cliffs Unit 18
City Address: 6505 PETIRROJO RD., NW

Applicant: SBS CONSTRUCTION AND ENGINEERING, LLC Contact: SHAWN BIAZAR
Address: 7632 William Moyers Avenue, NE, ALBUQUERQUE, NM 87114
Phone#: (505) 804-5013 Fax#: (505) 897-4996 E-mail: AECLLC@AOL.COM

Other Contact: _____ Contact: _____
Address: _____
Phone#: _____ Fax#: _____ E-mail: _____

TYPE OF DEVELOPMENT: _____ PLAT (# of lots) RESIDENCE _____ DRB SITE _____ ADMIN SITE

IS THIS A RESUBMITTAL? _____ Yes No

DEPARTMENT _____ TRANSPORTATION HYDROLOGY/DRAINAGE

Check all that Apply:

TYPE OF SUBMITTAL:

- ENGINEER/ARCHITECT CERTIFICATION
- _____ PAD CERTIFICATION
- _____ CONCEPTUAL G & D PLAN
- _____ GRADING PLAN
- _____ DRAINAGE REPORT
- _____ DRAINAGE MASTER PLAN
- _____ FLOODPLAIN DEVELOPMENT PERMIT APPLIC
- _____ ELEVATION CERTIFICATE
- _____ CLOMR/LOMR
- _____ TRAFFIC CIRCULATION LAYOUT (TCL)
- _____ TRAFFIC IMPACT STUDY (TIS)
- _____ STREET LIGHT LAYOUT
- _____ OTHER (SPECIFY) _____
- _____ PRE-DESIGN MEETING?

TYPE OF APPROVAL/ACCEPTANCE SOUGHT:

- _____ BUILDING PERMIT APPROVAL
- CERTIFICATE OF OCCUPANCY
- _____ PRELIMINARY PLAT APPROVAL
- _____ SITE PLAN FOR SUB'D APPROVAL
- _____ SITE PLAN FOR BLDG. PERMIT APPROVAL
- _____ FINAL PLAT APPROVAL
- _____ SIA/ RELEASE OF FINANCIAL GUARANTEE
- _____ FOUNDATION PERMIT APPROVAL
- _____ GRADING PERMIT APPROVAL
- _____ SO-19 APPROVAL
- _____ PAVING PERMIT APPROVAL
- _____ GRADING/ PAD CERTIFICATION
- _____ WORK ORDER APPROVAL
- _____ CLOMR/LOMR
- _____ FLOODPLAIN DEVELOPMENT PERMIT
- _____ OTHER (SPECIFY) _____

DATE SUBMITTED: 9/17/2024 By: SHAWN BIAZAR

COA STAFF: _____

ELECTRONIC SUBMITTAL RECEIVED: _____

FEE PAID: _____

Location

This project is located at 6505 Petirrojo Road, NW and contains 0.3214 acre. See attached portion of Vicinity Map D-10-Z for exact location.

Purpose

The purpose of this drainage report is to present a grading and drainage solution for the new pool on this lot.

Existing Drainage Conditions

This project falls within SAD 228 master drainage plan. This lot drains from south to north. No offsite runoff enters this site. There is existing retaining wall on the west property line.

Proposed Conditions and On-Site Drainage Management Plan

A new retaining wall is proposed for the back property line and to drain the water into Petirrojo road, NW. The allowable discharge volume based on the 100-year/10 Day volume is 2,844.33 cf and 100-year/10 Day volume under the proposed conditions is 2,818.65 cf. Therefore, there are no ponding required since allowable is greater than proposed. The first flush volume ponding requirement is 239.60 cf. The actual ponding volume provided is 334.40 cf.

VOLUME CALCULATIONS

BASIN	AREA (SF)	AREA (AC)	AREA (MI ²)
ON-SITE	14,000.00	0.3214	0.000502

$$E = \frac{EA(AA) + EB(AB) + EC(AC) + ED(AD)}{AA + AB + AC + AD}$$

$$V-360 = E (AA + AB + AC + AD) / 12$$

$$V-24HR \text{ HOUR} = V-360 + AD (P-1440 - P-360) / 12$$

- EA = 0.55
- EB = 0.73
- EC = 0.95
- ED = 2.24

- P-60 = 1.69
- P-360 = 2.17
- P-1440 = 2.49
- P-10 Day = 3.90

ALLOWABLE CONDITIONS	PROPOSED CONDITIONS
AA = 0.00%	AA = 0.00%
AB = 10.00%	AB = 20.00%
AC = 40.00%	AC = 30.00%
AD = 50.00%	AD = 50.00%
E = 1.5730 IN	E = 1.5510 IN
V-360 = 0.0421 AC-FT	V-360 = 0.0415 AC-FT
V-360 = 1,835.17 CF	V-360 = 1,809.50 CF
AD = 0.1607 AC	AD = 0.0709 AC
V-10 Day = 0.0653 AC-FT	V-10 Day = 0.0647 AC-FT
V-10 Day = 2,844.33 CF	V-10 Day = 2,818.67 CF

FIRST FLUSH PONDING REQUIREMENT

IMPERVIOUS AREA = 6,841.00 SF
 FIRST FLUSH VOL. REQI. = 0.42" x 6,841.00 / 12 = 239.61 CF

PONDING VOLUME CALCULATION

TOTAL POND AREA PROVIDED = PONDING CALCULATIONS:

POND A:
 AREA @ ELEV. 38.20 = 452.67 SF
 AREA @ ELEV. 37.60 = 200.00 SF
 POND VOLUME = (452.67 + 200.00) / 2 * 0.60 = 195.80 CF


POND B:
 AREA @ ELEV. 38.25 = 360.00 SF
 AREA @ ELEV. 37.65 = 102.00 SF
 POND VOLUME = (360.00 + 102.00) / 2 * 0.60 = 138.60 CF
 TOTAL PONDING VOLUME PROVIDED = 195.80 + 138.60 = 334.40 CF

DRAINAGE CERTIFICATION

I, REZA AFAGHPUR, NMPE 11814, OF SBS CONSTRUCTION AND ENGINEERING, LLC, HEREBY CERTIFY THAT THIS PROJECT HAS BEEN GRADED AND WILL DRAIN IN SUBSTANTIAL COMPLIANCE WITH AND IN ACCORDANCE WITH THE DESIGN INTENT OF THE APPROVED PLAN DATED 01-23-2024. THE RECORD INFORMATION EDITED ONTO THE ORIGINAL DESIGN DOCUMENT HAS BEEN OBTAINED BY NMPS 9801 LEONARD MARTINEZ, OF SBS CONSTRUCTION AND ENGINEERING. I FURTHER CERTIFY THAT I HAVE PERSONALLY VISITED THE PROJECT SITE ON AND HAVE DETERMINED BY VISUAL INSPECTION THAT THE SURVEY DATA PROVIDED IS REPRESENTATIVE OF ACTUAL SITE CONDITIONS AND IS TRUE AND CORRECT TO THE BEST OF MY KNOWLEDGE AND BELIEF. THIS CERTIFICATION IS SUBMITTED IN SUPPORT OF A REQUEST FOR FINAL CERTIFICATE OF OCCUPANCY.



THE RECORD INFORMATION PRESENTED HEREON IS NOT NECESSARILY COMPLETE AND INTENDED ONLY TO VERIFY SUBSTANTIAL COMPLIANCE OF THE GRADING AND DRAINAGE ASPECTS OF THIS PROJECT. THOSE RELYING ON THIS RECORD DOCUMENT ARE ADVISED TO OBTAIN INDEPENDENT VERIFICATION OF ITS ACCURACY BEFORE USING IT FOR ANY OTHER PURPOSE.

REZA AFAGHPUR, NMPE 11814 DATE 9/16/2024

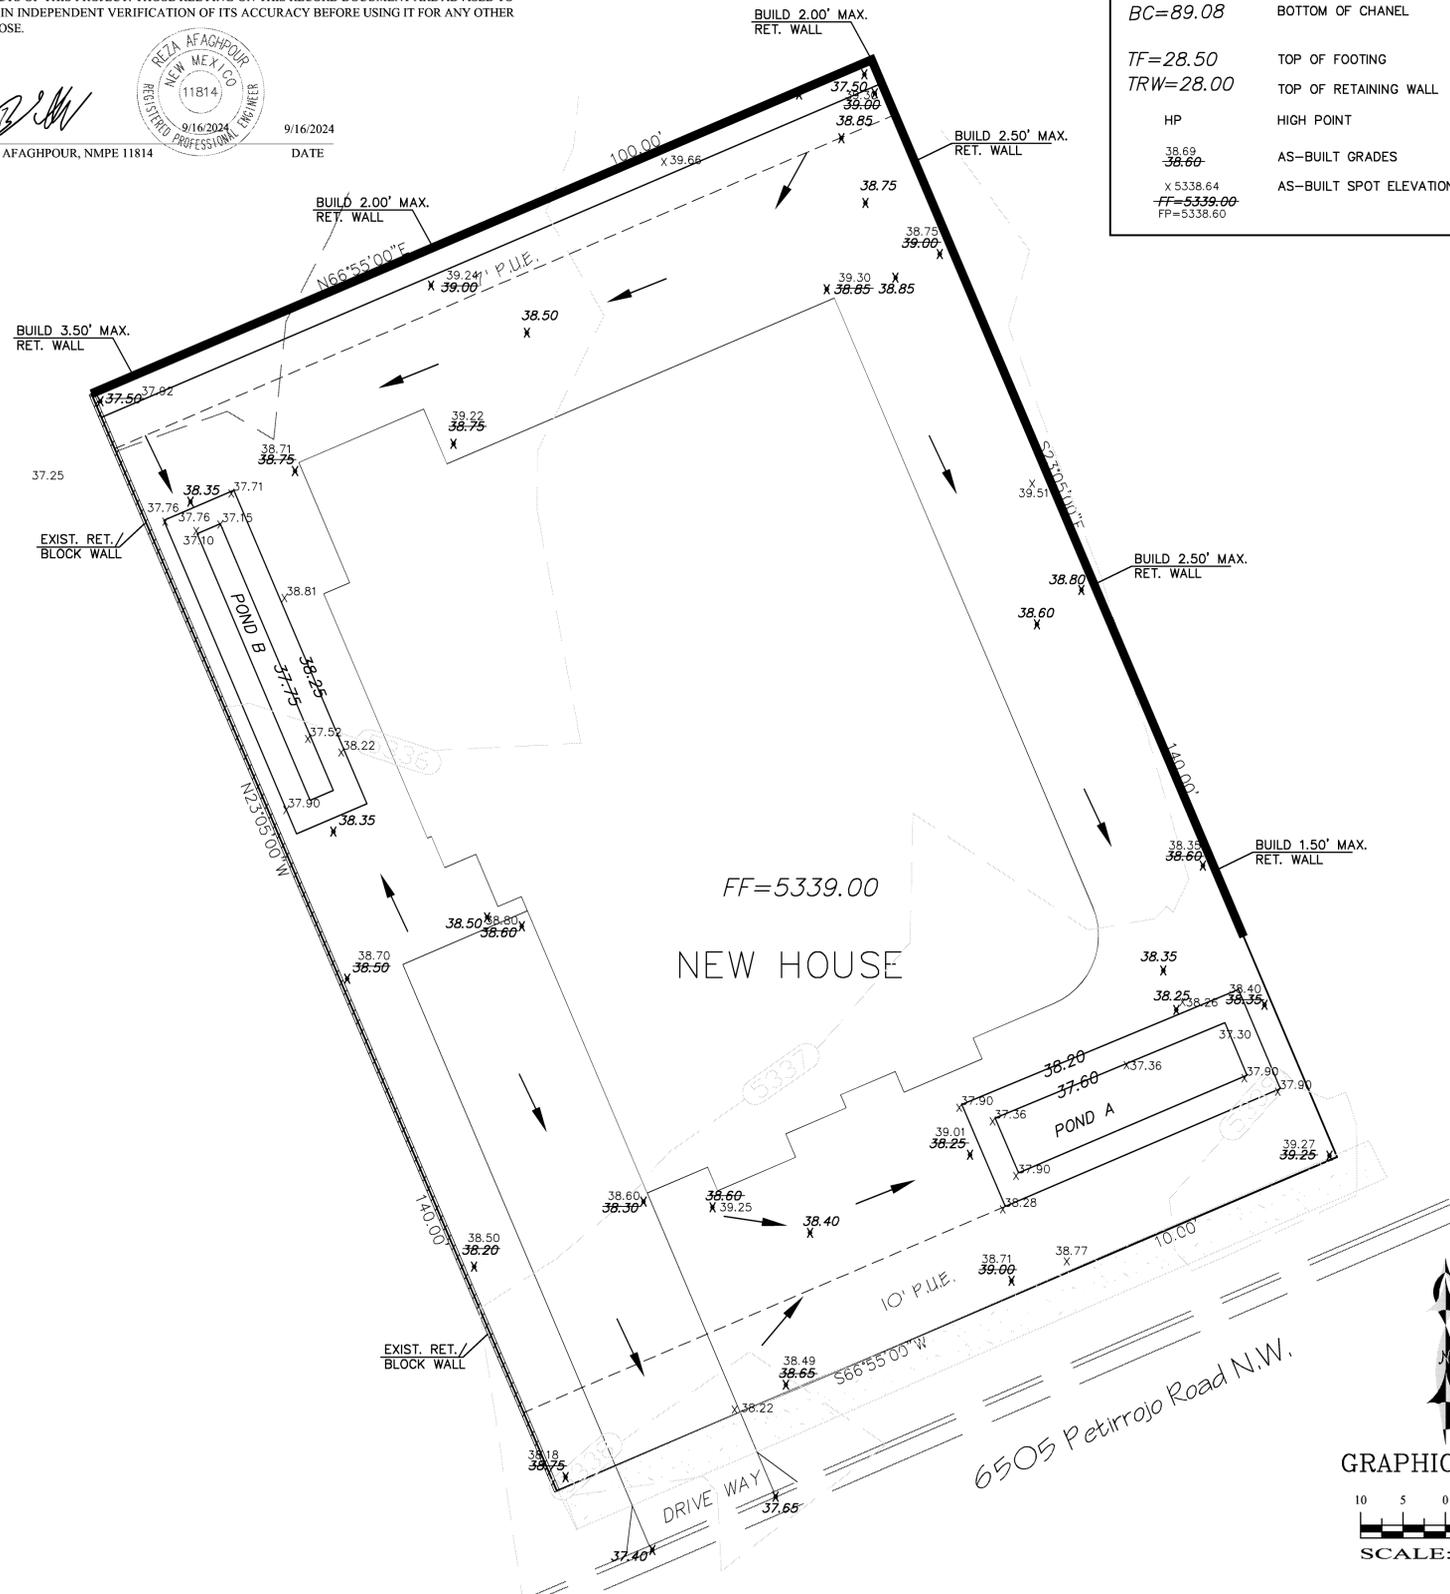

LEGEND

- 50.30 --- EXISTING CONTOUR (MAJOR)
- 50.29 --- EXISTING CONTOUR (MINOR)
- — — BOUNDARY LINE
- X 28.50 PROPOSED SPOT ELEVATION
- X 5029.16 EXISTING GRADE
- X 5075.65 EXISTING FLOWLINE ELEVATION
- █ █ █ █ PROPOSED RETAINING WALL
- BC=89.08 BOTTOM OF CHANNEL
- TF=28.50 TOP OF FOOTING
- TRW=28.00 TOP OF RETAINING WALL
- HP HIGH POINT
- 38.89 AS-BUILT GRADES
- X 5338.64 AS-BUILT SPOT ELEVATIONS
- FF=5339.00 FP=5338.60

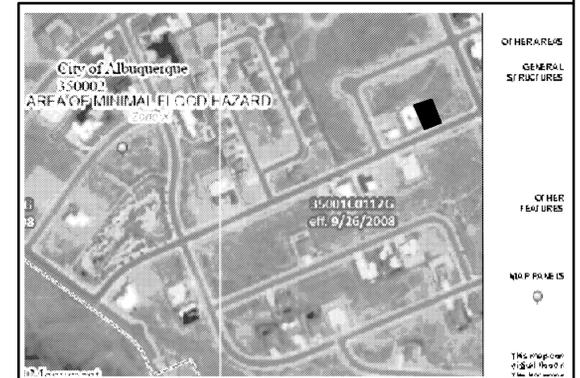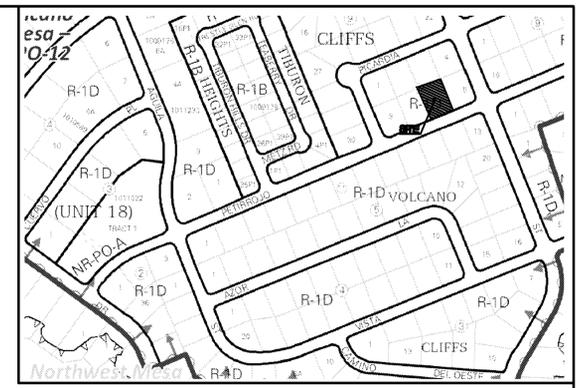

LEGAL DESCRIPTION:
 Lot 6, BLOCK 10, VOLCANO CLIFFS SUBDIVISION, UNIT 18
 ADDRESS: 6505 PETIRROJO ROAD, NW.

BENCHMARK
 CITY BENCHMARK 10_D10, ELEVATION OF 5322.212 FEET ABOVE SEA LEVEL.

EROSION CONTROL PLAN AND POLLUTION PREVENTION NOTES


1. CONTRACTOR IS RESPONSIBLE FOR OBTAINING A TOPSOIL DISTURBANCE PERMIT PRIOR TO BEGINNING WORK.
2. CONTRACTOR IS RESPONSIBLE FOR CLEANING ALL SEDIMENT OUT OF EXISTING RIGHT-OF-WAY.
3. CONTRACTOR IS RESPONSIBLE FOR MAINTAINING ALL STORM RUNOFF ON SITE.
4. REPAIR OF DAMAGED FACILITIES AND CLEAN-UP OF SEDIMENT ACCUMULATION ON ADJACENT PROPERTIES AND IN PUBLIC FACILITIES IS THE RESPONSIBILITY OF THE CONTRACTOR.
5. ALL EXPOSED EARTH SURFACES MUST BE PROTECTED FROM WIND AND WATER EROSION PRIOR TO FINAL ACCEPTANCE OF ANY PROJECT.

- GENERAL NOTES:**
- 1: CONTOUR INTERVAL IS HALF (1.00) FOOT.
 - 2: ELEVATIONS ARE BASED ON CITY OF ALBUQUERQUE CONTROL STATION 10_D10, HAVING AN ELEVATION OF 5322.212 FEET ABOVE SEA LEVEL.
 - 3: UTILITIES SHOWN HEREON ARE IN THEIR APPROXIMATE LOCATION BASED ONLY ON ABOVE GROUND EVIDENCE FOUND IN THE FIELD AND AS-BUILT INFORMATION PROVIDED BY THE CLIENT. UTILITIES SHOWN HEREON, WHETHER INDICATED AS ABANDONED OR NOT, SHALL BE VERIFIED BY OTHERS FOR EXACT LOCATION AND/OR DEPTH PRIOR TO EXCAVATION OR DESIGN CONSIDERATIONS.
 - 4: THIS IS NOT A BOUNDARY SURVEY, BEARINGS ARE ASSUMED, DISTANCES AND FOUND PROPERTY CORNERS ARE FOR INFORMATIONAL PURPOSES ONLY.
 - 5: SLOPES ARE AT 3:1 MAXIMUM.
 - 6: ADD 5300 TO ALL PROPOSED SPOT ELEVATIONS.

REZA AFAGHPUR P.E. #11814

SBS CONSTRUCTION AND ENGINEERING, LLC

7632 WILLIAM MOYERS AVE, NE
 ALBUQUERQUE, NEW MEXICO 87122
 (505)804-5013

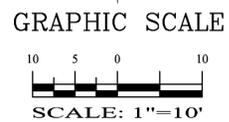

6505 PETIRROJO ST., N.W. GRADING PLAN

DRAWING:	DRAWN BY:	DATE:	SHEET #
202402-GD.DWG	SH-B	1-23-22	1