


# CITY OF ALBUQUERQUE

Planning Department  
Suzanne Lubar, Director

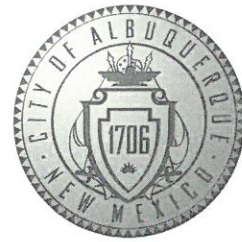

Mayor Richard J. Berry

October 30, 2017

Jackie McDowell, PE  
McDowell Engineering, Inc.  
7820 Beverly Hills Ave NE  
Albuquerque, NM 87121

**Re: Lot 10 Block 9 Unit 22 Volcano Cliffs, S.A.D. 228  
6401 Petirrojo Rd. NW  
Request Permanent C.O. – Accepted  
Engineer's Stamp dated: 4-11-17 (D10D003Q10)  
Certification dated: 10/30/17**

Dear Ms. McDowell,

PO Box 1293

Based on the Certification received 10/30/2017, the site is acceptable for release of Certificate of Occupancy by Hydrology.

Albuquerque

If you have any questions, you can contact me at 924-3986 or Rudy Rael at 924-3977.

NM 87103

Sincerely,

www.cabq.gov


James D. Hughes, P.E.  
Principal Engineer, Hydrology  
Planning Department

RR/JDH  
C: email



STANDARD GRADING NOTE: THE MAXIMUM GRADED SIDE SLOPE SHALL NOT EXCEED 3 FEET (HORIZONTALLY) TO 1 FOOT (VERTICALLY). AREAS DISTURBED BY GRADING WHICH WILL NOT BE TREATED WITH LANDSCAPING SHALL BE SEEDED.


PROJECT BENCHMARK:  
"ACS BM14\_D10"  
ELEVATION: 5322.212

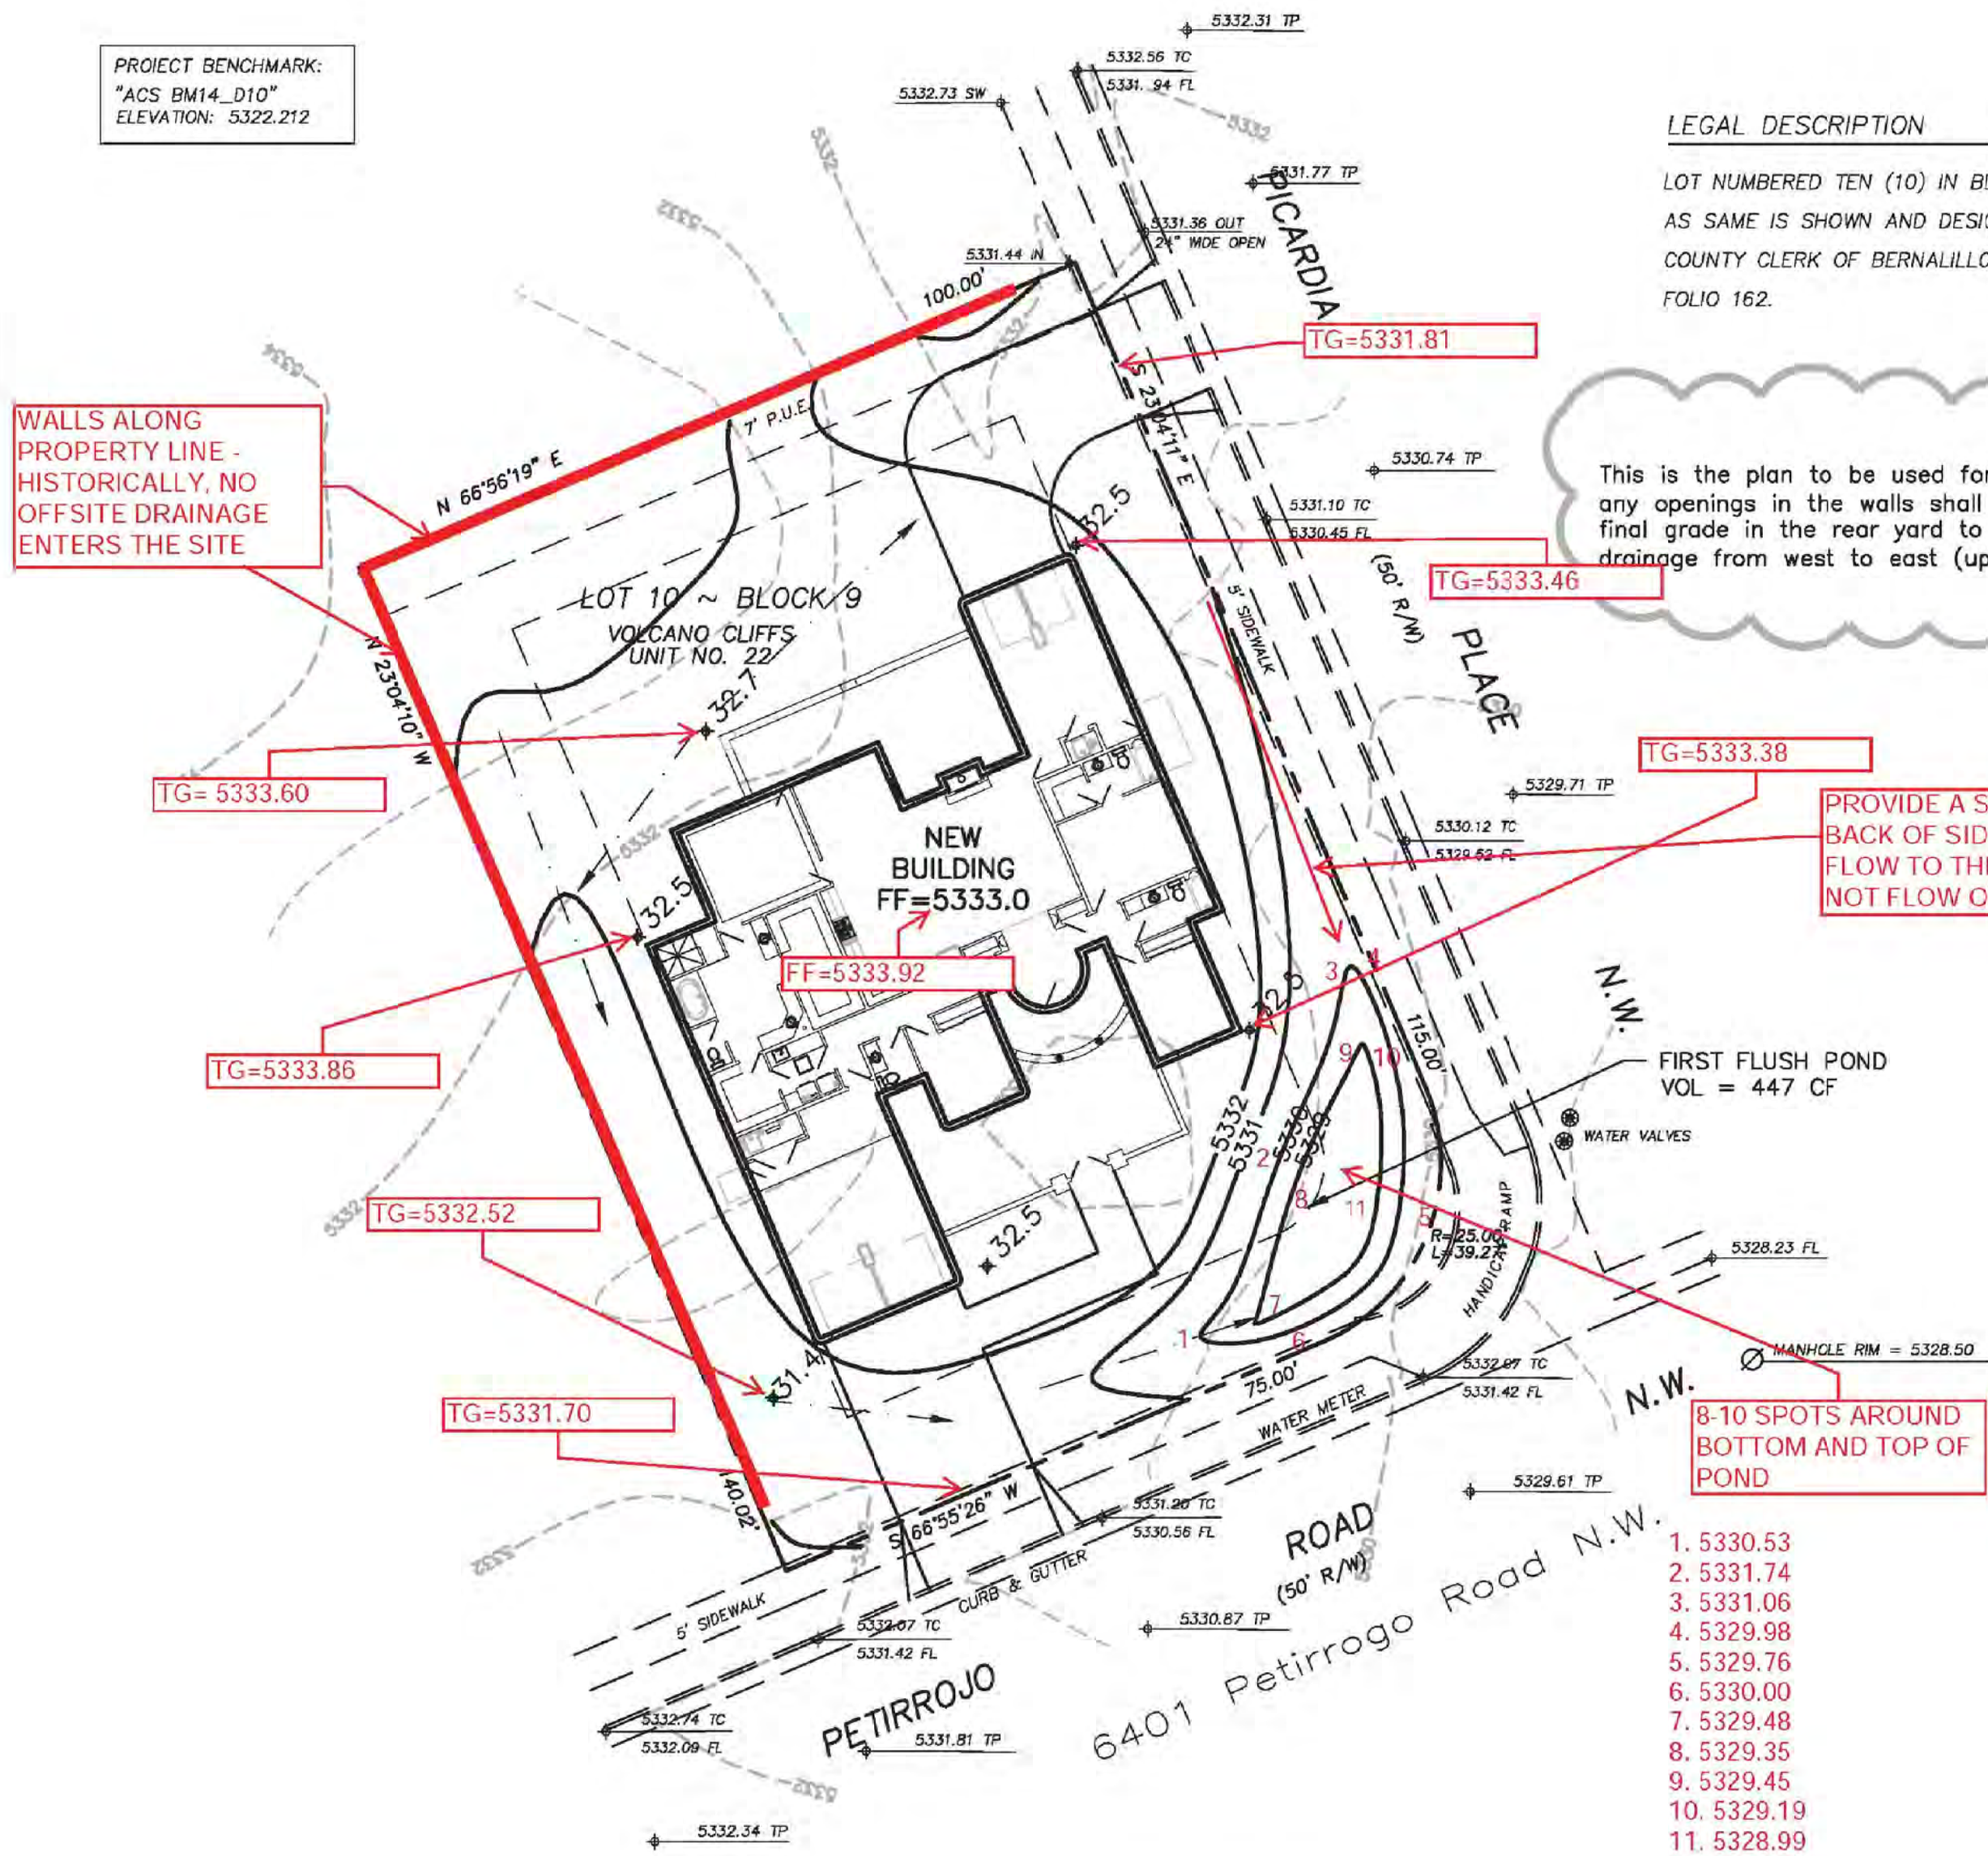

LEGAL DESCRIPTION

LOT NUMBERED TEN (10) IN BLOCK NUMBERED NINE (9) OF VOLCANO CLIFFS, UNIT NO. 22 AS SAME IS SHOWN AND DESIGNATED ON SAID PLAT, AS FILED IN THE OFFICE OF THE COUNTY CLERK OF BERNALILLO COUNTY, NEW MEXICO ON JULY 9, 1975 IN VOLUME D6, FOLIO 162.

This is the plan to be used for any garden walls and any openings in the walls shall be placed 3" above final grade in the rear yard to allow for cross lot drainage from west to east (upstream to downstream).

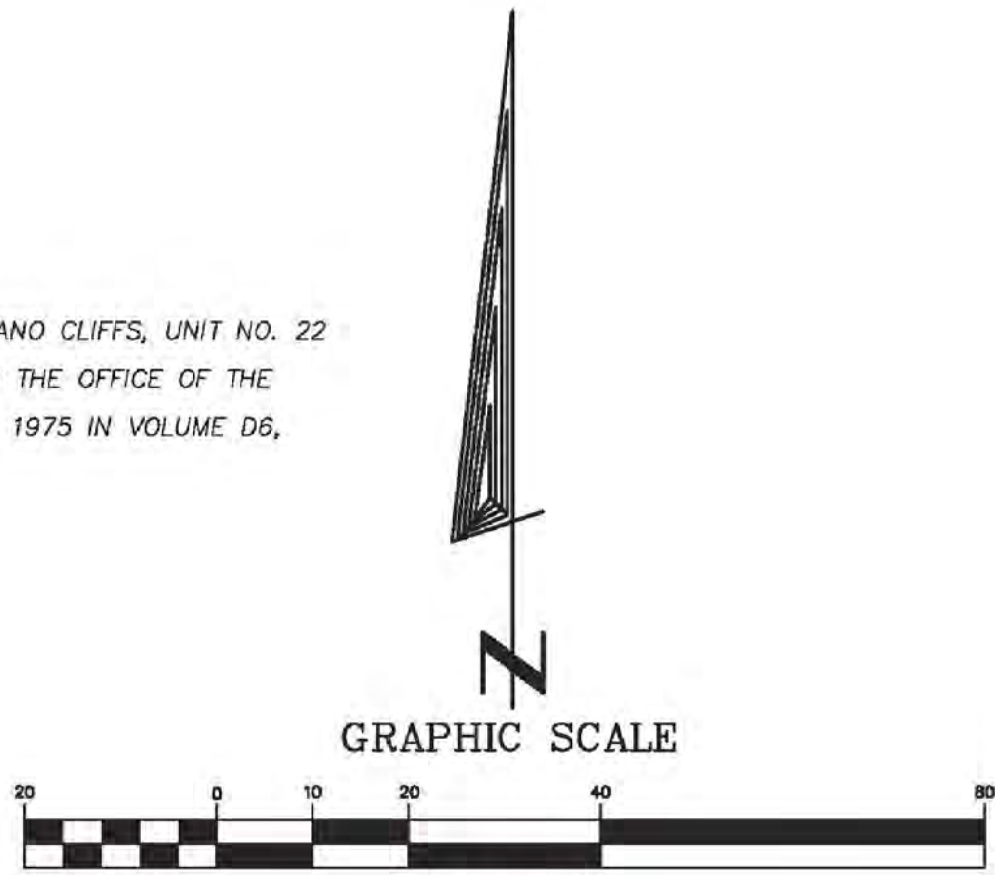

DRAINAGE PLAN

SCOPE:

Pursuant to the latest City of Albuquerque and Bernalillo County Ordinances, the Drainage Plan shown hereon outlines the drainage management criteria for controlling developed runoff on and exiting the project site. A single family home is proposed for the site with associated parking, access, landscaping, and utility improvements.

EXISTING CONDITIONS:

Presently, the 0.32 acre site is undeveloped. The site is bounded on the northeast by Picardia Pl. on the southeast by Petirrojo Road NW, and on the northwest and southeast by private property. The site is relatively level in the center and has a gentle slope from the northwest to the southeast. Site topography slopes to the southeast. As shown on FEMA Panel #112G, the site is not located in a 100 year flood plain.

PROPOSED CONDITIONS:

Per the SAD 228 Drainage Report by Wilson & Company, drainage from the lots have been master planned to be intercepted by drainage features downstream of the properties. Current COA Drainage Ordinance requires that ponds must be provided to handle the First Flush volume which has been calculated and is included on this plan. As shown by the plan, the building is located in the center of the lot. No off-site flows enter the site due to existing grades on adjacent lots which transport offsite runoff to public streets around the site. On site flows will drain around the structure via swales, and flow to the southeast to the first flush retention pond. All roof drainage will discharge from the roof to the lot and be directed around the structure to the drainage paths and pond.

Supplemental calculations are shown as part of this Grading and Drainage plan.

CALCULATIONS:


The calculations shown hereon define the 100 year-6 hour design storm falling within the project area under existing and developed conditions. The Hydrology is per "Section 22.2, Hydrology of the Development Process Manual, Volume 2, Design Criteria, for the City of Albuquerque, New Mexico in cooperation with Bernalillo County, New Mexico and the Albuquerque Metropolitan Arroyo Flood Control Authority.

PROPERTY ADDRESS:

6401 Petirrojo Road NW

TOPOGRAPHY:

Topographic information provided by Mike Shook dated May, 2017.

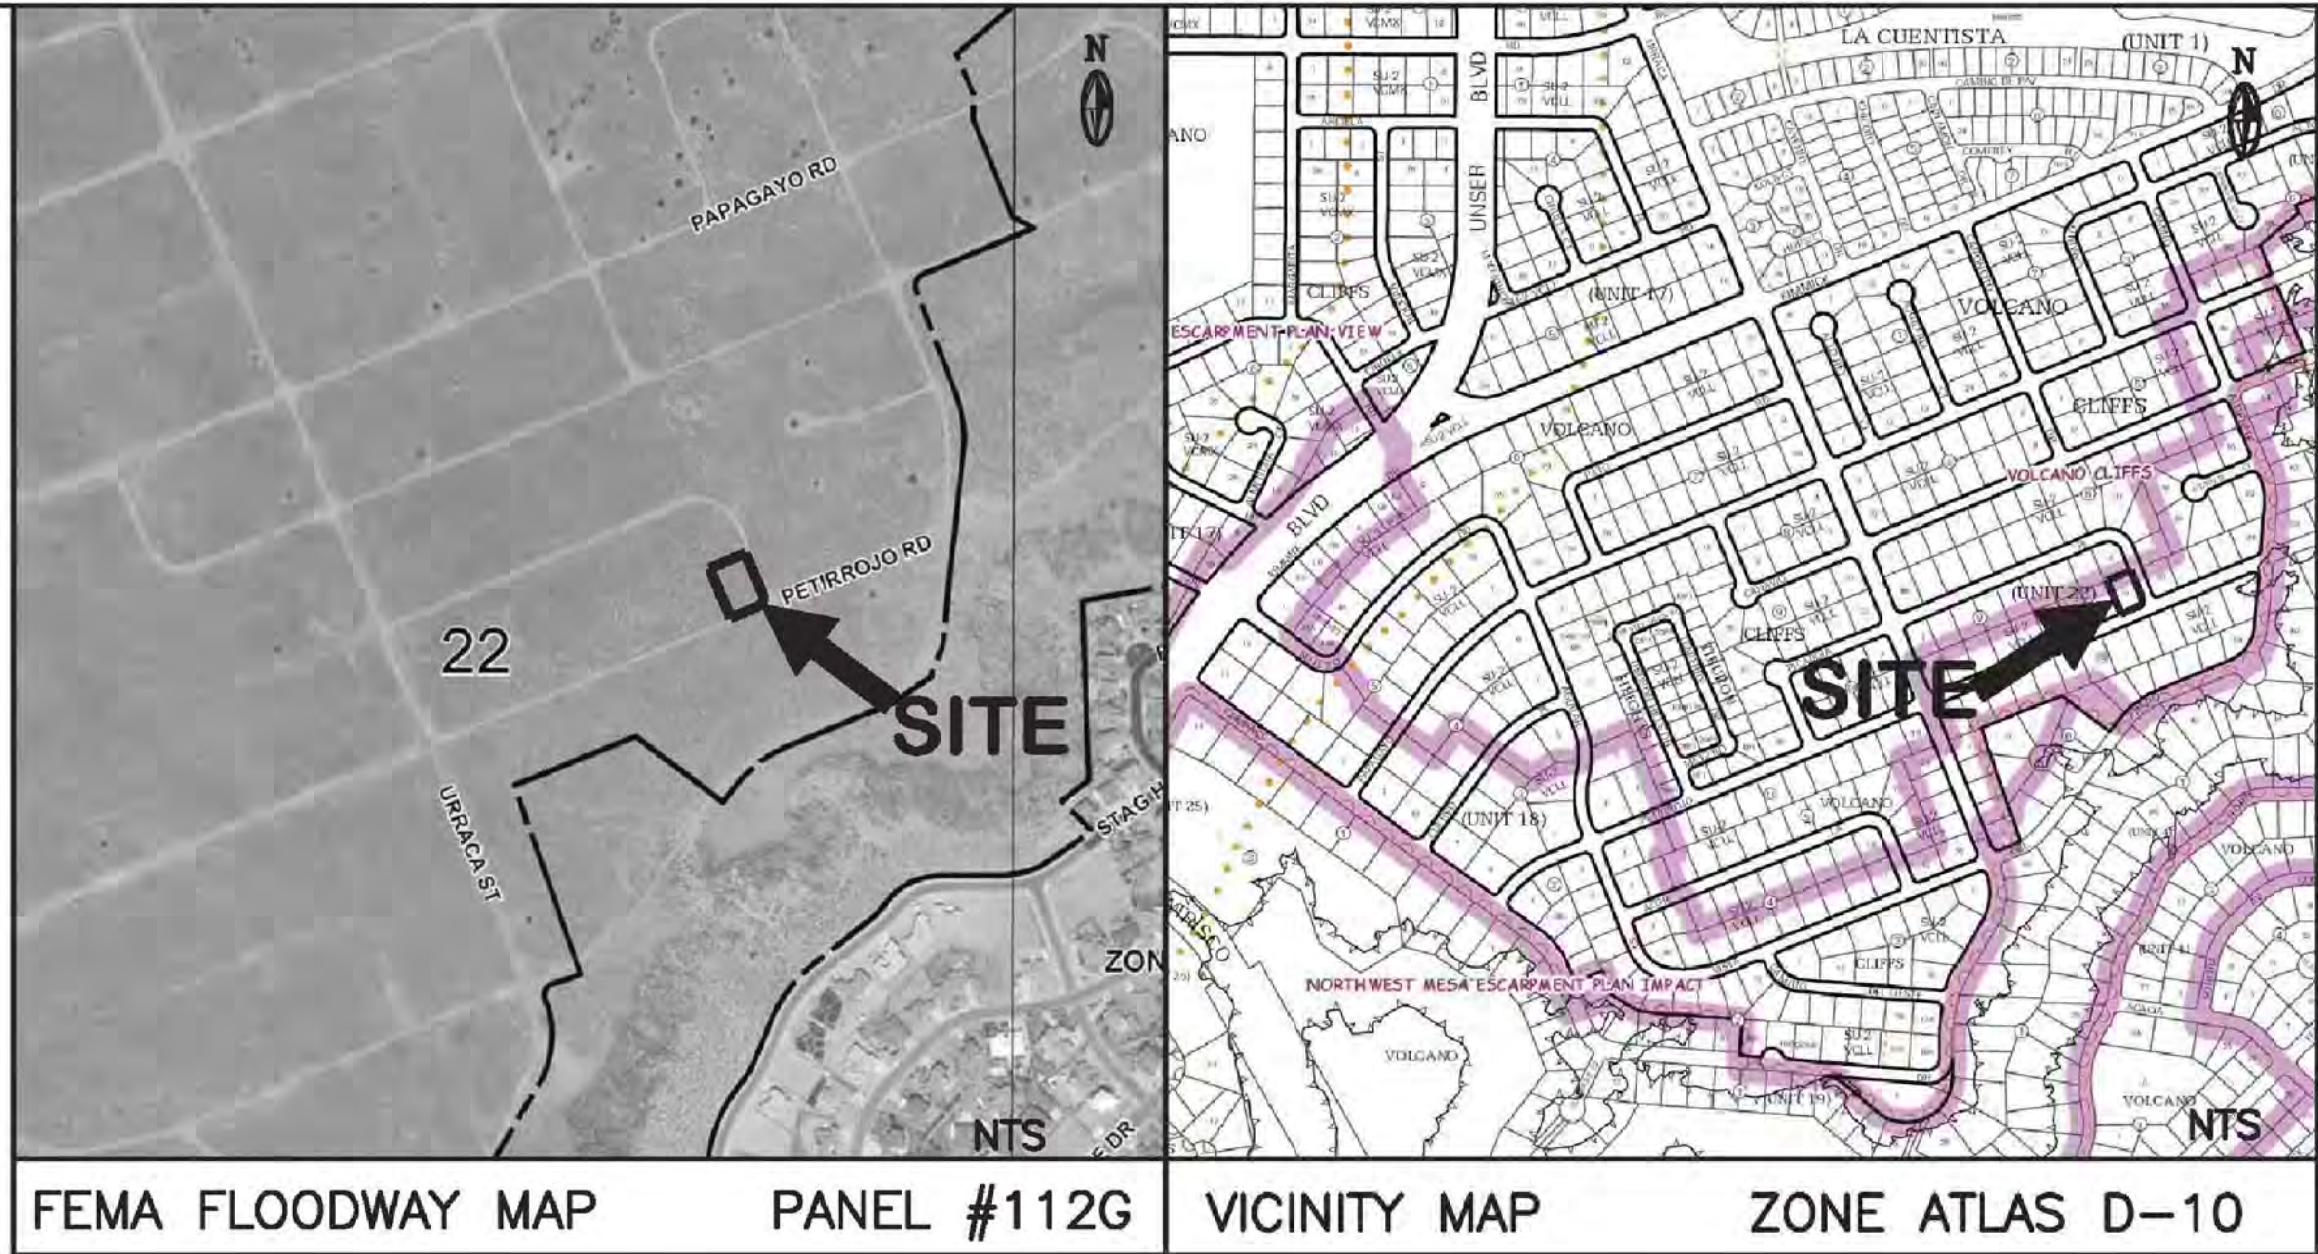

LEGEND

	EXISTING	PROPOSED
CONTOUR	5045	5045
PROPERTY LINE		
ROAD		
SETBACK		

"CERTIFICATE OF OCCUPANCY"

I, Jackie S. McDowell, NMPE #10903, OF THE FIRM McDowell Engineering, Inc., HEREBY CERTIFY THAT THIS PROJECT HAS BEEN GRADED AND WILL DRAIN IN SUBSTANTIAL COMPLIANCE WITH AND IN ACCORDANCE WITH THE DESIGN INTENT OF THE APPROVED PLAN DATED 5/15/17 and 5/17/17 (wall note added as requested by COA). I FURTHER CERTIFY THAT I HAVE PERSONALLY VISITED THE PROJECT SITE ON 10-26-17 AND HAVE DETERMINED BY VISUAL INSPECTION THAT THE SURVEY DATA PROVIDED IS REPRESENTATIVE OF ACTUAL SITE CONDITIONS AND IS TRUE AND CORRECT TO THE BEST OF MY KNOWLEDGE AND BELIEF. THIS CERTIFICATION IS SUBMITTED IN SUPPORT FOR A REQUEST FOR CERTIFICATE OF OCCUPANCY.

THE RECORD INFORMATION PRESENTED HEREON IS NOT NECESSARILY COMPLETE AND INTENDED ONLY TO VERIFY SUBSTANTIAL COMPLIANCE OF THE GRADING AND DRAINAGE ASPECTS OF THIS PROJECT AND TO CONFIRM THAT THE BUILDING PAD IS AT THE GRADE PROVIDED. THOSE RELYING ON THIS RECORD DOCUMENT ARE ADVISED TO OBTAIN INDEPENDENT VERIFICATION OF ITS ACCURACY BEFORE USING IT FOR ANY OTHER PURPOSE.

Jackie S. McDowell, NMPE #10903  
DATE 10-30-17



5-15-17  
REV. 5-17-17

AS-BUILT CERTIFICATION 10-21-17

The As-Built Plan is in substantial compliance with the approved Grading & Drainage Plan.

ENGINEER'S CERTIFICATION:

I, Jackie S. McDowell, hereby certify that I personally inspected the site shown on this plan on May 11, 2017 and as of that date it appeared that no filling, grading, or excavation had occurred thereon since completion of the topographic survey used to prepare this plan.

CITY OF ALBUQUERQUE, BERNALILLO COUNTY		NEW MEXICO	
LOT 10, BLOCK 9, UNIT 22 VOLCANO CLIFFS SUBDIVISION			
CANDELARIA - COMPOS - GRADING & DRAINAGE PLAN			
<b>McDowell Engineering, Inc.</b>			
7820 BEVERLY HILLS AVE. NE • ALBUQUERQUE, NM 87122			
TEL: 505-828-2430 • FAX: 505-821-4857			
Designed JSM	Drawn STAFF	Checked JSM	Sheet of
File CAN0117L	Date MAY, 2017		1 1

I, CHRISTOPHER A. MEDINA, N.M.P.L.S. NO. 15702, DO HEREBY CERTIFY THAT THE AS-BUILT INFORMATION SHOWN AND THE ACTUAL SURVEY WHICH IT WAS DERIVED FROM WAS PERFORMED BY ME OR UNDER MY DIRECT SUPERVISION AND THAT THE INFORMATION SHOWN IS TRUE AND CORRECT TO THE BEST OF MY KNOWLEDGE AND BELIEF.

Christopher A Medina

10/20/2017

CHRISTOPHER A. MEDINA, N.M.P.L.S. NO. 15702

DATE

GENERAL DRAINAGE PLAN NOTES:

- It is recommended that the Owner obtain a Geotechnical Evaluation of the on-site soils prior to foundation/structural design.
- This plan recommends positive drainage away from all structures to prohibit ponding of runoff adjacent to the structure. Future alterations of the grades next to the structures are not recommended.
- Irrigation within 10 feet of any proposed structure is not recommended. Irrigation water adjacent to the structures could cause settlement.
- This plan establishes on-site drainage and assumes no responsibility for subsurface analysis, foundation or structural design, or utility design.
- Local codes may require all footings to be placed in natural undisturbed soil. If the contractor plans to place footings on engineered fill, a certification by a registered Professional Engineer is recommended.
- It is recommended that the Owner obtain the services of a Geotechnical Engineer to test and inspect all earthwork aspects of the project.
- The property boundary shown on this plan is given for information only to describe the project limits. Property boundary information shown hereon does not constitute a boundary survey.
- All work shall be constructed in accordance with the City of Albuquerque Standard Specifications for Public Works Construction with updates.
- All work on this project shall be performed in accordance with applicable Federal, State, and Local laws, rules, and regulations concerning construction safety and health.
- Contact shall ensure that no site soils/sediment or silt enters the right-of-ways during construction.
- Areas disturbed due to construction shall be restored per City of Albuquerque Spec. 1012 native seed mix.





# City of Albuquerque

Planning Department

Development & Building Services Division

## DRAINAGE AND TRANSPORTATION INFORMATION SHEET

(REV 02/2013)

**D10D003Q10**

Project Title: \_\_\_\_\_ Building Permit #: \_\_\_\_\_ City Drainage #: \_\_\_\_\_

DRB#: \_\_\_\_\_ EPC#: \_\_\_\_\_ Work Order#: \_\_\_\_\_

Legal Description: \_\_\_\_\_

City Address: \_\_\_\_\_

**Engineering Firm:** \_\_\_\_\_ Contact: \_\_\_\_\_

Address: \_\_\_\_\_

Phone#: \_\_\_\_\_ Fax#: \_\_\_\_\_ E-mail: \_\_\_\_\_

**Owner:** \_\_\_\_\_ Contact: \_\_\_\_\_

Address: \_\_\_\_\_

Phone#: \_\_\_\_\_ Fax#: \_\_\_\_\_ E-mail: \_\_\_\_\_

**Architect:** \_\_\_\_\_ Contact: \_\_\_\_\_

Address: \_\_\_\_\_

Phone#: \_\_\_\_\_ Fax#: \_\_\_\_\_ E-mail: \_\_\_\_\_

**Surveyor:** \_\_\_\_\_ Contact: \_\_\_\_\_

Address: \_\_\_\_\_

Phone#: \_\_\_\_\_ Fax#: \_\_\_\_\_ E-mail: \_\_\_\_\_

**Contractor:** \_\_\_\_\_ Contact: \_\_\_\_\_

Address: \_\_\_\_\_

Phone#: \_\_\_\_\_ Fax#: \_\_\_\_\_ E-mail: \_\_\_\_\_

### TYPE OF SUBMITTAL:

- ☐ DRAINAGE REPORT
- ☐ DRAINAGE PLAN 1st SUBMITTAL
- ☐ DRAINAGE PLAN RESUBMITTAL
- ☐ CONCEPTUAL G & D PLAN
- ☐ GRADING PLAN
- ☐ EROSION & SEDIMENT CONTROL PLAN (ESC)
- ☐ ENGINEER'S CERT (HYDROLOGY)
- ☐ CLOMR/LOMR
- ☐ TRAFFIC CIRCULATION LAYOUT (TCL)
- ☐ ENGINEER'S CERT (TCL)
- ☐ ENGINEER'S CERT (DRB SITE PLAN)
- ☐ ENGINEER'S CERT (ESC)
- ☐ SO-19
- ☐ OTHER (SPECIFY) \_\_\_\_\_

### CHECK TYPE OF APPROVAL/ACCEPTANCE SOUGHT:

- ☐ SIA/FINANCIAL GUARANTEE RELEASE
- ☐ PRELIMINARY PLAT APPROVAL
- ☐ S. DEV. PLAN FOR SUB'D APPROVAL
- ☐ S. DEV. FOR BLDG. PERMIT APPROVAL
- ☐ SECTOR PLAN APPROVAL
- ☐ FINAL PLAT APPROVAL
- ☐ CERTIFICATE OF OCCUPANCY (PERM)
- ☐ CERTIFICATE OF OCCUPANCY (TCL TEMP)
- ☐ FOUNDATION PERMIT APPROVAL
- ☐ BUILDING PERMIT APPROVAL
- ☐ GRADING PERMIT APPROVAL
- ☐ PAVING PERMIT APPROVAL
- ☐ WORK ORDER APPROVAL
- ☐ GRADING CERTIFICATION
- ☐ SO-19 APPROVAL
- ☐ ESC PERMIT APPROVAL
- ☐ ESC CERT. ACCEPTANCE
- ☐ OTHER (SPECIFY) \_\_\_\_\_

WAS A PRE-DESIGN CONFERENCE ATTENDED: \_\_\_\_\_ Yes \_\_\_\_\_ No \_\_\_\_\_ Copy Provided

DATE SUBMITTED: \_\_\_\_\_ By: \_\_\_\_\_

Requests for approvals of Site Development Plans and/or Subdivision Plats shall be accompanied by a drainage submittal. The particular nature, location, and scope to the proposed development defines the degree of drainage detail. One or more of the following levels of submittal may be required based on the following:

1. **Conceptual Grading and Drainage Plan:** Required for approval of Site Development Plans greater than five (5) acres and Sector Plans
2. **Drainage Plans:** Required for building permits, grading permits, paving permits and site plans less than five (5) acres
3. **Drainage Report:** Required for subdivision containing more than ten (10) lots or constituting five (5) acres or more
4. **Erosion and Sediment Control Plan:** Required for any new development and redevelopment site with 1-acre or more of land disturbing area, including project less than 1-acre than are part of a larger common plan of development