

CITY OF ALBUQUERQUE

Planning Department
Brennon Williams, Director



Mayor Timothy M. Keller

July 14, 2020

Donald Briggs, P.E.
Don Briggs Engineering LLC
5324 Oakledge Ct. NW
Albuquerque, New Mexico 87120

**RE: Lot 11 Block 9 Unit 22 SAD 228
6405 Petirrojo Rd. NW
Volcano Cliffs Subdivision
Grading and Drainage Plan
Engineers Stamp Date; 6/30/21 (D10D00Q11)
C.O. Certification Date; 7/8/2021**

Dear Mr. Briggs,

PO Box 1293

Based upon the information provided in your submittal received 7/14/2021, this plan is approved for Certificate of Occupancy release.

Albuquerque

If you have any questions, please contact me at 924-3986 or Rudy Rael at 924-3977.

NM 87103

Sincerely,

www.cabq.gov

Ernest Armijo, P.E.
Principal Engineer, Planning Dept.
Development Review Services



City of Albuquerque

Planning Department

Development & Building Services Division

DRAINAGE AND TRANSPORTATION INFORMATION SHEET (REV 11/2018)

Project Title: _____ **Building Permit #:** _____ **Hydrology File #:** _____

DRB#: _____ **EPC#:** _____ **Work Order#:** _____

Legal Description: _____

City Address: _____

Applicant: _____ **Contact:** _____

Address: _____

Phone#: _____ **Fax#:** _____ **E-mail:** _____

Owner: _____ **Contact:** _____

Address: _____

Phone#: _____ **Fax#:** _____ **E-mail:** _____

TYPE OF SUBMITTAL: _____ PLAT (____# OF LOTS) _____ RESIDENCE _____ DRB SITE _____ ADMIN SITE

IS THIS A RESUBMITTAL?: _____ Yes _____ No

DEPARTMENT: _____ TRAFFIC/ TRANSPORTATION _____ HYDROLOGY/ DRAINAGE

Check all that Apply:

TYPE OF SUBMITTAL:

- _____ ENGINEER/ARCHITECT CERTIFICATION
- _____ PAD CERTIFICATION
- _____ CONCEPTUAL G & D PLAN
- _____ GRADING PLAN
- _____ DRAINAGE MASTER PLAN
- _____ DRAINAGE REPORT
- _____ FLOODPLAIN DEVELOPMENT PERMIT APPLIC
- _____ ELEVATION CERTIFICATE
- _____ CLOMR/LOMR
- _____ TRAFFIC CIRCULATION LAYOUT (TCL)
- _____ TRAFFIC IMPACT STUDY (TIS)
- _____ OTHER (SPECIFY) _____
- _____ PRE-DESIGN MEETING?

TYPE OF APPROVAL/ACCEPTANCE SOUGHT:

- _____ BUILDING PERMIT APPROVAL
- _____ CERTIFICATE OF OCCUPANCY
- _____ PRELIMINARY PLAT APPROVAL
- _____ SITE PLAN FOR SUB'D APPROVAL
- _____ SITE PLAN FOR BLDG. PERMIT APPROVAL
- _____ FINAL PLAT APPROVAL
- _____ SIA/ RELEASE OF FINANCIAL GUARANTEE
- _____ FOUNDATION PERMIT APPROVAL
- _____ GRADING PERMIT APPROVAL
- _____ SO-19 APPROVAL
- _____ PAVING PERMIT APPROVAL
- _____ GRADING/ PAD CERTIFICATION
- _____ WORK ORDER APPROVAL
- _____ CLOMR/LOMR
- _____ FLOODPLAIN DEVELOPMENT PERMIT
- _____ OTHER (SPECIFY) _____

DATE SUBMITTED: _____ **By:** _____

COA STAFF:

ELECTRONIC SUBMITTAL RECEIVED: _____



FEE PAID: _____

DRAINAGE CERTIFICATION

I, Don Briggs, NMPS 14912, OF THE FIRM, Don Briggs Engineering LLC, HEREBY CERTIFY THAT THIS PROJECT HAS BEEN GRADED AND WILL DRAIN IN SUBSTANTIAL COMPLIANCE WITH AND IN ACCORDANCE WITH THE DESIGN INTENT OF THE APPROVED PLAN DATED 6/20/2021. THE RECORD INFORMATION ENTERED ONTO THE ORIGINAL DESIGN DOCUMENT HAS BEEN OBTAINED BY Andrew Medina P.E., NMPS 12649, OF THE FIRM Sandia Land Surveying LLC.


I FURTHER CERTIFY THAT I HAVE PERSONALLY VISITED THE PROJECT SITE ON 7/27/2021 AND HAVE DETERMINED BY VISUAL INSPECTION THAT THE SURVEY DATA PROVIDED IS REPRESENTATIVE OF ACTUAL SITE CONDITIONS AND IS TRUE AND CORRECT TO THE BEST OF MY KNOWLEDGE AND BELIEF. THIS CERTIFICATION IS SUBMITTED IN SUPPORT OF A REQUEST FOR CERTIFICATE OF OCCUPANCY.

THE RECORD INFORMATION PRESENTED HEREON IS NOT NECESSARILY COMPLETE AND IS INTENDED ONLY TO VERIFY SUBSTANTIAL COMPLIANCE OF THE GRADING AND DRAINAGE ASPECTS OF THIS PROJECT. THOSE RELYING ON THIS RECORD DOCUMENT ARE ADVISED TO OBTAIN INDEPENDENT VERIFICATION OF ITS ACCURACY BEFORE USING IT FOR ANY OTHER PURPOSE.

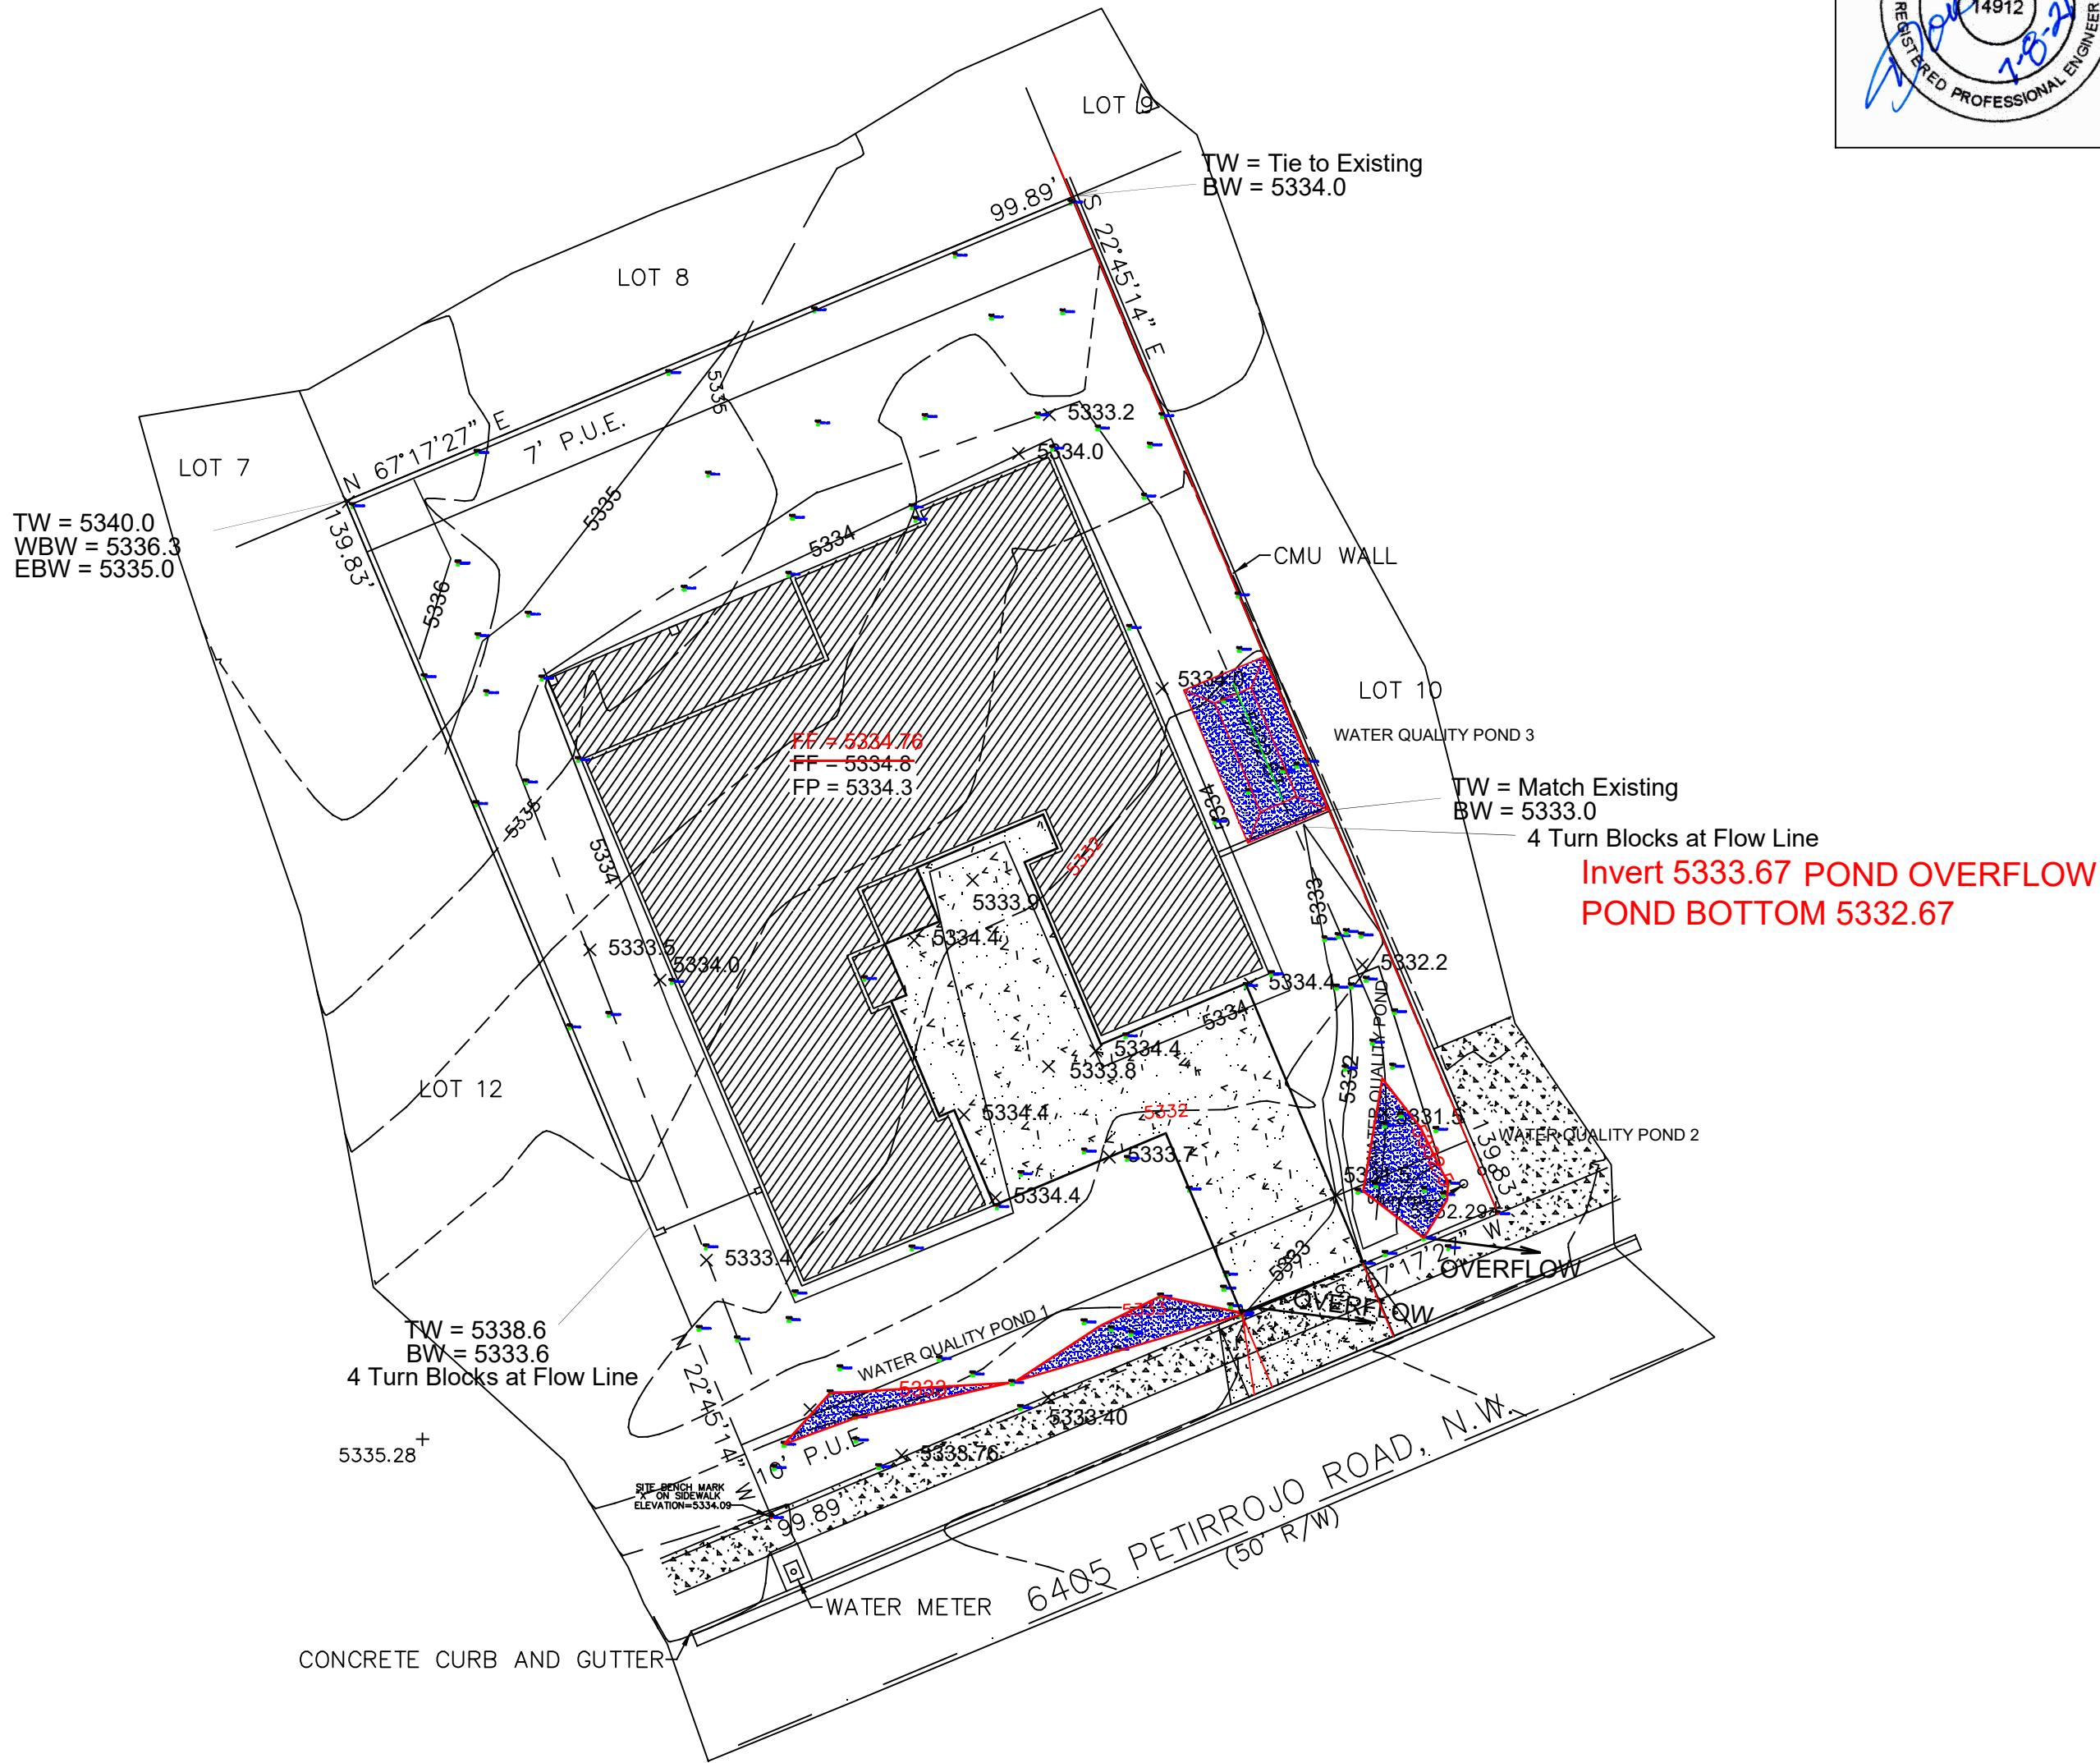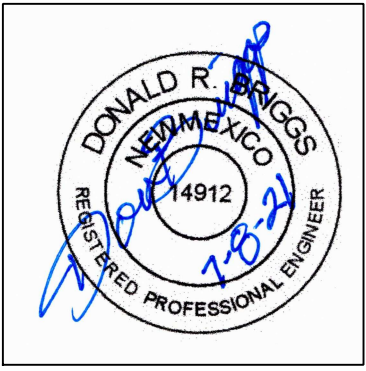

----- Existing Contour
----- Design Contour
----- New 5' CMU Wall
----- Drainage Swale
G=5324.98 X Existing Spot Elevation
X 5328.5 Proposed Spot Elevation

NATURAL GROUND CONTOUR
INTERVAL = 1.0'

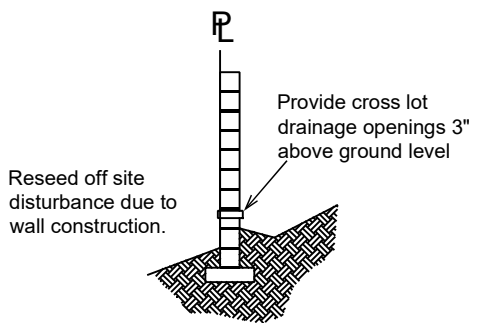

SCALE 1" = 20'

DRAINAGE NARRATIVE

This grading & drainage plan was prepared to support a building permit application for a new residence located at 6405 Petirrojo Rd. NW. A review of the City Hydrology records indicate development of this property is governed by the Drainage Report for SAD 228. This report indicates allowable land treatment values of 0% A, 10% B, 40% C, and 50% D. If developed discharge rates exceed what is allowable using these land treatment values, mitigation measures will be required. This plan was prepared using the hydrology methodology presented in Chapter 22.2 of the City of Albuquerque's Development Process Manual (abbreviated method).

The site is a 0.34 acre parcel located in Precipitation Zone 1 and Floodzone X (Unshaded). It slopes from the north west to the south east at about 4.6%. The site is impacted by cross lot runoff from adjacent properties and ponds that water onsite. This plan is designed to meet the drainage requirements indicated in the SAD 228 report.

The hydrology analysis indicates the developed conditions will not increase discharge rates over what is allowed so mitigation measures are not required. However, a water quality pond is provided to meet EPA requirements. All onsite flows are directed to the front yard landscaping then to the street.

NOTE:

1. Pad Certification was provided for previous design on 7/27/20
2. A final inspection by Hydrology is required before a Certificate of Occupancy is released.
3. Provide openings in CMU wall 3" above ground to allow cross lot drainage.

GENERAL NOTES

Contractor is responsible for utility spots and controlling sediment deposition and erosion during construction.

A concrete washout bin must be provided as per City of Albuquerque MS4 Permit requirements.

All disturbed area due to construction must be reseeded or landscaped following construction.

Hydrology Calculations
6405 Petirrojo Rd. NW

Precipitation Zone 1
100 yr 6 hr Storm
Basin Area =

0.34 ac.

14810.4 sq ft

Determined by DB

Allowable - SAD 228 Master Drainage Plan

Land Treatment	Percent	Area (ac.)	Excess Precipitation (in.)	Unit Peak Discharge (cfs/ac.)	Runoff Volume (ac. Ft.)	Peak Discharge (cfs)	Comments
A	0.00%	0.00	0.44	1.29	0.00	0.00	Natural Ground
B	10.00%	0.03	0.67	2.03	0.00	0.07	Landscaped Areas
C	40.00%	0.14	0.99	2.87	0.01	0.39	Compacted earth
D	50.00%	0.17	1.97	4.37	0.03	0.74	Impervious Areas
TOTAL	100.00%	0.34	1.45		0.04	1.20	
1787.12 cu ft							

Proposed

0.34 ac.

14810.4 sq ft

Determined by DB

Land Treatment	Percent	Area (ac.)	Excess Precipitation (in.)	Unit Peak Discharge (cfs/ac.)	Runoff Volume (ac. Ft.)	Peak Discharge (cfs)	Comments
A	0.00%	0.00	0.44	1.29	0.00	0.00	Natural Ground/Pond
B	8.10%	0.03	0.67	2.03	0.00	0.06	Landscaped Areas
C	50.80%	0.17	0.99	2.87	0.01	0.50	Compacted earth
D	41.10%	0.14	1.97	4.37	0.02	0.61	Impervious Areas
TOTAL	100.00%	0.34	1.37		0.04	1.16	
1686.91 cu ft							

PONDING REQUIREMENT =	1686.91	-1787.12	-100.21	cu ft.	PONDING NOT REQUIRED
Water Quality Retention Volume = 0.34" x	6086.38	sq ft	=	172.45	cu ft.
Water Quality Retention Volume Provided =				180.11	cu ft.

AS BUILT WATER QUALITY POND VOLUME

POND 1




ELEVATION	AREA	AVE AREA	DEPTH	VOLUME	CUMULATIVE VOLUME	COMMENTS
(ft)	(sq ft)	(sq ft)	(ft)	(cu ft)	(cu ft)	
5331.50	0.00					
		0.00	1.28	0.00	0.00	
5332.78	0.00					
		70.77	0.22	15.57	15.57	
5333.00	141.55					
PONDING PROVIDED				15.57		

POND 2



ELEVATION	AREA	AVE AREA	DEPTH	VOLUME	CUMULATIVE VOLUME	COMMENTS
(ft)	(sq ft)	(sq ft)	(ft)	(cu ft)	(cu ft)	
5331.50	0.00					
		0.00	0.51	0.00	0.00	
5332.01	0.00					
		60.28	0.49	29.54	29.54	
5332.50	120.57					
PONDING PROVIDED				29.54		

POND 3

ELEVATION	AREA	AVE AREA	DEPTH	VOLUME	CUMULATIVE VOLUME	COMMENTS
(ft)	(sq ft)	(sq ft)	(ft)	(cu ft)	(cu ft)	
5332.67	60.00					
		135.00	1.00	135.00	135.00	
5333.67	210.00					
		105.00	0.00	0.00	135.00	
5333.67	0.00					
PONDING PROVIDED					135.00	

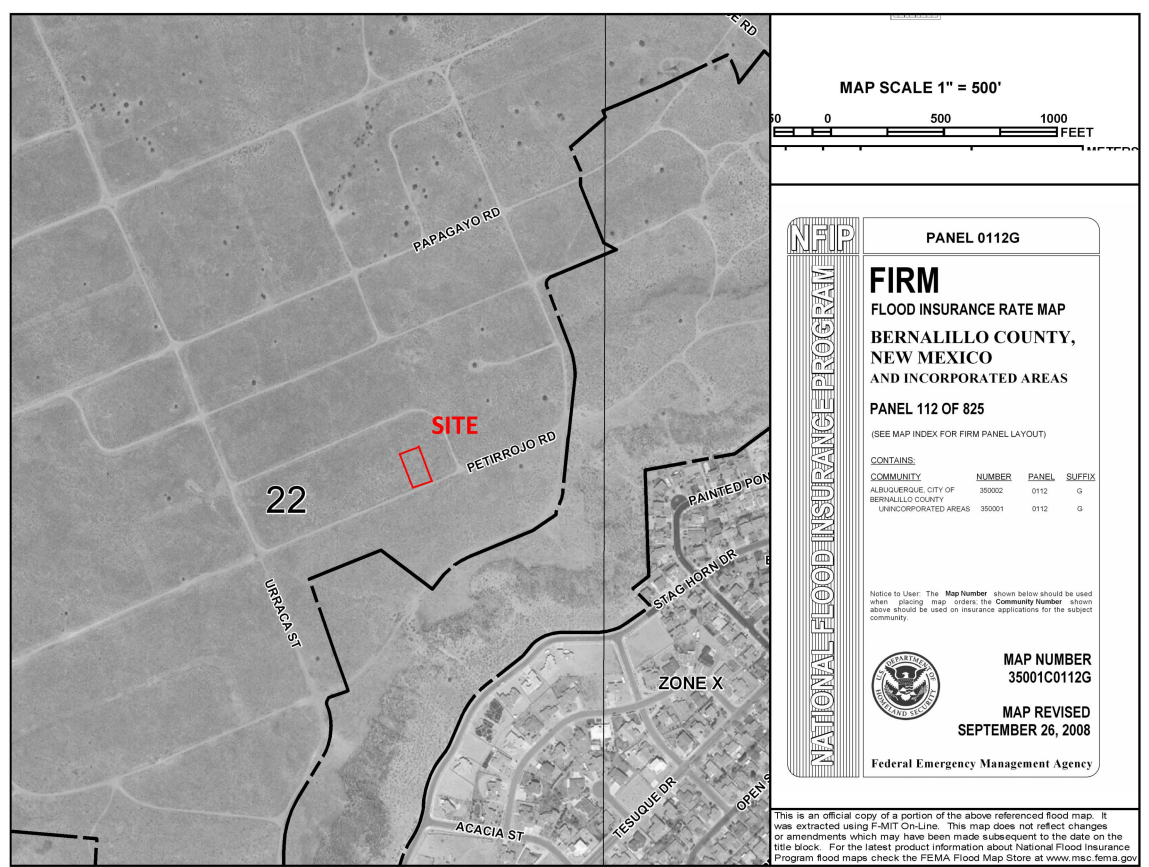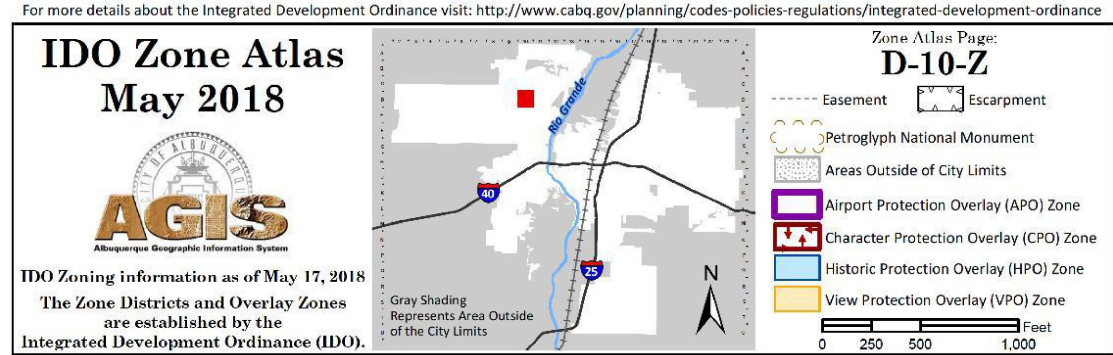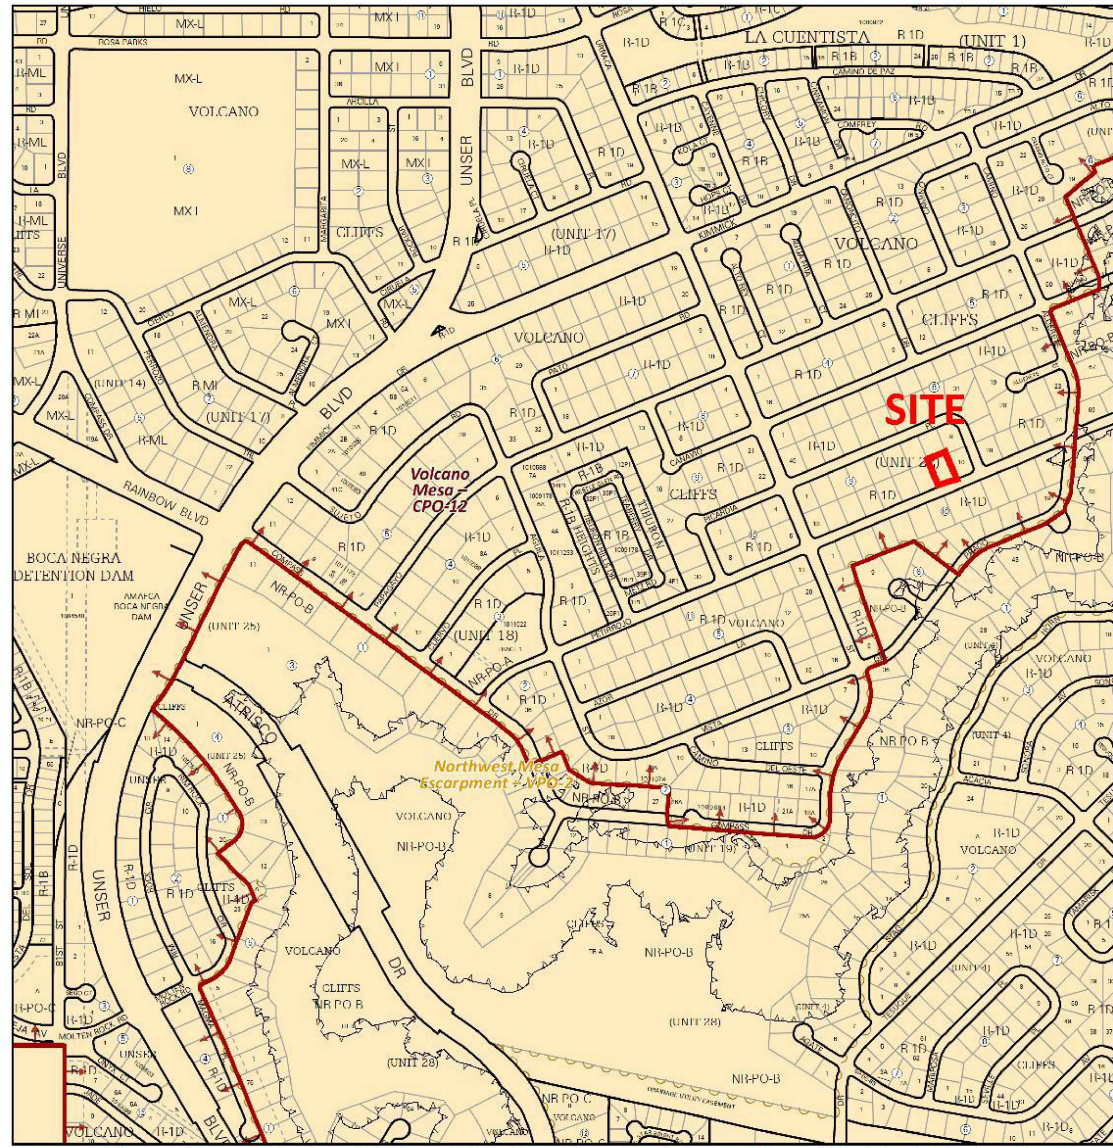

AS BUILT INFORMATION				BENCHMARKS				SURVEY INFORMATION				ENGINEER'S SEAL			
CONTRACTOR	WORK	DATE	NO.	CONTRACTOR	WORK	DATE	NO.	BY	DATE	NO.	DATE	BY	DATE	NO.	DATE
	INSPECTED	DATE			INSPECTED	DATE			DATE				DATE		
	ACCEPTANCE	DATE			ACCEPTANCE	DATE			DATE				DATE		
	VERIFICATION	DATE			VERIFICATION	DATE			DATE				DATE		
	DRAWINGS	DATE			DRAWINGS	DATE			DATE				DATE		
	RECORDING	DATE			RECORDING	DATE			DATE				DATE		

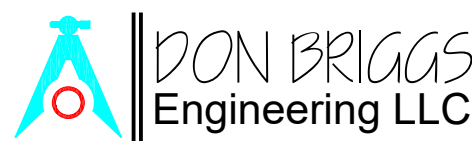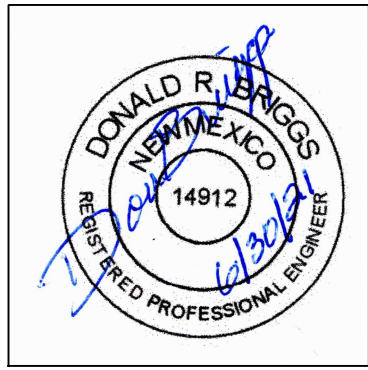

TITLE:

6405 Petirrojo Rd. NW
Grading & Drainage Plan

Design Review Committee

City Engineer Approval

City Project No.

Zone Map No.

D10D003Q11

Sheet

Of

City Project No.

Zone Map No.

D10D003Q11

Sheet

Of

