

CITY OF ALBUQUERQUE



Planning Department
Suzanne Lubar, Director

Mayor Richard J. Berry

March 15, 2016

David Soule, PE
Rio Grande Engineering
1606 Central SE Suite 201
Albuquerque, NM 87106

**Re: Mellor Residence
6309 Canavio NW
Request Permanent C.O. - Accepted
Engineer's Stamp dated: 9-10-15 (D10D003V9)
Certification dated: 3-11-16**

PO Box 1293

Dear Mr. Soule,

Albuquerque

Based on the Certification received 3/11/2016, the site is acceptable for release of Certificate of Occupancy by Hydrology.

New Mexico 87103

If you have any questions, you can contact me at 924-3986 or Totten Elliott at 924-3982.

www.cabq.gov

Sincerely,

Rita Harmon, P.E.
Senior Engineer, Planning Dept.
Development Review Services

TE/RH

C: email

Cordova, Camille C.; Miranda, Rachel; Sandoval, Darlene M.; Blocker, Lois

Weighted E Method										
Basin	100-Year SFR						Weighted E (ac-ft)	Volume (ac-ft)	Flow cfs	
	Area (sf)	Area (acres)	Treatment A % (acres)	Treatment B % (acres)	Treatment C % (acres)	Treatment D % (acres)				
UPLAND	54206.00	1.246	0%	10%	0.125	40%	0.48831	50%	0.623	1.448
NATIVE	15400.00	0.354	80%	0.2828	10%	0.035	10%	0.03535	9%	0.000
ALLOWED	15400.00	0.354	0%	0	10%	0.035	40%	0.14141	50%	0.177
PROPOSED	15400.00	0.354	0%	0	23%	0.081	38%	0.13434	39%	0.136
INCREASE										1.299
total										0.023

Equations:
Weighted E = Ea**A*a + Eb**A*b + Ec**A*c + Ed**A*d / (Total Area)
Volume = Weighted D * Total Area
Flow = Qa * *A*a + Qb * *A*b + Qc * *A*c + Qd * *A*d
Where for 100-year, 6-hour storm-zone 1
Ea= 1.29
Eb= 0.44
Ec= 0.67
Ed= 0.99
Qa= 1.29
Qb= 2.03
Qc= 2.87
Qd= 4.37


OVERFLOW CALCULATION
ONCE/10 YRS
EACH TURNED BLOCK HAS 2-6X8 OPENINGS
ON-2X 2.95X 5X1 5'11" H=1.04 CFS
SINCE 5.56 CFS USE 6 TURNED BLOCKS

ONSITE Conditions
FIRST FLUSH WATER QUALITY VOLUME REQUIRED (CF) PROVIDED (CF)
WATER QUALITY 170 1246
POND INCREASED 1002 1246

Narrative
This site is within the SAD 228 Master Drainage plan boundaries. The site is to drain to the the adjacent lot per the master drainage plan. We are ponding the increase in flow generated by the develop of this site, allowing upland flow to pass thru. This plan has a shallow water harvest pond per the new city drainage reg. This plan is in conformance to the masterplan

I David Soule, NMPE 14522 , of the firm Rio Grande Engineering, hereby certify that this project has been graded and will drain in substantial compliance with and in accordance with the design intend of the approved plan dated 9/10/15 The record information edited on the original design document has performed by me or under my direct supervision and is true and correct to the best of my knowledge and belief. The as-built survey was provided DAVID ACOSTA NMPS 21082. The certification is submitted in support of a request for PERMANENT CERTIFICATE OF OCCUPANCY. The record information presented heron is not necessarily complete and intended only to verify substantial compliance of the grading and drainage aspects of this project. Those relying on this record document are advised to obtain independent verification of its accuracy before using it for any other purpose.

TURNED BLOCKS WERE MODIFIED BASED UPON AS BUILT CONDITIONS OF ADJACENT PROPERTIES
SITE ACCEPTS FLOW AND PASSES FLOW IN CONFORMANCE TO THE MASTER DRAINAGE PLAN.

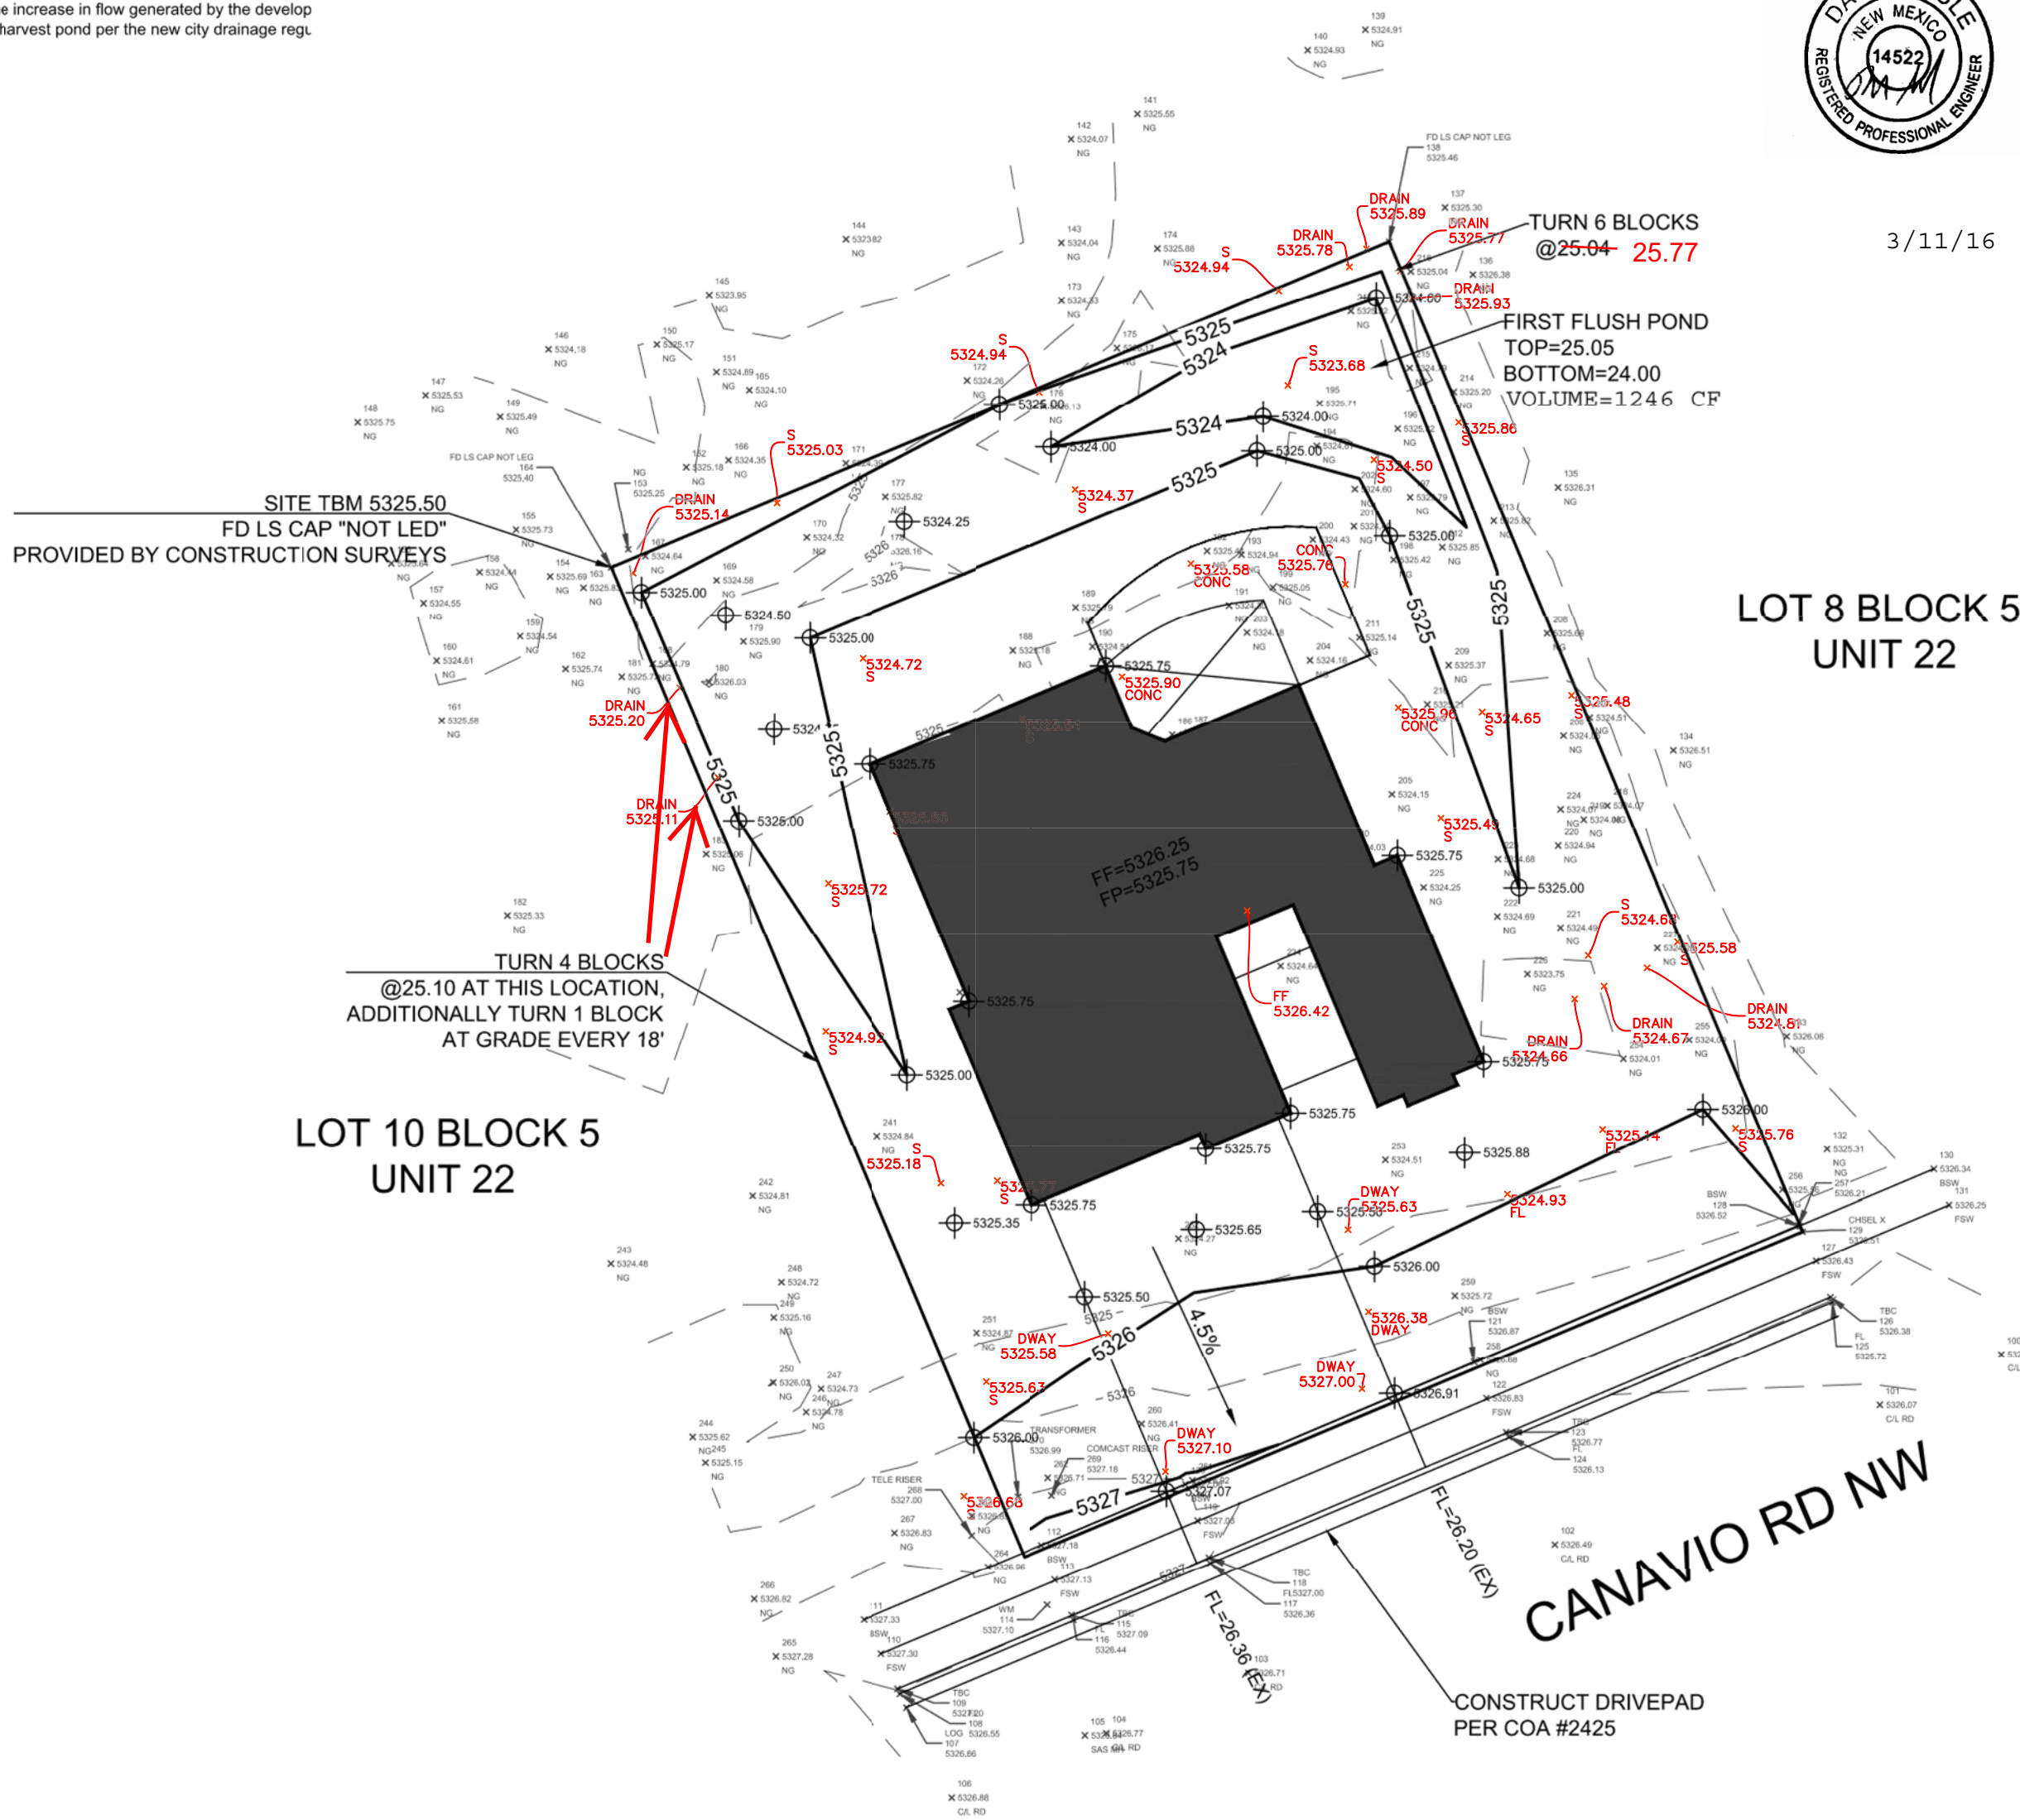



City of Albuquerque

Planning Department

Development & Building Services Division

DRAINAGE AND TRANSPORTATION INFORMATION SHEET (REV 09/2015)

Project Title: _____ **Building Permit #:** _____ **City Drainage #:** _____

DRB#: _____ **EPC#:** _____ **Work Order#:** _____

Legal Description: _____

City Address: _____

Engineering Firm: _____ **Contact:** _____

Address: _____

Phone#: _____ **Fax#:** _____ **E-mail:** _____

Owner: _____ **Contact:** _____

Address: _____

Phone#: _____ **Fax#:** _____ **E-mail:** _____

Architect: _____ **Contact:** _____

Address: _____

Phone#: _____ **Fax#:** _____ **E-mail:** _____

Other Contact: _____ **Contact:** _____

Address: _____

Phone#: _____ **Fax#:** _____ **E-mail:** _____

Check all that Apply:

DEPARTMENT:

- ☐ HYDROLOGY/ DRAINAGE
☐ TRAFFIC/ TRANSPORTATION
☐ MS4/ EROSION & SEDIMENT CONTROL

TYPE OF SUBMITTAL:

- ☐ ENGINEER/ ARCHITECT CERTIFICATION
- ☐ CONCEPTUAL G & D PLAN
☐ GRADING PLAN
☐ DRAINAGE MASTER PLAN
☐ DRAINAGE REPORT
☐ CLOMR/LOMR
- ☐ TRAFFIC CIRCULATION LAYOUT (TCL)
☐ TRAFFIC IMPACT STUDY (TIS)
☐ EROSION & SEDIMENT CONTROL PLAN (ESC)
- ☐ OTHER (SPECIFY) _____

CHECK TYPE OF APPROVAL/ACCEPTANCE SOUGHT:

- ☐ BUILDING PERMIT APPROVAL
☐ CERTIFICATE OF OCCUPANCY
- ☐ PRELIMINARY PLAT APPROVAL
☐ SITE PLAN FOR SUB'D APPROVAL
☐ SITE PLAN FOR BLDG. PERMIT APPROVAL
☐ FINAL PLAT APPROVAL
☐ SIA/ RELEASE OF FINANCIAL GUARANTEE
☐ FOUNDATION PERMIT APPROVAL
☐ GRADING PERMIT APPROVAL
☐ SO-19 APPROVAL
☐ PAVING PERMIT APPROVAL
☐ GRADING/ PAD CERTIFICATION
☐ WORK ORDER APPROVAL
☐ CLOMR/LOMR
- ☐ PRE-DESIGN MEETING
☐ OTHER (SPECIFY) _____

IS THIS A RESUBMITTAL?: ☐ Yes ☐ No

DATE SUBMITTED: _____ **By:** _____

COA STAFF: _____ ELECTRONIC SUBMITTAL RECEIVED: _____