

# CITY OF ALBUQUERQUE

Planning Department  
Alan Varela, Director



Mayor Timothy M. Keller

April 18, 2023

Reza Afaghpour, PE  
SBS Construction and Engineering, LLC  
10209 Snowflake Ct NW  
Albuquerque, NM 87114

**RE: Lot 8 Block 2 Unser Cliffs SAD 227  
6704 Rim Rock Circ. NW  
Grading and Drainage Plan  
Engineers Stamp Date 3/25/2023 (D10D025)**

Mr. Afaghpour,

Based upon the information provided in your submittal received 4/17/2023, this plan cannot be approved for grading until the following comments are addressed.

- The building pad cannot be higher than 1 foot above the road elevation, unless there is a reason given on the plan as to why it must be higher than 1 foot.
- Provide a table of land treatments for existing and proposed.

PO Box 1293

Albuquerque

If you have any questions, please contact me at 924-3695 or Rudy Rael at 924-3977.

Sincerely,

NM 87103

Tiequan Chen, P.E.  
Principal Engineer, Hydrology  
Planning Department, Development Review Services

www.cabq.gov

RR/TC  
File D10D025



# City of Albuquerque

Planning Department  
Development & Building Services Division

## DRAINAGE AND TRANSPORTATION INFORMATION SHEET (REV 6/2018)

**Project Title:** 6704 Rim Rock Circle, NW **Building Permit #:** \_\_\_\_\_ **Hydrology File #:** \_\_\_\_\_  
**DRB#:** \_\_\_\_\_ **EPC#:** \_\_\_\_\_ **Work Order#:** \_\_\_\_\_  
**Legal Description:** Lot 8, Block 2, Unser Cliffs Subdivision  
**City Address:** 6704 Rim Rock Circle, NW

**Applicant:** SBS CONSTRUCTION AND ENGINEERING, LLC **Contact:** SHAWN BIAZAR  
**Address:** 7632 William Moyers Avenue, NE, ALBUQUERQUE, NM 87114  
**Phone#:** (505) 804-5013 **Fax#:** (505) 897-4996 **E-mail:** AECLLC@AOL.COM

**Other Contact:** \_\_\_\_\_ **Contact:** \_\_\_\_\_  
**Address:** \_\_\_\_\_  
**Phone#:** \_\_\_\_\_ **Fax#:** \_\_\_\_\_ **E-mail:** \_\_\_\_\_

**TYPE OF DEVELOPMENT:** \_\_\_\_\_ PLAT (# of lots)  RESIDENCE \_\_\_\_\_ DRB SITE \_\_\_\_\_ ADMIN SITE

IS THIS A RESUBMITTAL? \_\_\_\_\_ Yes  No

**DEPARTMENT** \_\_\_\_\_ TRANSPORTATION  HYDROLOGY/DRAINAGE

Check all that Apply:

**TYPE OF SUBMITTAL:**

- ENGINEER/ARCHITECT CERTIFICATION
- PAD CERTIFICATION
- CONCEPTUAL G & D PLAN
- GRADING PLAN
- DRAINAGE REPORT
- DRAINAGE MASTER PLAN
- FLOODPLAIN DEVELOPMENT PERMIT APPLIC
- ELEVATION CERTIFICATE
- CLOMR/LOMR
- TRAFFIC CIRCULATION LAYOUT (TCL)
- TRAFFIC IMPACT STUDY (TIS)
- STREET LIGHT LAYOUT
- OTHER (SPECIFY) \_\_\_\_\_
- PRE-DESIGN MEETING?

**TYPE OF APPROVAL/ACCEPTANCE SOUGHT:**

- BUILDING PERMIT APPROVAL
- CERTIFICATE OF OCCUPANCY
- PRELIMINARY PLAT APPROVAL
- SITE PLAN FOR SUB'D APPROVAL
- SITE PLAN FOR BLDG. PERMIT APPROVAL
- FINAL PLAT APPROVAL
- SIA/ RELEASE OF FINANCIAL GUARANTEE
- FOUNDATION PERMIT APPROVAL
- GRADING PERMIT APPROVAL
- SO-19 APPROVAL
- PAVING PERMIT APPROVAL
- GRADING/ PAD CERTIFICATION
- WORK ORDER APPROVAL
- CLOMR/LOMR
- FLOODPLAIN DEVELOPMENT PERMIT
- OTHER (SPECIFY) \_\_\_\_\_

**DATE SUBMITTED:** 3/27/2023 **By:** SHAWN BIAZAR

COA STAFF:

ELECTRONIC SUBMITTAL RECEIVED: \_\_\_\_\_

FEE PAID: \_\_\_\_\_

**Location**

This project is located at 6704 Rim Rock Cir. Albuquerque, NM 87120 and contains 0.3076 acre. See attached portion of Vicinity Map D-10-Z for exact location.

**Purpose**

The purpose of this drainage report is to present a grading and drainage solution for the new house.

**Existing Drainage Conditions**

This project falls within SAD 227 master drainage plan and drain to Rim Rock Cir.

**Proposed Conditions and On-Site Drainage Management Plan**

The drainage patterns will remain the same. The site will drain to ponds A & B and then to Rim Rock Cir. Ponds A & B are designed to hold a total volume of 537.21 cf. The required first flush volume is 248.58 cf

**RUNOFF CALCULATIONS**

BASIN	AREA (SF)	AREA (AC)	AREA (MI <sup>2</sup> )
ON-SITE	13,400.47	0.30763	0.000481

$$E = \frac{EA(AA) + EB(AB) + EC(AC) + ED(AD)}{AA + AB + AC + AD}$$

EA = 0.55  
EB = 0.73  
EC = 0.95  
ED = 2.24

P-60 = 1.69  
P-360 = 2.17  
P-1440 = 2.49  
P-10 Day = 3.90

AA = 0.00%  
AB = 27.00%  
AC = 20.00%  
AD = 53.00%

**E = 1.46 IN**  
**V-360 = 0.0435 AC-FT**  
**V-360 = 1,895.31**

A = 1.54 CFS/AC  
B = 2.16 CFS/AC  
C = 2.87 CFS/AC  
D = 4.12 CFS/AC

$$\text{TOTAL QP} = \text{QPA} \cdot \text{AA} + \text{QPB} \cdot \text{AB} + \text{QPC} \cdot \text{AC} + \text{QPD} \cdot \text{AD}$$

$$= 1.23 \text{ CFS (PROPOSED)}$$

**FIRST FLUSH PONDING REQUIREMENT**


IMPERVIOUS AREA = 7,102.55 SF  
FIRST FLUSH VOL. REQUIRED. =  $0.42' \times 7,102.55 / 12 = 248.58 \text{ CF}$

**PONDING VOLUME CALCULATION**

POND A:  
AREA @ ELEV. 25.40 = 302.04 SF  
AREA @ ELEV. 24.40 = 64.25 SF  
POND VOLUME =  $(302.04 + 64.25) / 2 \times 1.00 = 183.15 \text{ CF}$

POND B:  
AREA @ ELEV. 25.40 = 530.61 SF  
AREA @ ELEV. 24.40 = 177.51 SF  
POND VOLUME =  $(530.61 + 177.51) / 2 \times 1.00 = 354.06 \text{ CF}$

TOTAL PONDING VOLUME PROVIDED = 183.15 + 354.06 = 537.21 CF

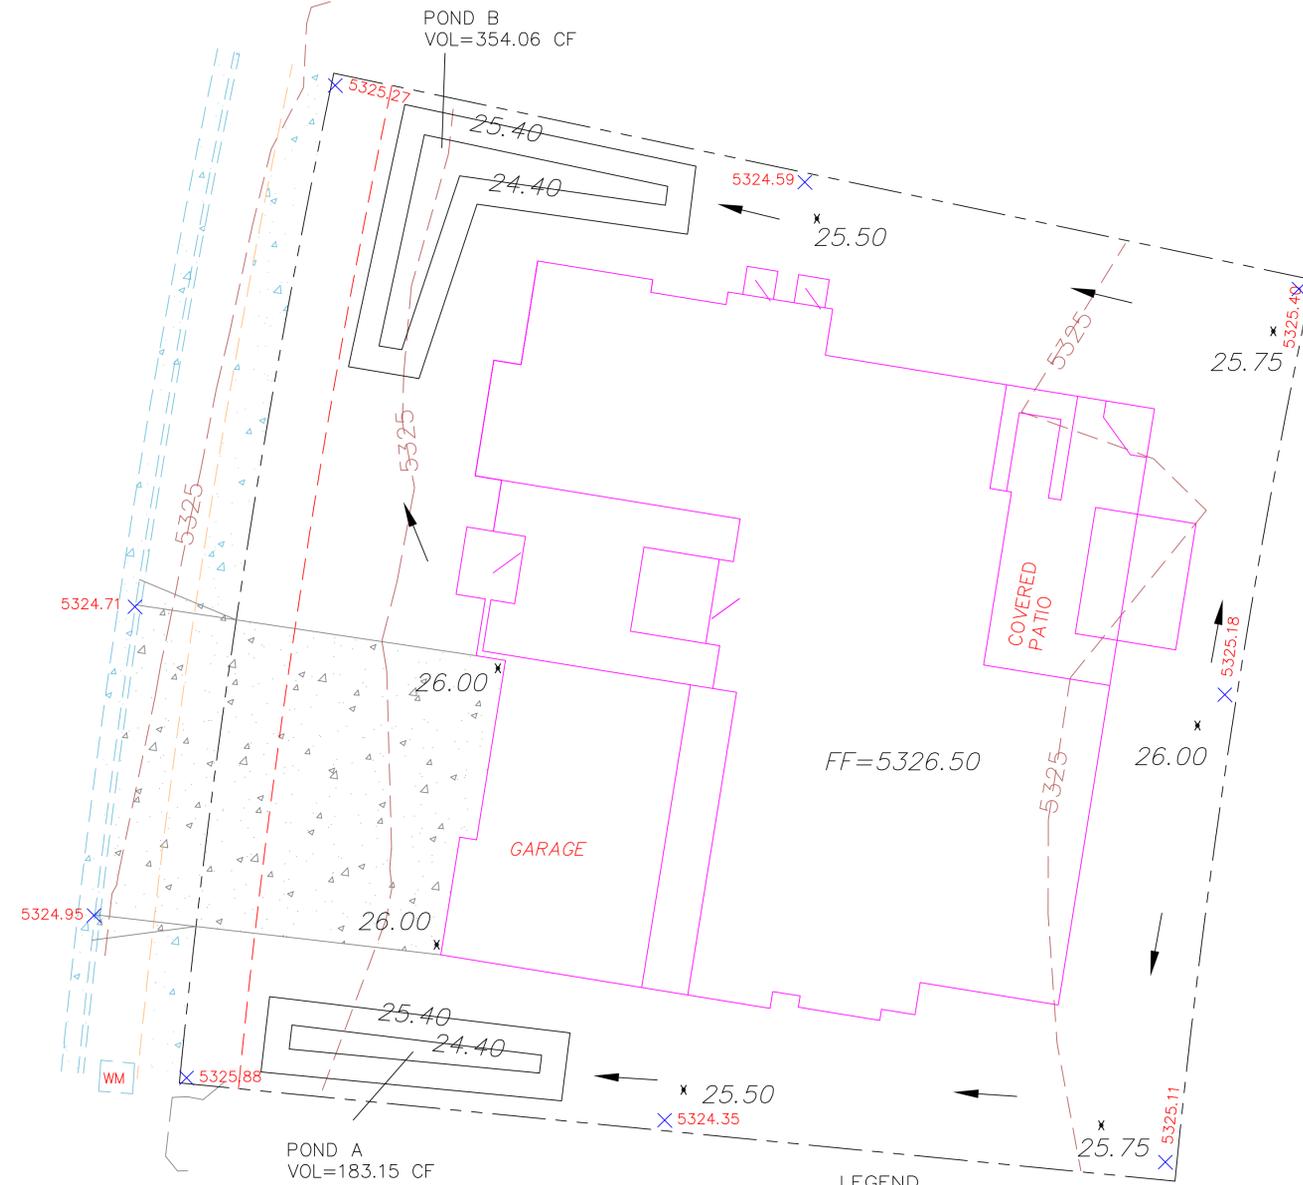

**LEGEND**


- 50.30--- EXISTING CONTOUR (MAJOR)
- 50.29--- EXISTING CONTOUR (MINOR)
- BOUNDARY LINE
- x 28.50 PROPOSED SPOT ELEVATION
- x 5029.16 EXISTING GRADE
- x 5075.65 EXISTING FLOWLINE ELEVATION
- FL
- PROPOSED RETAINING WALL
- BC=89.08 BOTTOM OF CHANEL
- TF=28.50 TOP OF FOOTING
- TRW=28.00 TOP OF RETAINING WALL
- HP HIGH POINT
- AS-BUILT GRADES
- AS-BUILT SPOT ELEVATIONS



REZA AFAGHPOUR  
P.E. #11814

**SBS CONSTRUCTION AND ENGINEERING, LLC**

7632 WILLIAM MOYERS AVE., NE  
ALBUQUERQUE, NEW MEXICO 87122  
(505)804-5013

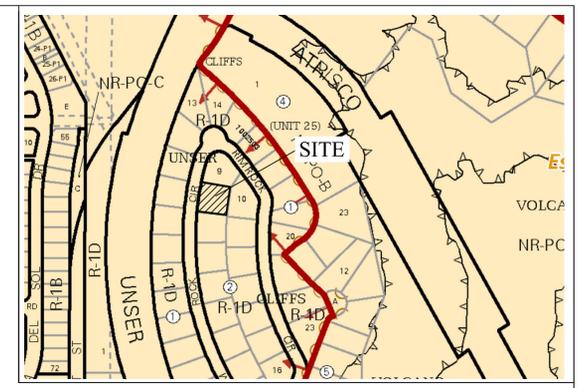

LEGAL DESCRIPTION:  
LOT 8, BLOCK 2, UNSER CLIFFS SUBDIVISION  
ADDRESS: 6704 RIM ROCK CIR NW ALBUQUERQUE NM 87120

BENCHMARK  
CITY BNCHMARK 17\_D10, ELEVATION OF 5325.068 FEET ABOVE SEA LEVEL.

**EROSION CONTROL PLAN AND POLLUTION PREVENTION NOTES**

1. CONTRACTOR IS RESPONSIBLE FOR OBTAINING A TOPSOIL DISTURBANCE PERMIT PRIOR TO BEGINNING WORK.
2. CONTRACTOR IS RESPONSIBLE FOR CLEANING ALL SEDIMENT OUT OF EXISTING RIGHT-OF-WAY.
3. CONTRACTOR IS RESPONSIBLE FOR MAINTAINING ALL STORM RUNOFF ON SITE.
4. REPAIR OF DAMAGED FACILITIES AND CLEAN-UP OF SEDIMENT ACCUMULATION ON ADJACENT PROPERTIES AND IN PUBLIC FACILITIES IS THE RESPONSIBILITY OF THE CONTRACTOR.
5. ALL EXPOSED EARTH SURFACES MUST BE PROTECTED FROM WIND AND WATER EROSION PRIOR TO FINAL ACCEPTANCE OF ANY PROJECT.

- GENERAL NOTES:**
- 1: CONTOUR INTERVAL IS HALF (1.00) FOOT.
  - 2: ELEVATIONS ARE BASED ON CITY OF ALBUQUERQUE CONTROL STATION 17\_D10, HAVING AN ELEVATION OF 5325.068 FEET ABOVE SEA LEVEL.
  - 3: UTILITIES SHOWN HEREON ARE IN THEIR APPROXIMATE LOCATION BASED ONLY ON ABOVE GROUND EVIDENCE FOUND IN THE FIELD AND AS-BUILT INFORMATION PROVIDED BY THE CLIENT. UTILITIES SHOWN HEREON, WHETHER INDICATED AS ABANDONED OR NOT, SHALL BE VERIFIED BY OTHERS FOR EXACT LOCATION AND/ OR DEPTH PRIOR TO EXCAVATION OR DESIGN CONSIDERATIONS.
  - 4: THIS IS NOT A BOUNDARY SURVEY, BEARINGS ARE ASSUMED, DISTANCES AND FOUND PROPERTY CORNERS ARE FOR INFORMATIONAL PURPOSES ONLY.
  - 5: SLOPES ARE AT 3:1 MAXIMUM.
  - 6: ADD 5300 TO ALL PROPOSED SPOT ELEVATIONS.

<b>6704 RIM ROCK CIR NW GRADING PLAN</b>			
DRAWING: RIM ROCK GD.dwg	DRAWN BY: SH-B	DATE: 3/25/2023	SHEET # <b>1</b>

LAST REVISION: 3/25/2023