CITY OF ALBUQUERQUE

Planning Department Alan Varela, Director



July 2, 2025

David Soule, P.E. Rio Grande Engineering P.O. Box 93924 Albuquerque, NM 87199

RE: 6605 Rim Rock Cir. NW

Permanent C.O. - Accepted

Engineer's Certification Date: 6/29/25

Engineer's Stamp Date: 3/22/24

Hydrology File: D10D026 Case # HYDR-2025-00230

Dear Mr. Soule:

PO Box 1293

Based on the Certification received 06/30/2025 and the site visit on 7/2/2025, this letter serves an approval of the certification in support of a Permanent Certificate of Occupancy to be issued by the Building and Safety Division.

Albuquerque

If you have any questions, please contact me at 505-924-3314 or amontoya@cabq.gov.

NM 87103

Sincerely,

www.cabq.gov

Anthony Montoya, Jr., P.E., CFM Senior Engineer, Hydrology

anth Mar

Planning Department, Development Review Services

Weighted E Method

											100-Year, 6-hr.			24 hour
Basin	Area	Area	Treatment A		Treatment B		Treatment C		Treatment D		Weighted E	Volume	Flow	Volume
	(sf)	(acres)	%	(acres)	%	(acres)	%	(acres)	%	(acres)	(ac-ft)	(ac-ft)	cfs	(ac-ft)
ALLOWED	16354.00	0.375	0%	0	24%	0.090	40%	0.1502	36%	0.135	1.362	0.043	1.18	0.052
PROPOSED	16354.00	0.375	0%	0	21%	0.079	27%	0.1014	52%	0.195	1.575	0.049	1.27	0.062
COMPARISON												0.007		0.011

Weighted E = Ea*Aa + Eb*Ab + Ec*Ac + Ed*Ad / (Total Area)

Volume = Weighted D * Total Area

Flow = Qa * Aa + Qb * Ab + Qc * Ac + Qd * Ad

Where for 100-year, 6-hour storm-zone

Qa= 1.54 Qb= 2.16 Qc= 2.87 Qd= 4.12

ONSITE Conditions

FIRST FLUSH WATER QUALITY VOLUME

PROVIDED (CF)

WATER QUALITY FLOOD CONTROL

Narrative

This site is within the SAD 227 Master Drainage plan boundaries. The site is to maintain existing patterns and drain to the adjacent roadway to the south per the master drainage plan. The site does exceed the SAD 227 developed conditions assumptions, therefore ponding OF 883 CF is required. Due to hight restrictions we have incorporated ponding to minimize the pad height as much as possible. We are ponding the water harvest volume generated by the site. All building generated water drains to street. This plan is in conformance to the master drainage plan

I, DAVID SOULE HAVE PERSONALLY INPECTED THE SITE. I HEREBY CERTIFY THE PAD HAS BEEN CONSTRUCTED SUCH THAT IT IS IN SUBSTANTIAL CONFORMANCE TO THE APPROVED GRADING PLAN DATED 3/22/24




EROSION CONTROL NOTES:


EXISTING RIGHT-OF-WAY.


- 1. CONTRACTOR IS RESPONSIBLE FOR OBTAINING A TOPSOIL DISTURBANCE PERMIT
- 2. CONTRACTOR IS RESPONSIBLE FOR MAINTAINING RUN-OFF ON SITE DURING
- 3. CONTRACTOR IS RESPONSIBLE FOR CLEANING ALL SEDIMENT THAT GETS INTO
- 4. REPAIR OF DAMAGED FACILITIES AND CLEANUP OF SEDIMENT ACCUMULATIONS ON ADJACENT PROPERTIES AND IN PUBLIC FACILITIES IS THE RESPONSIBILITY OF THE
- EROSION PRIOR TO FINAL ACCEPTANCE OF ANY PROJECT

I <u>David Soule</u>, NMPE 14522, of the firm <u>Rio Grande Engineering</u>, hereby certify that this project has been graded and will drain in substantial compliance with and in accordance with the design intend of the approved plan dated 3/22/24 The certification is submitted in support of a request for <u>CERTIFICATE OR OCCUPANCY</u>. The record information presented heron is not necessarily complete and intended only to verify substantial compliance of the grading and drainage aspects of this project.

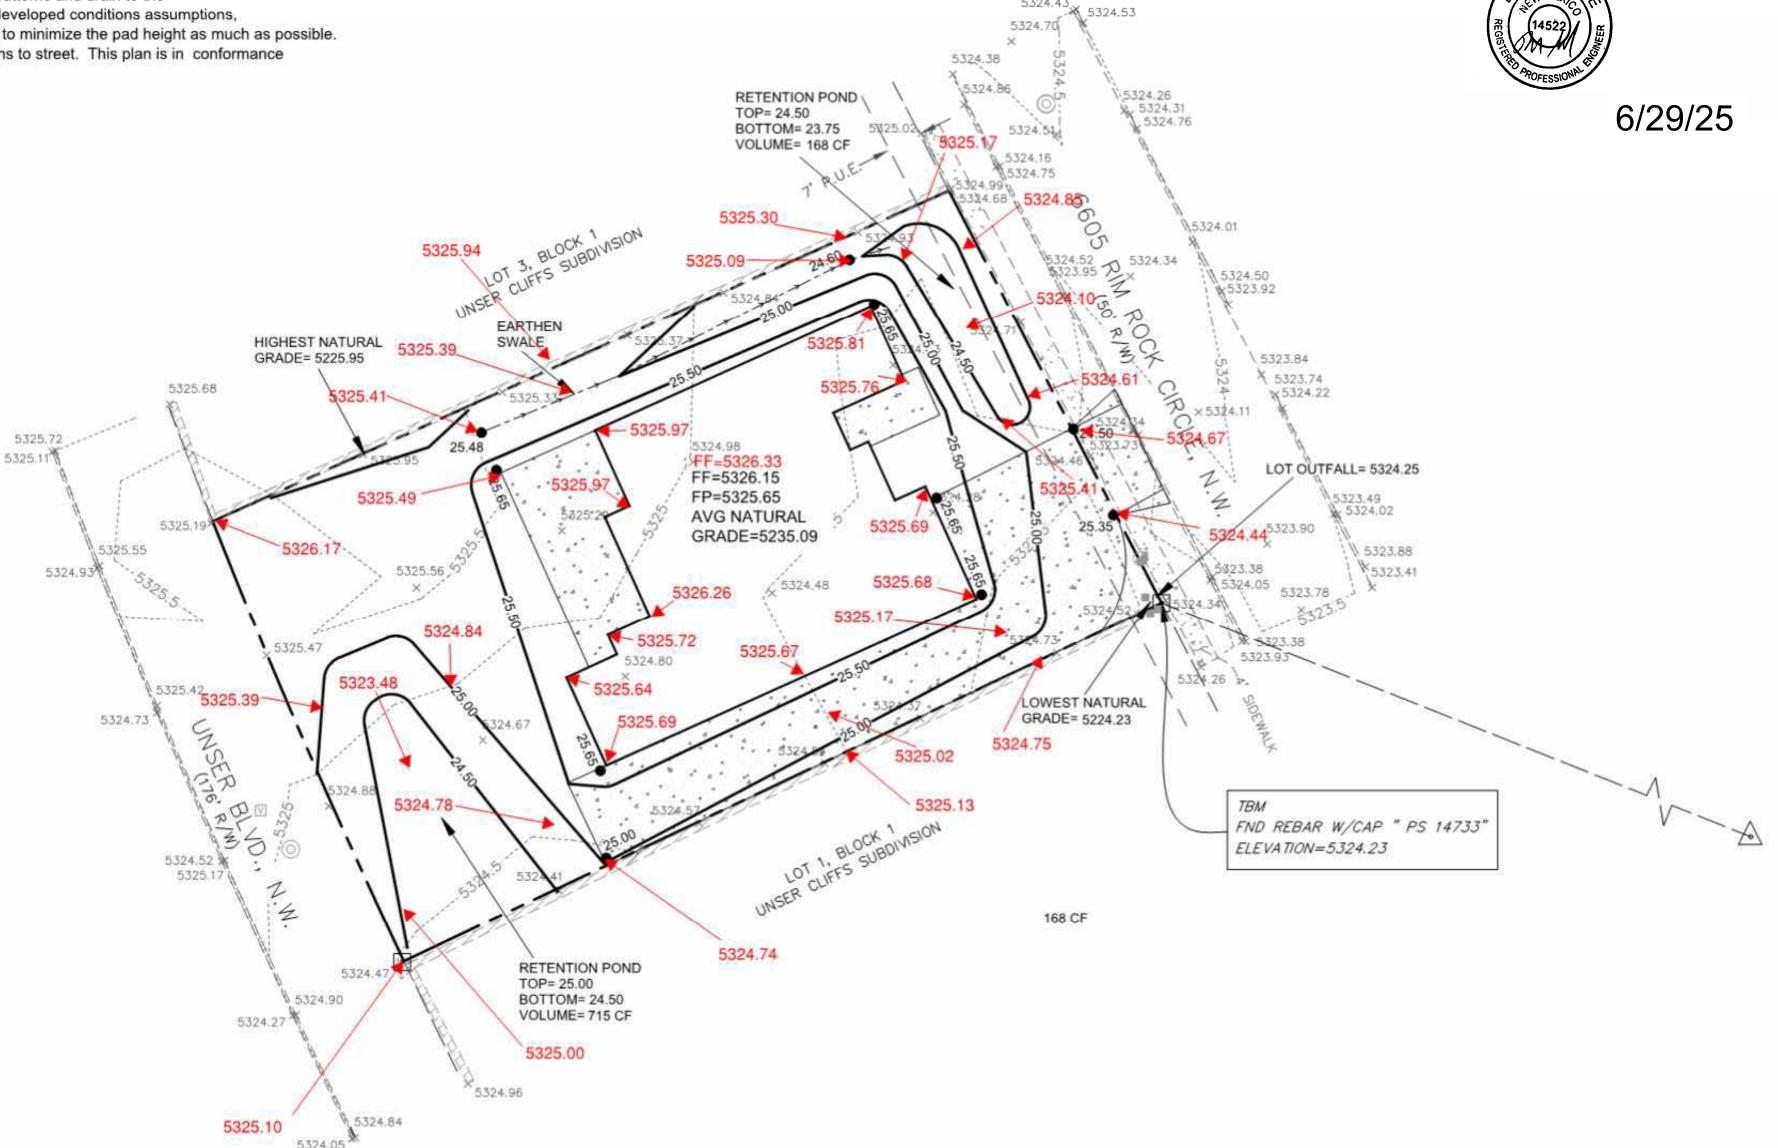

"ASBUILT" EXISTING UTILITIES ARE NOT SHOWN. 06/11/2025 DATE:

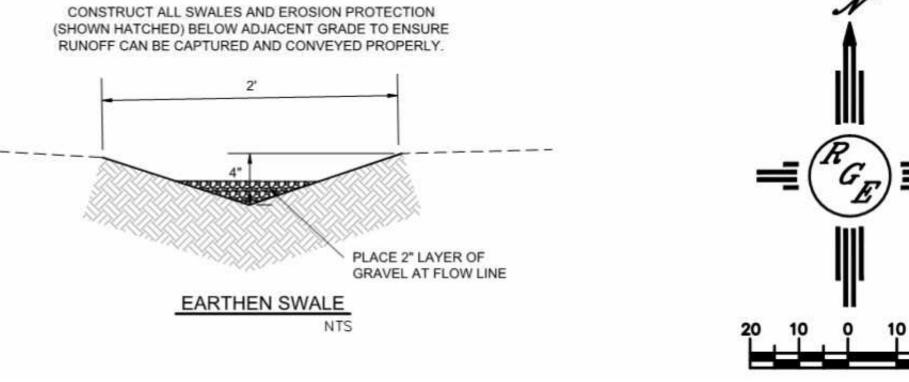

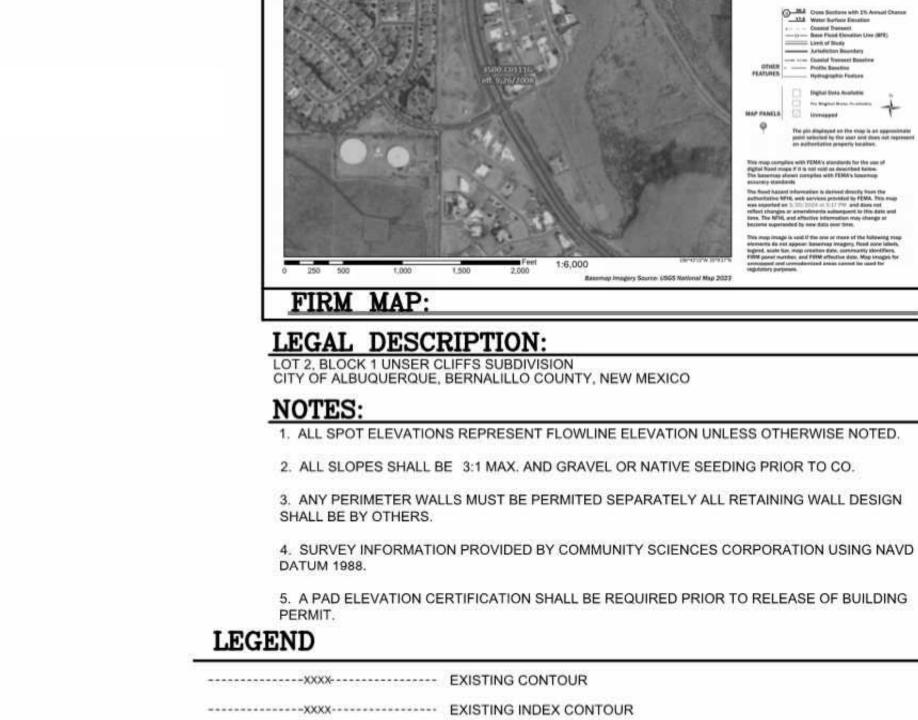

PROPOSED CONTOUR

PROPOSED INDEX CONTOUR


EXISTING SPOT ELEVATION

PROPOSED CONCRETE

PROPOSED SPOT ELEVATION

VICINITY MAP: D-10-2

National Flood Hazard Layer FIRMette

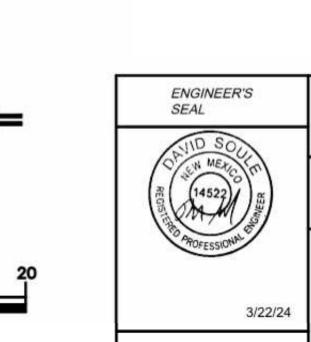

DAVID SOULE P.E. #14522

SCALE: 1"=20'

XXXX

2. 1. 1.

---- BOUNDARY

— — — — ADJACENT BOUNDARY

■■■■■■■■■■■ EXISTING CURB AND GUTTER

PROPOSED EARTHEN SWALE

LOT 2 BLK 1 UNSER CLIFFS SUB. 6605 RIM ROCK CIRCLE NW GRADING AND



SHEET#

JOB#

BY DEM

DATE 3-21-24

6605 Rim Rock Circle NW .DWG

IMPROVEMENTS.

CAUTION:

IT SHALL BE THE SOLE RESPONSIBILITY OF THE CONTRACTOR TO CONDUCT ALL NECESSARY FIELD INVESTIGATIONS PRIOR TO ANY EXCAVATION TO DETERMINE THE ACTUAL LOCATION OF UTILITIES & OTHER