


# GRADING AND DRAINAGE LEGEND:

TA	TOP OF ASPHALT	70	PROPOSED CONTOUR
FL	FLOWLINE		DRAINAGE BASIN-BOUNDARY
TC	TOP OF CURB/CONCRETE		DEFERRED SIDEWALK
TF	TOP OF FOOTING		NEW SIDEWALK
R/W	RIGHT-OF-WAY		DISCHARGE
PL	PROPERTY LINE		RETAINING WALL
PP	POWER POLE		NEW STORM DRAIN (SEE PLAN FOR SIZE)
⊙	GAS LINE MARKER	Q=XX.XX CFS	
—5065—	EXISTING CONTOUR	XX" SD	
⊗ TC 68.78	PROPOSED SPOT ELEVATION		
⊗ TF 62.25	EXISTING SPOT ELEVATION		

SCALE: 1" = 60'

CONCRETE CHANNEL

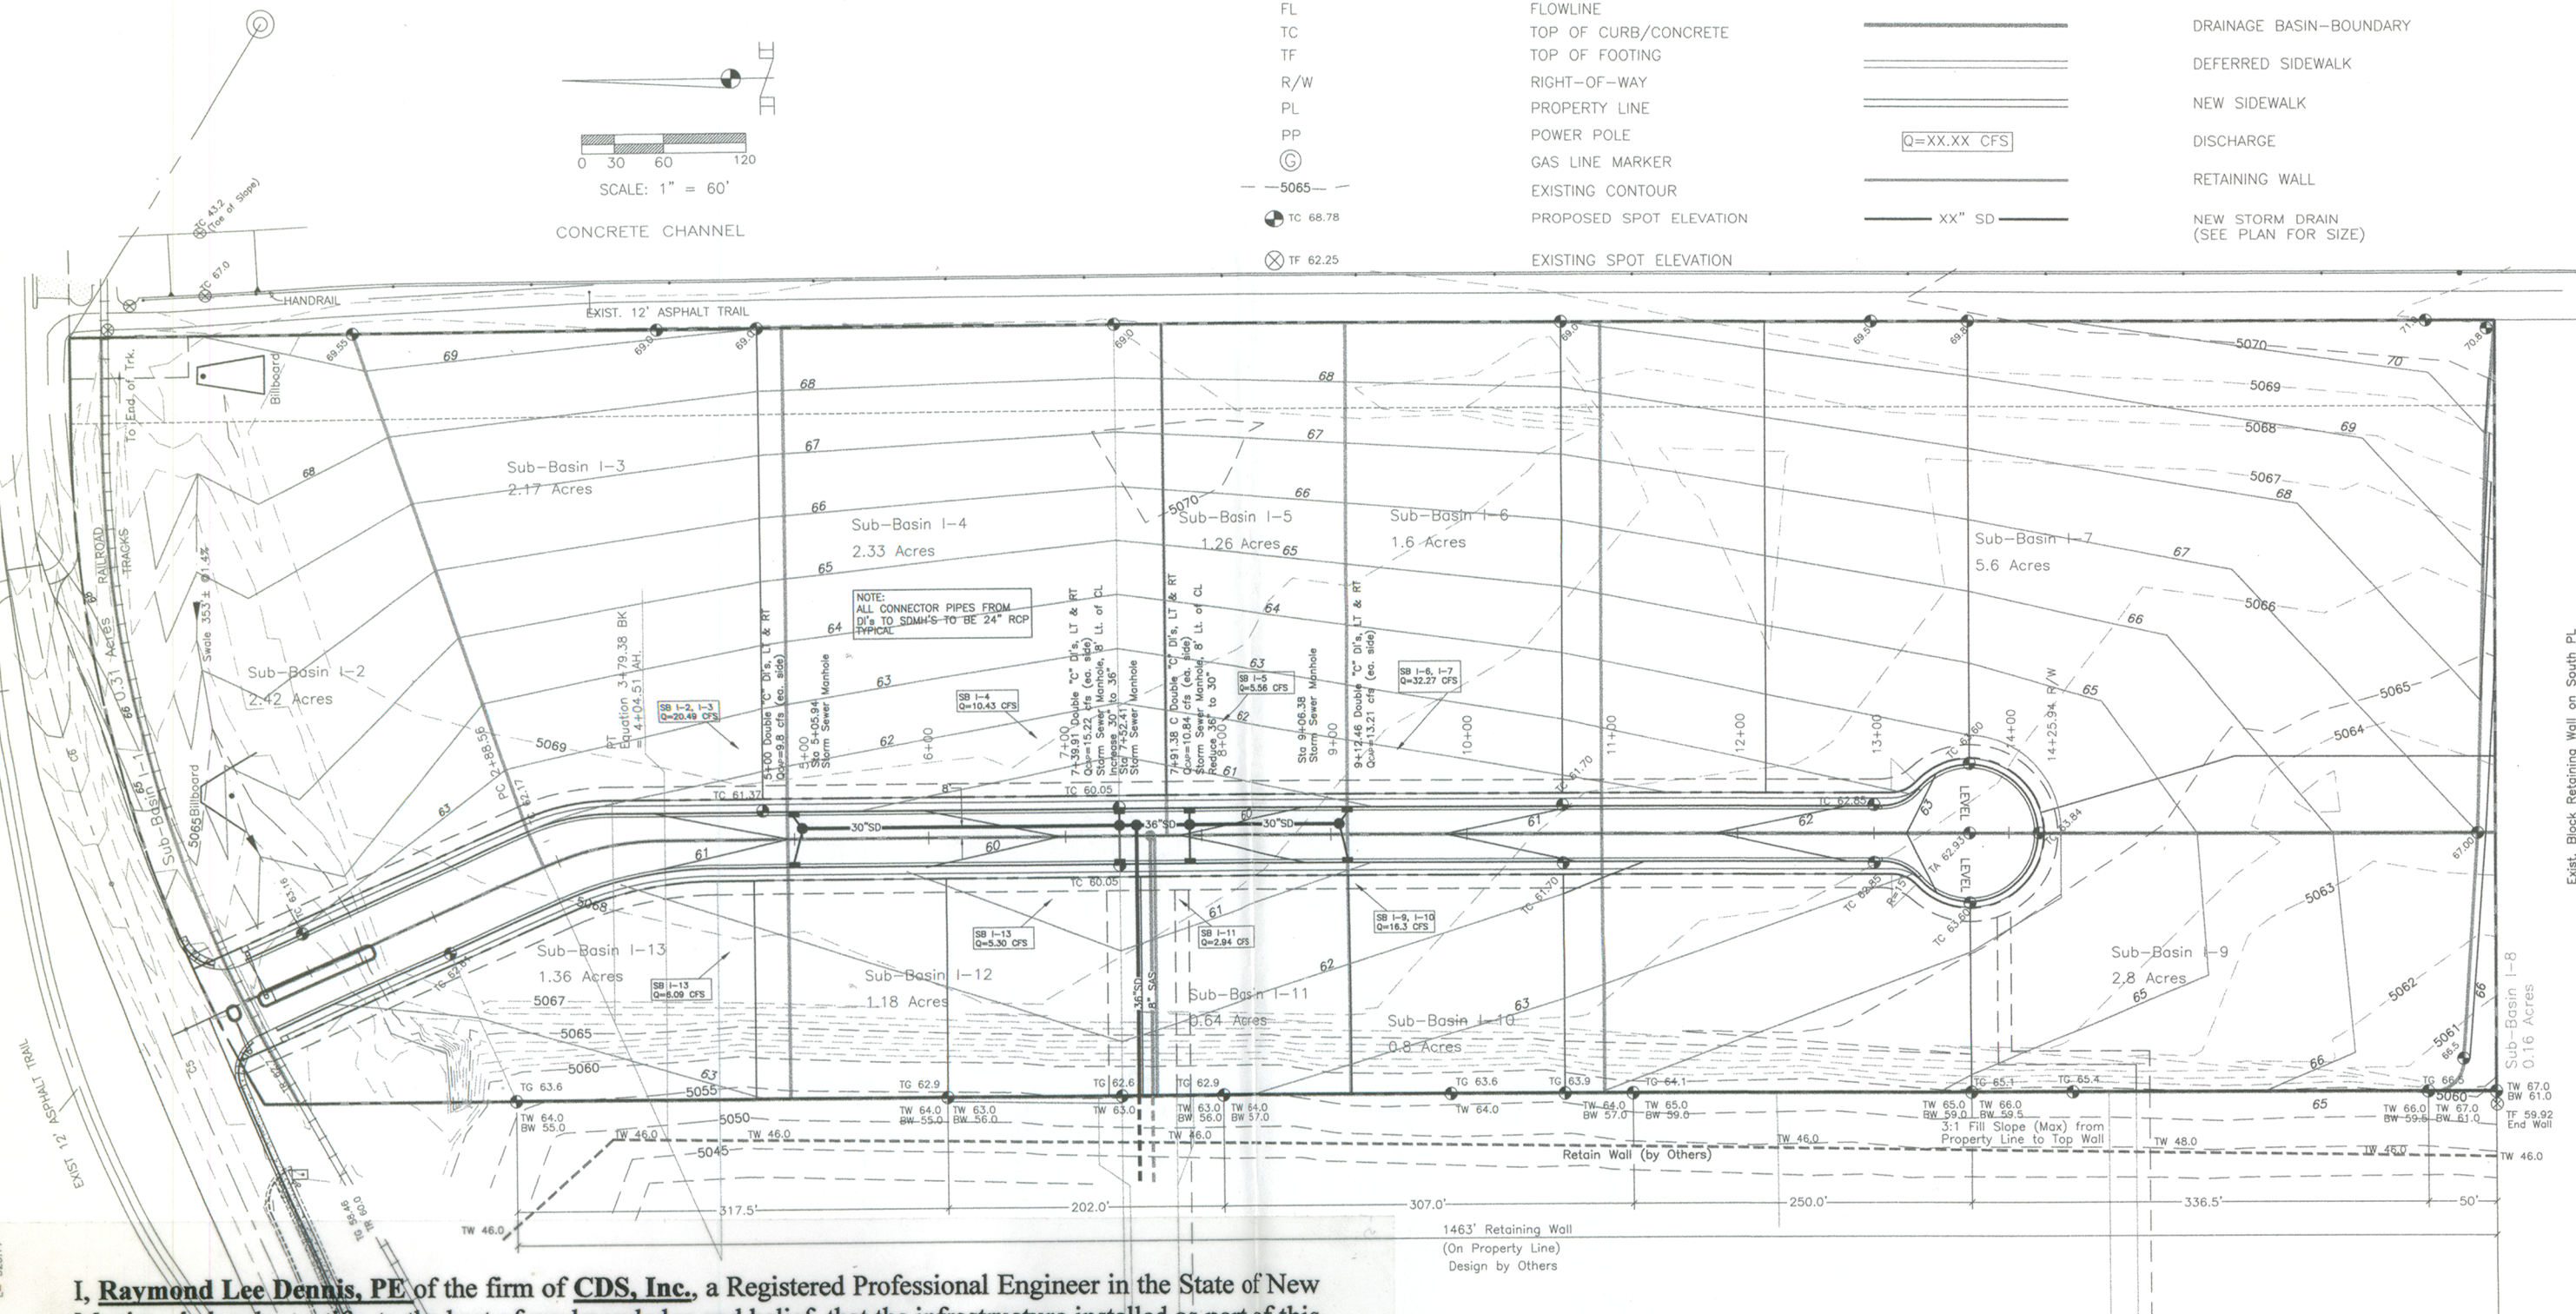


I, **Raymond Lee Dennis, PE** of the firm of **CDS, Inc.**, a Registered Professional Engineer in the State of New Mexico, do hereby certify, to the best of my knowledge and belief, that the infrastructure installed as part of this project has been inspected by me or by a qualified person under my direct supervision and has been constructed in accordance with the plans and specifications approved by the City Engineer and that the original design intent of the approved plans has been met, except as noted by me on the as-built construction drawings. This Certification is based on site inspections by me or personnel under my direction and survey information provided by **Chris Medina of Terra Land Surveys, NMPS number 15702.**

Raymond Lee Dennis, NMPE 4115

Date

12-19-2007

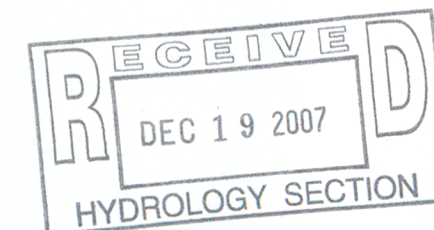

BENCH MARKS
ACS MONUMENT "A-A-9"
Y=1,518,711.30, X=394,134.18
G-G = 0.99967037
Δα = 00°12'15", CENTRAL ZONE, (NAD 1927)
ELEVATION = 5069.27 (SLD 1929)

AS-BUILT INFORMATION
CONTRACTOR:
WORK STARTED ON:
INSPECTOR'S ACCEPTANCE BY:
FIELD VERIFICATION BY:
DRAWINGS CORRECTED BY:
MICRO-FILM INFORMATION
RECORDED BY:
DATE:
NO.:

ENGINEER'S SEAL
RAYMOND LEE DENNIS
NEW MEXICO
REGISTERED PROFESSIONAL ENGINEER
4115

SURVEY INFORMATION
FIELD NOTES
NO.
BY
DATE
NO.
DATE
REMARKS
REVISIONS
DESIGN
DESIGN: SRW, RLD
DRAWN: SRW, KN
CHECKED: RLD
DATE: 5/24/06
DATE: 5/24/06
DATE: 5/24/06

<b>DENNIS ENGINEERING COMPANY</b> PO Box 909, (38 Cactus Road) Edgewood, New Mexico 87015 (505) 281-2880	
CITY OF ALBUQUERQUE PUBLIC WORKS DEPARTMENT	
TITLE: <b>BLUE SKY BUSINESS PARK GRADING AND DRAINAGE PLAN</b>	
DESIGN REVIEW COMMITTEE	CITY ENGINEER APPROVAL
<i>Information Only</i>	
CITY PROJECT NO.	ZONE MAP NO.
666589	D-16
MO./DAY/YR.	SHEET
5/24/06	3 OF 13
6/21/06	

FILE PATH:	FILE NAME:
PLOT DATE:	PLOT TIME:

EL PUEBLO CL CURVE DATA  
 C4 D=1752.31' C5 D=1646.13' C6 D=1646.13'  
 R=850.00' R=524.83' R=524.83'  
 L=361.20' L=361.20' L=361.20'