

GRADING NOTES

- EXCEPT AS PROVIDED HEREIN, GRADING SHALL BE PERFORMED AT THE ELEVATIONS AND IN ACCORDANCE WITH THE DETAILS SHOWN ON THIS PLAN.
- THE COST FOR REQUIRED CONSTRUCTION DUST AND EROSION CONTROL MEASURES SHALL BE INCIDENTAL TO THE PROJECT COST.
- ALL WORK RELATIVE TO FOUNDATION CONSTRUCTION, SITE PREPARATION, AND PAVEMENT INSTALLATION, AS SHOWN ON THIS PLAN, SHALL BE CONSTRUCTED IN ACCORDANCE WITH THE "GEOTECHNICAL INVESTIGATION," AS PROVIDED BY THE ARCHITECT OR OWNER. ALL OTHER WORK SHALL, UNLESS OTHERWISE STATED OR PROVIDED FOR HEREON, BE CONSTRUCTED IN ACCORDANCE WITH THE PROJECT, (FIRST PRIORITY) SPECIFICATIONS, AND/OR THE CITY OF ALBUQUERQUE (COA) STANDARD SPECIFICATIONS FOR PUBLIC WORKS (SECOND PRIORITY).
- EARTH SLOPES SHALL NOT EXCEED 3 HORIZONTAL TO 1 VERTICAL UNLESS SHOWN OTHERWISE.
- IT IS THE INTENT OF THESE PLANS THAT THIS CONTRACTOR SHALL NOT PERFORM ANY WORK OUTSIDE OF THE PROPERTY BOUNDARIES EXCEPT AS REQUIRED BY THIS PLAN.
- THE CONTRACTOR IS TO ENSURE THAT NO SOIL ERODES FROM THE SITE ONTO ADJACENT PROPERTY OR PUBLIC RIGHT-OF-WAY. THIS SHOULD BE ACHIEVED BY CONSTRUCTING TEMPORARY BERMS OR SILT FENCE AT THE PROPERTY LINES AND WETTING THE SOIL TO PROTECT IT FROM WIND EROSION.
- A DISPOSAL SITE FOR ANY & ALL EXCESS EXCAVATION MATERIAL, AND UNSUITABLE MATERIAL AND/OR A BORROW SITE CONTAINING ACCEPTABLE FILL MATERIAL SHALL BE OBTAINED BY THE CONTRACTOR IN COMPLIANCE WITH APPLICABLE ENVIRONMENTAL REGULATIONS AND APPROVED BY THE OBSERVER. ALL COSTS INCURRED IN OBTAINING A DISPOSAL OR BORROW SITE AND Haul TO OR FROM SHALL BE CONSIDERED INCIDENTAL TO THE PROJECT AND NO SEPARATE MEASUREMENT OR PAYMENT SHALL BE MADE.
- PAVING AND ROADWAY GRADES SHALL BE +/- 0.1' FROM PLAN ELEVATIONS. PAD ELEVATION SHALL BE +/- 0.05' FROM BUILDING PLAN ELEVATION.
- ALL PROPOSED CONTOURS REFLECT TOP OF PAVEMENT ELEVATIONS IN THE PARKING AREA AND MUST BE ADJUSTED FOR MEDIANS AND ISLANDS.
- VERIFY ALL ELEVATIONS SHOWN ON PLAN FROM BASIS OF ELEVATION CONTROL STATION PRIOR TO BEGINNING CONSTRUCTION.

LEGEND



---	PROPERTY LINE	---	PROPOSED INDEX CONTOURS
---	EXISTING CONTOURS	---	PROPOSED INTER CONTOURS
5301.15	EXISTING GROUND SPOT ELEVATION	---	PROPOSED CURB & GUTTER
65.23	EXISTING ELECTRICAL POLE	---	EASEMENT
65.23	PROPOSED SPOT ELEVATION	---	EXISTING TREE
TC=52.84 FL=52.52	TOP OF CURB, FL=FLOW LINE EX=EXISTING, TO=TOP OF GRADE		
S=2.0%	PROPOSED DIRECTION OF FLOW		
---	WATER BLOCK		
---	PROPOSED RETAINING WALL		

DRAINAGE CERTIFICATION

I, BRUCE STODWORTHY, NMPE 14523, OF THE FIRM BOHANNAN HUSTON INC., HEREBY CERTIFY THAT THIS PROJECT HAS BEEN GRADED AND WILL DRAIN IN SUBSTANTIAL COMPLIANCE WITH AND IN ACCORDANCE WITH THE DESIGN INTENT OF THE APPROVED PLAN AND ENGINEER'S STAMP DATED 8/1/05. THE RECORD INFORMATION EDITED ONTO THE ORIGINAL DESIGN DOCUMENT HAS BEEN OBTAINED BY LARRY MEDRANO, NMPS 11993, OF THE FIRM PRECISION SURVEYS, I. FURTHER CERTIFY THAT I HAVE PERSONALLY VISITED THE PROJECT SITE ON 7/17/05 AND HAVE DETERMINED BY VISUAL INSPECTION THAT THE SURVEY DATA PROVIDED IS REPRESENTATIVE OF ACTUAL SITE CONDITIONS AND IS TRUE AND CORRECT TO THE BEST OF MY KNOWLEDGE AND BELIEF. THIS CERTIFICATION IS SUBMITTED IN SUPPORT OF A REQUEST FOR PERMANENT C.O.

THE RECORD INFORMATION PRESENTED HEREON IS NOT NECESSARILY COMPLETE AND INTENDED ONLY TO VERIFY SUBSTANTIAL COMPLIANCE OF THE GRADING AND DRAINAGE ASPECTS OF THIS PROJECT. THOSE RELYING ON THIS RECORD DOCUMENT ARE ADVISED TO OBTAIN INDEPENDENT VERIFICATION OF ITS ACCURACY BEFORE USING IT FOR ANY OTHER PURPOSE.

BRUCE STODWORTHY
NEW MEXICO
14523
8/1/05

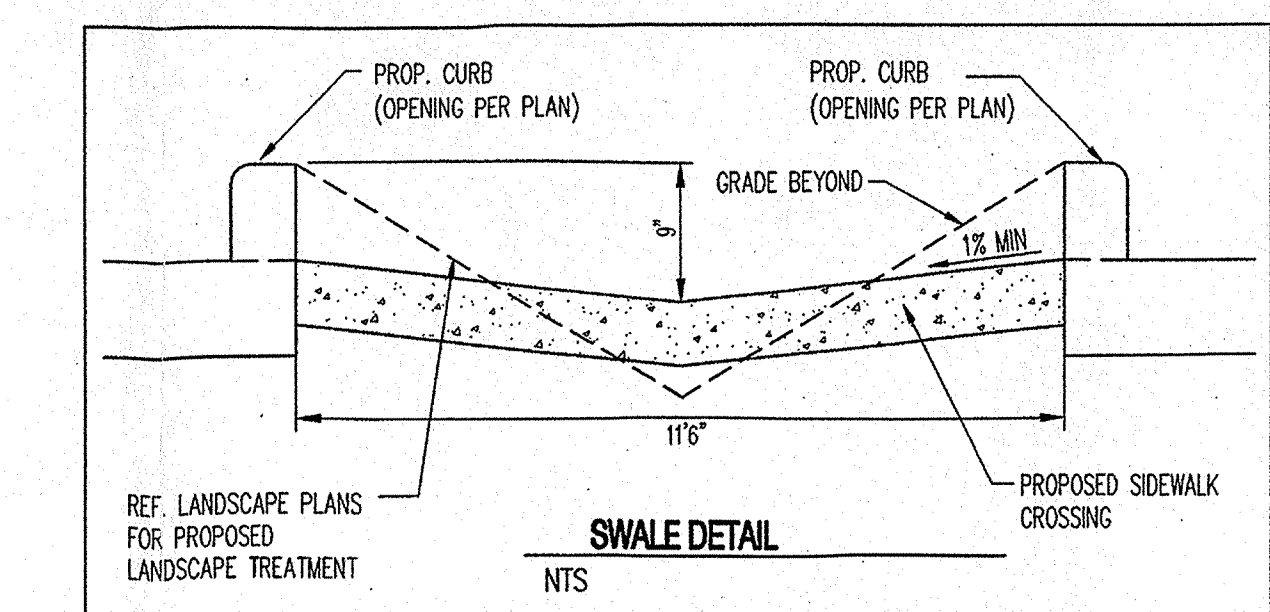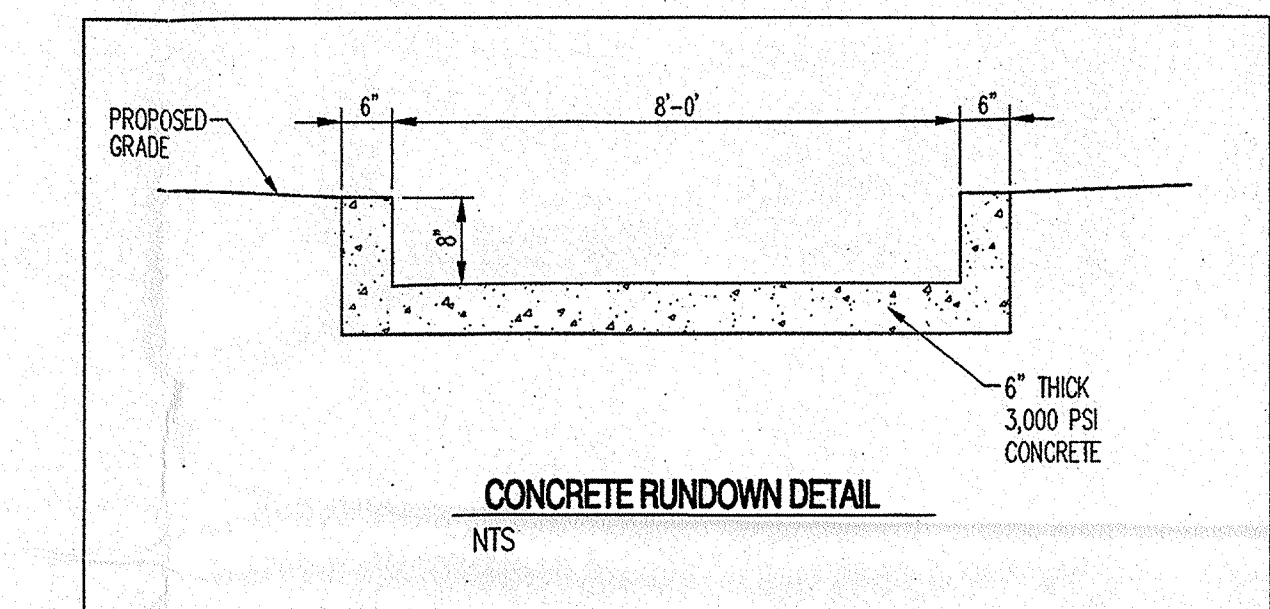

Bohannon & Huston

Courtyard | 7600 Jefferson St. NE Albuquerque, NM 87109-4335
ENGINEERING & SPATIAL DATA & ADVANCED TECHNOLOGIES

Journal Center Tract 5
Office Building A
7601 Jefferson NE
Albuquerque, New Mexico 87109

REVISIONS

△
△
DRAWN BY: CM
REVIEWED BY: JTM
DATE: 8/15/05


PROJECT NO.: 04186
DRAWING NAME:

OVERALL GRADING
& DRAINAGE PLAN

SHEET NO.

C101

OF

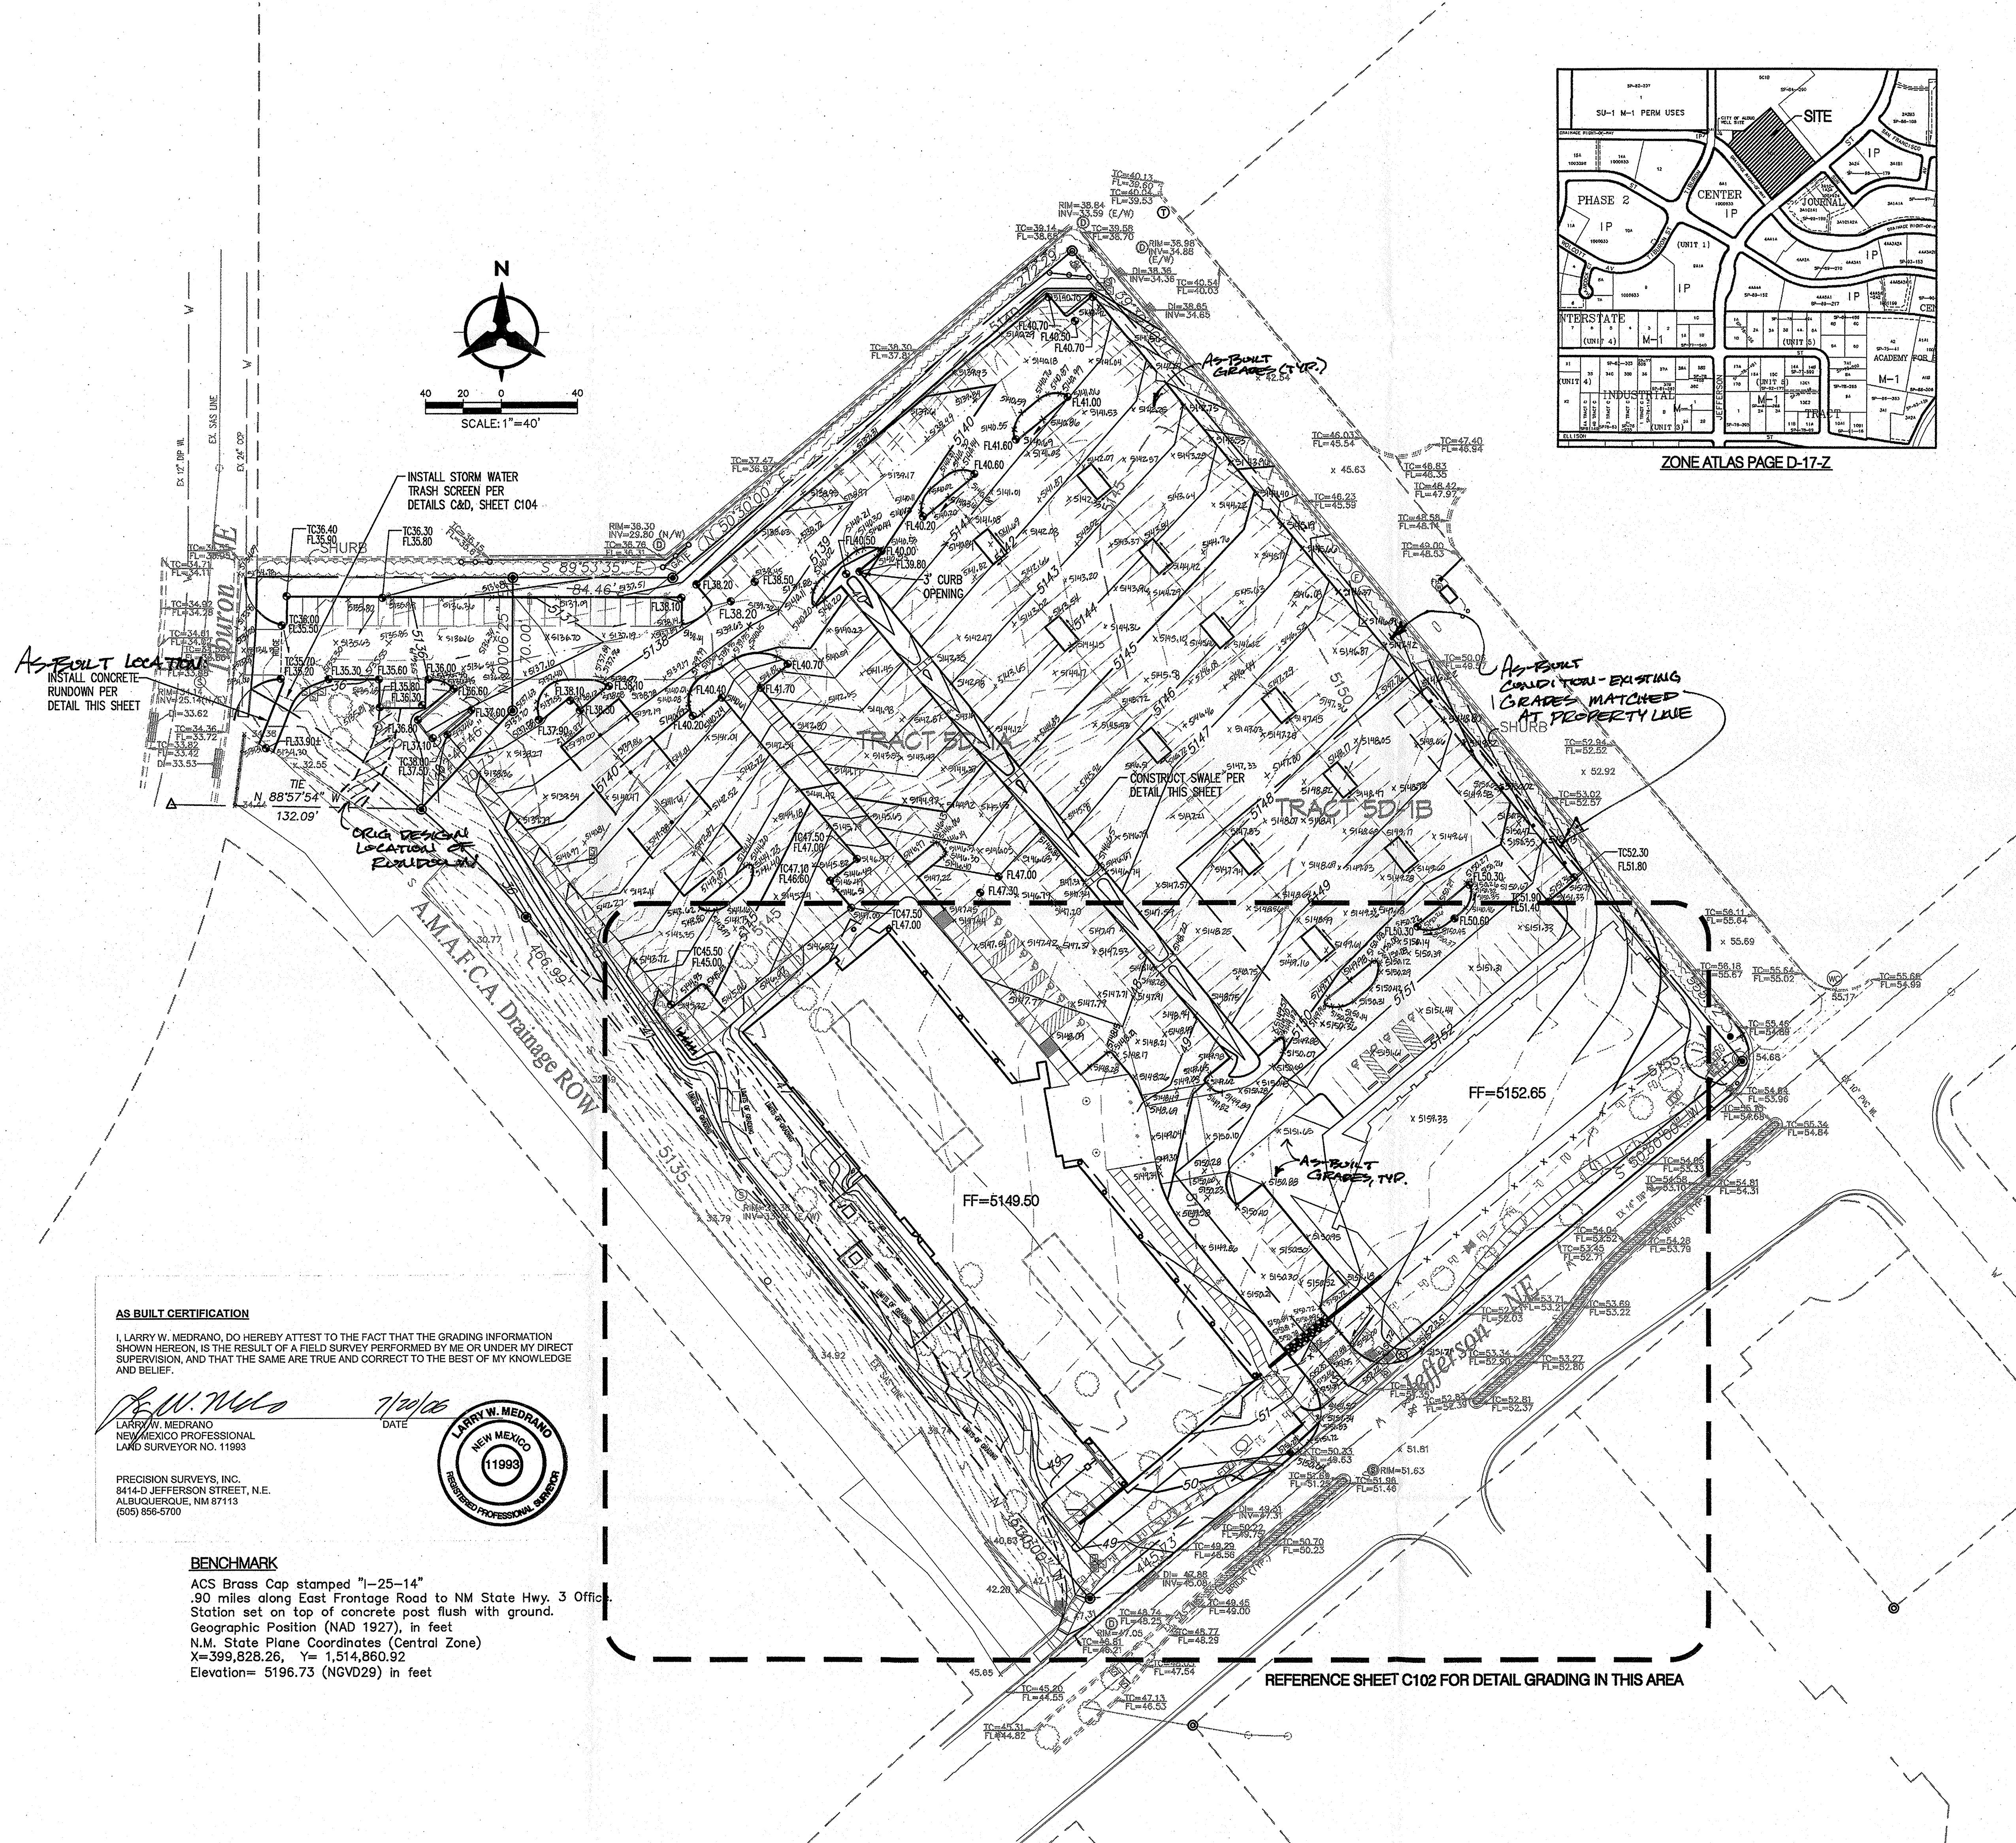

AS BUILT CERTIFICATION



I, LARRY W. MEDRANO, DO HEREBY ATTEST TO THE FACT THAT THE GRADING INFORMATION SHOWN HEREON, IS THE RESULT OF A FIELD SURVEY PERFORMED BY ME OR UNDER MY DIRECT SUPERVISION, AND THAT THE SAME ARE TRUE AND CORRECT TO THE BEST OF MY KNOWLEDGE AND BELIEF.

LARRY W. MEDRANO
NEW MEXICO PROFESSIONAL
LAND SURVEYOR NO. 11993
PRECISION SURVEYS, INC.
6414-D JEFFERSON STREET, N.E.
ALBUQUERQUE, NM 87113
(505) 856-5700



BENCH-MARK

ACS Brass Cap stamped "I-25-14"
.90 miles along East Frontage Road to NM State Hwy. 3 Office.
Station set on top of concrete post flush with ground.
Geographic Position (NAD 1927), in feet
N.M. State Plane Coordinates (Central Zone)
X=399,828.26, Y=1,514,860.92
Elevation= 5196.73 (NGVD29) in feet

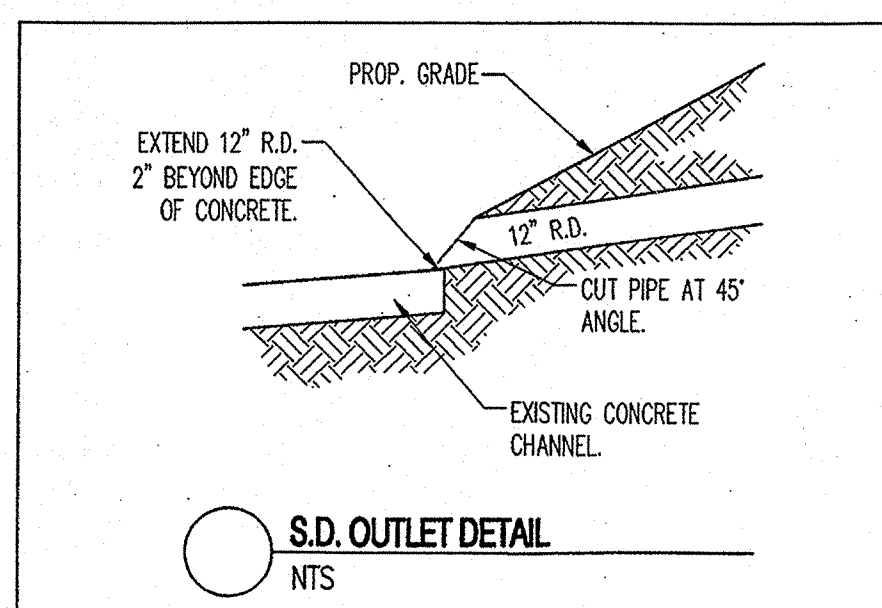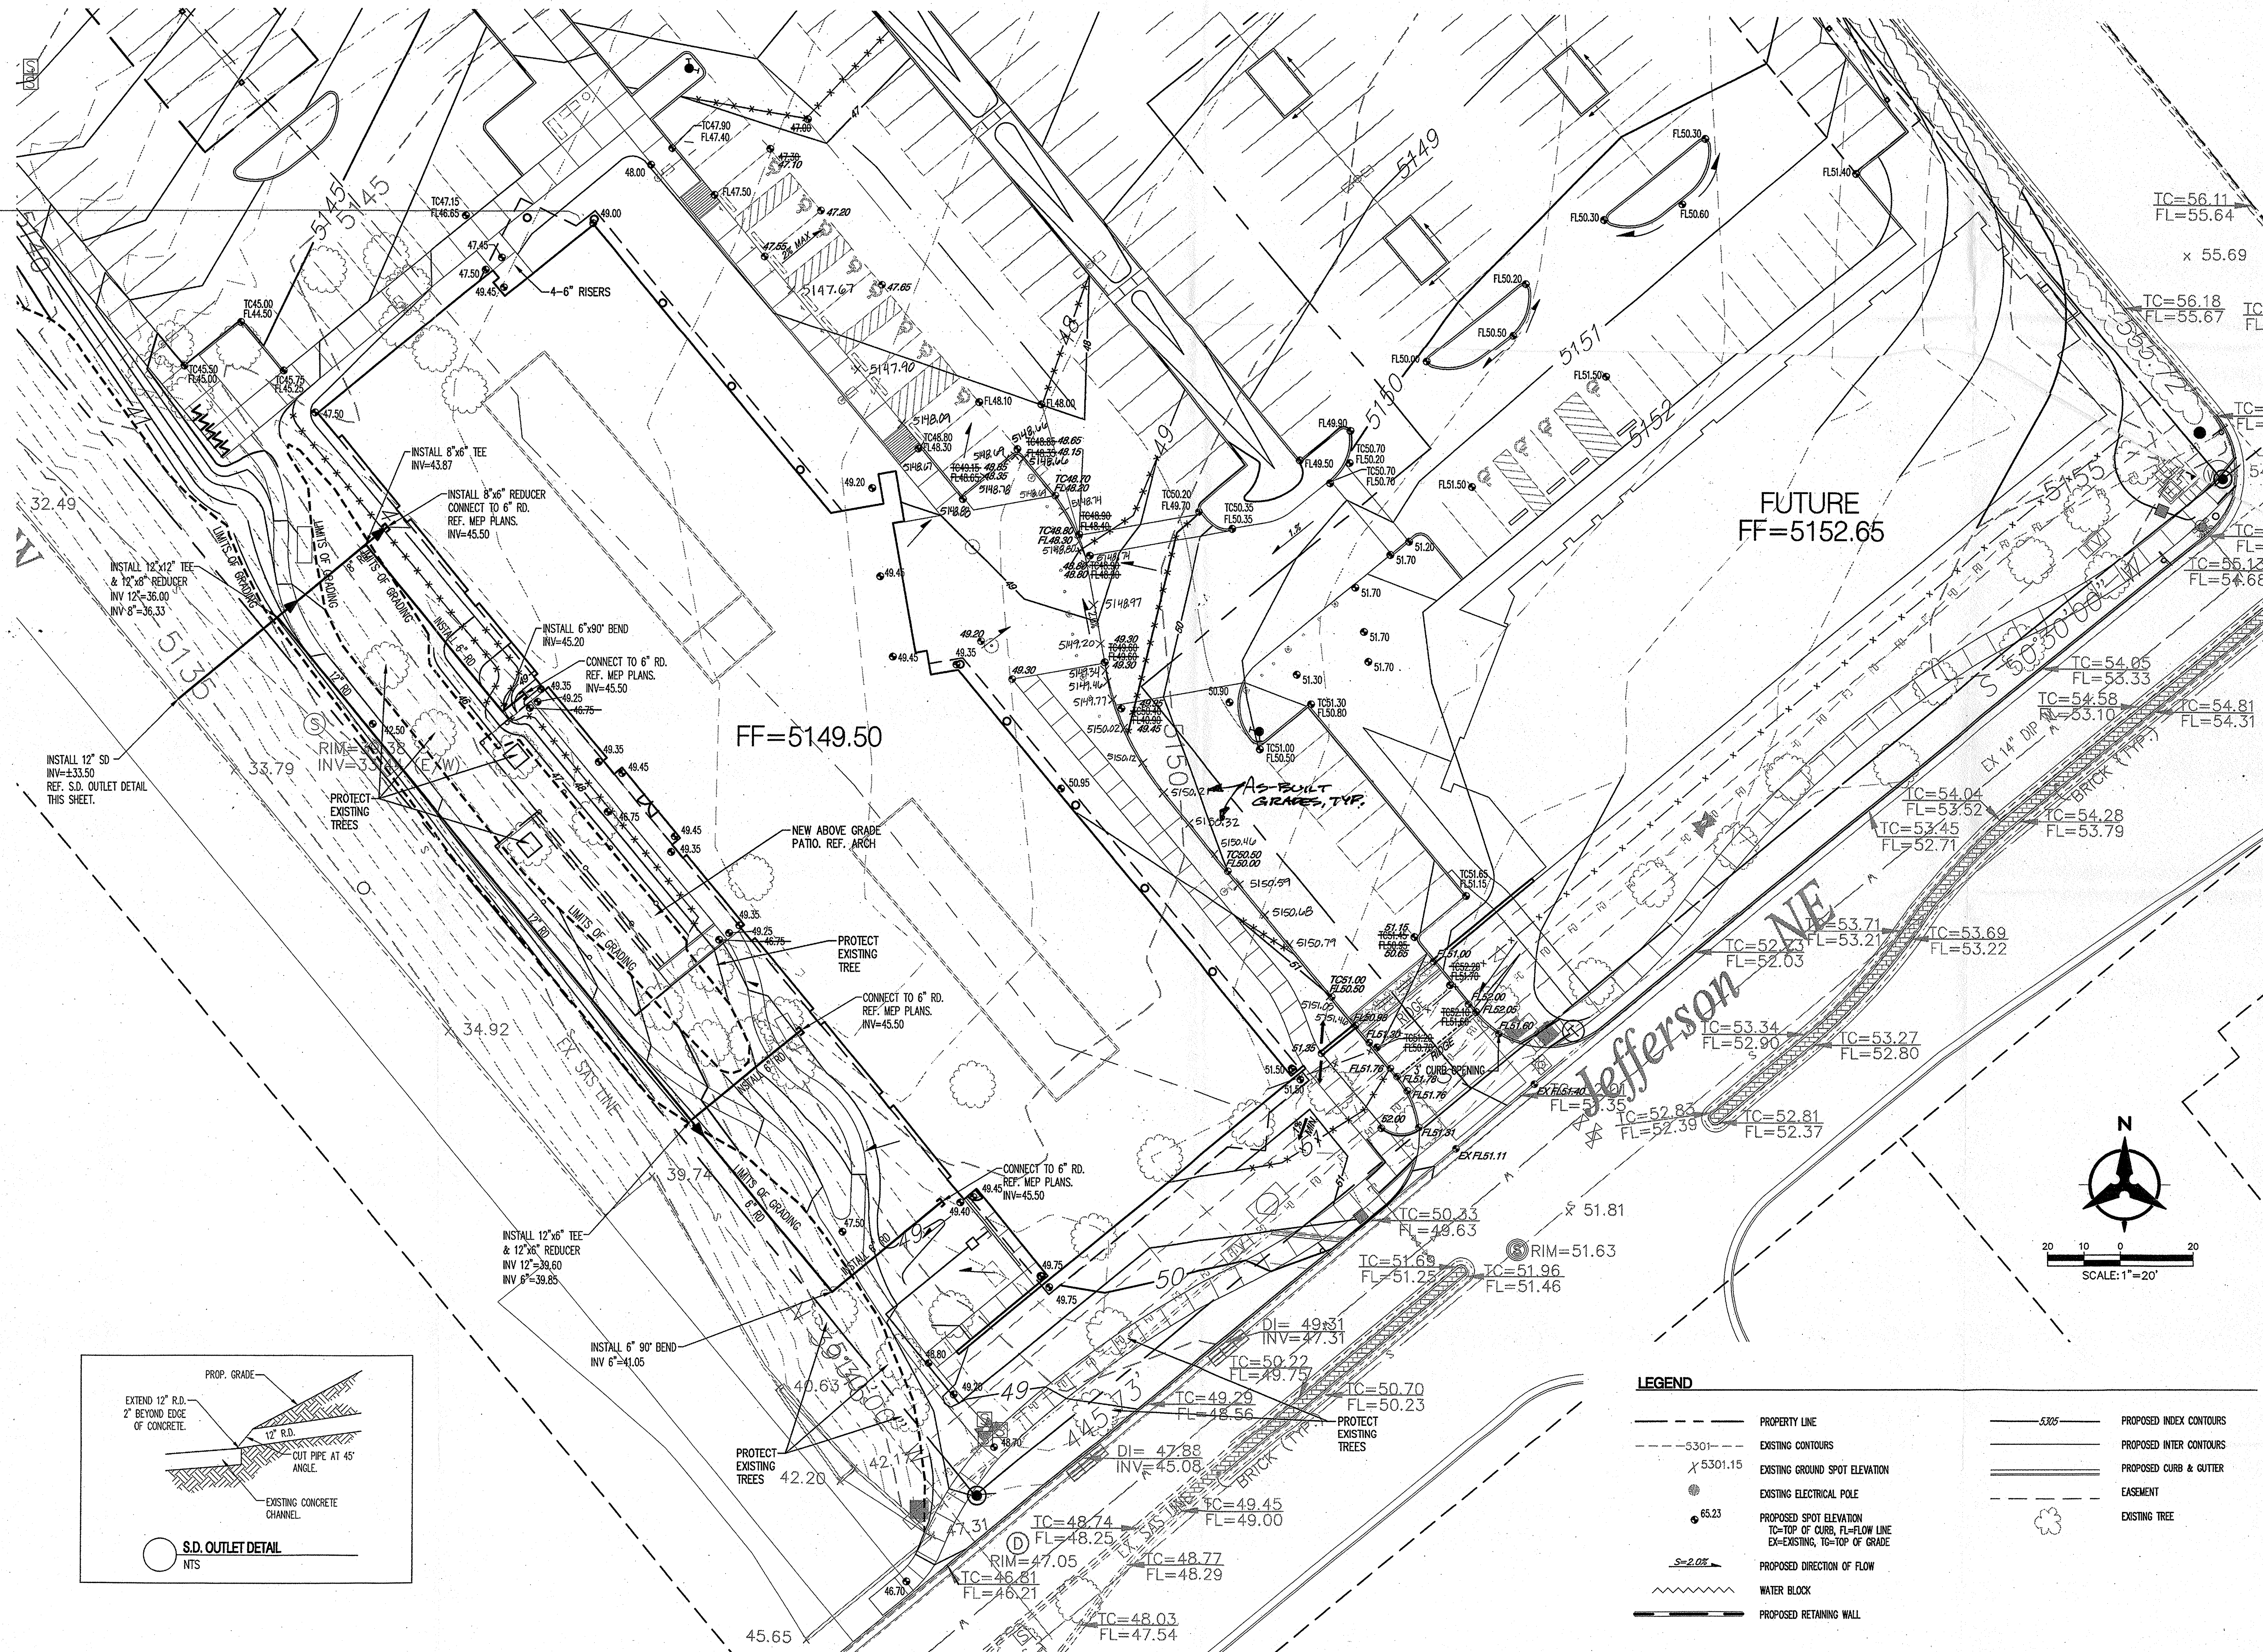

AS BUILT CERTIFICATION

I, LARRY W. MEDRANO, DO HEREBY ATTEST TO THE FACT THAT THE GRADING INFORMATION SHOWN HEREON, IS THE RESULT OF A FIELD SURVEY PERFORMED BY ME OR UNDER MY DIRECT SUPERVISION, AND THAT THE SAME ARE TRUE AND CORRECT TO THE BEST OF MY KNOWLEDGE AND BELIEF.

LARRY W. MEDRANO
NEW MEXICO PROFESSIONAL
LAND SURVEYOR NO. 11993

PRECISION SURVEYS, INC.
8414-D JEFFERSON STREET, N.E.
ALBUQUERQUE, NM 87113
(505) 859-5700

DRAINAGE CERTIFICATION


I, BRUCE STODWORTH, NMPE 14823, OF THE FIRM BOHANNAN HUSTON INC., HEREBY CERTIFY THAT THIS PROJECT HAS BEEN GRADED AND WILL DRAIN IN SUBSTANTIAL COMPLIANCE WITH AND IN ACCORDANCE WITH THE DESIGN INTENT OF THE APPROVED PLAN. THE ENGINEER'S STAMP DATED 9/2/05, THE RECORD INFORMATION EDITED ONTO THE ORIGINAL DESIGN DOCUMENT HAS BEEN OBTAINED BY LARRY MEDRANO, NMPS 11993, OF THE FIRM PRECISION SURVEYS. I FURTHER CERTIFY THAT I HAVE PERSONALLY VISITED THE PROJECT SITE ON 7/17/05 AND HAVE DETERMINED BY VISUAL INSPECTION THAT THE SURVEY DATA PROVIDED IS REPRESENTATIVE OF ACTUAL SITE CONDITIONS AND IS TRUE AND CORRECT TO THE BEST OF MY KNOWLEDGE AND BELIEF. THIS CERTIFICATION IS SUBMITTED IN SUPPORT OF A REQUEST FOR PERMANENT C.O.


THE RECORD INFORMATION PRESENTED HEREON IS NOT NECESSARILY COMPLETE AND INTENDED ONLY TO VERIFY SUBSTANTIAL COMPLIANCE OF THE GRADING AND DRAINAGE ASPECTS OF THIS PROJECT. THOSE RELYING ON THIS RECORD DOCUMENT ARE ADVISED TO OBTAIN INDEPENDENT VERIFICATION OF ITS ACCURACY BEFORE USING IT FOR ANY OTHER PURPOSE.

BRUCE STODWORTH
NEW MEXICO
14823
REGISTERED PROFESSIONAL ENGINEER
8/1/06


LEGEND

- | | | | |
|-----|--------------------------------|-----|-------------------------|
| --- | PROPERTY LINE | --- | PROPOSED INDEX CONTOURS |
| --- | EXISTING CONTOURS | --- | PROPOSED INTER CONTOURS |
| • | EXISTING GROUND SPOT ELEVATION | --- | PROPOSED CURB & GUTTER |
| • | EXISTING ELECTRICAL POLE | --- | EASEMENT |
| • | PROPOSED SPOT ELEVATION | --- | EXISTING TREE |
| --- | TO-TOP OF CURB, FL=FLOW LINE | | |
| --- | EX=EXISTING, TO-TOP OF GRADE | | |
| --- | PROPOSED DIRECTION OF FLOW | | |
| --- | WATER BLOCK | | |
| --- | PROPOSED RETAINING WALL | | |

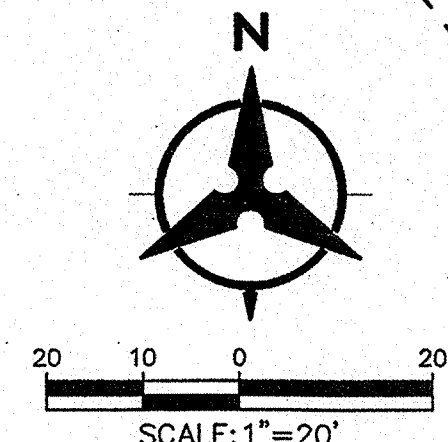

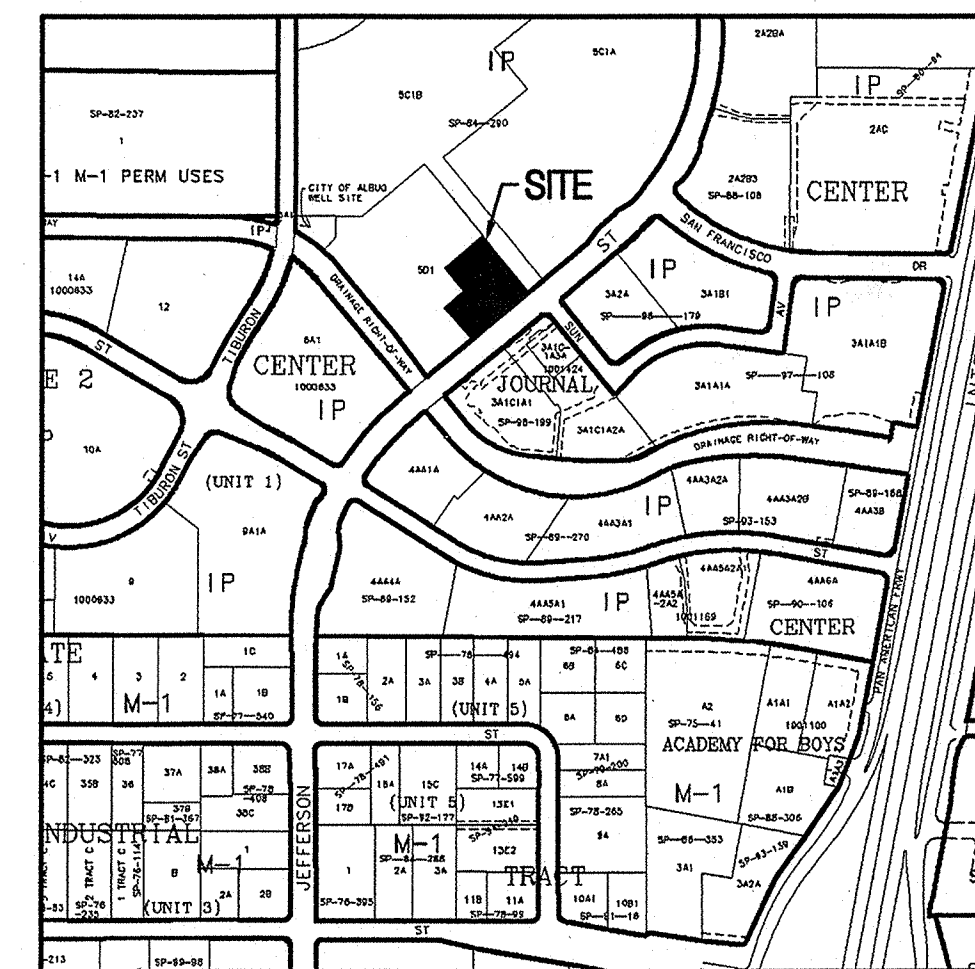

ZONE ATLAS PAGE D-17-Z

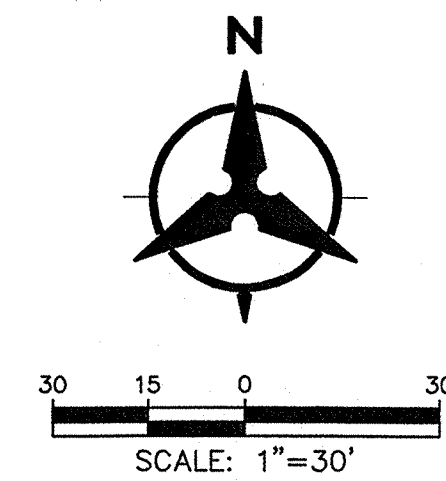

BENCHMARK

ACS Brass Cap stamped "I-25-14"
90 miles along East Frontage Road to NM State Hwy. 3 Office.
Station set on top of concrete post flush with ground.
Geographic Position (NAD 1927), in feet
N.M. State Plane Coordinates (Central Zone)
X=399,828.28, Y= 1,514,880.92
Elevation= 5196.73 (NGVD29) in feet

GRADING NOTES

- EXCEPT AS PROVIDED HEREIN, GRADING SHALL BE PERFORMED AT THE ELEVATIONS AND IN ACCORDANCE WITH THE DETAILS SHOWN ON THIS PLAN.
- THE COST FOR REQUIRED CONSTRUCTION DUST AND EROSION CONTROL MEASURES SHALL BE INCIDENTAL TO THE PROJECT COST.
- ALL WORK RELATIVE TO FOUNDATION CONSTRUCTION, SITE PREPARATION, AND PAVEMENT INSTALLATION, AS SHOWN ON THIS PLAN, SHALL BE CONSTRUCTED IN ACCORDANCE WITH THE "GEOTECHNICAL INVESTIGATION," AS PROVIDED BY THE ARCHITECT OR OWNER. ALL OTHER WORK SHALL, UNLESS OTHERWISE STATED OR PROVIDED FOR HEREON, BE CONSTRUCTED IN ACCORDANCE WITH THE PROJECT (FIRST PRIORITY) SPECIFICATIONS, AND/OR THE CITY OF ALBUQUERQUE (COA) STANDARD SPECIFICATIONS FOR PUBLIC WORKS (SECOND PRIORITY).
- EARTH SLOPES SHALL NOT EXCEED 3 HORIZONTAL TO 1 VERTICAL UNLESS SHOWN OTHERWISE.
- IT IS THE INTENT OF THESE PLANS THAT THIS CONTRACTOR SHALL NOT PERFORM ANY WORK OUTSIDE OF THE PROPERTY BOUNDARIES EXCEPT AS REQUIRED BY THIS PLAN.
- THE CONTRACTOR IS TO ENSURE THAT NO SOIL ERODES FROM THE SITE ONTO ADJACENT PROPERTY OR PUBLIC RIGHT-OF-WAY. THIS SHOULD BE ACHIEVED BY CONSTRUCTING TEMPORARY BERM OR SLT FENCE AT THE PROPERTY LINES AND NETTING THE SOIL TO PROTECT IT FROM WIND EROSION.
- A DISPOSAL SITE FOR ANY & ALL EXCESS EXCAVATION MATERIAL, AND UNSUITABLE MATERIAL AND/OR A BORROW SITE CONTAINING ACCEPTABLE FILL MATERIAL SHALL BE OBTAINED BY THE CONTRACTOR IN COMPLIANCE WITH APPLICABLE ENVIRONMENTAL REGULATIONS AND APPROVED BY THE OBSERVER. ALL COSTS INCURRED IN OBTAINING A DISPOSAL OR BORROW SITE AND Haul TO OR FROM SHALL BE CONSIDERED INCIDENTAL TO THE PROJECT AND NO SEPARATE MEASUREMENT OR PAYMENT SHALL BE MADE.
- PAVING AND ROADWAY GRADES SHALL BE +/- 0.1' FROM PLAN ELEVATIONS. PAD ELEVATION SHALL BE +/- 0.05' FROM BUILDING PLAN ELEVATION.
- ALL PROPOSED CONTOURS REFLECT TOP OF PAVEMENT ELEVATIONS IN THE PARKING AREA AND MUST BE ADJUSTED FOR MEDIAN AND ISLANDS.
- VERIFY ALL ELEVATIONS SHOWN ON PLAN FROM BASIS OF ELEVATION CONTROL STATION PRIOR TO BEGINNING CONSTRUCTION.


DRAINAGE MANAGEMENT PLAN

- INTRODUCTION**
The purpose of this submittal is to present a grading and drainage plan for the proposed Office Building B (Phase 2) in Journal Center (Tract 5D-1). The site is bound to the southeast by Jefferson and to the southwest by the North Pino Arroyo Concrete Channel. The overall project contains two multi story office buildings along with parking and landscaped areas. This submittal is in support of building permit approval.
- SITE LOCATION**
The site is located within zone atlas map # D-17-Z. In reference to the Federal Emergency Management Agency map #3500100157, there is a 1% annual chance flood zone adjacent to the site. This flood elevation is contained in the AMAFCA North Pino Arroyo Concrete Channel along the southern border of the site.
- EXISTING HYDROLOGIC CONDITIONS**
The site encompasses approximately 6.04 acres. The site is undeveloped and existing slopes range between 1 to 3% to the west. Currently, the majority of the site drains via surface flow into the adjacent channel (North Pino Arroyo) and partially into Tiburon Ave.
- Under existing conditions, this site has a 100yr discharge of 17,06cfs. The associated land treatments for the existing conditions are 20% land treatment A and 80% land treatment C. The analysis of the existing hydrology was performed in accordance with the methodology outlined in section 22.2 of the Development Process Manual.
- PROPOSED HYDROLOGIC CONDITIONS**
The proposed project includes construction of one multi story office building, combined with parking and landscaped areas. According to the approved drainage report for Journal Center, this site has free discharge into the North Pino Arroyo. Most of the site drains into the North Pino Arroyo via a concrete channel. There is a small portion of Building B and landscaped area that will drain via surface flow to Jefferson. This insignificant amount of drainage (2.15 cfs) will not have an adverse effect on the downstream system within Jefferson.
- The total 100 year peak discharge entering the North Pino Arroyo from this site is 26.74cfs. The associated land treatments for Basin 1 are 15% land treatment C and 85% land treatment D. The flow from Basin 2 that will discharge to Jefferson is 2.15 cfs. The analysis of the proposed hydrology was performed in accordance with the methodology outlined in section 22.2 of the Development Process Manual. See Basin Calculations table for associated computations.
- CONCLUSION**
The drainage management plan is capable of safely passing the 100 year storm and meets city requirements. With this submittal we are seeking building permit approval.

JOURNAL CENTER OFFICE BUILDING BASIN CALCULATIONS								
Development Conditions Basin Data Table								
This table is based on the DPM Section 22.2, Zone 12								
BASIN ID	Area (SQ. FT.)	Area (AC.)	Land Treatment Percentages				Q(100) (cfs/sec.)	Q(100) (cfs)
			A	B	C	D		
Existing								
Basin 1	283147	6.04	20.0%	0.0%	80.0%	0.0%	2.82	17.06
								1.01
								22148
								22148
Proposed								
Basin 1	241799	5.56	0.0%	0.0%	16.0%	85.0%	4.47	24.79
Basin 2	21989	0.49	0.0%	0.0%	20.0%	80.0%	4.39	2.15
								1.92
								3423
								5702
TOTAL	283188	6.04	-	-	-	-	4.46	26.84
								3.89
								43148.16
								72831.41

LEGEND

- | | | |
|---|-----------|-----------------------------|
| --- PROPERTY LINE | --- 5.30% | --- PROPOSED INDEX CONTOURS |
| --- 5.301-15 | --- | --- PROPOSED INTER CONTOURS |
| --- EXISTING CONTOURS | --- | --- PROPOSED CURB & GUTTER |
| --- EXISTING GROUND SPOT ELEVATION | --- | --- EASEMENT |
| --- EXISTING ELECTRICAL POLE | --- | --- EXISTING TREE |
| --- 65.23 | --- | |
| --- PROPOSED SPOT ELEVATION TO TOP OF CURB, FL=FLOW LINE EX=EXISTING, TO=TOP OF GRADE | --- | |
| --- S=2.0% | --- | |
| --- PROPOSED DIRECTION OF FLOW | --- | |
| --- WATER BLOCK | --- | |
| --- PROPOSED RETAINING WALL | --- | |

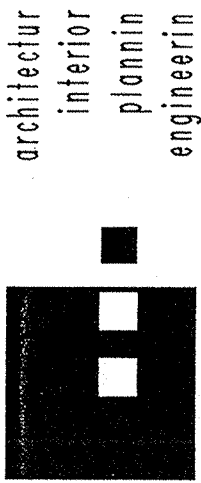

architecture
interior
planning
engineering

**Dekker
Perich
Sabatini**

6801 Jefferson NE
Suite 100
Albuquerque, NM 87105
505 761-9700
fax 761-4222
dps@4psabq.com

ARCHITECT

**ADMINISTRATIVE
AMENDMENT**

ENGINEER



PROJECT

Journal Center Tract 5
7601 Jefferson NE
Albuquerque, New Mexico

GENERAL NOTES

- PARKING AREA SHALL BE DESIGNED & BUILT TO CURRENT DPM STANDARDS
- PHASE I TO INCLUDE FULL BUILD-OUT OF OFFICE BUILDING A, ALL PARKING BUILDING B AS A FUTURE PHASE I, PHASE II TO INCLUDE FULL BUILD-OUT OF OFFICE BUILDING C, SEE SHEET 100 FOR LANDSCAPING OF PHASE I AND II
- PROVIDE LETTERING "COMPACT" PAINTED IN SAFETY WHITE AT ALL COMPACT PARKING SPACES, TYPICAL
- ALL SITEWORK WILL BE CONSTRUCTED AS SUCH TO ENSURE THAT A SITE DISTANCE OF 400' IS MET ON JEFFERSON.

KEYED NOTES

- SIDEWALK, CONCRETE
- PAVING, ASPHALT
- SPECIAL PAVING
- PAVING, ASPHALT (100' AUTOS)
- CURB, 6" HIGH, CONCRETE
- TRANSFORMER
- SCREEN WALL, 74" HIGH, 2-COAT STUCCO SYSTEM OVER 8" CMU
- COLOR TO MATCH BUILDING, RE. A/A091
- LANDSCAPE AREA, RE. L001
- HC RAMP
- CONCRETE CURB TO COORDINATE REMOVAL AND RELOCATION OF IRRIGATION EXPOSURE WITH LEGCO
- CONCRETE CURB TO BE REMOVED
- MONUMENT SIGN
- PARKING CANOPY
- CITY WELL SITE EASEMENT TO BE VACATED BY PLAT
- PROPOSED LOT LINE
- PROPOSED LOT LINE
- TRANSFERRING PUBLIC SIDEWALK EASEMENT
- 14' SIDEWALK TO MIDPOINT OF BRIDGE OVER ANAFCA R.O.W.
- ROLLED AND COMPACTED CRUSHER FINE FATH CONCRETE CURB AT TURF EDGE

SITE INFORMATION

LEGAL DESCRIPTION:
TRACT 5D-1, JOURNAL CENTER, AS THE SAME IS SHOWN ON THE REPLAT OF JOURNAL CENTER AND A PORTION OF LOT 30.31, A/D 82 BLOCK 3 OF TRACT A, UNIT A, NORTH 1/4 SECTION 34, T12N, R12E, S44E, OF THE RANCHITOS AVENUE, FILED LINE 30, 1983, MAP BOOK C21, FOLLO 124, RECORDS OF BERNALLO COUNTY, NEW MEXICO.

SITE DATA (OVERALL)

ZONE 1F INDUSTRIAL PARK
GROSS BUILDING AREA:
BUILDING A (three story) = 84,631 GSA
BUILDING B (two story) = 22,454 GSA
TOTAL BUILDINGS = 107,085 GSA
RENTABLE BUILDING AREA:
BUILDING A (three story) = 81,838 FRA
BUILDING B (two story) = 20,221 FRA
TOTAL BUILDINGS = 102,059 FRA
SITE AREA: 262,957 GSF = 6.0366 ACRES
TOTAL SITE AREA: 262,957 GSF
GROSS F.A.R. (GSA/site area): .37
RENTABLE F.A.R. (FRA/site area): .36

SITE DATA (TRACT 5D-1A)

GROSS BUILDING AREA:
BUILDING A (three story) = 84,631 GSA
RENTABLE BUILDING AREA:
BUILDING A (three story) = 81,838 FRA
SITE AREA: 200,661 GSF
GROSS F.A.R. (GSA/site area): .41
RENTABLE F.A.R. (FRA/site area): .40
PARKING PROVIDED: 339 SPACES
RATIO = (281 STANDARD + 101 COMPACT SPACES) 4.14/1000 FRA

SITE DATA (TRACT 5D-1B)

GROSS BUILDING AREA:
BUILDING B (two story) = 22,454 GSA
RENTABLE BUILDING AREA:
BUILDING B (two story) = 20,221 FRA
TOTAL SITE AREA = 62,327 GSF
GROSS F.A.R. (GSA/site area): .360
RENTABLE F.A.R. (FRA/site area): .325
PARKING PROVIDED: 84 SPACES
RATIO = (75 STANDARD + 16 COMPACT SPACES) 4.4/1000 FRA

PARKING INFORMATION

OFFICES NET RENTABLE SF/200 (SF/FL)
AND 300 (2ND + 3RD FLS)

BUILDING A:
FIRST FLOOR: 24,048 SF/200 = 120
SECOND FLOOR: 20,239 SF/200 = 95
THIRD FLOOR: 21,952 SF/300 = 95
TOTAL = 314

BUILDING B:
FIRST FLOOR: 8,621 SF/200 = 44
SECOND FLOOR: 11,669 SF/200 = 58
TOTAL = 102


TOTAL SPACES REQUIRED: 391
(INCLUDES 12 ACCESSIBLE SPACES WITH 4 VAN ACCESSIBLE)

TOTAL SPACES PROVIDED: 466
(INCLUDES 12 ACCESSIBLE SPACES WITH 4 VAN ACCESSIBLE)

COMPACT SPACES: 123
BICYCLE REQUIREMENTS: 947/20 = 20
BICYCLE SPACES PROVIDED = 20

LEGEND


- EXISTING FIRE HYDRANT
- NEW FIRE HYDRANT
- PARKING SPACE COINT
- LIGHT POLE - DOUBLE HEAD
- LIGHT POLE - SINGLE HEAD
- SURFACE MOUNTED LIGHT FIXTURE
- FLOOD LIGHT
- UP LIGHT, RE
- TRAFFIC ARROW
- PAINT WHITE
- PAINT CURB
- RED, 4" PAINT
- TEXT, PREC. LINE
- NO PARKING

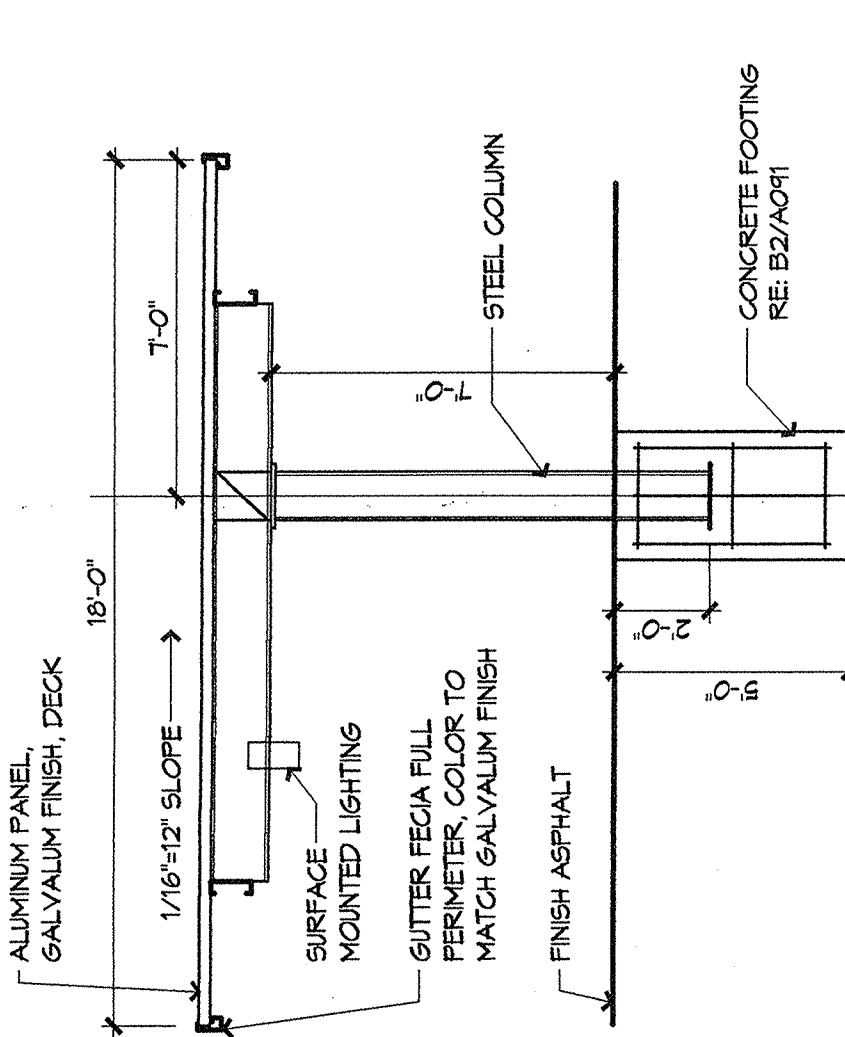

A4 PARKING CANOPY


1/4" = 1'-0"

- HORIZONTAL MOUNTED LENS SHALL NOT PROJECT BEYOND LIGHT SHIELD. LUMINANCE SHALL NOT BE GREATER THAN 1000 FOOT-LAMBERTS. MAX. HEIGHT FOR POLE AND BASE = 24' ABOVE GRADE.

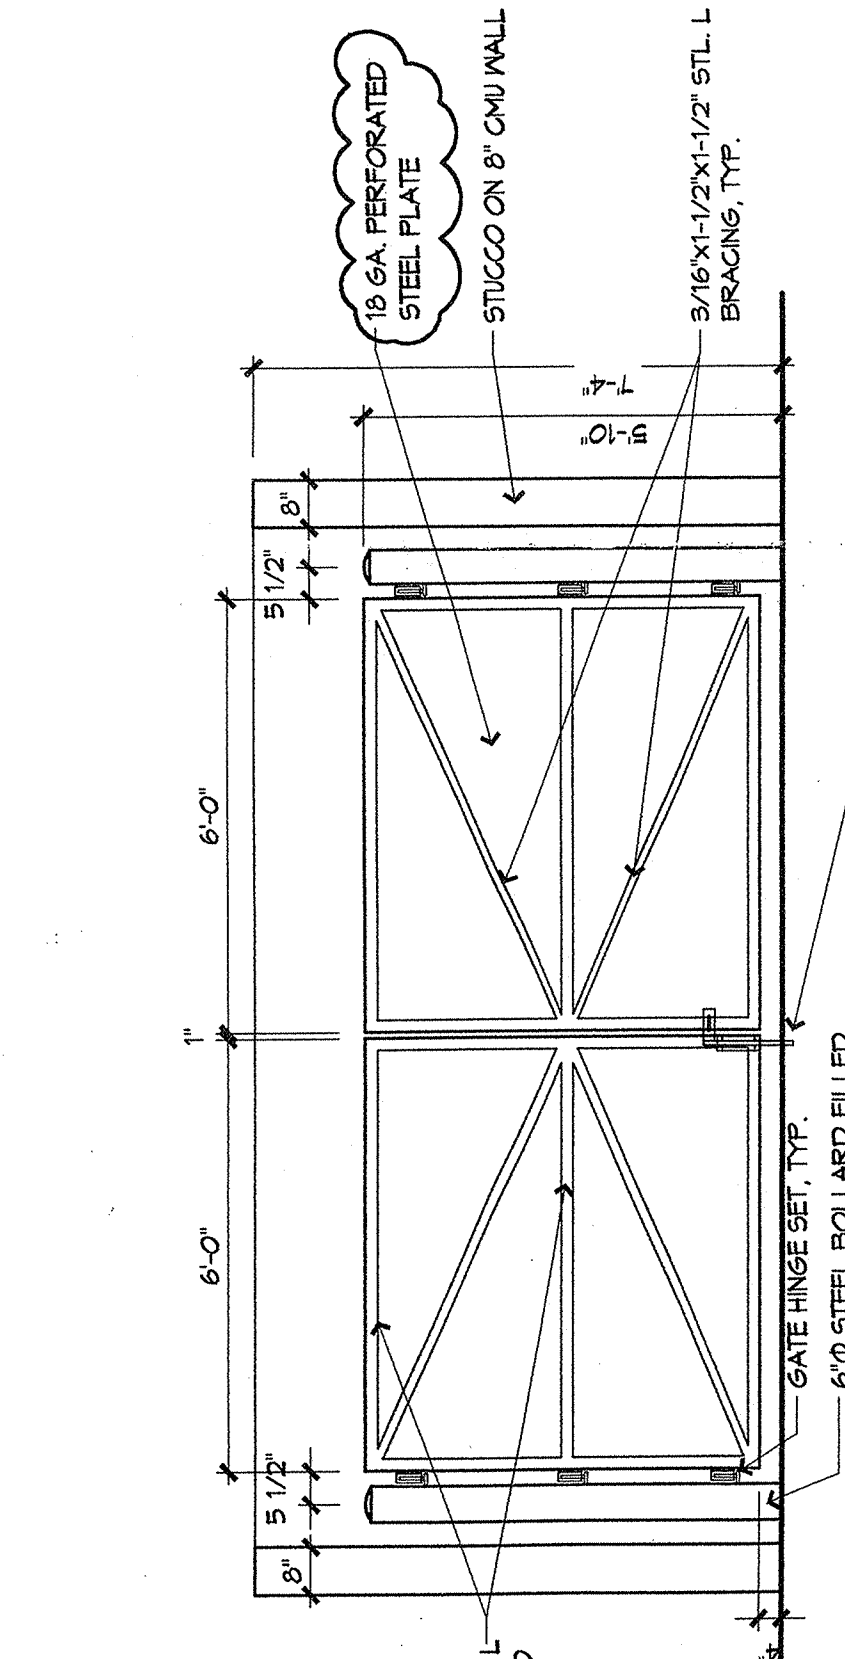


COMPACT ENCLOSURE ELEVATION

3/8" = 1'-0"

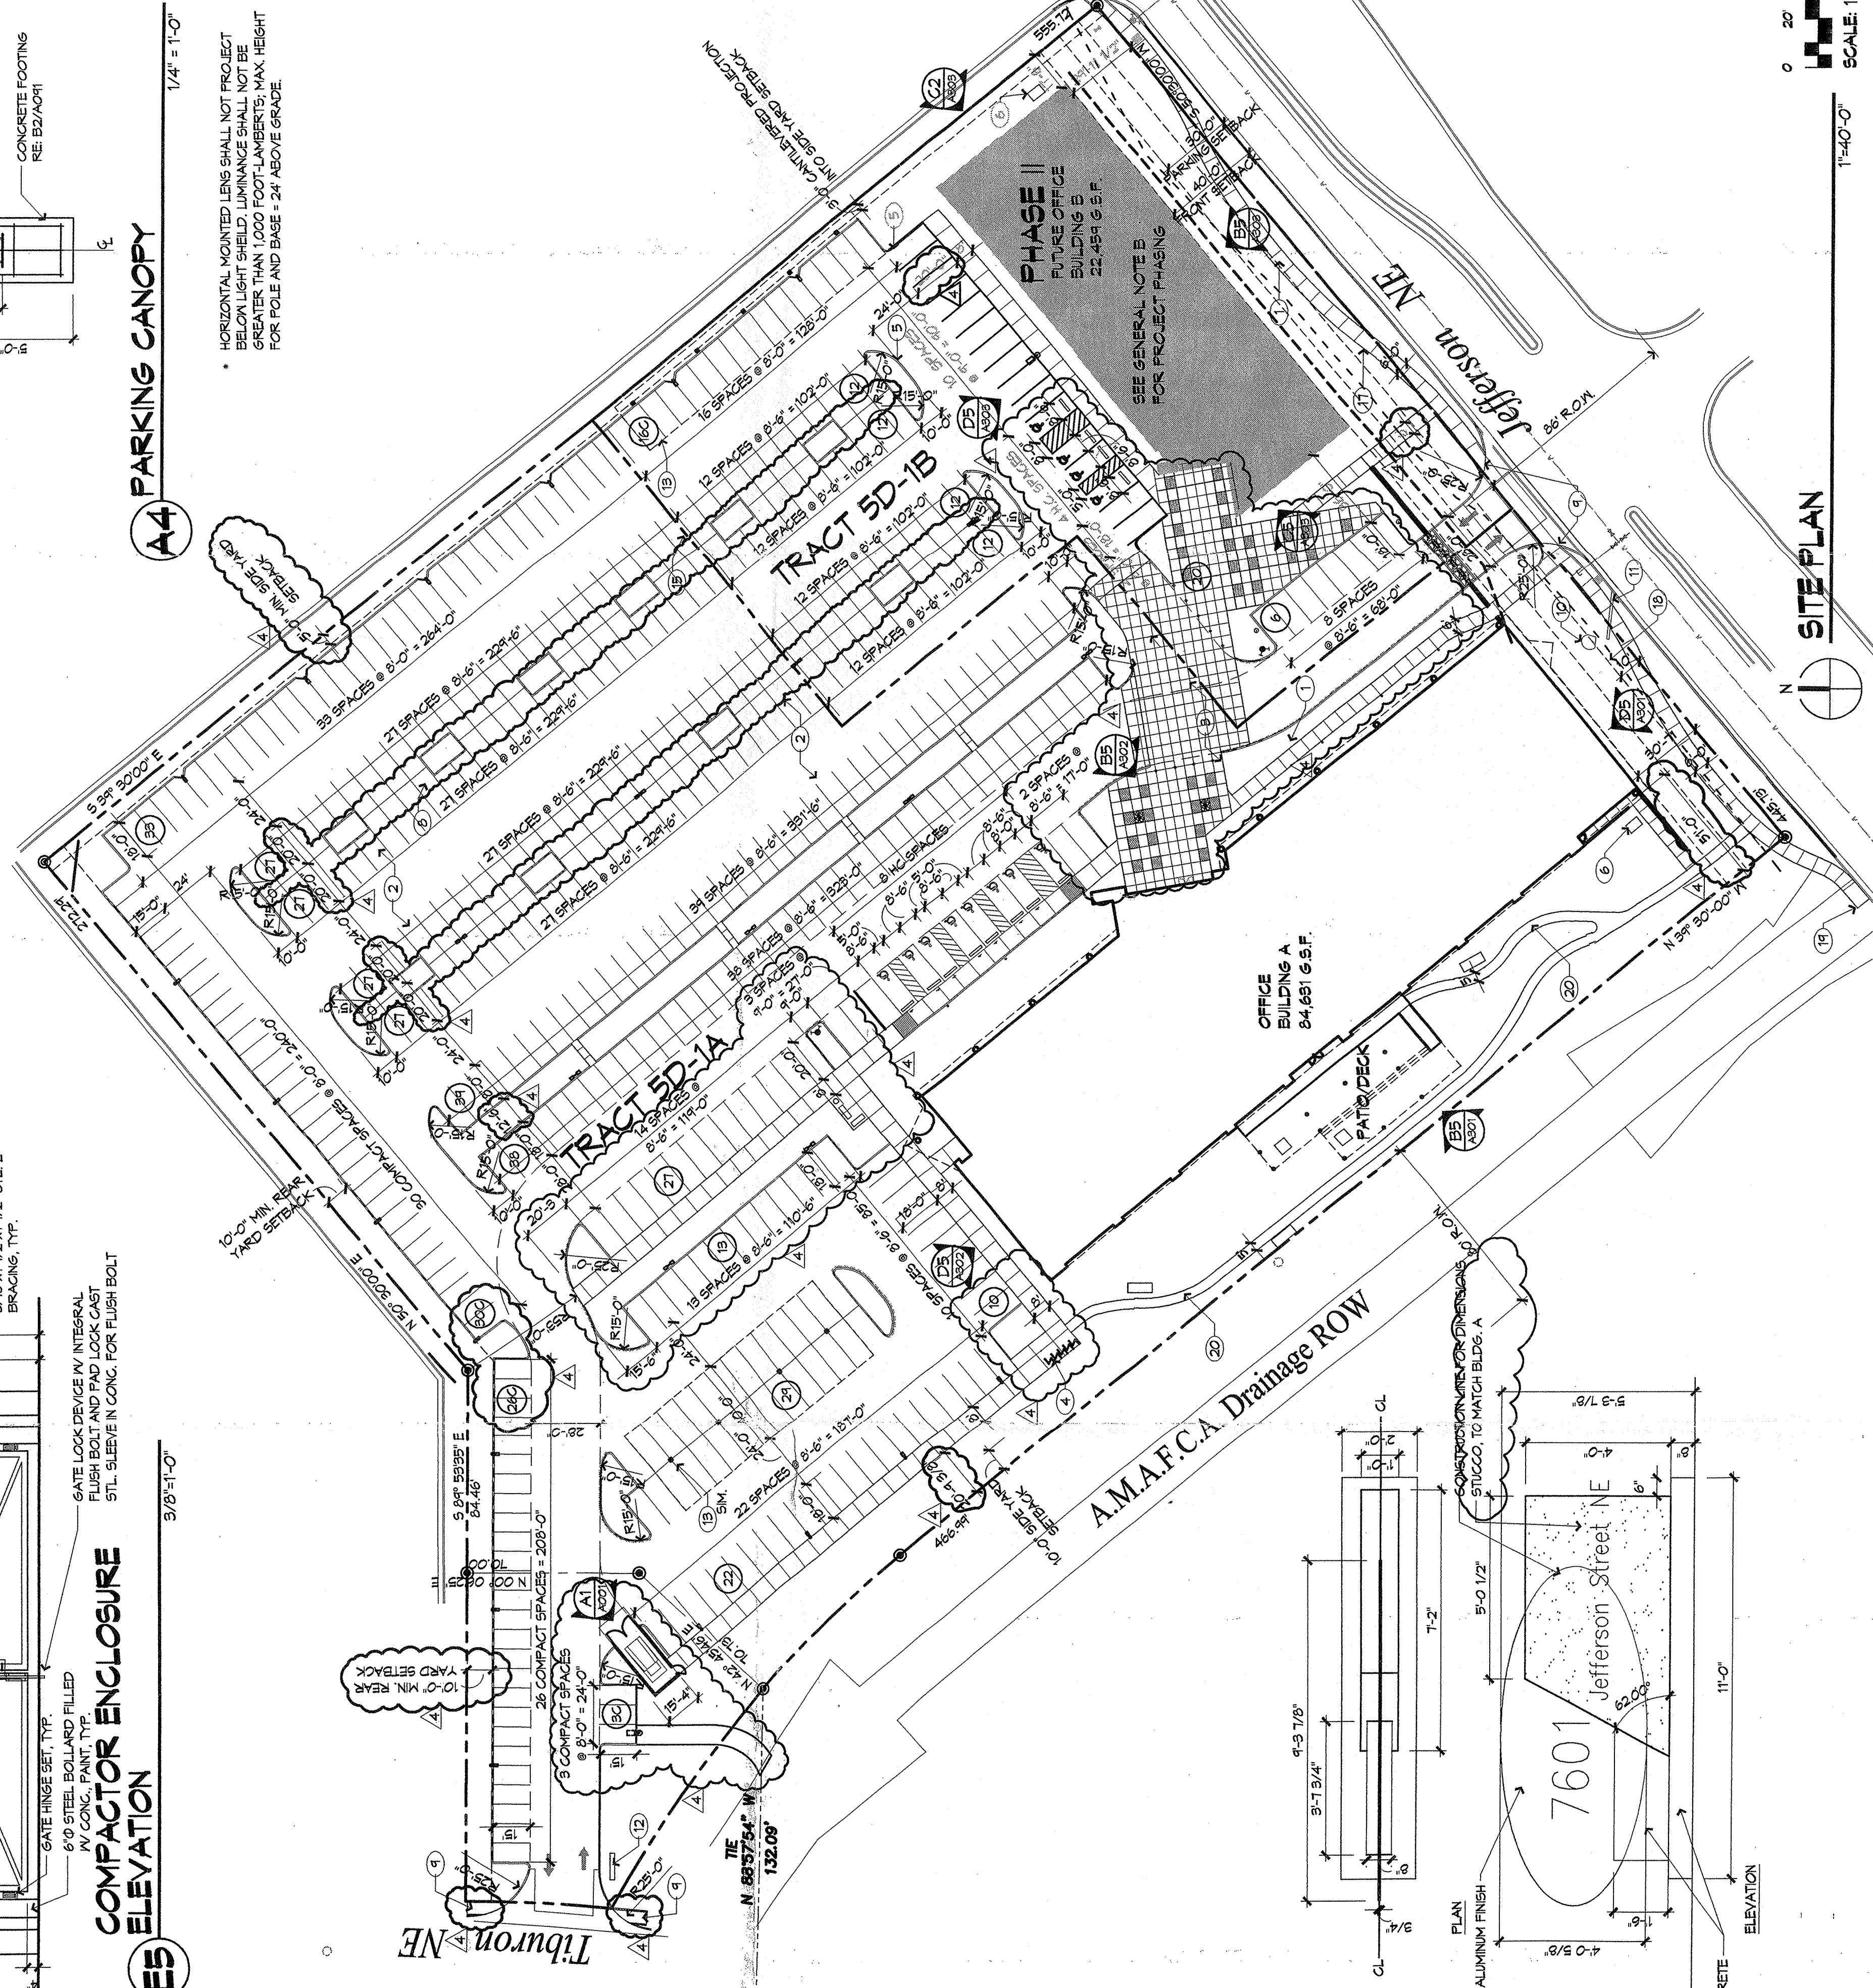

SITE PLAN

1" = 40'-0"

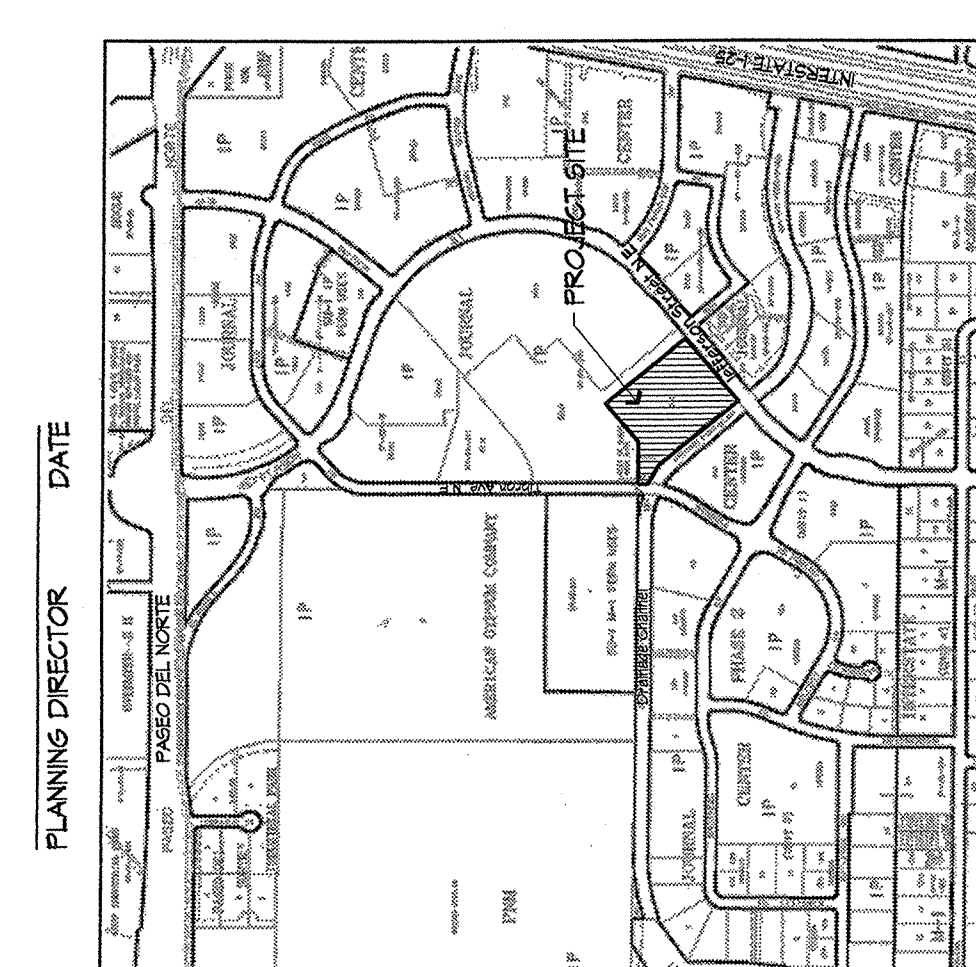

ZONE ATLAS MAP

D-17

0 250 500 1000'

SCALE: 1" = 1000'-0"

REVISIONS

4/19/05 REVISED TRACT LINES

5/06/05 DRG COMMENTS

05/11/05 ADDED SPECIALS @ ANAFCA BRIDGE

09/20/05 SITE PLAN REVISIONS

DRAWN BY

MRM/SJT

REVIEWED BY

CS

DATE

4/20/05

PROJECT NO.

04156

DRAWING NAME

SITE PLAN

FOR BLDG PERMIT

1:0000

HYDROLOGY SECTION

SHEET NO.

1:0000






1:0000

1:0000

1:0000

GENERAL NOTES

1. ALL WORK DETAILED ON THESE PLANS AND PERFORMED UNDER THIS CONTRACT SHALL BE CONSTRUCTED IN ACCORDANCE WITH THE PROJECT SPECIFICATIONS AND THE PROJECT GEOTECHNICAL REPORT, WHERE APPLICABLE, CITY OF ALBUQUERQUE PUBLIC WORKS STANDARDS SHALL APPLY.
2. THE CONTRACTOR SHALL ABIDE BY ALL LOCAL, STATE, AND FEDERAL LAWS, RULES AND REGULATIONS WHICH APPLY TO THE CONSTRUCTION OF THESE IMPROVEMENTS, INCLUDING EPA REQUIREMENTS WITH RESPECT TO STORM WATER DISCHARGE.
3. PRIOR TO CONSTRUCTION, THE CONTRACTOR SHALL FIELD VERIFY THE HORIZONTAL AND VERTICAL LOCATIONS OF ALL POTENTIAL OBSTRUCTIONS INCLUDING ALL UNDERGROUND UTILITIES. SHOULD A CONFLICT EXIST, THE CONTRACTOR SHALL NOTIFY THE CONSTRUCTION OBSERVER OR ENGINEER SO THAT THE CONFLICT CAN BE RESOLVED WITH A MINIMUM AMOUNT OF DELAY.
4. TWO (2) WORKING DAYS PRIOR TO ANY EXCAVATION, THE CONTRACTOR SHALL CONTACT LINE LOCATING SERVICE FOR LOCATION OF EXISTING UTILITIES.
5. ALL ELECTRICAL, TELEPHONE, CABLE TV, GAS AND OTHER UTILITY LINES, CABLES, AND APPURTENANCES ENCOUNTERED DURING CONSTRUCTION THAT REQUIRE RELOCATION, SHALL BE COORDINATED WITH THAT UTILITY. THE CONTRACTOR SHALL BE RESPONSIBLE FOR COORDINATION OF ALL NECESSARY UTILITY ADJUSTMENTS. NO ADDITIONAL COMPENSATION WILL BE ALLOWED FOR DELAYS OR INCONVENIENCES CAUSED BY UTILITY COMPANY WORK CREWS. THE CONTRACTOR MAY BE REQUIRED TO RESCHEDULE HIS ACTIVITIES TO ALLOW UTILITY CREWS TO PERFORM THEIR REQUIRED WORK.
6. THE CONTRACTOR IS RESPONSIBLE FOR PROTECTING ALL EXISTING UTILITY LINES WITHIN THE CONSTRUCTION AREA. ANY DAMAGE TO EXISTING FACILITIES CAUSED BY CONSTRUCTION ACTIVITY SHALL BE REPAIRED OR REPLACED AT THE CONTRACTOR'S EXPENSE AND APPROVED BY THE CONSTRUCTION OBSERVER.
7. CONSTRUCTION ACTIVITY SHALL BE LIMITED TO THE PROPERTY AND/OR PROJECT LIMITS. ANY DAMAGE TO ADJACENT PROPERTIES RESULTING FROM THE CONSTRUCTION PROCESS SHALL BE REPAIRED OR REPLACED AT THE CONTRACTOR'S EXPENSE.
8. OVERNIGHT PARKING OF CONSTRUCTION EQUIPMENT SHALL NOT OBSTRUCT DRIVEWAYS OR DESIGNATED TRAFFIC LANES. THE CONTRACTOR SHALL NOT STORE ANY EQUIPMENT OR MATERIAL WITHIN THE PUBLIC RIGHT-OF-WAY.
9. THE CONTRACTOR SHALL OBTAIN ALL THE NECESSARY PERMITS FOR THE PROJECT PRIOR TO COMMENCING CONSTRUCTION (I.E., BARRICADES, TOPSOIL DISTURBANCE, EXCAVATION PERMITS, EPA STORM WATER PERMITS, ETC.).
10. ALL PROPERTY CORNERS DESTROYED DURING CONSTRUCTION SHALL BE REPLACED AT THE CONTRACTOR'S EXPENSE. ALL PROPERTY CORNERS MUST BE RESET BY A REGISTERED LAND SURVEYOR.
11. THE CONTRACTOR SHALL PREPARE A CONSTRUCTION TRAFFIC CONTROL AND SIGNING PLAN AND OBTAIN APPROVAL OF SUCH PLAN FROM THE CITY OF ALBUQUERQUE, TRAFFIC ENGINEERING DEPARTMENT, PRIOR TO BEGINNING ANY CONSTRUCTION WORK ON OR ADJACENT TO EXISTING STREETS.
12. ALL BARRICADES AND CONSTRUCTION SIGNING SHALL CONFORM TO APPLICABLE SECTIONS OF THE "MANUAL ON UNIFORM TRAFFIC CONTROL DEVICES" (MUTCD), US DEPARTMENT OF TRANSPORTATION, LATEST EDITION.
13. THE CONTRACTOR SHALL MAINTAIN ALL CONSTRUCTION BARRICADES AND SIGNING AT ALL TIMES. THE CONTRACTOR SHALL VERIFY THE PROPER LOCATION OF ALL BARRICADES AT THE END AND BEGINNING OF EACH DAY.
14. THE CONTRACTOR SHALL TAKE ALL STEPS NECESSARY TO CONFORM WITH EPA REQUIREMENTS, INCLUDING COMPLIANCE WITH NPDES PHASE 2 REQUIREMENTS.

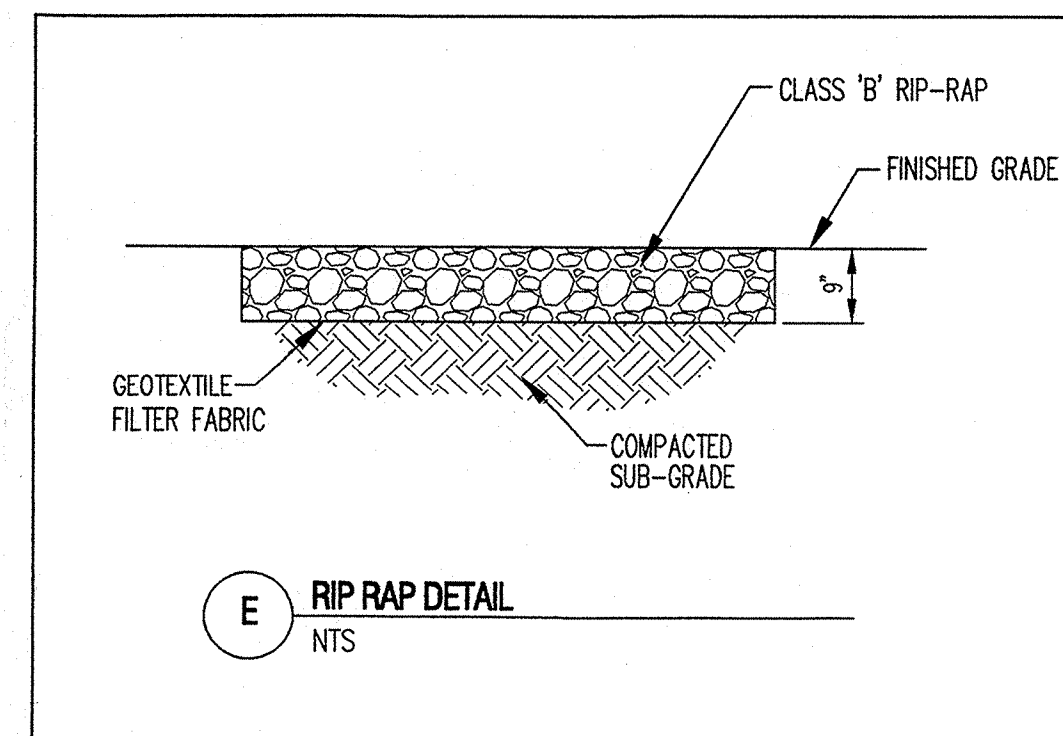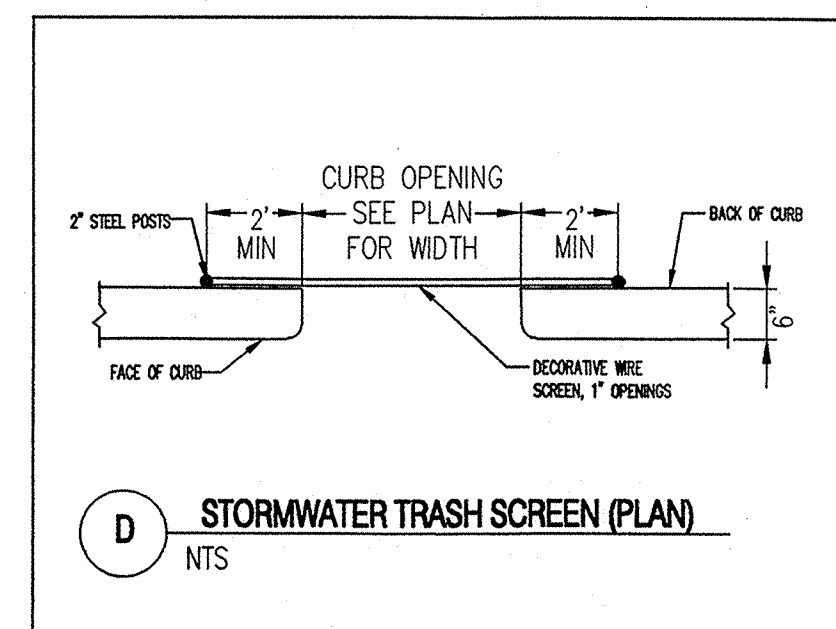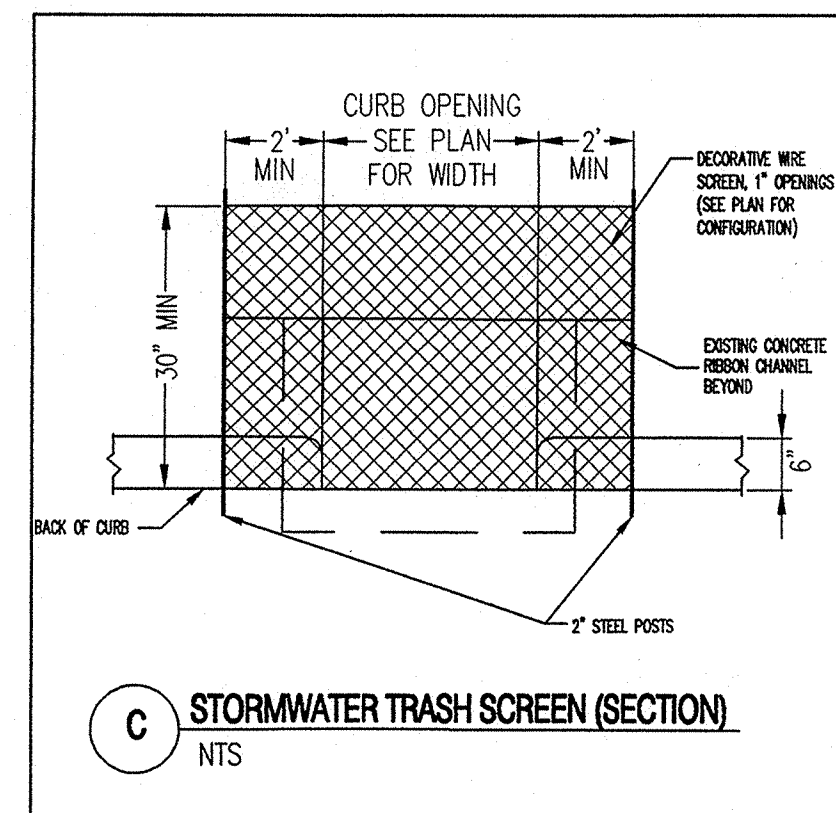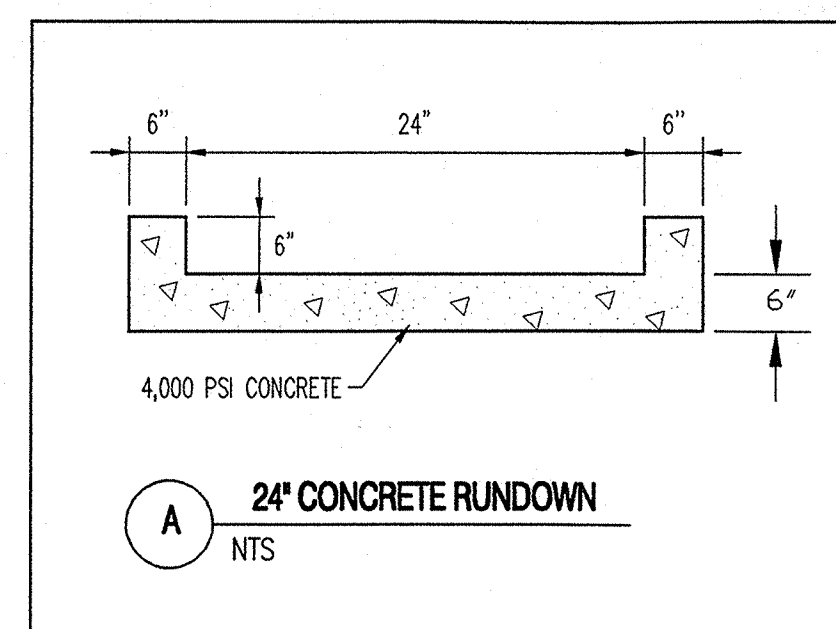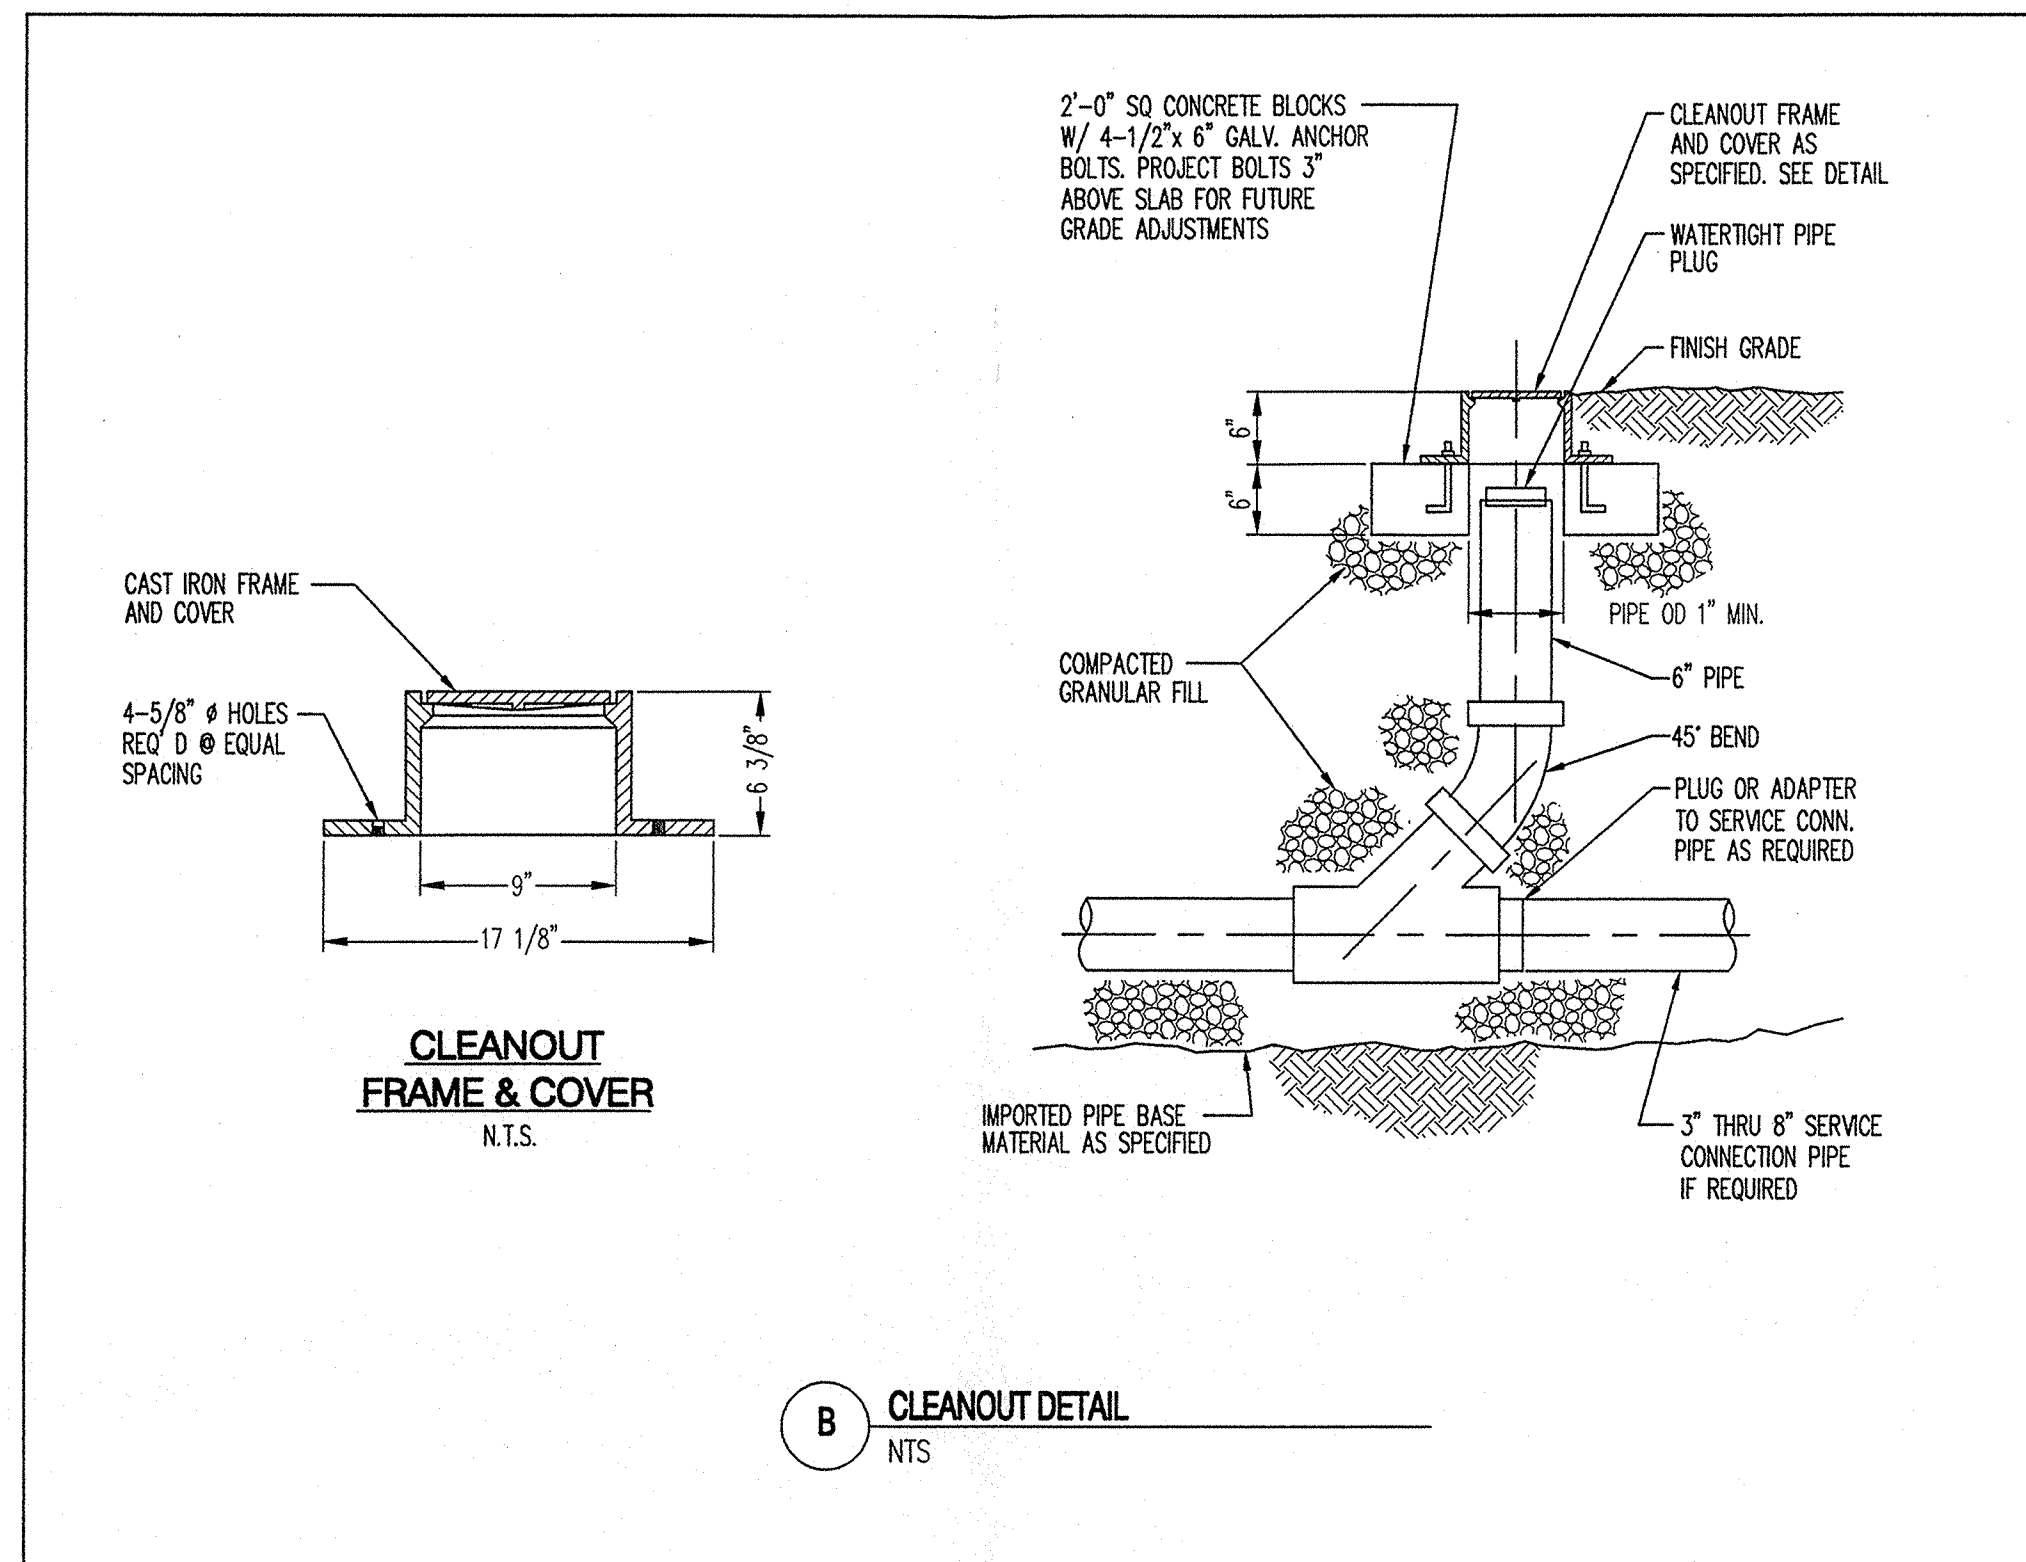

REVISIONS



△
△
DRAWN BY: CN
REVIEWED BY: JTN
DATE: 8/15/05
PROJECT NO: 04186
DRAWING NAME:

SITE DETAILS & GENERAL NOTES

SEP 02 2005
SHEET NO.

C104
OF

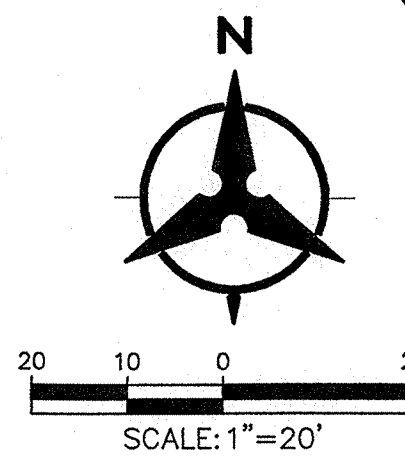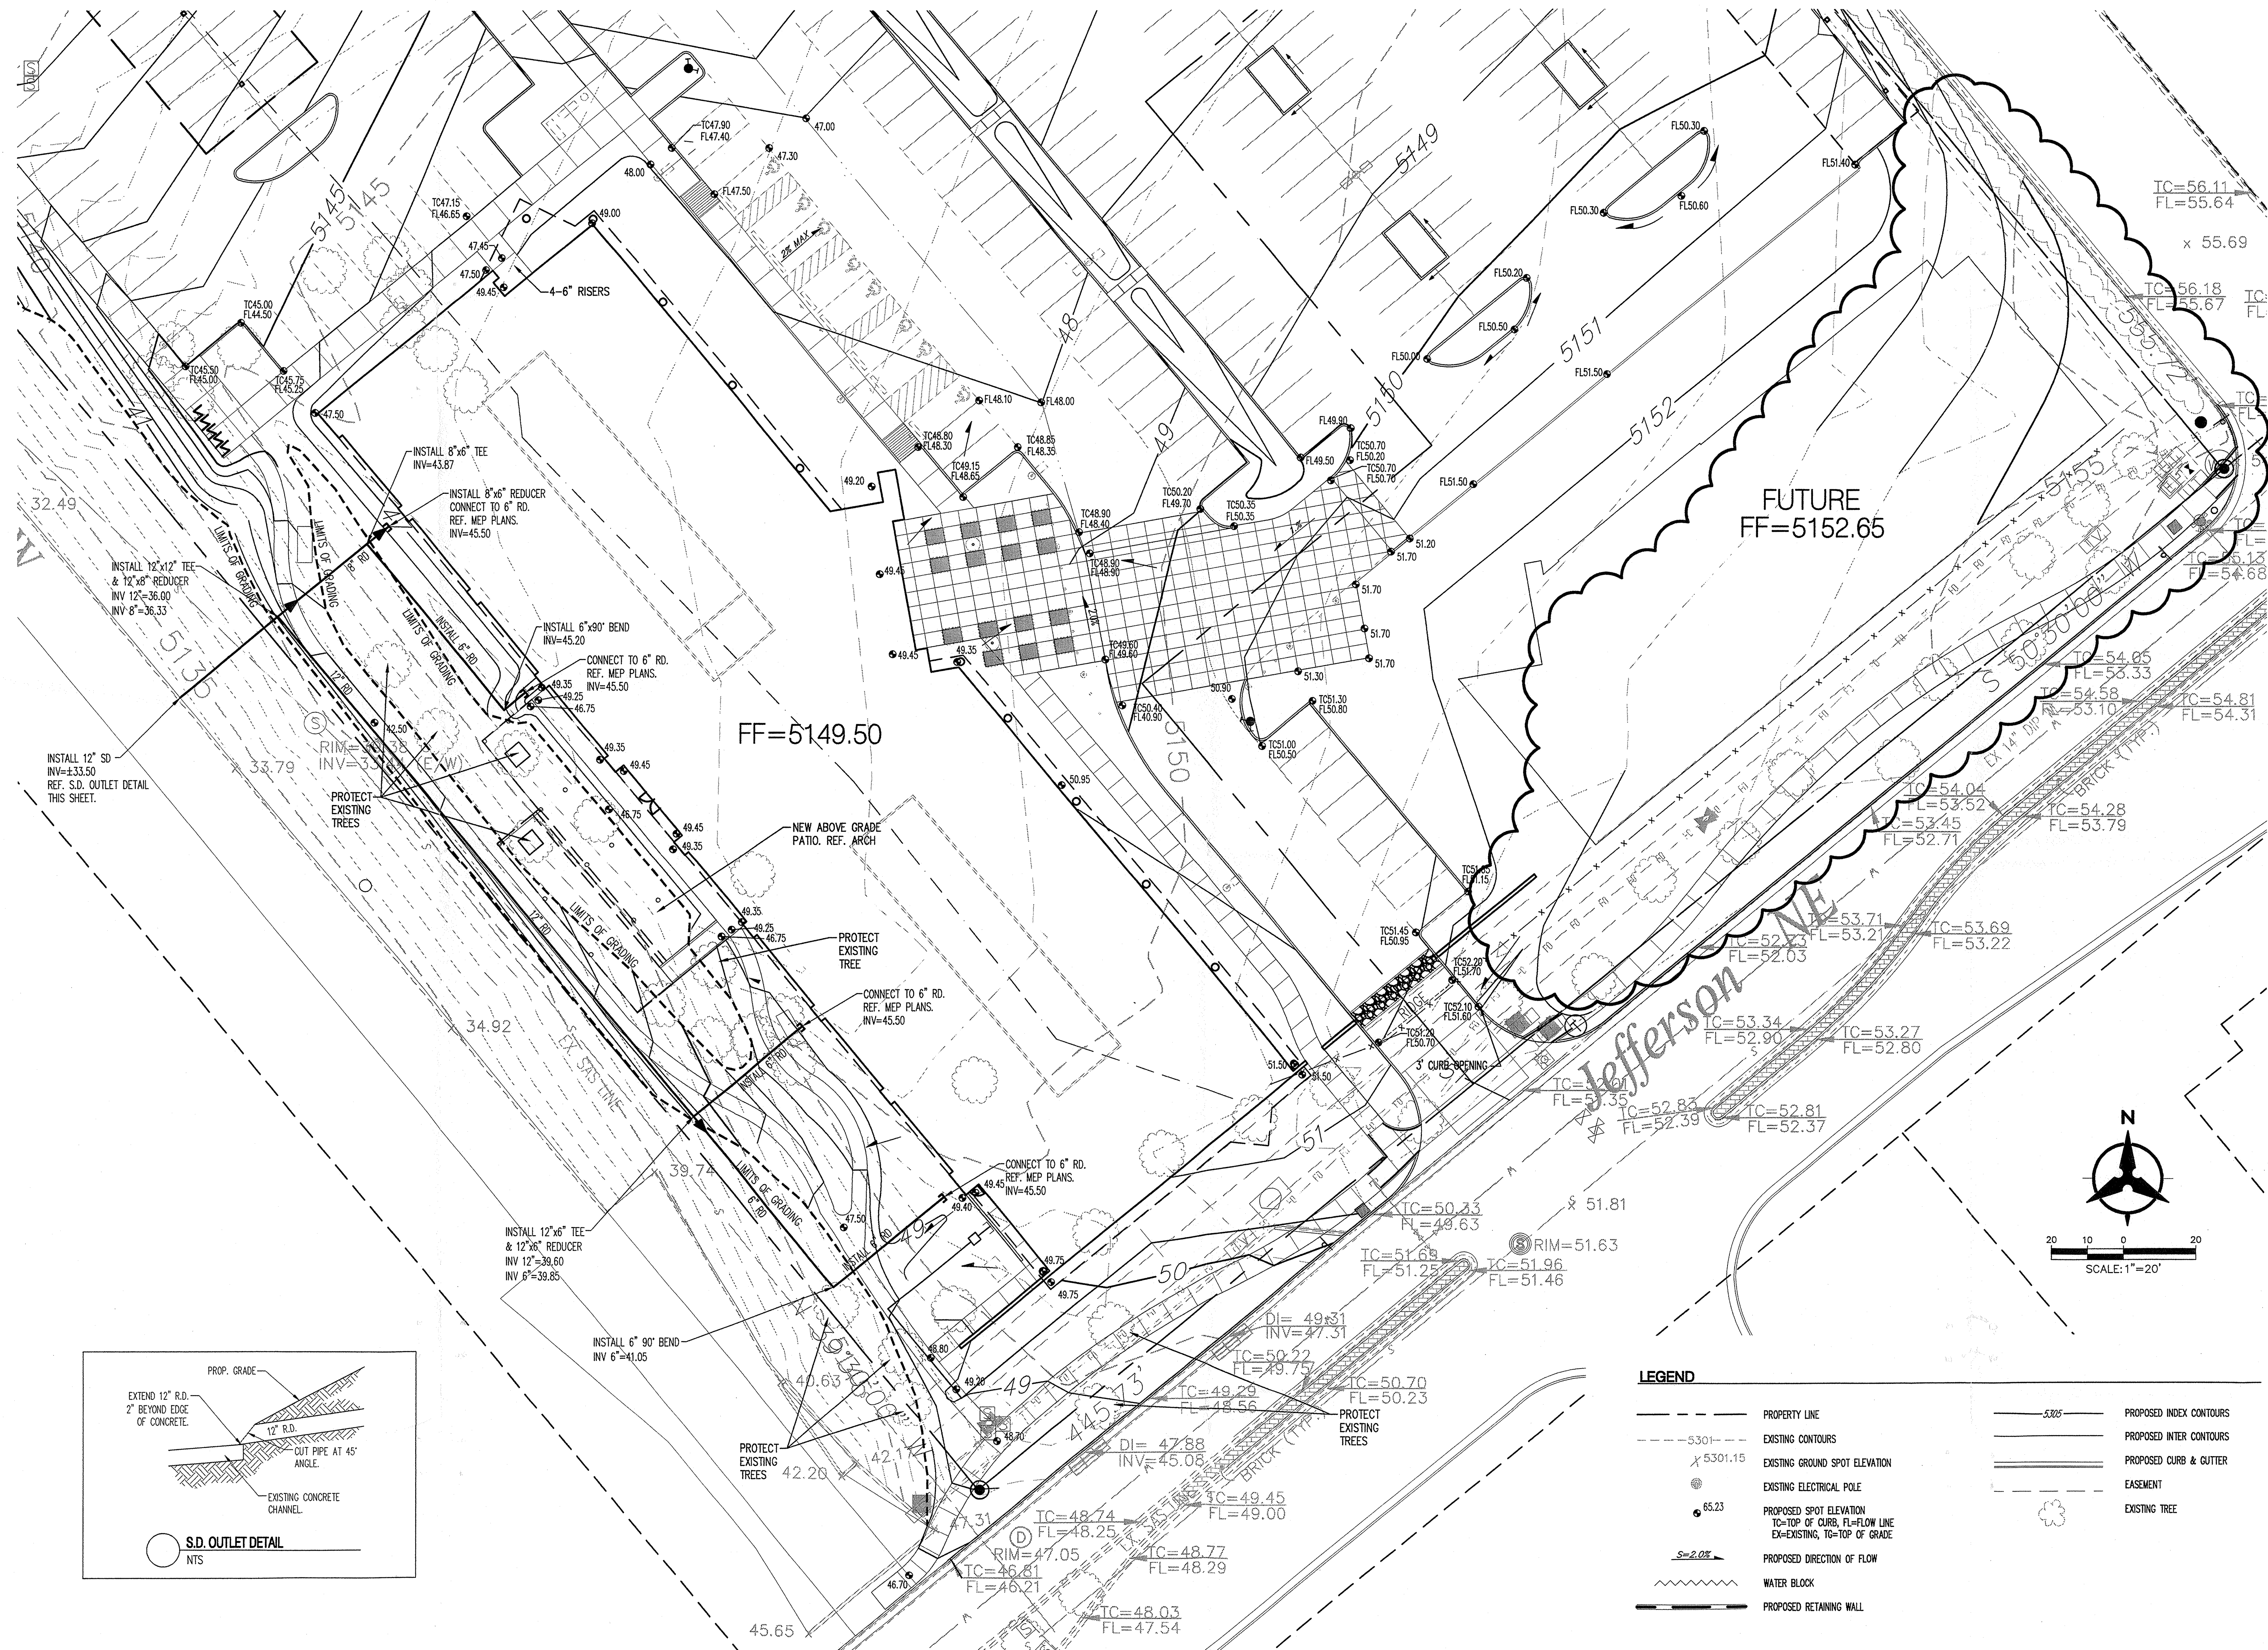


LEGEND	
	PROPERTY LINE
	EXISTING CONTOURS
	EXISTING GROUND SPOT ELEVATION
	EXISTING ELECTRICAL POLE
	PROPOSED SPOT ELEVATION TO=TOP OF CURB, FL=FLOW LINE EX=EXISTING, TO=TOP OF GRADE
	PROPOSED DIRECTION OF FLOW
	WATER BLOCK
	PROPOSED RETAINING WALL
	PROPOSED INDEX CONTOURS
	PROPOSED INTER CONTOURS
	PROPOSED CURB & GUTTER
	EASEMENT
	EXISTING TREE

REVISIONS	
△	
△	
DRAWN BY	CN
REVIEWED BY	JTM
DATE	8/15/05
PROJECT NO.	04186
DRAWING NAME	

DETAILED GRADING
PLAN



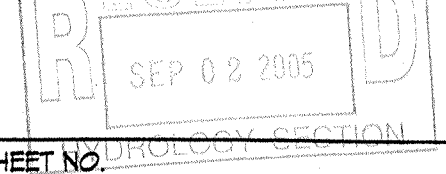


GRADING NOTES

- EXCEPT AS PROVIDED HEREIN, GRADING SHALL BE PERFORMED AT THE ELEVATIONS AND IN ACCORDANCE WITH THE DETAILS SHOWN ON THIS PLAN.
- THE COST FOR REQUIRED CONSTRUCTION DUST AND EROSION CONTROL MEASURES SHALL BE INCIDENTAL TO THE PROJECT COST.
- ALL WORK RELATIVE TO FOUNDATION CONSTRUCTION, SITE PREPARATION, AND PAVEMENT INSTALLATION, AS SHOWN ON THIS PLAN, SHALL BE CONSTRUCTED IN ACCORDANCE WITH THE "GEOTECHNICAL INVESTIGATION," AS PROVIDED BY THE ARCHITECT OR OWNER. ALL OTHER WORK SHALL, UNLESS OTHERWISE STATED OR PROVIDED FOR HEREON, BE CONSTRUCTED IN ACCORDANCE WITH THE PROJECT (FIRST PRIORITY) SPECIFICATIONS, AND/OR THE CITY OF ALBUQUERQUE (COA) STANDARD SPECIFICATIONS FOR PUBLIC WORKS (SECOND PRIORITY).
- EARTH SLOPES SHALL NOT EXCEED 3 HORIZONTAL TO 1 VERTICAL UNLESS SHOWN OTHERWISE.
- IT IS THE INTENT OF THESE PLANS THAT THIS CONTRACTOR SHALL NOT PERFORM ANY WORK OUTSIDE OF THE PROPERTY BOUNDARIES EXCEPT AS REQUIRED BY THIS PLAN.
- THE CONTRACTOR IS TO ENSURE THAT NO SOIL ERODES FROM THE SITE ONTO ADJACENT PROPERTY OR PUBLIC RIGHT-OF-WAY. THIS SHOULD BE ACHIEVED BY CONSTRUCTING TEMPORARY BERM OR SILT FENCE AT THE PROPERTY LINES AND WETTING THE SOIL TO PROTECT IT FROM WIND EROSION.
- A DISPOSAL SITE FOR ANY & ALL EXCESS EXCAVATION MATERIAL, AND UNSUITABLE MATERIAL AND/OR A BORROW SITE CONTAINING ACCEPTABLE FILL MATERIAL SHALL BE OBTAINED BY THE CONTRACTOR IN COMPLIANCE WITH APPLICABLE ENVIRONMENTAL REGULATIONS AND APPROVED BY THE OBSERVER. ALL COSTS INCURRED IN OBTAINING A DISPOSAL OR BORROW SITE AND HAUL TO OR FROM SHALL BE CONSIDERED INCIDENTAL TO THE PROJECT AND NO SEPARATE MEASUREMENT OR PAYMENT SHALL BE MADE.
- PAVING AND ROADWAY GRADES SHALL BE +/- 0.1' FROM PLAN ELEVATIONS. PAD ELEVATION SHALL BE +/- 0.05' FROM BUILDING PLAN ELEVATION.
- ALL PROPOSED CONTOURS REFLECT TOP OF PAVEMENT ELEVATIONS IN THE PARKING AREA AND MUST BE ADJUSTED FOR MEDIANS AND ISLANDS.
- VERIFY ALL ELEVATIONS SHOWN ON PLAN FROM BASIS OF ELEVATION CONTROL STATION PRIOR TO BEGINNING CONSTRUCTION.



LEGEND

---	PROPERTY LINE	---	PROPOSED INDEX CONTOURS
- - - -	EXISTING CONTOURS	---	PROPOSED INTER CONTOURS
5301.15	EXISTING GROUND SPOT ELEVATION	---	PROPOSED CURB & GUTTER
65.23	EXISTING ELECTRICAL POLE	---	EASEMENT
65.23	PROPOSED SPOT ELEVATION TC=TOP OF CURB FL=LOW LINE EX=EXISTING, TO=TOP OF GRADE	---	EXISTING TREE
S=2.0%	PROPOSED DIRECTION OF FLOW		
~~~~~	WATER BLOCK		
=====	PROPOSED RETAINING WALL		

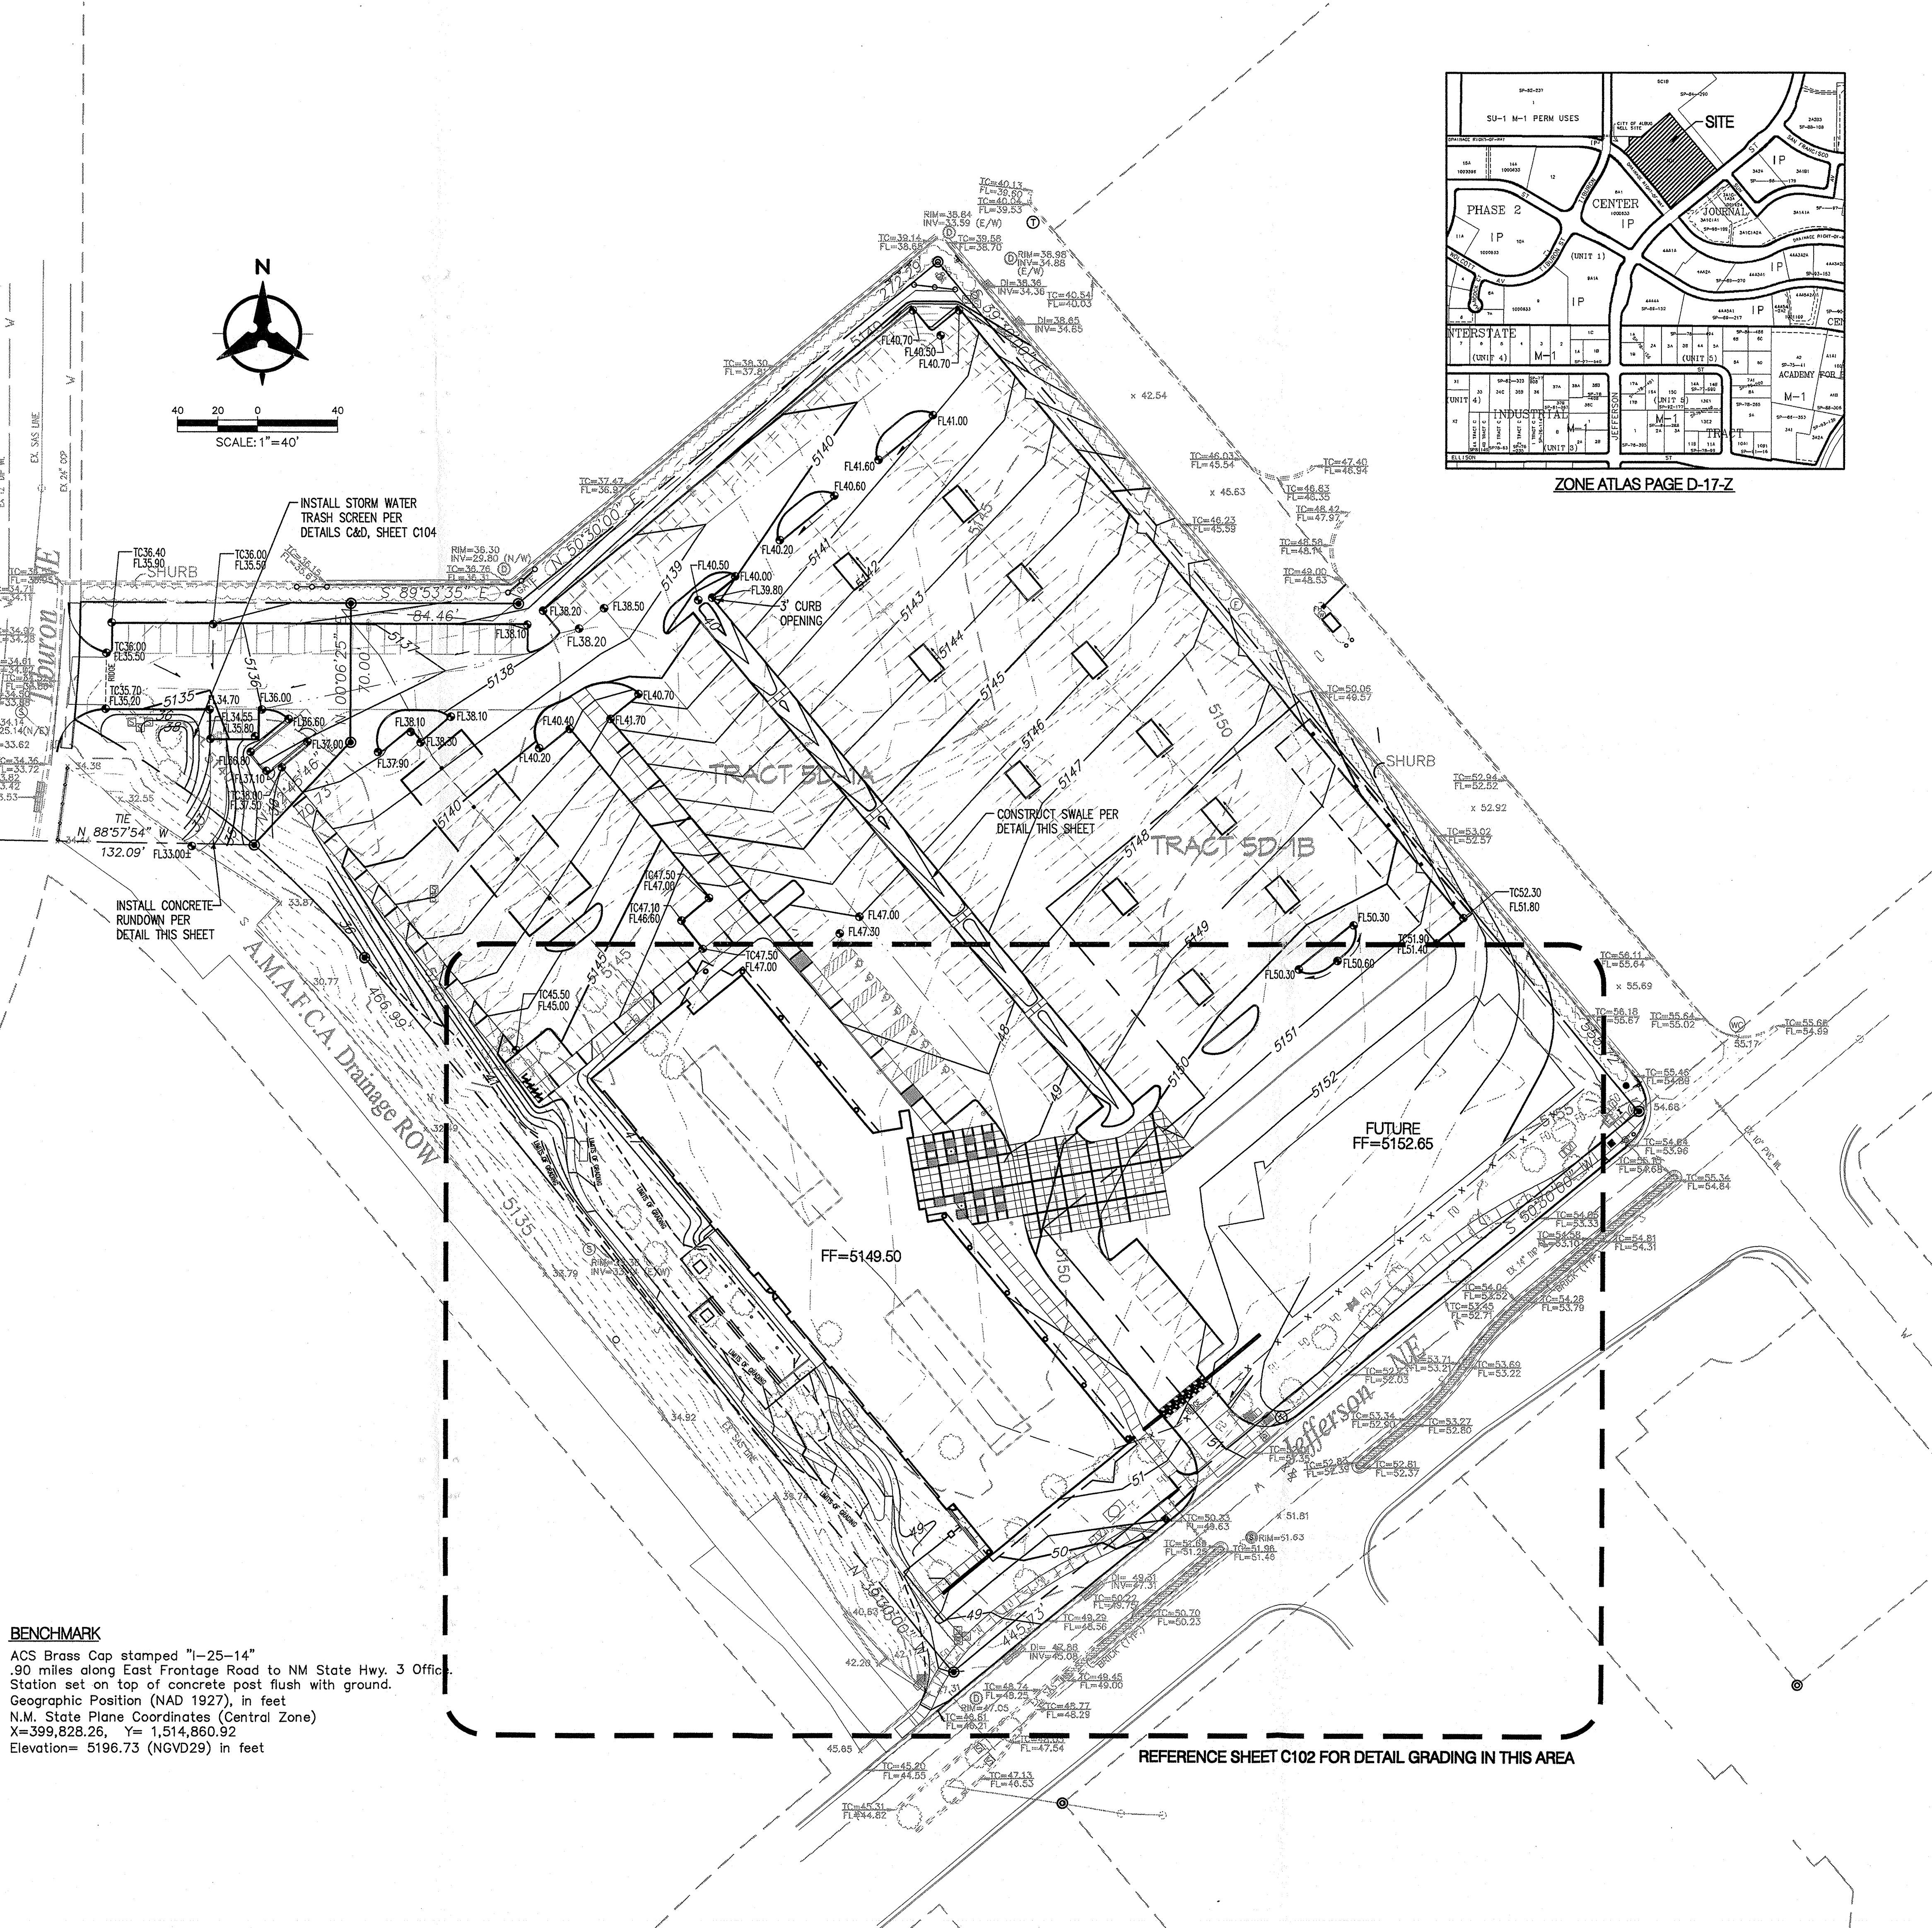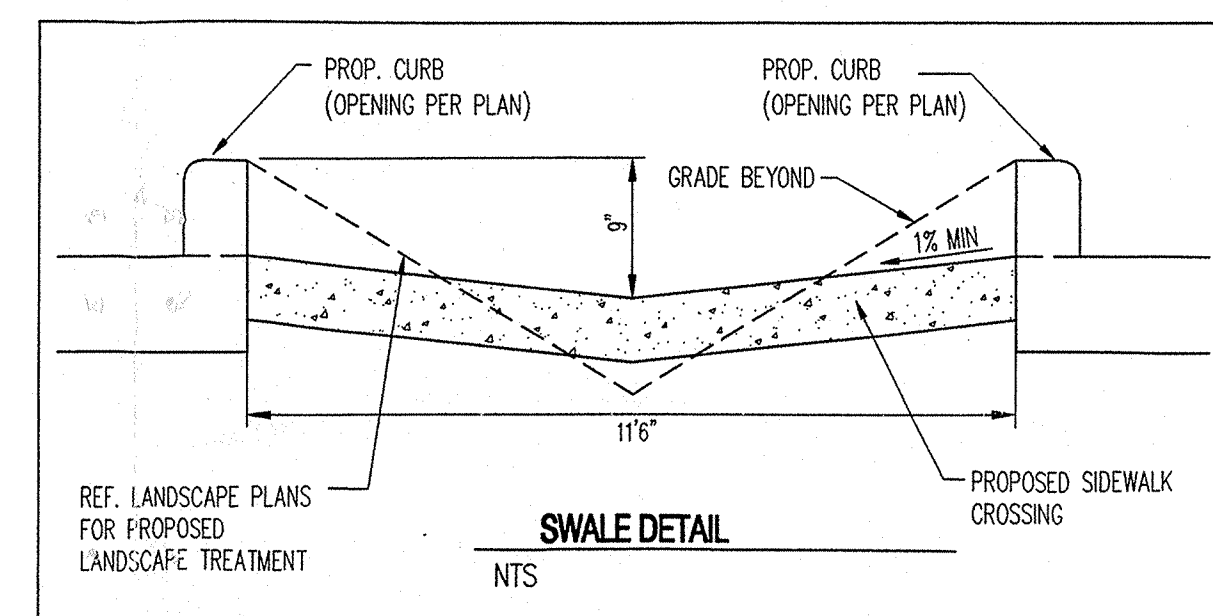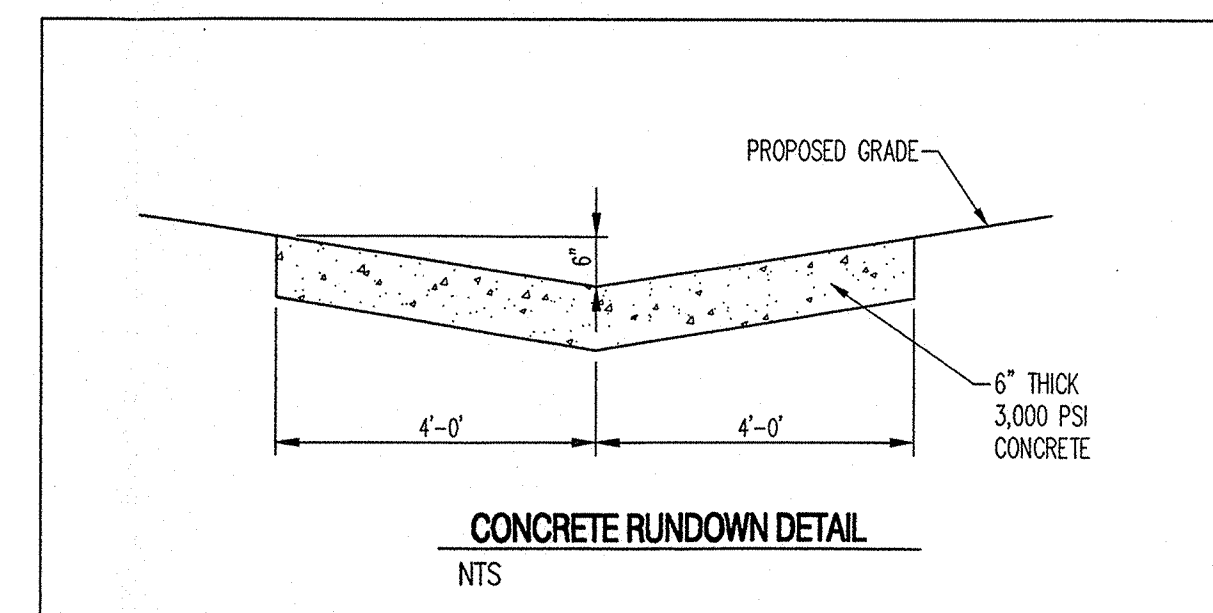

**BENCHMARK**  
ACS Brass Cap stamped "I-25-14"  
.90 miles along East Frontage Road to NM State Hwy. 3 Office  
Station set on top of concrete post flush with ground.  
Geographic Position (NAD 1927), in feet  
N.M. State Plane Coordinates (Central Zone)  
X=399,828.26, Y=1,514,860.92  
Elevation= 5196.73 (NGVD29) in feet



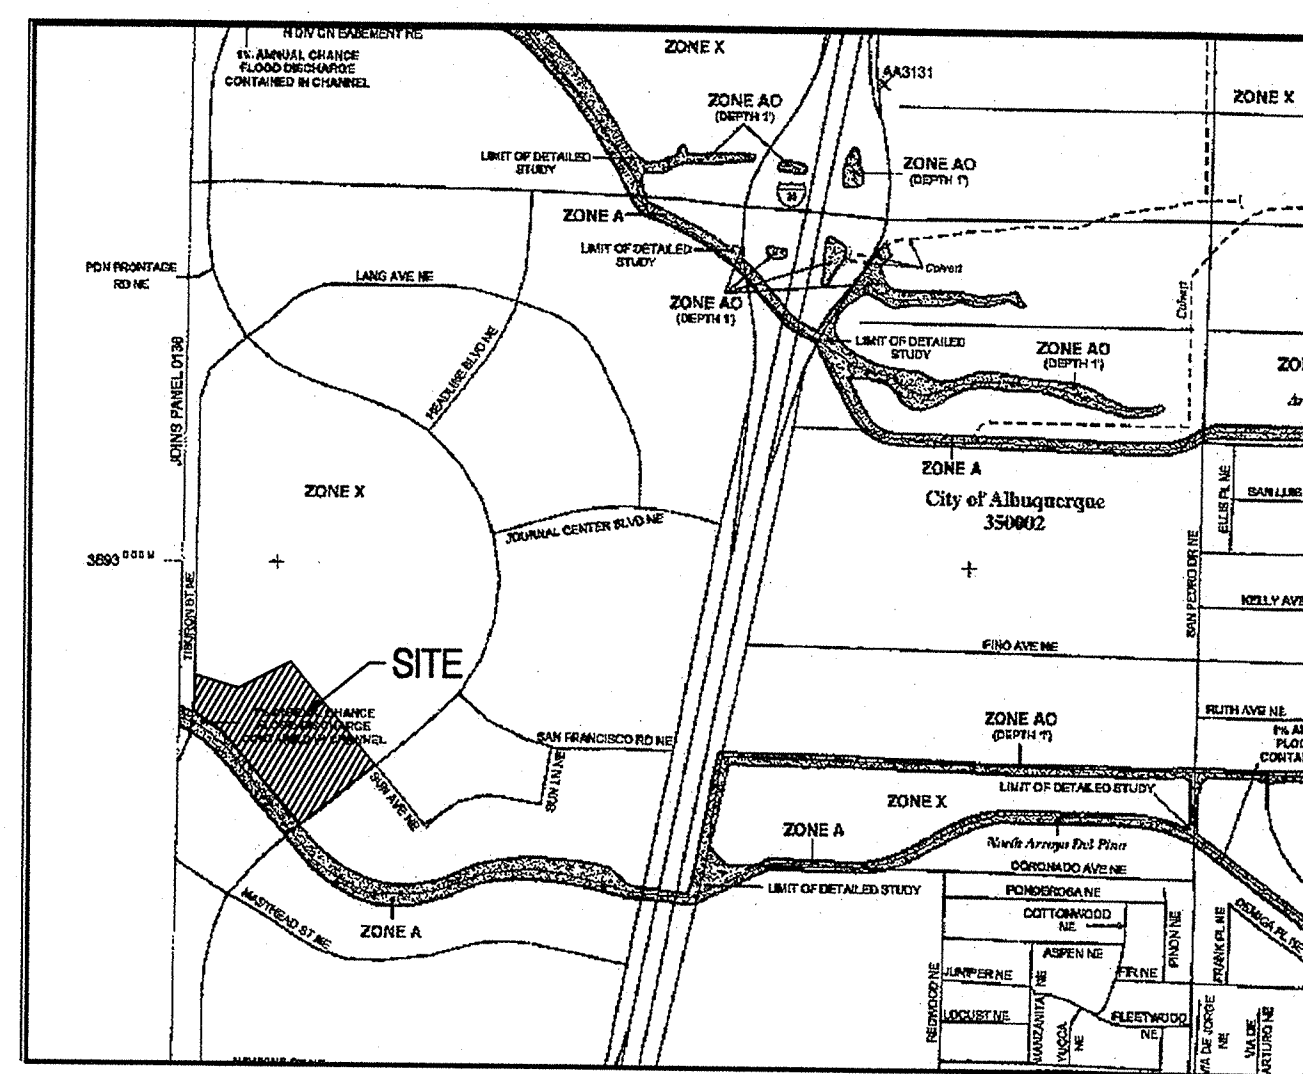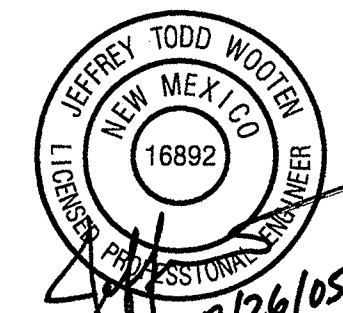

**FLOOD INSURANCE RATE MAP**  
FEMA - NUMBER 350002, PANEL 0137F

**ZONE ATLAS PAGE D-17-Z**

**LEGAL DESCRIPTION**

JOURNAL CENTER TRACT 5D-1

**DRAINAGE MANAGEMENT PLAN**

**I. INTRODUCTION**

The purpose of this submittal is to present a grading and drainage plan for the proposed Office Building in Journal Center (Tract 5D-1). The site is bound to the southeast by Jefferson and to the southwest by the North Pino Arroyo Concrete Channel. The project will include one multi story office building along with parking and landscaped areas. This submittal is in support of building permit approval.

**II. SITE LOCATION**

The site is located within zone atlas map # D-17-Z. In reference to the Federal Emergency Management Agency map #3500020137F, there is a 1% annual chance flood zone adjacent to the site. This flood elevation is contained in the AMAFCA North Pino Arroyo Concrete Channel along the southern border of the site.

**III. EXISTING HYDROLOGIC CONDITIONS**

The site encompasses approximately 6.04 acres. The site is undeveloped and existing slopes range between 1 to 3% to the west. Currently, the majority of the site drains via surface flow into the adjacent channel (North Pino Arroyo) and partially into Tiburon Ave.

Under existing conditions, this site has a 100yr discharge of 17.06cfs. The associated land treatments for the existing conditions are 20% land treatment A and 80% land treatment C. The analysis of the existing hydrology was performed in accordance with the methodology outlined in section 22.2 of the Development Process Manual.

**IV. PROPOSED HYDROLOGIC CONDITIONS**

The proposed project includes construction of one multi story office building, combined with parking and landscaped areas. According to the approved drainage report for Journal Center, this site has free discharge into the North Pino Arroyo. Most of the site drains into the North Pino Arroyo via a concrete roadway. There is a small portion of landscaped area that will drain via surface flow to Jefferson. This insignificant amount of drainage will not have an adverse effect on the downstream system within Jefferson.

The total 100 year peak discharge entering the North Pino Arroyo from this site is 26.74cfs. The associated land treatments for Basin 1 are 10% land treatment C and 90% land treatment D. The flow from Basin 2 that will discharge to Jefferson is 0.71cfs. The analysis of the proposed hydrology was performed in accordance with the methodology outlined in section 22.2 of the Development Process Manual. See Basin Data table for associated computations.

**V. CONCLUSION**


The drainage management plan is capable of safely passing the 100 year storm and meets city requirements. With this submittal we are seeking building permit approval.

JOURNAL CENTER OFFICE BUILDING BASIN CALCULATIONS									
Development Conditions Basin Data Table									
This table is based on the DPM Section 22.2, Zone 12									
BASIN ID	Area (SQ. FT)	Area (AC.)	Land Treatment Percentages				Q(100) (cfs/ac.)	Q(100) (cfs)	WT E (inches)
Existing			A	B	C	D			
Basin 1	263147	6.04	20.0%	0.0%	80.0%	0.0%	2.82	17.06	1.01
Proposed									
Basin 1	268384	5.89	0.0%	0.0%	10.0%	90.0%	4.54	26.74	2.02
Basin 2	6764	0.16	0.0%	0.0%	10.0%	90.0%	4.54	0.71	2.02
TOTAL	263147	6.04	-	-	-	-	4.54	27.45	4.04
									44318.38
									75896.05

**LEGEND**

PROPERTY LINE	PROPOSED INDEX CONTOURS
EXISTING CONTOURS	PROPOSED INTER CONTOURS
EXISTING GROUND SPOT ELEVATION	PROPOSED CURB & GUTTER
EXISTING ELECTRICAL POLE	EASEMENT
PROPOSED SPOT ELEVATION	EXISTING TREE
TC=TOP OF CURB, FL=FLOW LINE	PROPOSED LIGHTING
FGH=TOP OF WALL, FGL=BOTTOM OF WALL	PROPOSED STORM DRAIN LINE
EX=EXISTING, TO=TOP OF GRADE	PROPOSED STORM DRAIN MANHOLE
PROPOSED DIRECTION OF FLOW	PROPOSED STORM DRAIN INLET
WATER BLOCK	EXISTING STORM DRAIN MANHOLE
PROPOSED RETAINING WALL	

**REVISIONS**

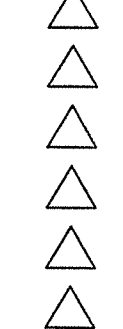

DRAWN BY: RMM

REVIEWED BY: JTN

DATE: 8/15/05

PROJECT NO.: 04186

DRAWING NAME:

**DRAINAGE MANAGEMENT PLAN**

HYDROLOGY SECTION


SHEET NO.

COO1







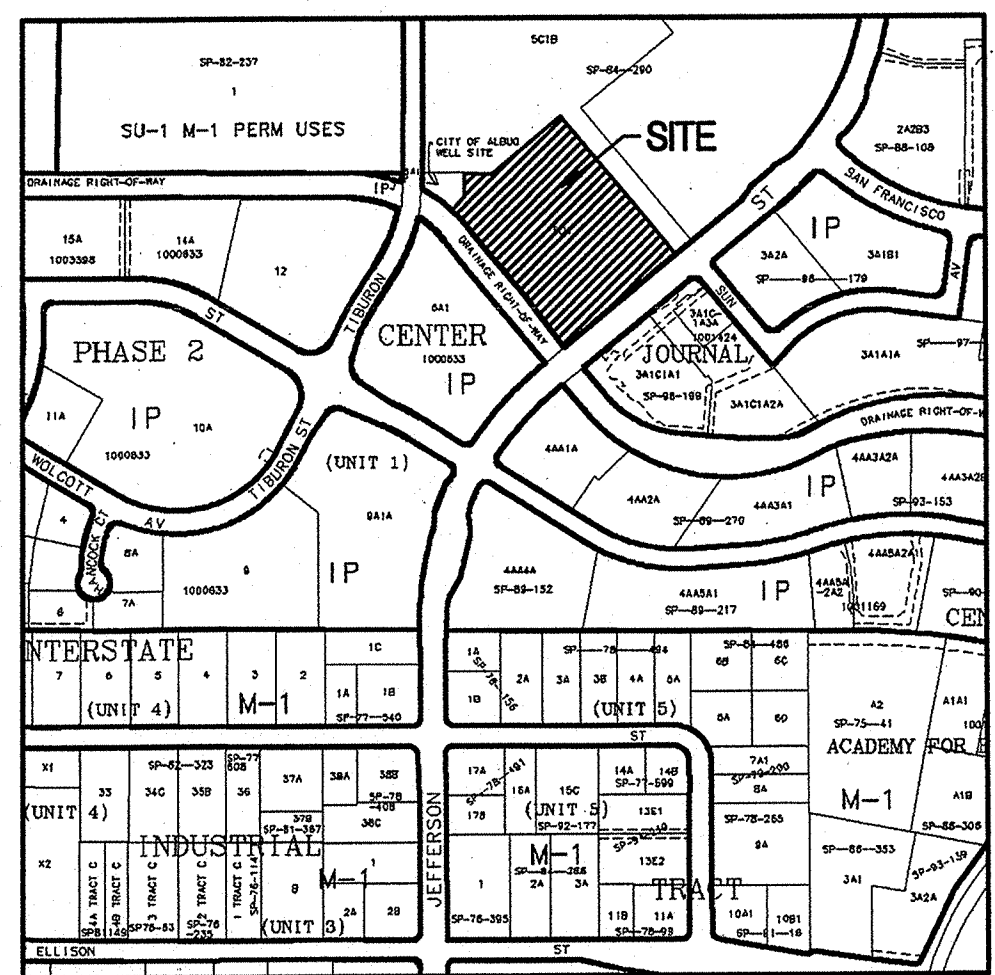

ZONE ATLAS PAGE D-17-Z

**LEGAL DESCRIPTION**

JOURNAL CENTER TRACT 5D-1

**CONCEPTUAL DRAINAGE MANAGEMENT PLAN**

**I. INTRODUCTION**

The purpose of this submittal is to present a conceptual grading and drainage plan for the proposed Office Buildings in Journal Center (Tract 5D-1). The site is bound to the southeast by Jefferson and to the southwest by the North Pina Arroyo Concrete Channel. The project will include two office buildings along with parking and landscaped areas. This submittal is in support of site plan approval for DRB approval.

**II. SITE LOCATION**

The site is located within zone atlas map # D-17-Z. In reference to the Federal Emergency Management Agency map #35001C01377, there is a 1% annual chance flood zone adjacent to the site. This flood elevation is contained in the AMAFCA North Pina Arroyo Concrete Channel along the northern border of the site.

**III. EXISTING HYDROLOGIC CONDITIONS**

The site encompasses approximately 5.8 acres with an additional 0.22 acres acquired for an access easement from the site to Tiburon. The site is undeveloped and existing slopes range between 1 to 3% to the west. Currently, the majority of the site drains via surface flow into the adjacent channel (North Pina Arroyo) and partially into Tiburon Ave.

Under existing conditions, this site has a 100yr discharge of 16.98cfs. The associated land treatments for the existing conditions are 20% land treatment A and 80% land treatment C. The analysis of the existing hydrology was performed in accordance with the methodology outlined in section 22.2 of the Development Process Manual.

**IV. PROPOSED HYDROLOGIC CONDITIONS**

The proposed project includes construction of two office buildings, combined with parking and landscaped areas. According to the approved drainage report for Journal Center, this site has free discharge into the North Pina Arroyo. The entire site drains into the North Pina Arroyo via a concrete random. There is a small portion of the access easement that will drain via surface flow to Tiburon. This insignificant amount of drainage will not have an adverse effect on the downstream system within Tiburon. The total 100 year peak discharge entering the North Pina Arroyo from this site is 27.45cfs. The associated land treatments for the developed site are 100% land treatment C and 90% land treatment D. The analysis of the proposed hydrology was performed in accordance with the methodology outlined in section 22.2 of the Development Process Manual. See Basin Data table for associated computations.

**V. CONCLUSION**

The drainage management plan is capable of safely passing the 100 year storm and meets city requirements. With this submittal we are seeking hydrology approval in support of site plan approval.

JOURNAL CENTER OFFICE BUILDING BASIN CALCULATIONS									
Development Conditions Basin Data Table									
This table is based on the DPM Section 22.2, Zone: 2									
BASIN ID	Area (SQ. FT)	Area (AC.)	Land Treatment Percentages				Q(100) (cfs/acc.)	Q(100) (cfs)	WT E (inches)
Existing	263160	6.04	20.0%	0.0%	80.0%	0.0%	2.82	17.06	22149
Proposed	263160	6.04	0.0%	0.0%	10.0%	90.0%	4.64	27.45	202
									44321
									75900

**REVISIONS**

△  
△  
**DRAWN BY**


**REVIEWED BY**

DATE 4/12/05

**PROJECT NO.**

**DRAWING NAME**

**DRAINAGE  
MANAGEMENT  
PLAN**

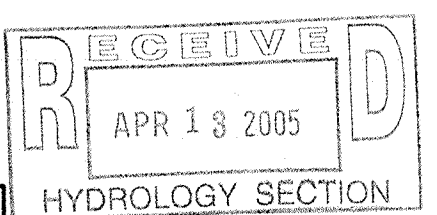


**SHEET NO.**

**COO1**  
OF




**Bohannon & Huston**

Courtyard | 7500 Jefferson St. NE Albuquerque, NM 87109-4335  
ENGINEERING • SPATIAL DATA • ADVANCED TECHNOLOGIES



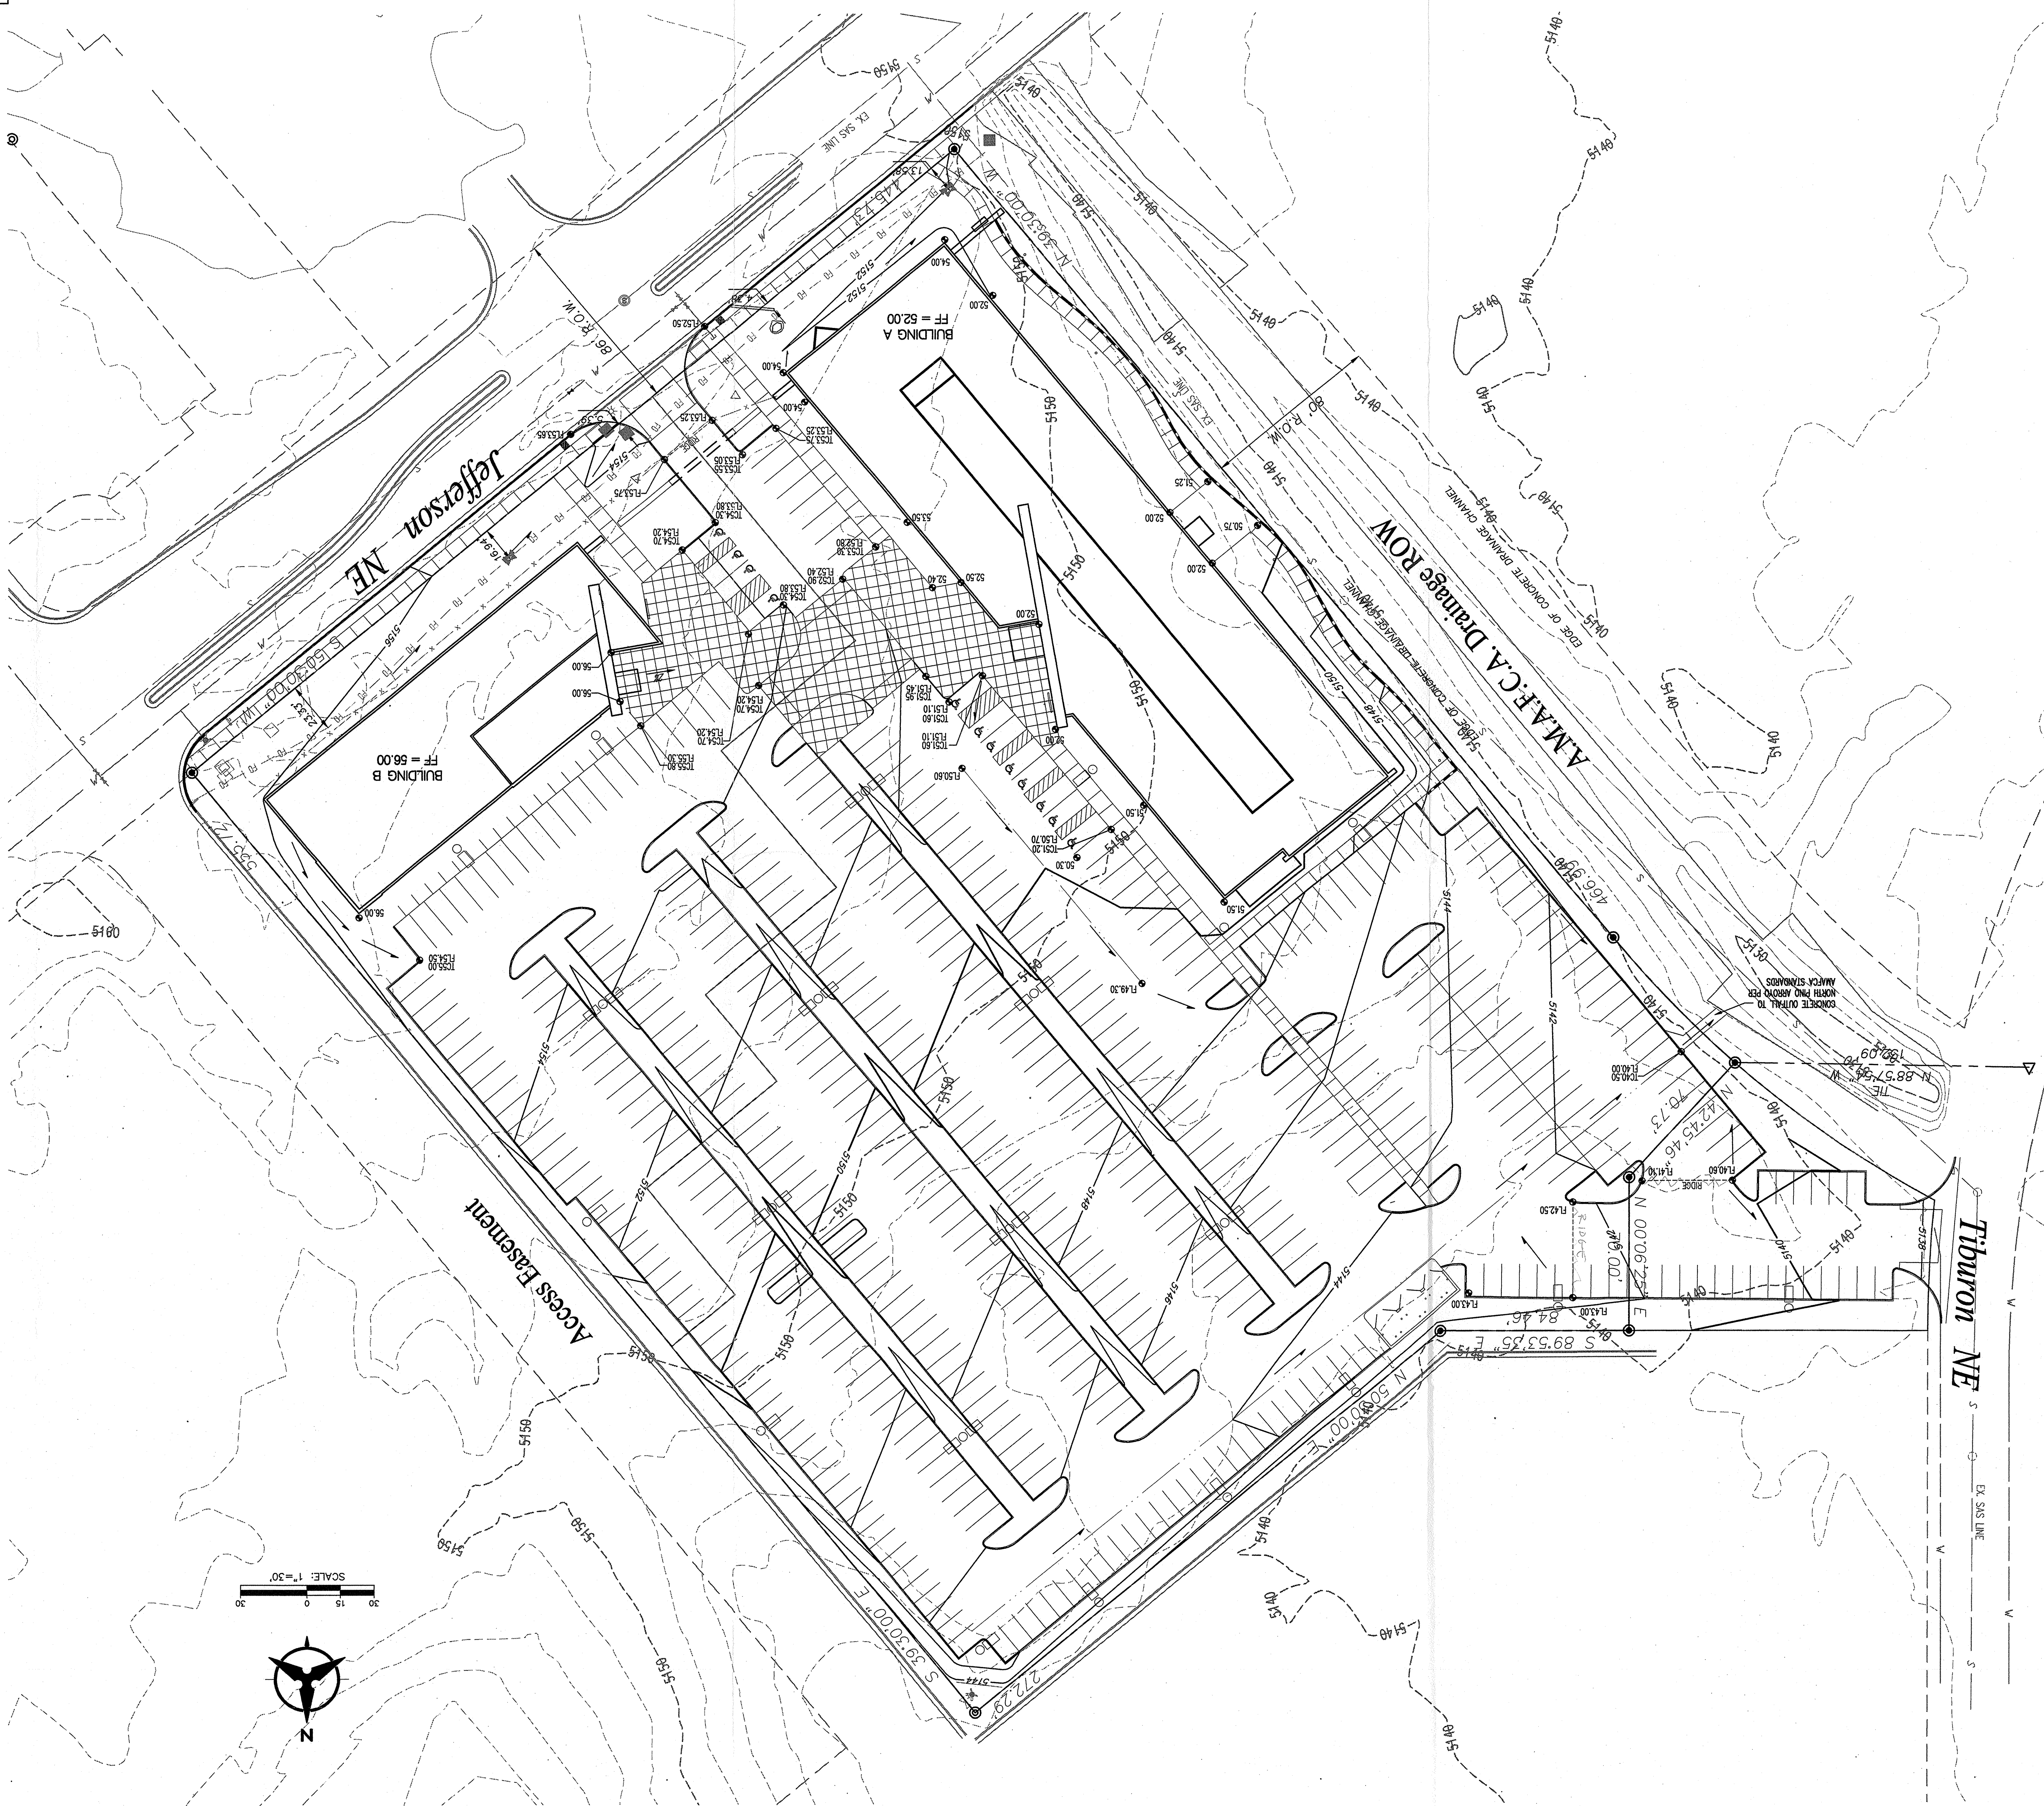



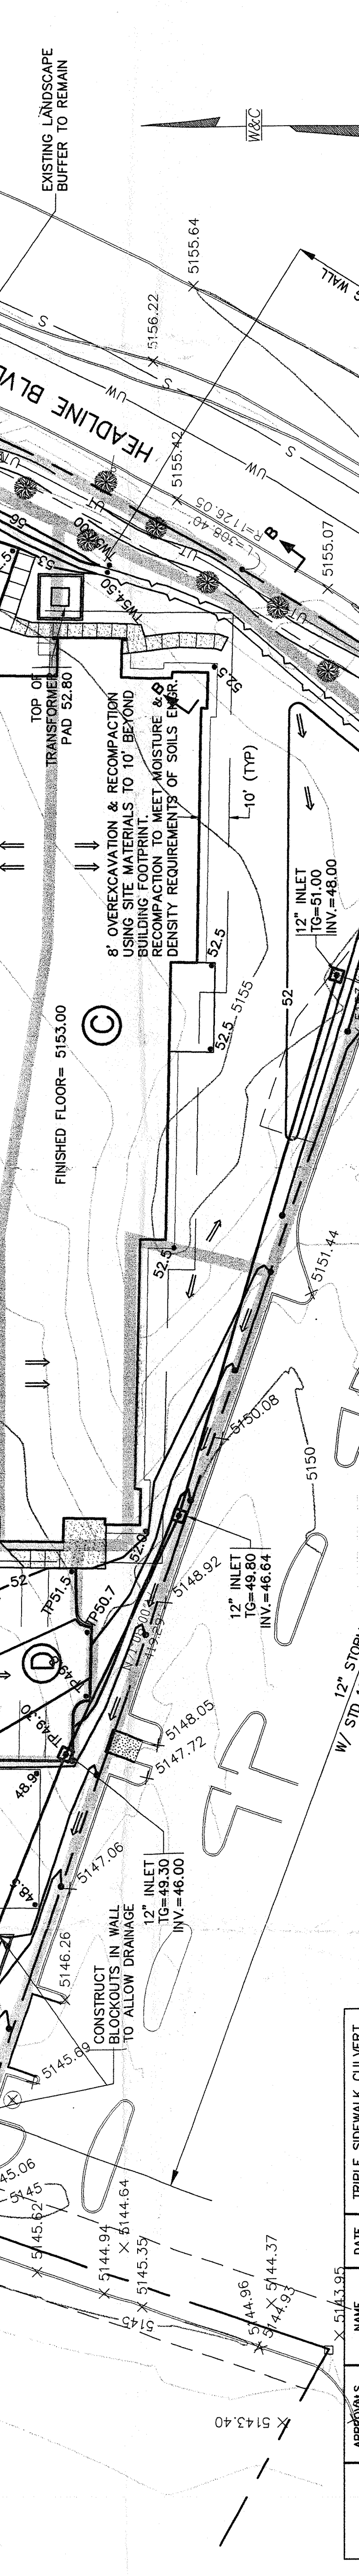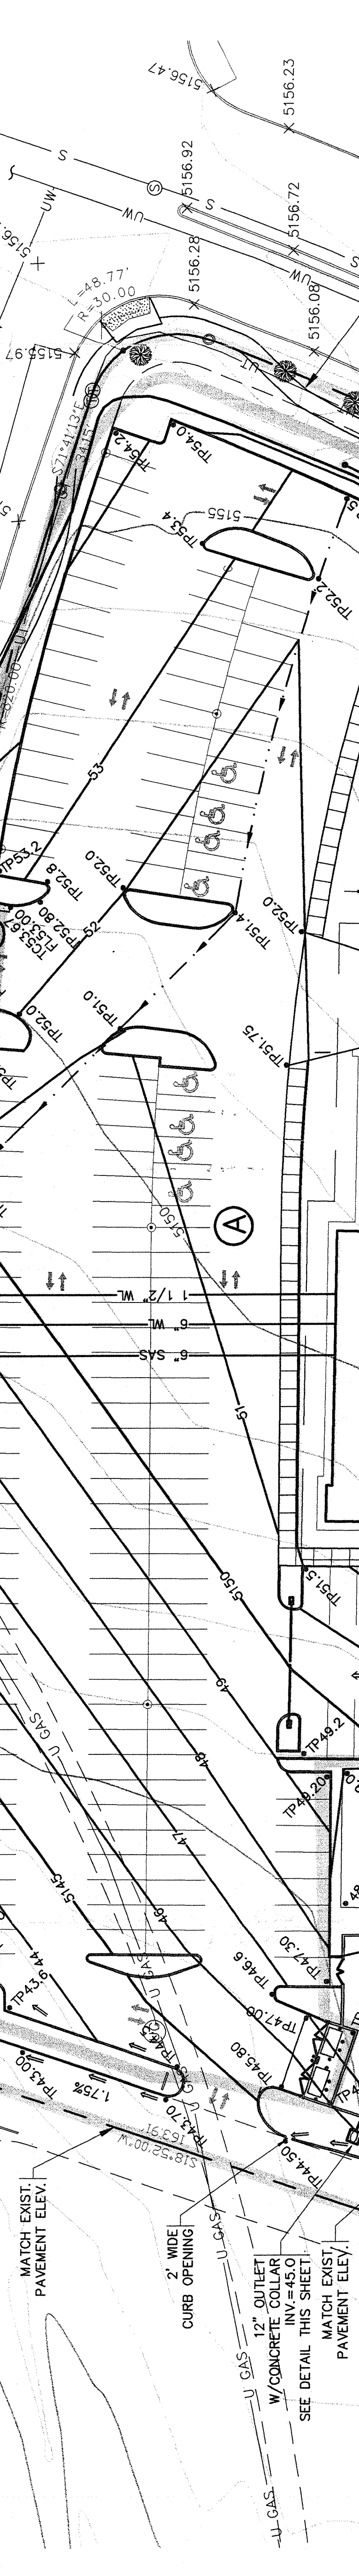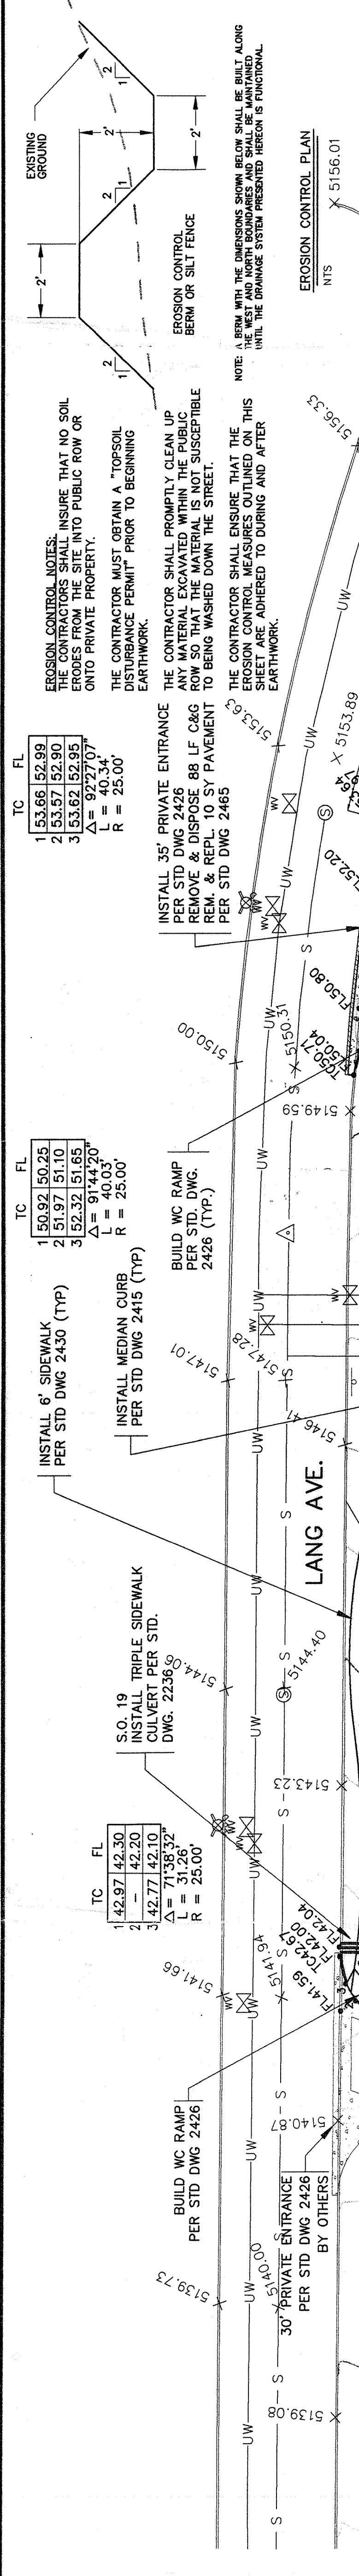

WILSON & COMPANY  
HYDROLOGIST  
INSPECTOR  
ACE/RELD  
WCEA # 38115  
S.O. 19  
D-17-Z  
WILSON & COMPANY OFFICE BUILDING  
MAP NO.  
WATER TO CONTAMINATION

**PAVEMENT SECTION**

1500 LBS. STABILITY  
TYPE B GRADUATION  
4" AGGREGATE BASE COURSE  
95% COMPACTION

**GRADING NOTES**

1. ALL ELEVATIONS ARE FINISHED ELEVATIONS  
AND ROUGH GRADING SHALL BE 0.5' LOWER  
EXCEPT UNDER BUILDING FOUNDATION WHICH  
WILL BE 1.0' LOWER.

**PROPOSED DRAINAGE SYSTEM**

APPROVED FOR ROUGH GRADING  $\pm 1'$

DATE: 3-18-99

COA: [Signature]

AREA (A)	SUB-BASIN	% D	Q _{max} (GPM)	REMARKS
5155.36	5155.36	5155.36	5155.36	5155.36

[illegible]

5070 EXISTING INTERMEDIATE CONTOUR

5071 EXISTING INDEX CONTOUR



2'-6"

12"

N/S

1. HYDROLOGY COMPUTED USING THE SECTION 22.2 HYDROLOGY OF THE COA "DEVELOPMENT PROCESS MANUAL VOLUME 2, DESIGN CRITERIA." THE PROJECT IS IN ZONE 2. THE EXISTING  $Q_{wm}$  FLOW IS 10.3 cfs (TYPE C LAND TREATMENT)

[illegible]