TAINAGE INFORMATION SHEET

PROJECT TITLE: Ptnay Bours ZONE ATLAS/DRAINAGE FILE # DIT/D3M				
LEGAL DESCRIPTION: 4A-18 JOURNAL CENTER				
CITY ADDRESS: 5141 MASTHEAD STREET NE				
ENGINEERING FIRM: BORDENAVE DESIGNS CONTACT: J. BORDENAVE				
ADDRESS: P.O. Box 91194 87199-1194 PHONE: 823-1344				
OWNER: KEN TEKIN, INC. CONTACT: K. Takin				
ADDRESS: 6729 Acadamy Rd NE 87109 PHONE: 828-2811				
ARCHITECT: SLN&B CONTACT: J. Lawis				
ADDRESS: 1620 Cantral Ava, SE, 87106 PHONE: 247-1529				
SURVEYOR: BORDEN AVE DESIGNS (AS Built Only) CONTACT: J. Bordonal				
ADDRESS: PO BOX91194 , 87199-1194 PHONE: 873-1344				
CONTRACTOR: Cambro Constr. CONTACT: J. Camille				
ADDRESS: 7424 2nd NW PHONE: 345-1133				
PRE-DESIGN MEETING: DECEMBE				
YES DEC 1 3 1989 DRB NO. 89-221				
NO EPC NO.				
COPY OF CONFERENCE YDROLOGY SECTION PROJECT NO				
RECAP SHEET PROVIDED				
TALE OF SUBMITTAL.				
DRAINAGE REPORTSECTOR PLAN APPROVAL				
DRAINAGE PLANSKETCH PLAT APPROVAL				
CONCEPTUAL GRADING & DRAIN PLANPRELIMINARY PLAT APPROVAL				
GRADING PLANSITE DEVELOPMENT PLAN APPROVAL				
EROSION CONTROL PLANFINAL PLAT APPROVAL				
ENGINEER'S DERTIFICATION BUILDING PERMIT APPROVAL FOUNDATION PERMIT APPROVAL				
FOUNDATION PERMIT APPROVAL				
FOUNDATION PERMIT APPROVAL X CERTIFICATE OF OCCUPANCY APPROVAL				
ROUGH GRADING PERMIT APPROVAL				
DATE SUBMITTED: 12/18/89 GRADING/PAVING PERMIT APPROVAL				
BY: Jean Bouline OTHER (SPECIFY).				
2EV 10/25				

R. WARD HUNNICUTT, CHAIRMAN
PAT D. HIGDON, VICE-CHAIRMAN
REX FUNK, SECRETARY-TREASURER
DANIEL W. COOK, DIRECTOR
RONALD D. BROWN, DIRECTOR

LARRY A. BLAIR



Alb perque
Metropolitan
Arroyo
Flood
Control
Authority

2600 PROSPECT N.E. - ALBUQUERQUE, N. M. 87107
TELEPHONE (505) 884-2215

November 14, 1989

Mr. Bernie Montoya Public Works - Hydrology City of Albuquerque P.O. Box 1293 Albuquerque, NM 87113

RE: Pitney Bowes/North Pino Arroyo; D17-D3M

Dear Bernie:

AMAFCA has inspected and accepts the storm sewer connection to the North Pino Arroyo from the Pitney Bowes site.

Sincerely, AMAFCA

John Kelly Field Engineer

cc: Sam Camilli, Cambro Construction



City of Albuquerque

P.O. BOX 1293 ALBUQUERQUE, NEW MEXICO 87103

KEN SCHULTZ MAYOR December 21, 1989

Jake Bordenave, P.E.
Bordenave Designs
7100 Louisiana Boulevard, NE Suite A-106
Albuquerque, New Mexico 87109

RE: ENGINEER'S CERTIFICATION FOR PITNEY-BOWES (D-17/D3M) CERTIFICATION STATEMENT DATED DECEMBER 18, 1989

Dear Mr. Bordenave,

Based on the information provided on your submittal of December 18, 1989, the referenced drainage plan is approved for Certification.

If I can be of further assistance, please feel free to call me at 768-2650.

Cordially,

Bernie J. Montoya, C.E Engineering Assistant

BJM/bsj (WP+1131)

PUBLIC WORKS DEPARTMENT

Walter H. Nickerson, Jr., P.E. Assistant Director Public Works

ENGINEERING GROUP

Telephone (505) 768-2500

EXISTING CONDITIONS

Offsite flows are intercepted by Interstate 25, Masthead Street and the concrete drainage channel. Flow rates and volumes are:

6 hr. - 100 yr. rainfall = 2.3 in.time of concentration = use 10 min. rainfall intensity = 6.84(2.3)(10*-0.51) = 4.86 in./hr. total area = 1.35 ac. rational C factor = 0.40 SCS curve number = 70 $Q_{100} = CiA = 2.6 cfs$ $Q_{10} = 1.7 \text{ cfs}$

 $v_{100} = RA = 1960 cf$ $v_{10} = 1313 \text{ cf}$

The flows generated onsite sheet flow northwesterly across a sod greenbelt to the concrete channel.

PROPOSED CONDITIONS

As in the existing condition all offsite flows are intercepted by existing streets and drainage facilities. The site is to be developed as an office building with approximately 70 percent of the area composed of impervious surfaces.

All roof and parking lot drainage in Basin A is directed to a catch basin which will discharge via a pipe to the concrete channel. All nuisance flows and up to the 10 year storm will be transported by the catch basin and pipe system. Flows in excess of the 10 year storm will exit the parking lot via a curb opening and sheet flow across the sod greenbelt to the concrete channel. Flows generated in Basin B to the east of the building will sheet flow to the concrete channel for all storms. Flows for each of the basins are:

6 hr. - 100 yr. rainfall = 2.3 in.time of concentration = use 10 min. rainfall intensity = 4.86 in./hr.

Taillair Incensicy - 4.00	T11 • / 11 T •	}
-	Basin A	Basin I
impervious area, acres	0.78	0.00
pervious area, acres	0.12	0.45
total area, acres	0.90	0.45
rational C factor	0.86	0.25
SCS curve number	93	61
Q ₁₀₀ , cfs	3.8	0.5
Q ₁₀ , cfs	2.5	0.4
v ₁₀₀ , cf	62726	2940
V ₁₀ , cf	41650	1952
-		

HYDRAULICS

Weir length = 2.5/(3.2)(0.1667*3/2) = 11.5 ft Orifice area = 2.5/(0.6)(0.5)((2g)(.1667)*1/2) = 2.5 s.f.Use basin with 6 inch sidewalls and inside dimensions of 2 feet. Walls and floor of basin shall have 1/2 inch rebar at 6 inches on center each way.

 $Q_{10} = 2.5 \text{ cfs}$

pipe radius = 2.5/(0.6)((2g)(2.5)*1/2) = 0.32 ft.

Use 8 inch pvc pipe from catch basin to concrete channel.


CURB OPENING


 $Q_{100} - Q_{10} = 3.8 - 2.5 = 1.3 \text{ cfs}$ Weir length = 1.3/(2.6)(0.25*3/2) = 4.0 ft.


Use 4 feet wide curb opening in vicinity of catch basin.


DRAINAGE CALCULATIONS

- 1. Two (2) working days prior to any excavation the Contractor shall contact Line Locating Service (765-1234) for location of existing utilities.
- 2. Prior to construction the Contractor shall excavate and verify the horizontal and vertical location of all potential obstructions. Should a conflict exist, the Contractor shall notify the Engineer so that the conflict can be resolved with a minimum amount of delay.
- 3. All work on this project shall be performed in accordance with applicable federal, state and local laws, rules and regulations concerning construction safety and worker health.
- 4. All construction within the public right-of-way shall be performed in accordance with City of Albuquerque Standard Specifications for Public Works Construction, 1986.
- 5. The Contractor shall ensure that no soil erodes from the site onto private property AMAFCA or City right-of-way. This can be achieved by constructing temporary earth berms or installing sediment control devices and by wetting the soil to keep it from blowing.
- 6. The Contractor shall promptly clean up any material excavated within the public right-of-way so that the excavated material is not susceptible to being washed down the street.
- 7. The Contractor shall secure "Topsoil Disturbance Permit" prior to beginning construction.
- Construction within the grassed greenbelt area shall be coordinated with the Journal Center to avoid conflicts with irrigation lines and subsurface erosion control fabrics. Work on the concrete channel and inspection of this work shall be coordinated with AMAFCA (884-2215).

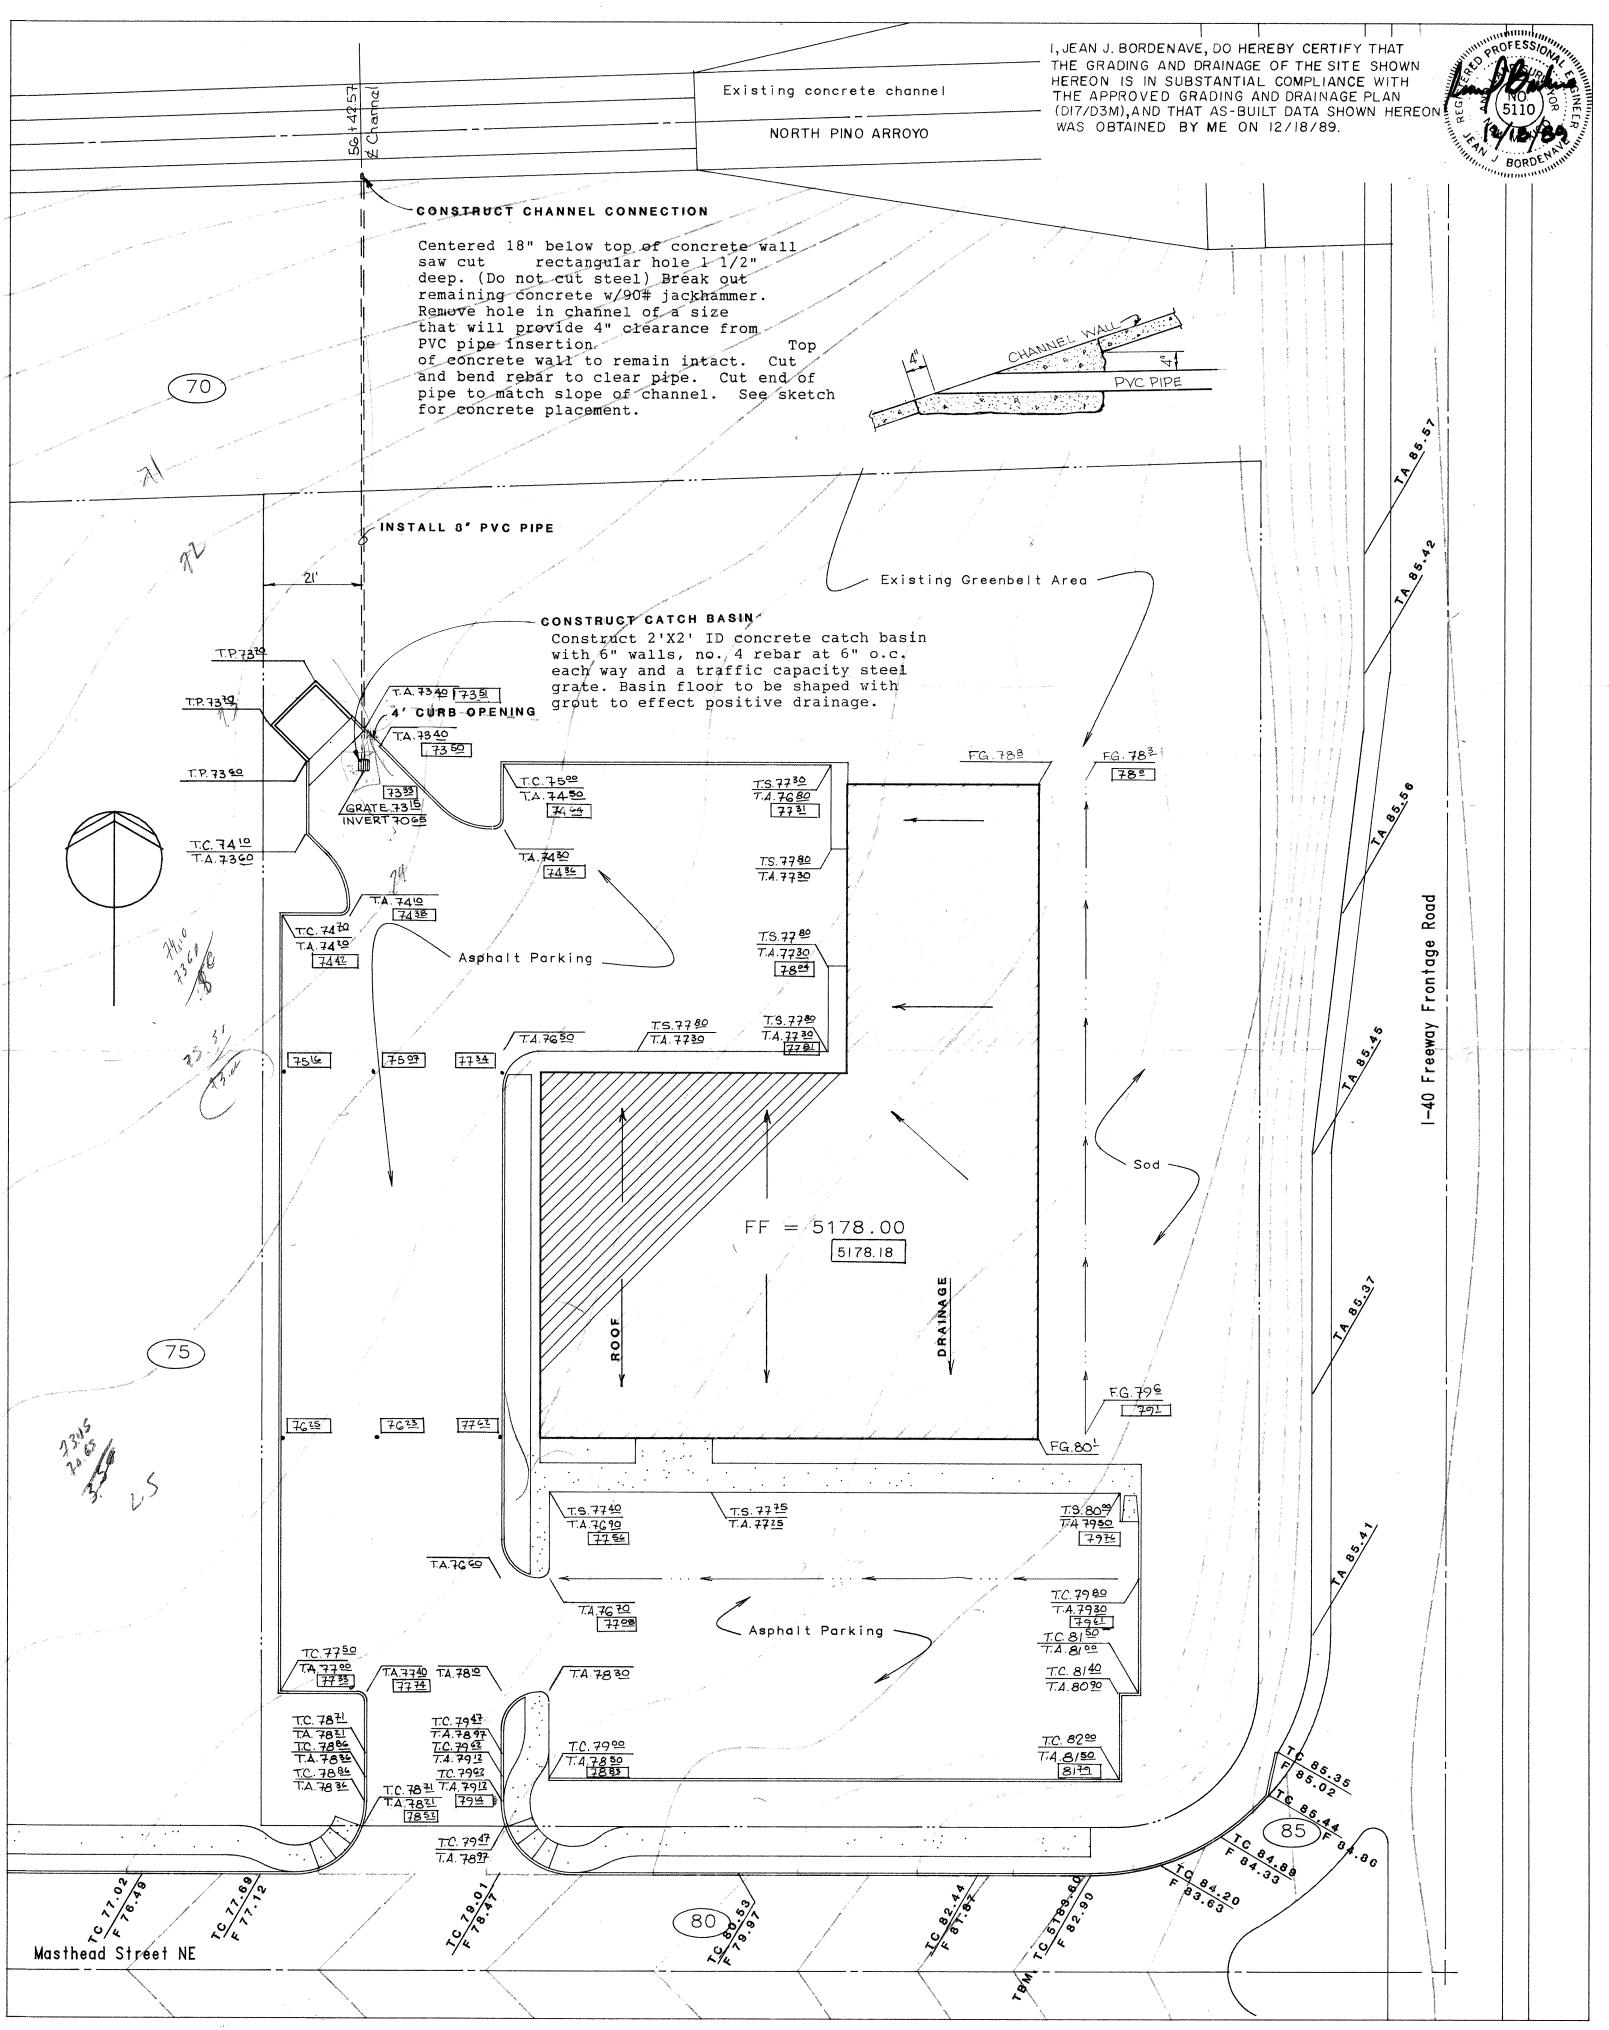

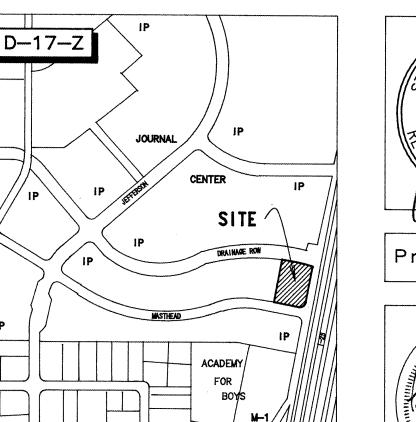

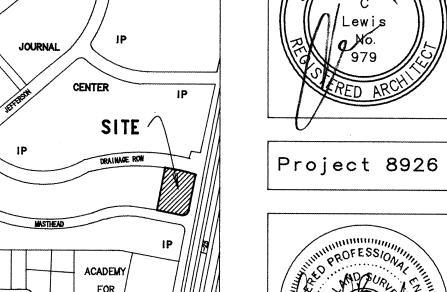

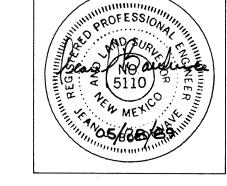

Z


BRAWLEY


SON

WEI

LEWIS

SCHLEGEL

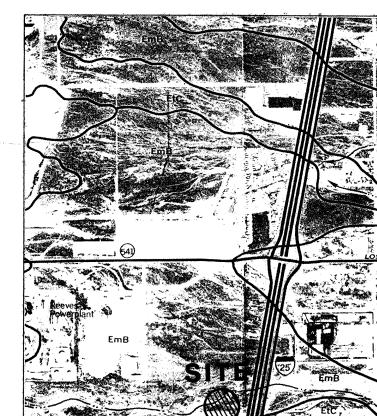

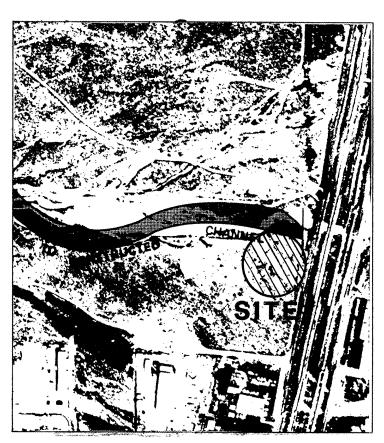

FIRM 350002 0009 C

AS-BUILT ELEVATION FINISHED FLOOR TOP OF CURB FLOWLINE TOP OF ASPHALT TOP OF SIDEWALK TOP OF CONCRETE PAD FINISHED GRADE - - EXISTING CONTOUR ----- FINISHED CONTOUR →··· → SWALE

LEGEND

ACS Monument #1-25-14 Elevation: 5196.73 TEMPORARY BENCH MARK Chiseled SQUARE on top of Curb @ WNW Curb Return of I—25 WFR & Masthead St NE Elevation: 5183.60 LEGAL DESCRIPTION: TRACT 4AA-3B A REPLAT OF TRACT 444.3, JOHNAL CENTER 31 MAY 89 SHEET

OF 10

DEC 1 8 1989

HYDROLOGY SECTION

Z

REVISIONS

1 6/7/89

CONSTRUCTION NOTES

SITE PLAN

1'' = 20' - 0'

NOTES