



# ***City of Albuquerque***

P.O. BOX 1293 ALBUQUERQUE, NEW MEXICO 87103

February 16, 2004

Glenn Broughton, PE  
Bohannon Huston, Inc  
7500 Jefferson NE  
Albuquerque, NM 87109

**Re: Journal Center Tract 1A-2A Storm Drain Extension Plan**  
**Engineer's Stamp not provided, (D17/D3V)**

Dear Mr. Broughton,

Based upon the information provided in your submittal dated 12-31-03, the above referenced plan is approved for Work Order. Any comments can be addressed during DRC.

If you have any questions, you can contact me at 924-3986.

Sincerely,

Bradley L. Bingham, PE  
Principal Engineer, Planning Dept.  
Development and Building Services

C: file



# REVISED DRAINAGE MANAGEMENT PLAN FOR: JOURNAL CENTER

REVISED: NOVEMBER, 1990  
PREPARED BY: BOHANNAN-HUSTON, INC.

The purpose of this revised drainage management plan is to update the plan to reflect the development of Journal Center since the plan was first approved in 1984. Since that time, Journal Center has been replatted, new streets constructed and new businesses have moved in. All new development has conformed to the 1984 plan and individual development plans have been approved by the City. The drainage concepts and basins remain substantially identical to the 1984 drainage management plan.

Additional functions of the updated plan will be to guide engineers in preparing future drainage plans and aiding City review of these future plans. Drainage basins which have been altered slightly have been re-analyzed and are shown in the table below to have no significant nor adverse impact on drainage facilities.

The criteria used for the minor re-analysis performed in this updated plan remained identical to that previously used and approved in the original 1984 plan.

Section 8C of the Drainage Ordinance stipulates that the curb flow line depth shall not exceed 0.5 feet during the 10-year storm in arterial street sections. As the values indicate, this criteria is exceeded at several locations along Jefferson Street.

As provided in Section 6H of the Ordinance, a variance to the requirement outlined in No. 3 is requested for the following reasons:

1. Considerable expense has already been applied to the construction of drainage facilities in the area. The Pino Arroyo Channel and Jefferson Street storm sewer represent an investment of approximately 2 million dollars. Design was guided and approved based upon criteria in effect at the time assuming free discharge from all parcels.
2. The total length of street over which the criteria is exceeded is approximately 3000 feet. This represents a relatively short distance compared to the total length of Jefferson Street running through and south from the project.

BASED ON THE INFORMATION PRESENTED IN THIS PLAN, IT IS PROPOSED THAT A FREE DISCHARGE MANAGEMENT APPROACH BE APPROVED FOR ALL PARCELS WITHIN THE PARK, AND THAT A VARIANCE TO SECTION 8C BE GRANTED FOR THE 10-YEAR FLOW CRITERIA IN JEFFERSON STREET.

The purpose of this plan is to outline drainage patterns, flow rates and facility capacities for the Journal Center Industrial/Commercial Park. The plan also serves to update recommendations made in an October 1980 report entitled *Journal Center Interim Drainage Report* based on current thinking outlined in the Drainage Ordinance and Development Process Manual (DPM).

It is proposed that runoff from sites be allowed to discharge to street rights-of-way or facilities in a free discharge manner. This runoff will be directed to three primary outfalls: the North Pino Arroyo Channel, Jefferson Street storm drain and Los Angeles Blvd. The North Pino Arroyo is concrete lined with grass free board and discharges runoff into the North Division Channel. The Jefferson Street storm drain discharges into the Domingo Baca Arroyo, north of Los Angeles Blvd. Runoff collected in Los Angeles Blvd. discharges into the North Division Channel. The accompanying plan identifies flow directions and the location of the primary outfalls.

Runoff rates and facility capacities are contained in the tables below. Based on this information, three points should be highlighted:

1. Current runoff criteria yields flow rates less than those used in the 1980 report.
2. Approximately 112 cfs will be directed to Los Angeles Blvd. during the 100-year storm. 226 cfs is collected in the storm drain system and conveyed to the Domingo Baca Arroyo. The 112 cfs represents a figure less than the undeveloped flow rate from the site prior to its development.

LOCATION MAP  
ZONE ATLAS D-17-Z

## BASIN HYDROLOGY (Developed Conditions)

| BASIN ID | AREA | DISCHARGES TO  | LONGEST REACH (FT.) | SLOPE (AVERAGE) | TC (MIN.) | INTENSITY (IN/HR.) | Q 100 | Q 100 1980 REPORT |
|----------|------|----------------|---------------------|-----------------|-----------|--------------------|-------|-------------------|
| A**      | 5.4  | Headline       | 1200                | 0.02            | 10.0      | 4.7                | 61    | 95                |
| B-1**    | 18.0 | Jefferson      | 1650                |                 | 10.0      | 4.7                | 68    | N/A               |
| C        | 27.6 | Diversion Berm | 1200                |                 | 10.0      | 4.7                | 102   | 112               |
| D-1      | 14.3 | Tiburon        | 1000                |                 | 10.0      | 4.7                | 54    | N/A               |
| E-1      | 13.1 | Jefferson      | 1100                |                 | 10.0      | 4.7                | 49    | N/A               |
| F        | 19.6 | Pino Arroyo    | 1250                |                 | 10.4      | 4.6                | 72    | 73                |
| G        | 22.5 | Pino Arroyo    | 1250                |                 | 10.4      | 4.6                | 83    | 84                |
| GST      | 3.0  | Jefferson      | 500                 |                 | 10.0      | 4.7                | 12    | 12                |
| H-1      | 29.1 | Tiburon        | 1600                |                 | 10.0      | 4.7                | 109   | N/A               |
| I        | 5.2  | Pino Arroyo    | 450                 |                 | 10.0      | 4.7                | 20    | 21                |
| J        | 4.6  | Pino Arroyo    | 450                 |                 | 10.0      | 4.7                | 17    | 19                |
| JST      | 0.6  | Masthead       | 1000                |                 | 10.0      | 4.7                | 3     | 2                 |
| K        | 15.6 | Pino Arroyo    | 1200                |                 | 10.0      | 4.7                | 59    | 53                |
| KST      | 1.3  | Masthead       | 1300                |                 | 10.0      | 4.7                | 5     | 5                 |
| L        | 15.4 | Pino Arroyo    | 1200                |                 | 10.0      | 4.7                | 58    | 64                |
| LST      | 1.4  | Masthead       | 1200                |                 | 10.0      | 4.7                | 5     | 6                 |
| M        | 25.5 | Masthead       | 1200                |                 | 10.0      | 4.7                | 96    | 87                |
| N        | 13.0 | Masthead       | 1200                |                 | 10.0      | 4.7                | 49    | 51                |
| NCH      | 3.4  | Masthead       | 650                 |                 | 10.0      | 4.7                | 13    | 14                |
| O        | 5.3  | Snaproll       | 650                 | 0.02            | 10.0      | 4.7                | 20    | 22                |
| A-1**    | 19.6 | Headline       | N/A                 | N/A             | N/A       | N/A                | 85    | N/A               |


## STREET & STORM SEWER HYDRAULICS

| AP | CONTRIBUTING BASIN(S)        | 10-YEAR STORM (all values cfs) |                                  |                    |                |            | 100-YEAR STORM (all values cfs) |                 |             |                |            | COMMENTS                                        |
|----|------------------------------|--------------------------------|----------------------------------|--------------------|----------------|------------|---------------------------------|-----------------|-------------|----------------|------------|-------------------------------------------------|
|    |                              | Q                              | STREET CAPACITY                  | SEWER(SS) CAPACITY | FLOW IN STREET | FLOW IN SS | Q                               | STREET CAPACITY | SS CAPACITY | FLOW IN STREET | FLOW IN SS |                                                 |
| 1  | A, OF-1                      | 64                             | 112                              | N.A                | 64             | N.A        | 98                              | 112             | N.A         | 98             | N.A        | Street has adequate capacity                    |
| 2  | B-1                          | 45                             | 18-East half of street           | N.A                | 45             | N.A.       | 68                              | 200             | N.A         | 45             | N.A.       | 10 year street capacity exceeded                |
| 3  | OF-1, A, B-1                 | 109                            | 36-Full street section (30" RCP) | 59                 | 69             | 40 *       | 166                             | 200             | 59          | 126            | 40         | " " "                                           |
| 4  | OF-1, AB-1, Street           | 115                            | 30-Full street section           | 59                 | 73             | 40         | 176                             | 170             | 59          | 136            | 40         | " " "                                           |
| 5  | D-1                          | 35                             | 100                              | 107 (48" RCP)      | 0              | 35         | 54                              | 100             | 107         | 0              | 54         | Basin D-1 runoff collected in Triple "C" inlets |
| 6  | C                            | 67                             | N.A                              | 120 (48" RCP)      | N.A            | 67         | 102                             | N.A             | 120         | N.A.           | 102        | Basin C runoff collected in 48" RCP inlet.      |
| 7  | Street, OF-1, A, B-1, C, D-1 | 211                            | 36 (72" RCP)                     | 64                 | 147            | 321        | 180                             | 232             | 96          | 226            |            | 90 cfs discharged to Paseo del Norte.           |
| 8  | E-1                          | 32                             | 9-East half of street            | N.A.               | 32             | N.A.       | 49                              | 104             | N.A.        | 49             | N.A.       | 10 year street capacity exceeded                |
| 9  | E-1, Street                  | 46                             | 25-East half of street           | 83 (36" RCP)       | 0              | 46         | 69                              | 200             | 83          | 0              | 69         | 74 cfs collected by inlets                      |
| 10 | H-1                          | 72                             | N.A                              | 10 (42" RCP)       | N.A            | 72         | 109                             | N.A             | 10          | N.A            | 109        | Runoff conveyed to Pino Arroyo                  |
| 11 | Gst, Jst                     | 10                             | 160                              | N.A.               | 10             | N.A.       | 15                              | 160             | N.A         | 10             | N.A        | " " "                                           |
| 12 | API1, Kst, M                 | 76                             | N.A.                             | N.A.               | 76             | N.A.       | 116                             | 130             | N.A         | 116            | N.A        | " " "                                           |
| 13 | AP2, N                       | 108                            | N.A.                             | N.A                | 108            | N.A.       | 165                             | 160             | N.A         | 165            | N.A        | " " "                                           |
| 14 | API3, NCH                    | 117                            | N.A.                             | N.A.               | N.A.           | N.A.       | 178                             | N.A.            | N.A         | N.A            | N.A        | Runoff collected in concrete rundowns           |
| 15 | A, OFFSITE                   | N.A.                           | N.A.                             | N.A.               | N.A.           | N.A.       | 43.1                            | 64.7            | N.A.        | 43.1           | N.A.       |                                                 |

N/A - Not Applicable  
\* - See Note #6  
\*\* - Using 1994 DPM Hydrology criteria to calculate flows

## NOTES

1. Basin Hydrology based on DPM Criteria, Chapter 22 (DPM Edition, 1984).
  - a. Tc - Plate 22.2 13-1 (10 minute minimum)
  - b. Intensity - Plate 22.2 D-2
  - c. 'C' for 85% Impervious = 0.80
  - d. Plate 22.2 C-1
  - e. 100 year rainfall = 2.2 in. - Plate 22.2 D-1
2. Street capacities determined using DPM Criteria, Chapter 22, Plates 22.3 D-1 thru 22.3 D-4 (DPM Edition, 1984).
3. Storm sewer sized to operate under pressure flow - Plate 22.3 B-5.
4.  $Q_{10} = 0.657(Q_{100})$  - Plate 22.2 D-1 (DPM Edition, 1984).
5. Jefferson Street classified as min. arterial - 10 year street capacities based on 0.5' at curb flowline.
6. Double 'B' and 'C' inlets assumed to collect an average of 10cfs during 100-year flow.
7. The south half (max.) of these lots may drain to Masthead Street as necessary.
8. The drainage basin for this 37 cfs (100-year storm) discharge is located east of and within the right-of-way of I-25. Calculations for this discharge can be found under City Drainage File D-17/030. Handling of this 37 cfs discharge will occur as follows:
  - a. Interim (undeveloped Basin A and B-1) Plan - As shown, flow is discharged to the surface and will drain by overland flow to Headline Road.
  - b. Ultimate Plan - With the development of Basins A and B-1, the flow will be carried by surface facilities or underground storm drains to the Domingo Baca Arroyo or to Headline Road. This extension of drainage facilities may be performed in phases, i.e., each development will construct only its required portion of the facility, in accordance with the Drainage Ordinance and approved site-specific drainage plans.
9. The 37 cfs (100-year) offsite flow is labeled OF-1. The 10-year storm value is 24 cfs.
10. The high point in Headline Blvd. is located at the Lang Ave. intersection. This condition will cause a flow split. Approximately 37 cfs is assumed to flow north on Headline Blvd.

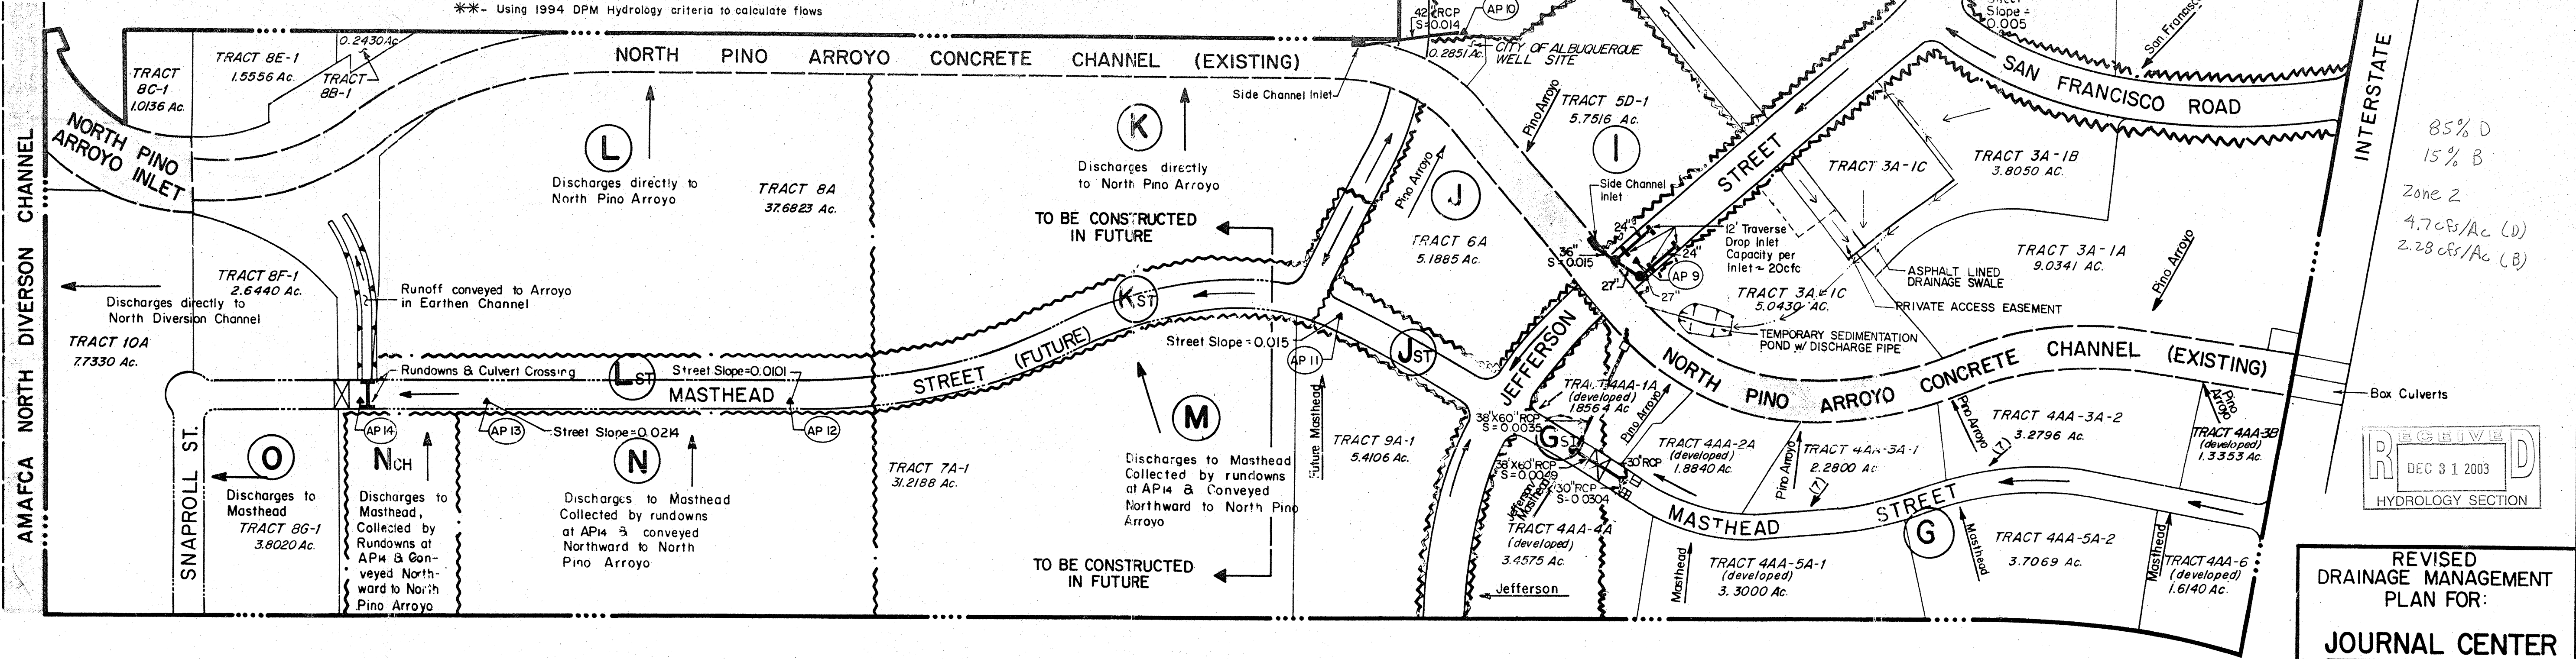

## LEGEND

- PROPERTY LINE
- BASIN DIVIDE
- WATER BLOCK
- DOUBLE 'B' INLET
- DOUBLE 'C' INLET
- DOUBLE 'D' INLET
- TRIPLE 'C' INLET
- STORM SEWER & MANHOLE
- MAJOR FLOW DIRECTION & DISCHARGE LOCATION
- ANALYSIS POINT
- DEVELOPED TRACTS ARE NOTED AS SUCH


REVISED DRAINAGE MANAGEMENT PLAN FOR: JOURNAL CENTER

DECEMBER 1992

ORIGINAL PLAN JULY 1984  
REVISION NO. 4 NOVEMBER 1990  
REVISION NO. 5 DECEMBER 1992





JOB No. 9011001



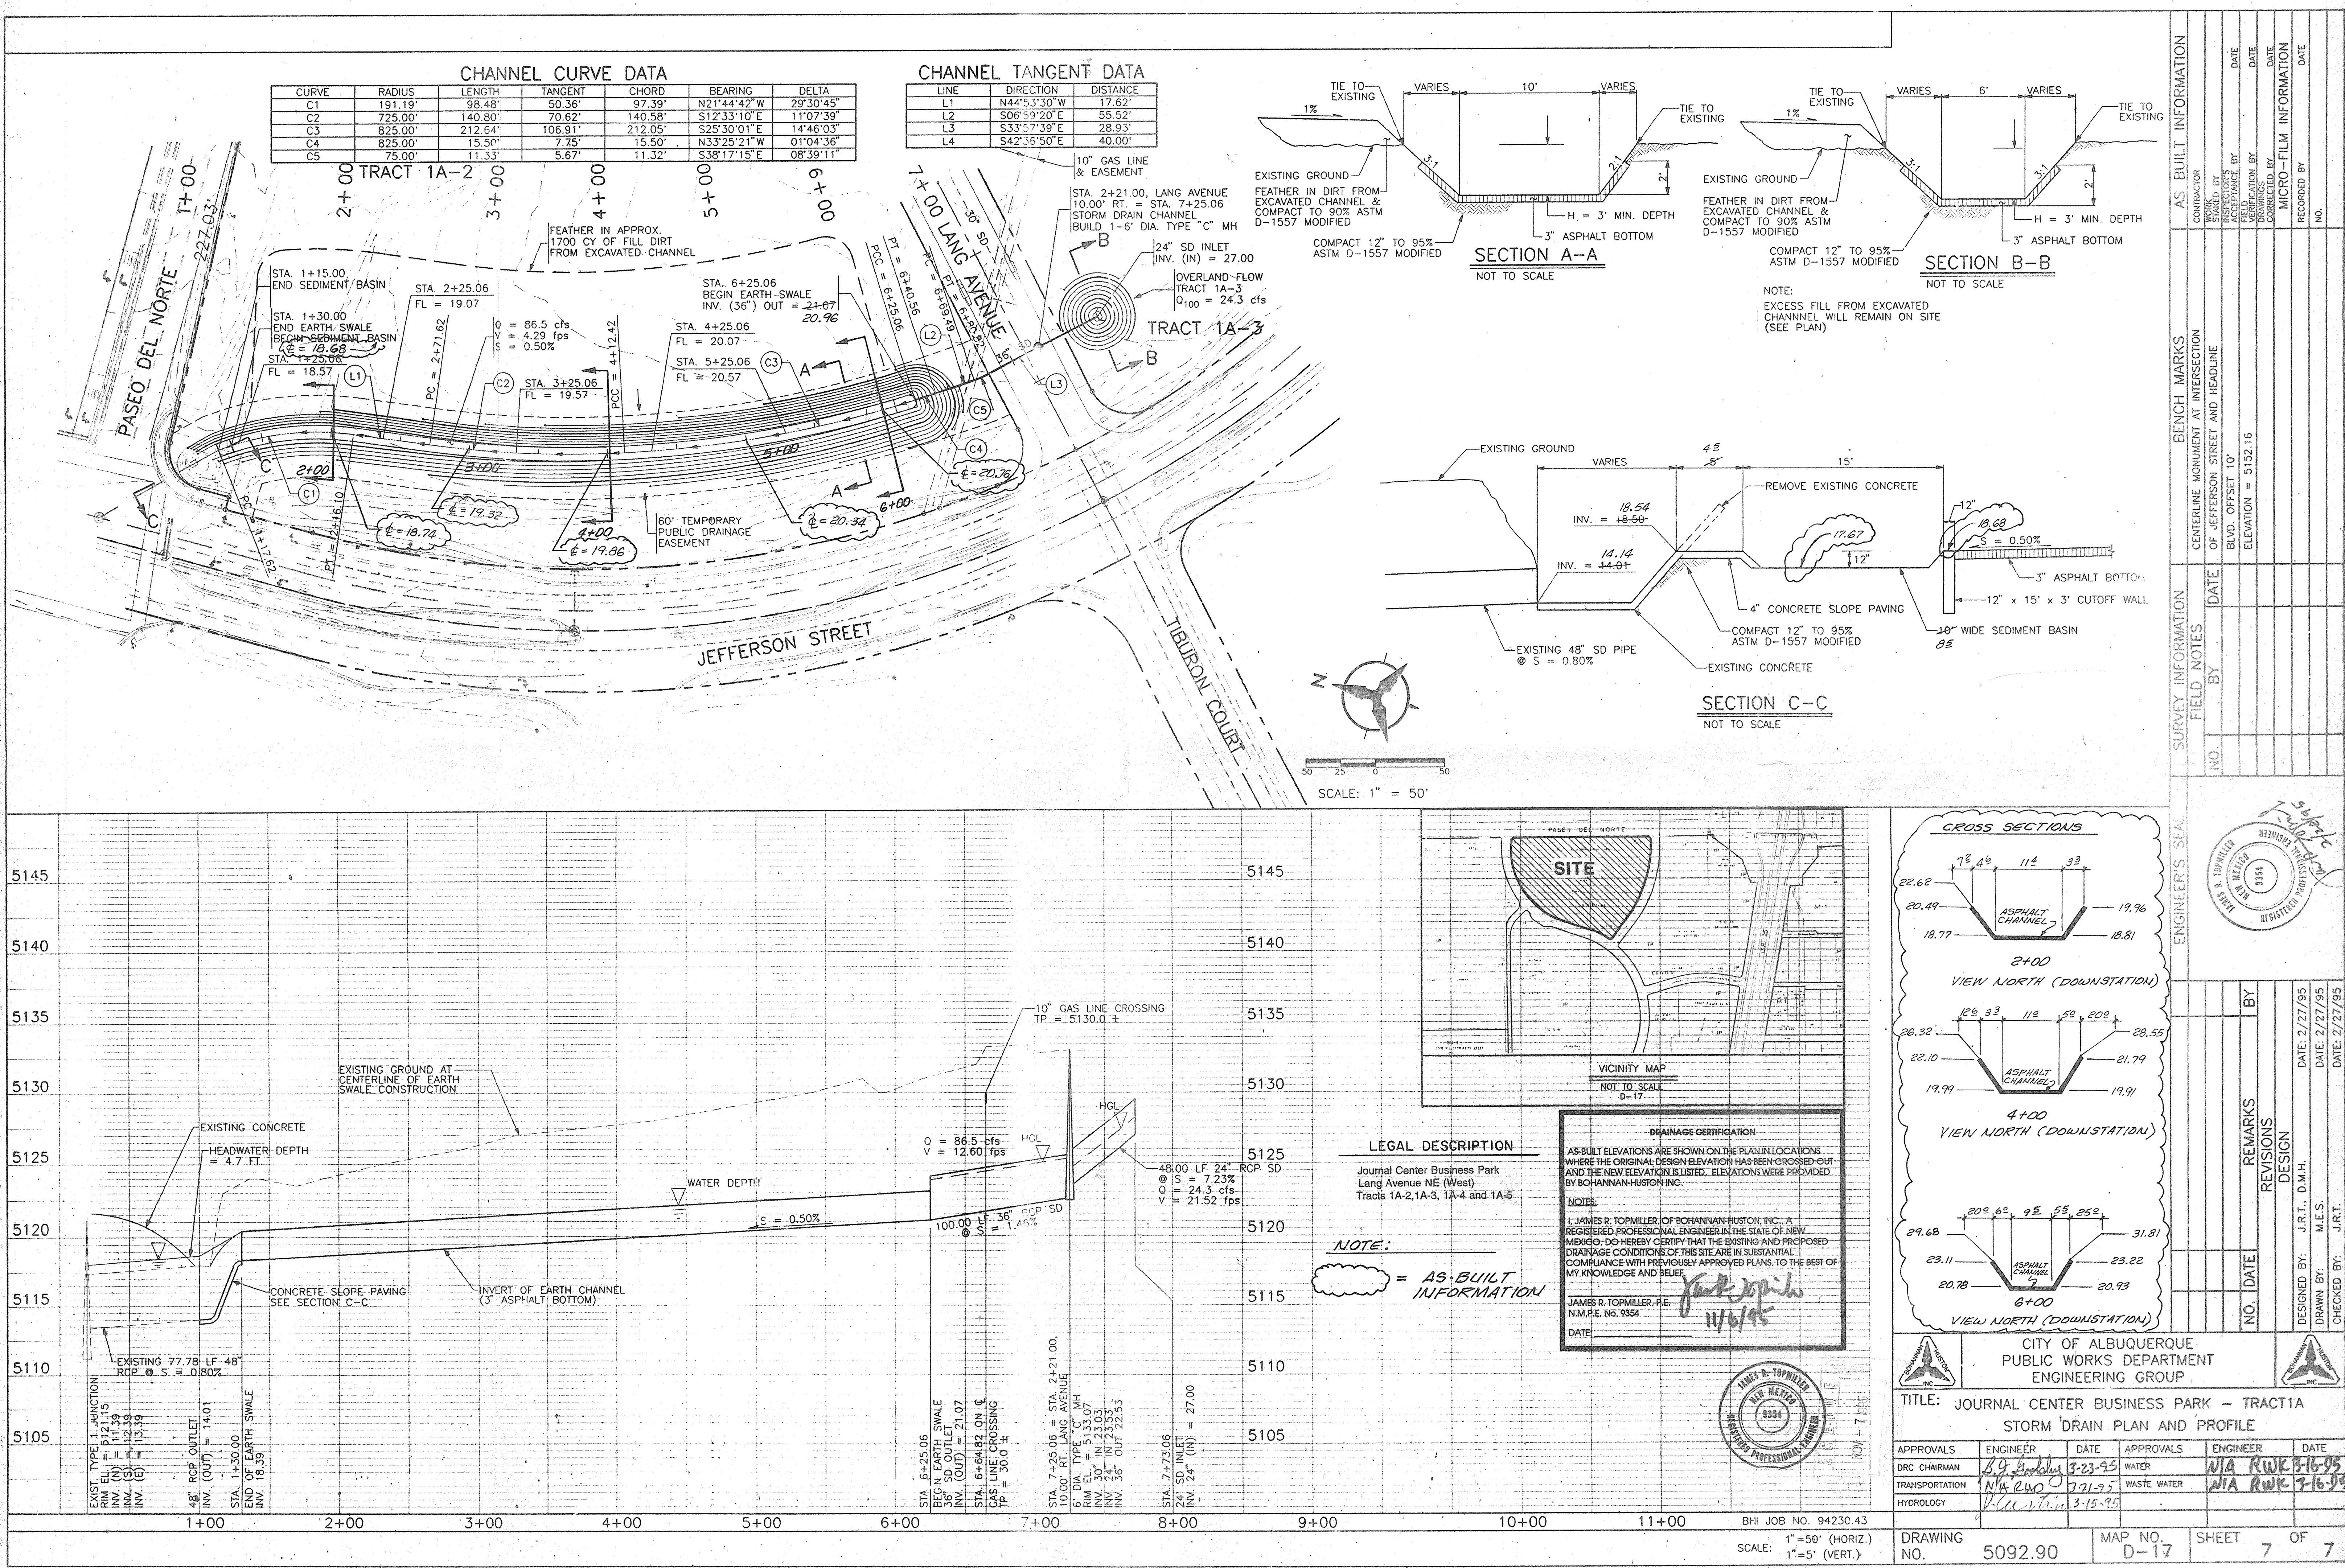

| CHANNEL CURVE DATA |         |         |         |         |             |           |
|--------------------|---------|---------|---------|---------|-------------|-----------|
| CURVE              | RADIUS  | LENGTH  | TANGENT | CHORD   | BEARING     | DELTA     |
| C1                 | 191.19' | 98.48'  | 50.36'  | 97.39'  | N21°44'42"W | 29°30'45" |
| C2                 | 725.00' | 140.80' | 70.62'  | 140.58' | S12°33'10"E | 11°07'39" |
| C3                 | 825.00' | 212.64' | 106.91' | 212.05' | S25°30'01"E | 14°46'03" |
| C4                 | 825.00' | 15.50'  | 7.75'   | 15.50'  | N33°25'21"W | 01°04'36" |
| C5                 | 75.00'  | 11.33'  | 5.67'   | 11.32'  | S38°17'15"E | 08°39'11" |

| CHANNEL TANGENT DATA |             |          |
|----------------------|-------------|----------|
| LINE                 | DIRECTION   | DISTANCE |
| L1                   | N44°53'30"W | 17.62'   |
| L2                   | S06°59'20"E | 55.52'   |
| L3                   | S33°57'39"E | 28.93'   |
| L4                   | S42°36'50"E | 40.00'   |

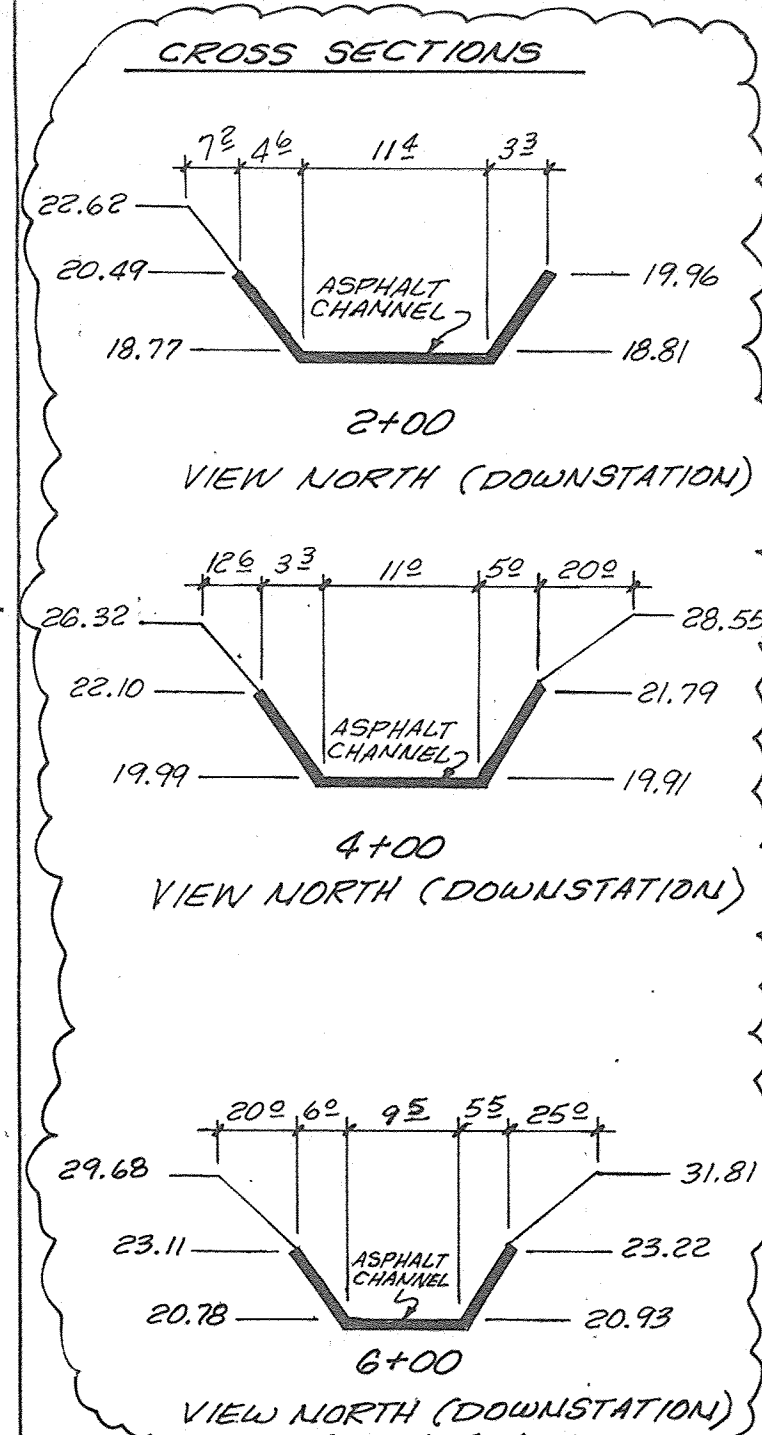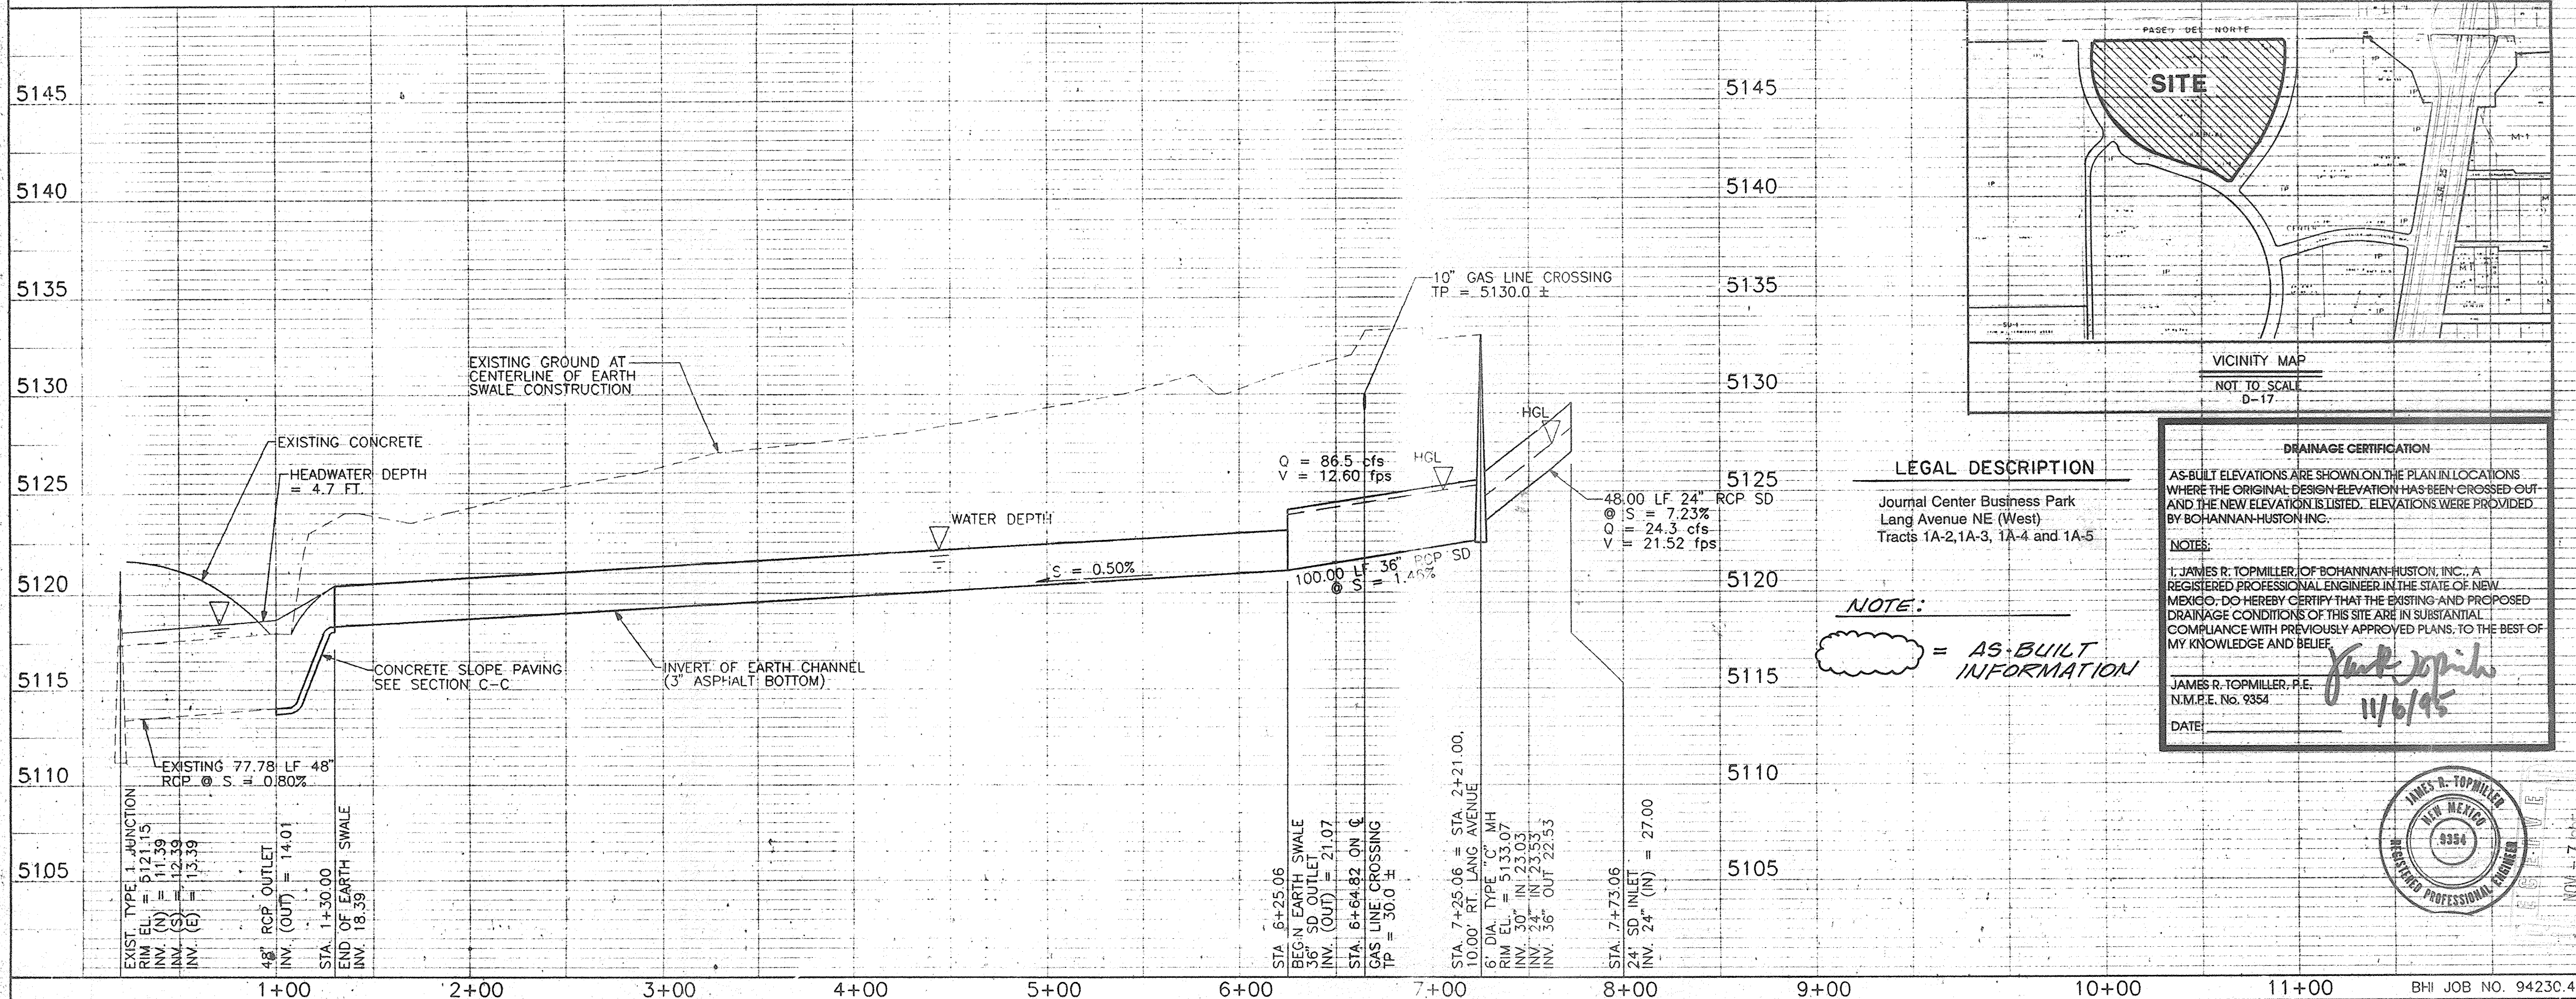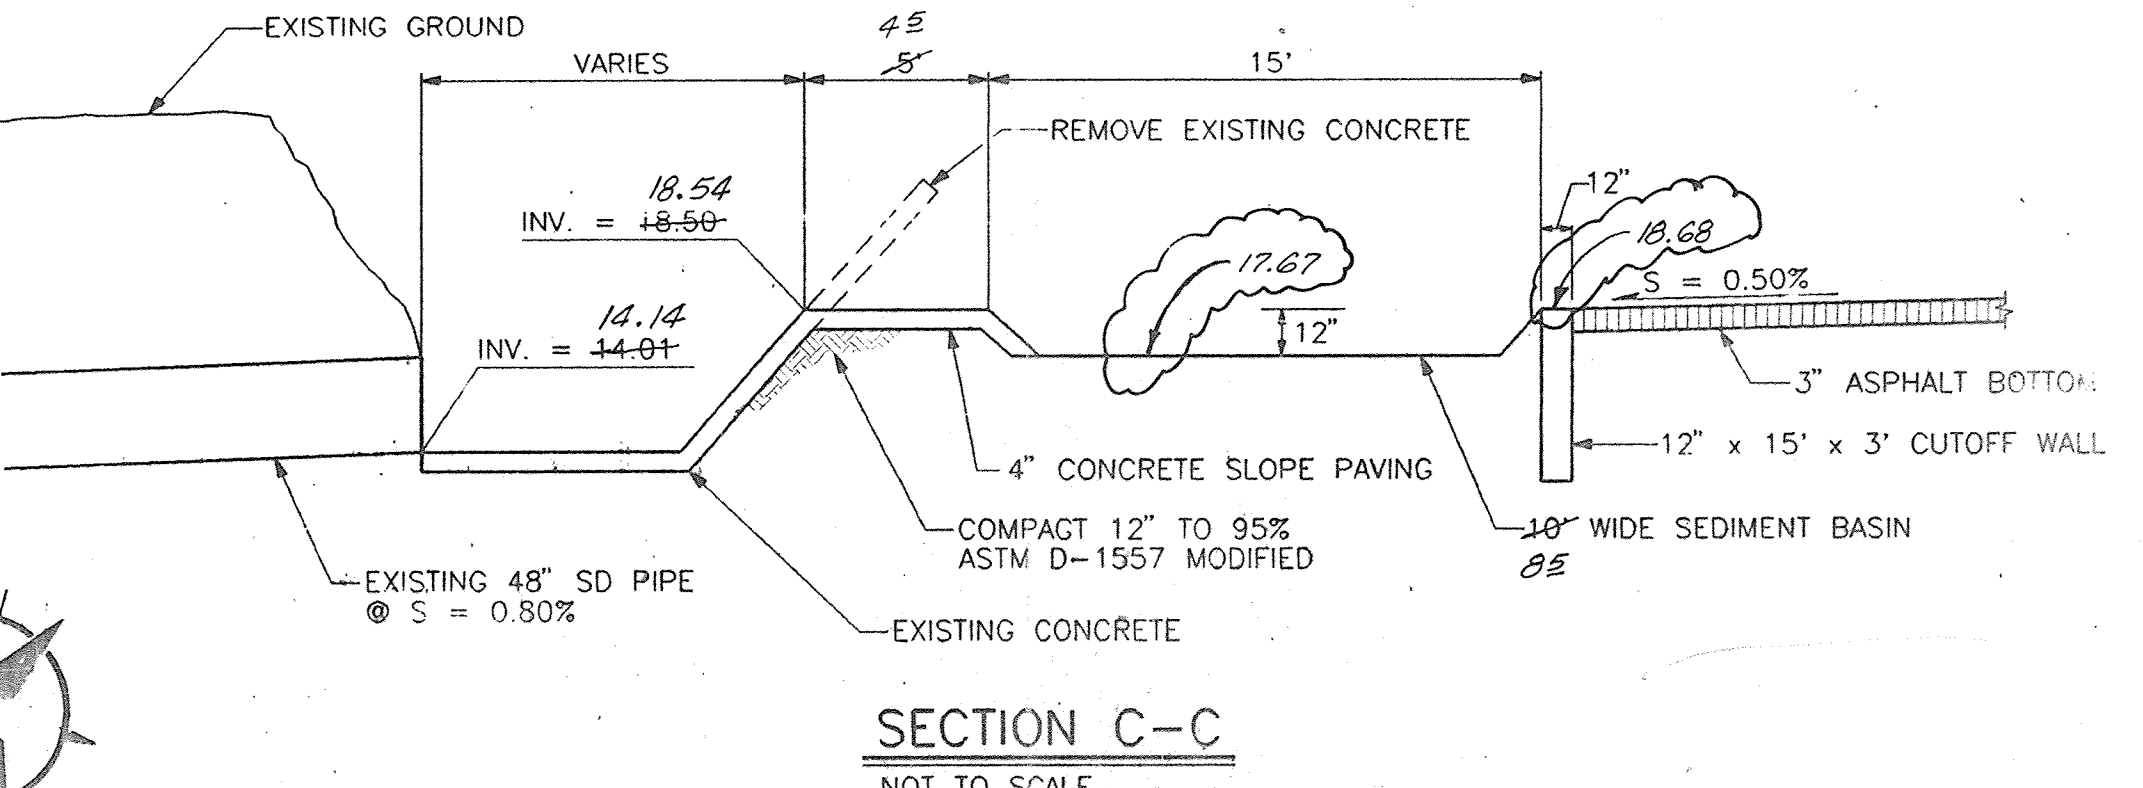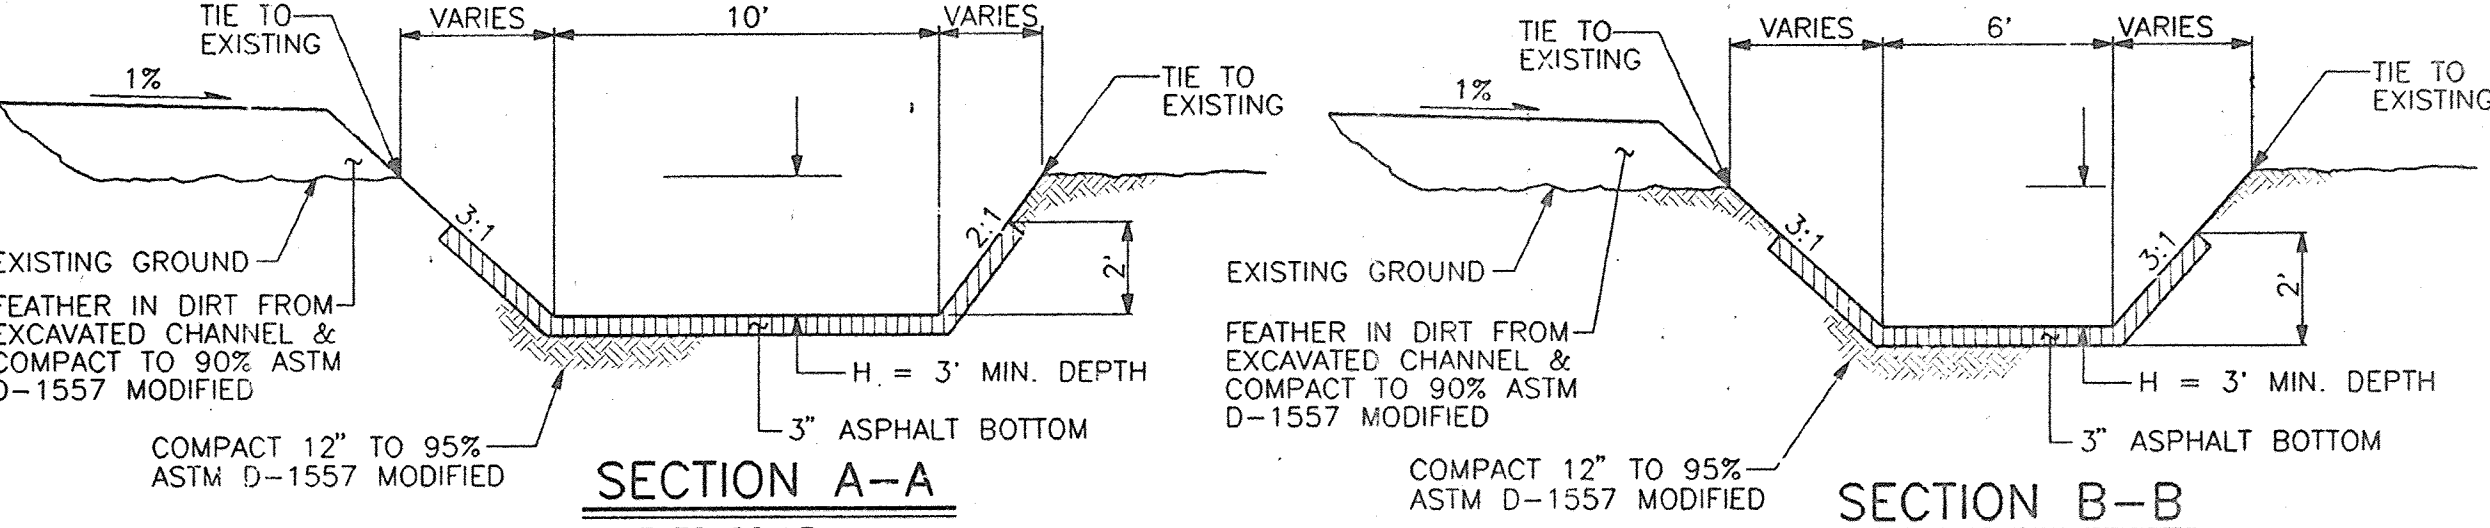

**LEGAL DESCRIPTION**  
Journal Center Business Park  
Lang Avenue NE (West)  
Tracts 1A-2, 1A-3, 1A-4 and 1A-5

**NOTE:**  
= AS-BUILT INFORMATION

**DRAINAGE CERTIFICATION**  
AS-BUILT ELEVATIONS ARE SHOWN ON THE PLAN IN LOCATIONS WHERE THE ORIGINAL DESIGN ELEVATION HAS BEEN CROSSED OUT AND THE NEW ELEVATION IS LISTED. ELEVATIONS WERE PROVIDED BY BOHANNAN-HUSTON INC.

**NOTES:**  
1. JAMES R. TOPMILLER OF BOHANNAN-HUSTON, INC., A REGISTERED PROFESSIONAL ENGINEER IN THE STATE OF NEW MEXICO, DO HEREBY CERTIFY THAT THE EXISTING AND PROPOSED DRAINAGE CONDITIONS OF THIS SITE ARE IN SUBSTANTIAL COMPLIANCE WITH PREVIOUSLY APPROVED PLANS, TO THE BEST OF MY KNOWLEDGE AND BELIEF.

JAMES R. TOPMILLER, P.E.  
N.M.P.E. No. 9354  
DATE: 11/6/95

| CITY OF ALBUQUERQUE<br>PUBLIC WORKS DEPARTMENT<br>ENGINEERING GROUP         |             |         |             |          |         |
|-----------------------------------------------------------------------------|-------------|---------|-------------|----------|---------|
| TITLE: JOURNAL CENTER BUSINESS PARK - TRACT 1A STORM DRAIN PLAN AND PROFILE |             |         |             |          |         |
| APPROVALS                                                                   | ENGINEER    | DATE    | APPROVALS   | ENGINEER | DATE    |
| DRC CHAIRMAN                                                                | B.G. Boudry | 3-23-95 | WATER       | NIA RWK  | 3-16-95 |
| TRANSPORTATION                                                              | NIA RWK     | 7-21-95 | WASTE WATER | NIA RWK  | 7-16-95 |
| HYDROLOGY                                                                   | NIA RWK     | 3-15-95 |             |          |         |
| DRAWING NO.                                                                 | 5092.90     | MAP NO. | D-17        | SHEET    | 7 OF 7  |