


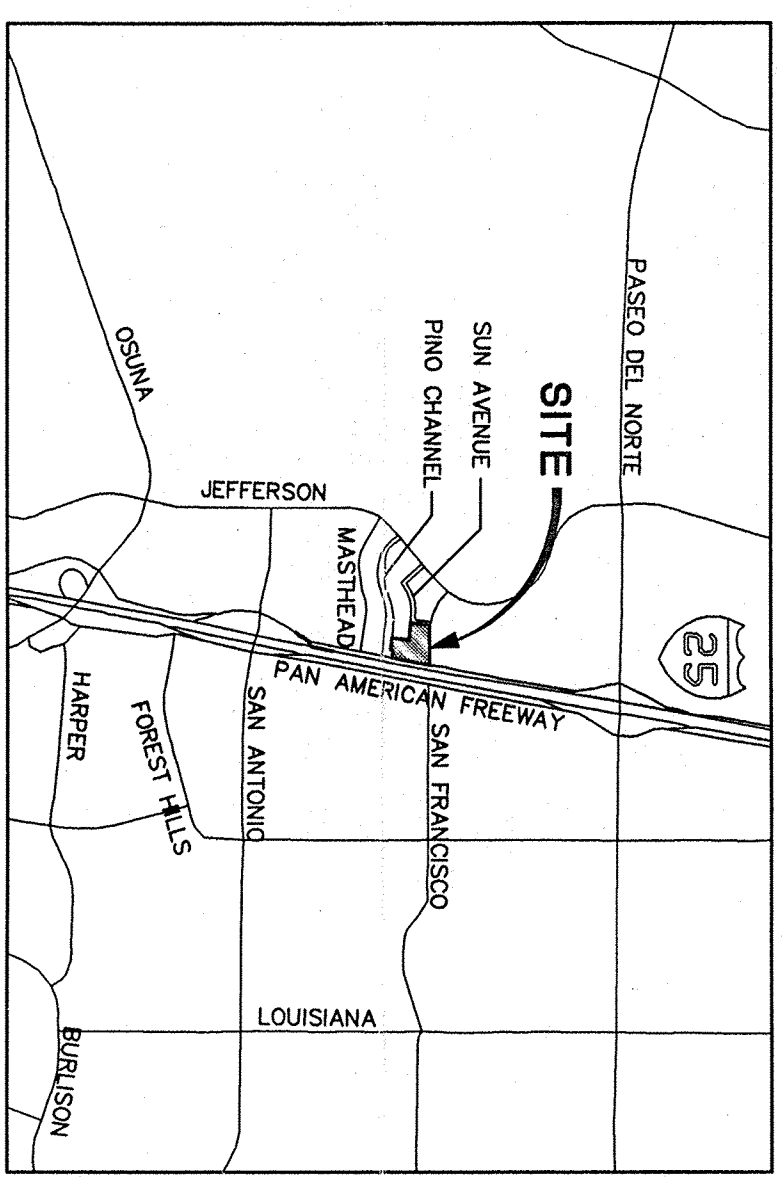

LEGEND

- EXISTING SPOT ELEVATION
- PROPOSED SPOT ELEVATION
- BRAKED DIRECTION
- EXISTING SURFACE
- WATER DITCH
- EXISTING INLET
- PROPOSED CONCRETE PAVING, SEE ALSO PLANS & DETAILS
- ▢
- ▣
- ▤
- ▥
- ▦
- ▧
- ▨
- ▩
-
-
- ▬ TOP OF PAVEMENT
- ▭ TOP OF CURB
- ▮ FINISHED SURFACE
- ▯ FINISHED SHOULDER
- ▰ TOP OF GRADE
- ▱ INVERT
- ▲ TOP OF WALL
- △ BOTTOM OF WALL
- ▴ RETAINING WALL
- ▵ AS-BUILT SPOT ELEVATION

EXISTING

DATE 12/12/00

by JAMES R. MILLER, P.E.

REGISTERED PROFESSIONAL ENGINEER
NEW MEXICO
3334

ACCEPTANCE:
DRAINAGE CERTIFICATION
I, JAMES R. TOPILNER, OF BOHANNAN-HUSTON, INC. N.A.I.P.E. # 9354 DO HEREBY CERTIFY THAT THE EXISTING AND PROPOSED DRAINAGE CONDITIONS OF THIS SITE ARE IN SUBSTANTIAL COMPLIANCE WITH THIS APPROVED GRADING AND DRAINAGE PLAN, TO THE BEST OF MY KNOWLEDGE AND BELIEF, AS BUILT ELEVATIONS WERE VERIFIED BY BOHANNAN-HUSTON INC. THIS STATEMENT DOES NOT PRESENT CERTIFICATION OF CONTRACTORS METHODS OR MATERIALS.

BENCHMARK

THE STATION IS THE CENTERLINE MONUMENT
AT THE INTERSECTION OF ELLERSON ROAD
AND SAN FRANCISCO ROAD

ELEVATION = 5160.47

NOT SHOWN IN DRAWING

BRUSH WITH THE ADJACENT SLOPE SHALL BE MAINTAINED.
THE LOCATION SHOWN ON THE PLAN, DURING CONSTRUCTION,

EROSION CONTROL BERM

NTS

The diagram shows a cross-section of an erosion control berm. A dashed line represents the centerline of the road. On either side of the centerline, there are two sloped sections labeled '1' and '2'. The top width of the berm is indicated as 12'". An arrow points from the text 'EXISTING GROUND' to the right-hand slope. Below the berm, there is a horizontal dimension line labeled 12'". To the left of the main cross-section, there is a smaller inset showing a rectangular structure with a height dimension of 12'".

• HIGH DENSITY POLYETHYLENE PER HANCOR HI-Q SPECIFICATION OR ENGINEER'S APPROVED EQUIV. • SDR 35, PVC (FOR STORM DRAIN PIPE 12" DIA. AND SMALLER) • RCP CLASS III	<u>ACCEPTABLE MATERIALS FOR STORM DRAIN</u>
<i>Fanning · Bard · Tatum</i> ARCHITECTS · AIA · L.T.D. 6100 Indian School Road NE Albuquerque, New Mexico 87110 Suite 210 505-883-5220	Sun Healthcare Group, Inc. PHASE IV WORLD HEADQUARTERS BUILDING AND PARKING GARAGE BIL MATHESON ALBUQUERQUE, NEW MEXICO
FINAL DRAINAGE/GRADING PLAN FOR PHASE 4	Sheet Project

DATE	SEPTEMBER 1998	00	01	1	(2)	NON			
------	----------------	----	----	---	-----	-----	--	--	--