



LEGEND

- | | |
|--|---|
| <p>--- SIDEWALK, CURB AND GUTTER (EXISTING, PROPOSED)</p> <p>--- PROPOSED PAVED DRIVE</p> <p>--- BUILDING (EXISTING, PROPOSED)</p> <p>--- PROPERTY LINE</p> <p>+ 65.7 EXISTING SPOT ELEVATION</p> <p>20 EXISTING CONTOUR</p> <p>75.2 PROPOSED SPOT ELEVATION</p> <p>30 PROPOSED CONTOUR</p> <p>--- SURFACE FLOW DIRECTION (EXISTING, PROPOSED, ROOF)</p> | <p>LA LANDSCAPED AREA</p> <p>TGW TOP OF GRADE WALL (< 18" HIGH)</p> <p>TRW TOP OF RETAINING WALL (> 18" HIGH)</p> <p>TA TOP OF ASPHALT</p> <p>TC TOP OF CURB</p> <p>FL FLOW LINE</p> <p>FF FINISHED FLOOR</p> <p>R/W RIGHT OF WAY</p> <p>PL PROPERTY LINE</p> <p>PP POWER POLE</p> <p>▲ ENTRY / EXIT LOCATION</p> <p>X 5172.35 BOC BACK OF CURB ELEVATION</p> |
|--|---|

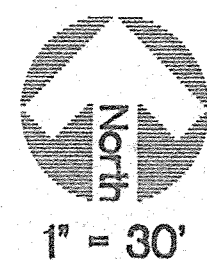

1" = 30'

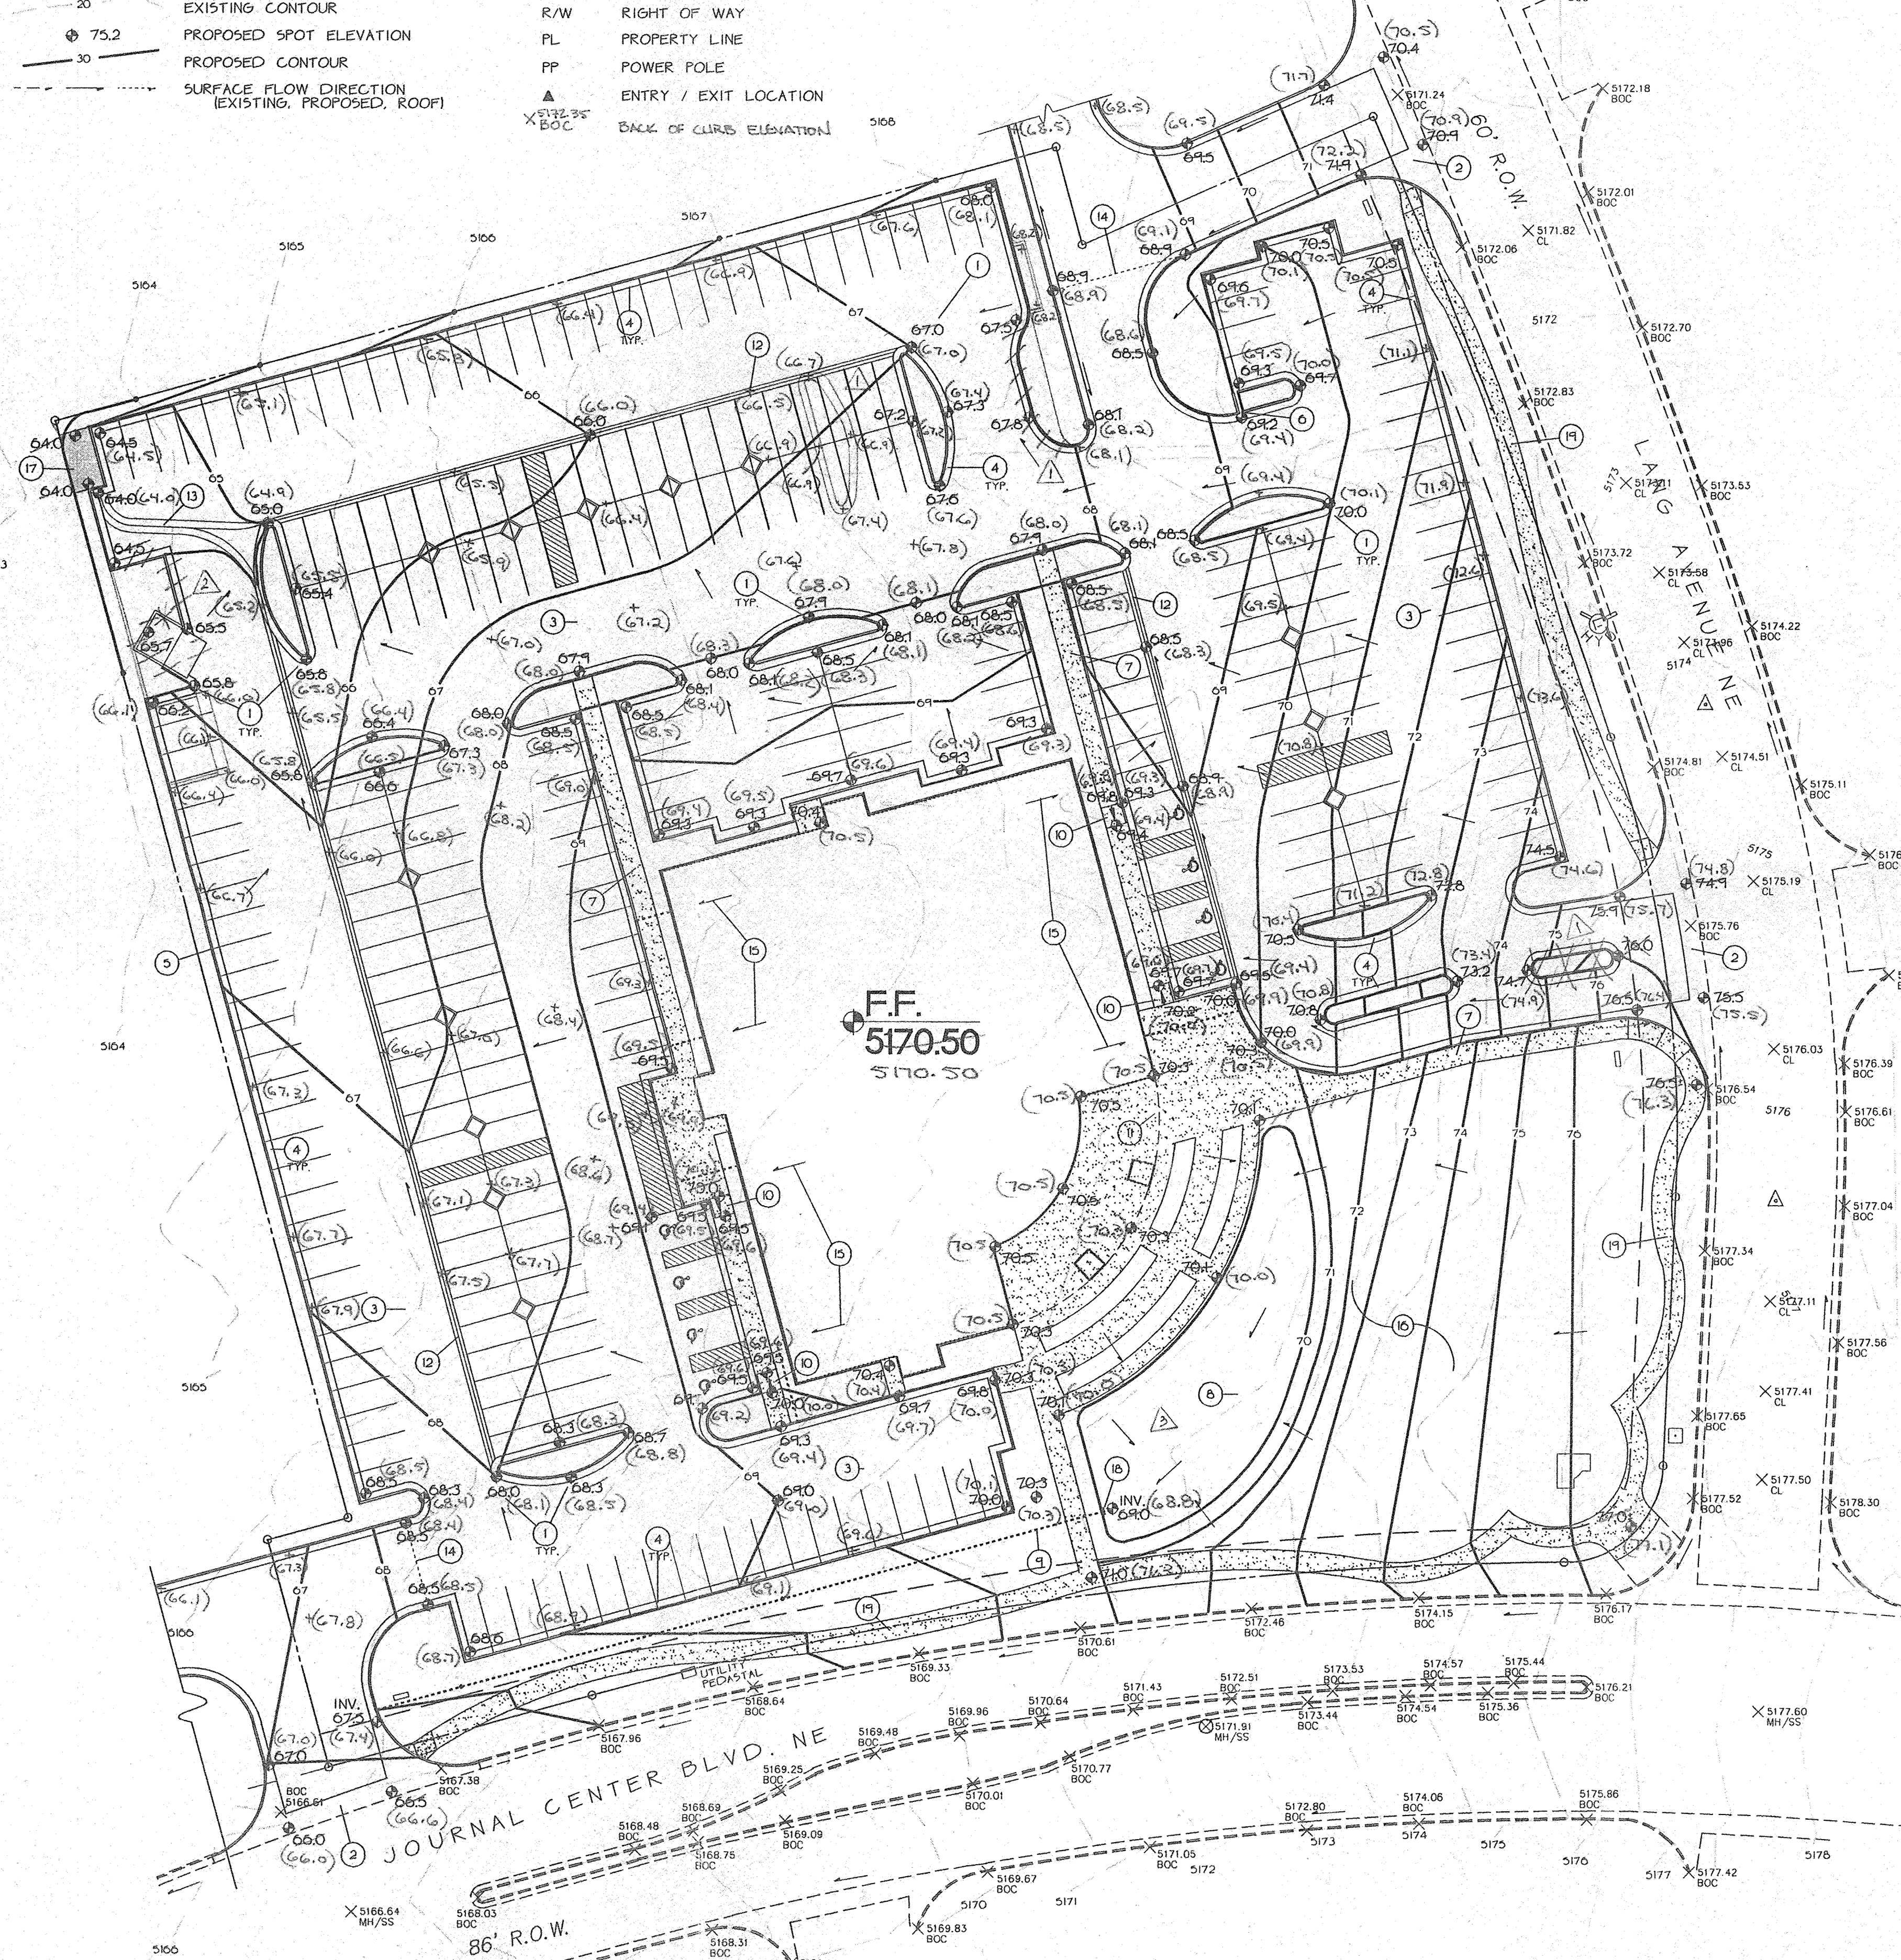

DRAINAGE / GRADING PLAN
SCALE: 1"=30'

CALCULATIONS:	
Calculations are based on the Drainage Design Criteria for City of Albuquerque, Section 27-2, DPM, Vol. 2, dated Jan., 1993	
ON-SITE	
AREA OF SITE:	173713 SF 3.988 Ac.
DEVELOPED FLOWS:	
On-Site Developed Land Condition	
Area a =	0 SF
Area b =	40275 SF
Area c =	0 SF
Area d =	133438 SF
Total Area =	173713 SF

On-Site Weighted Excess Precipitation (100-Year, 6-Hour Storm)

Weighted E = $\frac{Ea + E_b + E_c + E_d}{Aa + Ab + Ac + Ad}$

Developed E = 1.81 in.

On-Site Volume of Runoff: V360 = $E \cdot A / 12$

Developed V360 = 26192 CF

On-Site Peak Discharge Rate: $Qp = Qpa + Qpb + Qpc + Qpd + Qpe$

For Precipitation Zone = 2

Qpa = 1.56 Qpb = 2.28 Qpc = 3.14 Qpd = 4.70

Developed Qp = 16.5 CFS

The Drainage Management Plan for Journal Center prepared by Bohannon-Huston, Inc. (dated 12-17-92) has established free discharge of developed basins to adjoining streets, with Jefferson Street being the final intercepter for routing flows to the existing Storm Sewer (SS) system. Because the free discharge rates established for each basin are based on pre-1993 design criteria, a portion of the final developed site flows will leave the site at the northwest corner and drain across the adjoining undeveloped tract to Jefferson Ave. A drainage easement for the adjoining site will be required. The ponding area, located near the southeast corner of the property will detain the excess flows which will be released at the southwest drive entrance through a 4" pvc bleeder pipe. Based on the revised Drainage Management Plan for Journal Center this property is located partially in Basin A and partially in basin B-1. In this case, allowable basin discharge is 3.77 cfs per acre.

AREA OF SITE:	Area of Site	cfs / acre	Allowable Discharge
Allowable Discharge =	3.99 ac.	3.77 cfs	15.0 cfs

SOUTHEAST LANDSCAPE AREA TO DETERMINE PONDING CAPACITY

From field inspection and FEMA contour map analysis:

Area of basin flows = 25029 SF

The following calculations are based on Treatment areas as shown in table to the right:

Off-Site Weighted Excess Precipitation (see formula above)	
Weighted E =	1.05 in.
Off-Site Volume of Runoff (see formula above)	
V360 =	2186 CF
Off-Site Peak Discharge Rate (see formula above)	
Qp =	1.6 cfs

TREATMENT	
A =	0%
B =	80%
C =	0%
D =	20%

Note: Per the inflow / outflow hydrograph, the volume required to store is 1305 cf. Thus, the landscape area located in the southeast corner of the property will generate a sufficient volume to satisfy the criteria. The remainder of the site will free discharge at the northwest property corner.

PROPOSED POND	AREA	VOL. (CF)	ANALYSIS
(see Hydrograph for volume requirements)	69.0	1	Volume Provided:
	70.0	3975	1989
			Volume Required:
			1305

KEYNOTES

- ALL SPOT ELEVATIONS WITHIN PAVEMENT AREA REPRESENT TOP OF PAVING, UNLESS NOTED, ADO .05" TYPICAL FOR TOP OF CURB / TOP OF WALK ELEVATIONS.
- CONSTRUCT SITE ENTRANCE WITH VALLEY GUTTER PER C.O.A. STD. DWG. 2440 AT ELEVATIONS SHOWN, PROVIDE SMOOTH RIDING TRANSITION. SEE ARCHITECTURAL FOR ADDITIONAL INFORMATION.
- PROPOSED ASPHALT PAVING, CONSTRUCT AT ELEVATIONS INDICATED, PROVIDE SHADES WITHIN ASPHALT. DIRECT FLOWS AS SHOWN. SEE ARCHITECTURAL FOR ADDITIONAL INFORMATION REGARDING PARKING LAYOUT, DIMENSIONS, STRIPING AND ASPHALT PAVING SECTIONS.
- CONSTRUCT STANDARD CURB AND GUTTER AT ALL CURB LOCATIONS AS SHOWN, SEE C.O.A. STD. DWG. 2415.
- CONSTRUCT RETAINING WALL ALONG WEST PROPERTY LINE AS REQUIRE TO ACHIEVE GRADE ELEVATIONS SHOWN.
- CONSTRUCT A 1' BOTTOM WIDTH U SHAPED CONCRETE CHANNEL TO ALLOW FLOWS TO PASS.
- CONSTRUCT CONCRETE WALK / STANDARD CURB AND GUTTER THIS AREA. SEE ARCHITECTURAL FOR ADDITIONAL INFORMATION.
- CONSTRUCT POND THIS AREA TO CAPTURE SUB-BASIN FLOWS. SEE CALCULATIONS / DETAIL FOR ADDITIONAL INFORMATION.
- INSTALL 24" LF 4' DIA. PVC CULVERT TO DRAIN POND TO SOUTHWEST DRIVE ENTRANCE AS SHOWN, MIN. SLOPE = 0.0050'. INSTALL 4" CLEANOUTS AT 100' MAX. INTERVALS. SEE CALCULATIONS FOR ADDITIONAL INFORMATION.
- RAMP WALK DOWN FLUSH WITH TOP OF ASPHALT ADJACENT TO HANDICAP PARKING. SEE ARCHITECTURAL FOR ADDITIONAL INFORMATION.


AREAS OF MODIFICATION BETWEEN APPROVED DRAINAGE GRADING PLAN AND ACTUAL AS-BUILT

- Minor changes to curb and gutter / island locations. Does not affect drainage patterns. OKAY.
- Dumpster relocated. OKAY.
- As-built Pond Volume = 2350 SF Required Pond Volume = 1305 SF


I, Christopher L. Weiss, P.E. hereby certify that the as-built information shown, is in substantial compliance with the approved drainage / grading plan.

Christopher L. Weiss
Christopher L. Weiss, P.E.

Date: 12-6-99
Survey info. provided by Ron Forstbumer - Forstbumer Surveying Co. - November 1999

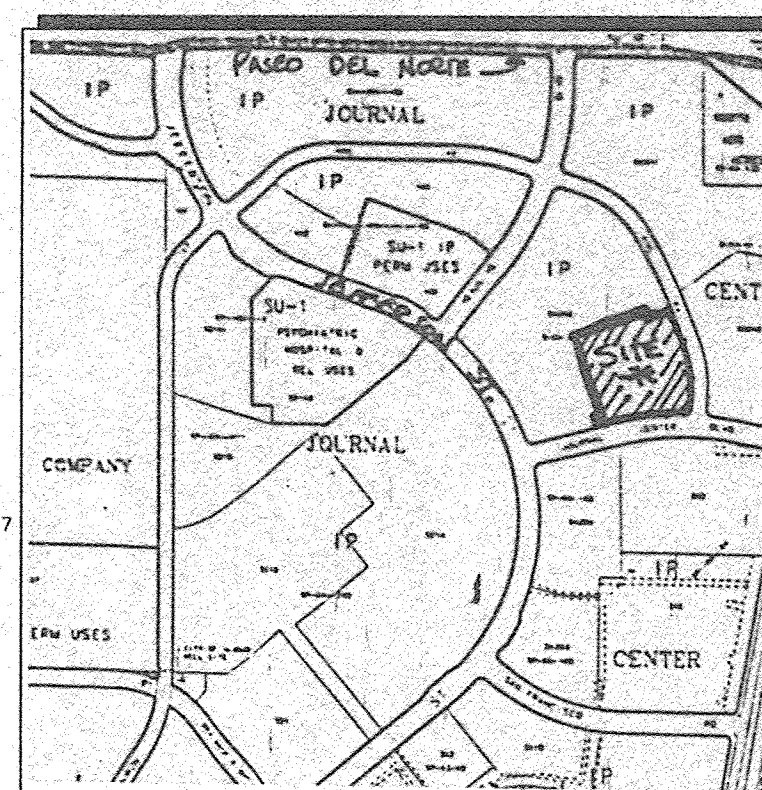

Vicinity Map D-17

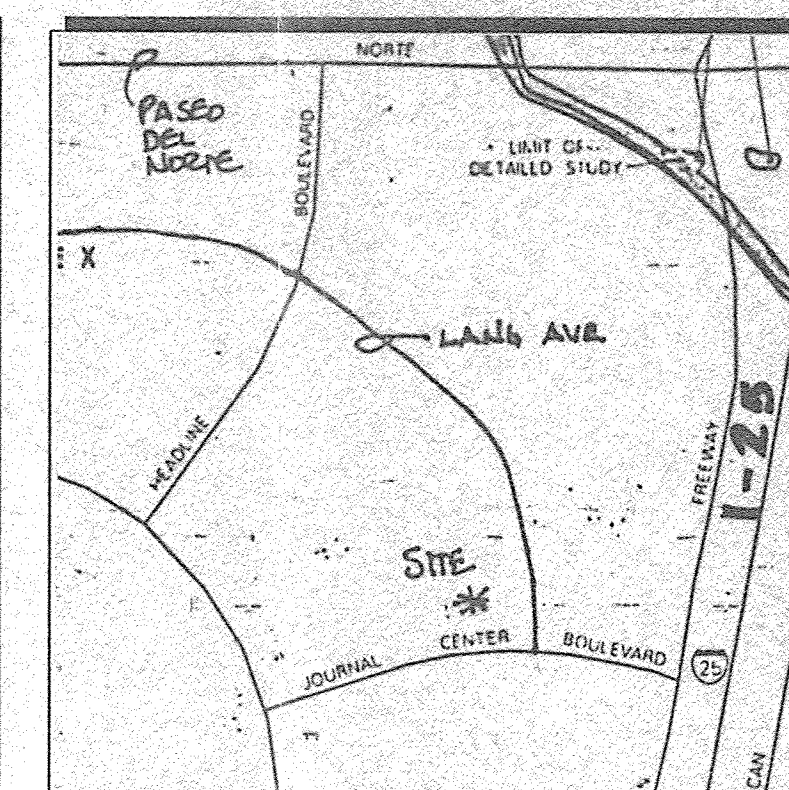

F.I.R.M. Map #137

PER CITY OF ALBUQUERQUE REQUIREMENTS, AN ENGINEER'S CERTIFICATION WILL BE REQUIRED TO OBTAIN A CERTIFICATE OF OCCUPANCY. THE SITE POND SHOWN ON THIS PLAN SHALL BE CONSTRUCTED PER THE PLAN. THE POND VOLUME, CULVERT INVERTS, BERMS, POND BOTTOM ELEVATIONS, ETC. AS WELL AS THE REMAINDER OF THE SITE MUST COMPLY WITH THE APPROVED PLAN.

C.L. WEISS ENGINEERING, INC.
POST OFFICE BOX 97 • SANDIA PARK, N.M. 87047 • (505) 891-8800
100 ALVARADO DR. NE • ALBUQUERQUE, N.M. 87102 • (505) 268-3444

SCOPE

The proposed improvements include an approx. 17,650 SF (footprint) commercial facility, along with all the necessary site improvements associated with vehicle access, parking and landscaping.

Lang Avenue NE borders the site to the east, Journal Center Blvd. NE borders the site to the south, undeveloped commercial properties border the site to the north and west.

The Drainage Management Plan for Journal Center prepared by Bohannon-Huston, Inc. (dated 12-17-92) has established free discharge of developed basins to adjoining streets, with Jefferson Street being the final intercepter for routing flows to the existing Storm Sewer (SS) system. See calculations for additional information.

The intent of this plan is to show:


- Grading relationships between the existing ground elevations and proposed finished elevations in order to facilitate positive drainage to designated discharge points.
- The extent of proposed site improvements, including buildings, walks and pavement.
- The flow rate/volume of rainfall runoff across or around these improvements and methods of handling these flows to meet City of Albuquerque requirements for drainage management.
- The relationship of on-site improvements with existing neighboring property to insure an orderly transition between proposed and surrounding grades.

GENERAL NOTES

- LEGAL:** Proposed Tract 2A-2A-2A Journal Center Albuquerque, Bernalillo County, New Mexico
- SURVEYOR:** Hall Engineering Company, Inc. - (505) 345-1064
- B.M.:** NMSHC "125-141969" Standard NMSHC Brass Table (Found in Place) New Mexico State Plane Grid Coordinates (Central Zone) X=399,828.26 (Nad 1927) Y=1,514,860.92 G=0.99966298 Elevation = 5196.73 (M.S.L.D.)
- T.B.M.:** Top of manhole located near Southeast corner of property in the intersection of Lang Avenue NE and Journal Center Blvd. NE. Elevation = 5177.60' (M.S.L.D.)
- FLOOD HAZARD:** Per F.I.R.M. Boundary Map #137, the site is not located in a flood zone.
- OFF-SITE DRAINAGE:** This site is isolated from all off-site flows by surrounding streets which intercept upland flows for routing around the site.
- EROSION CONTROL:** The contractor is responsible for retaining on-site all sediment generated during construction by means of temporary earth berms or silt fences at the low points on the west and north property lines.

Van H. Gilbert Architect PC

Architecture Planning
2428 Baylor Drive SE Albuquerque, NM 87106 505.247.9866

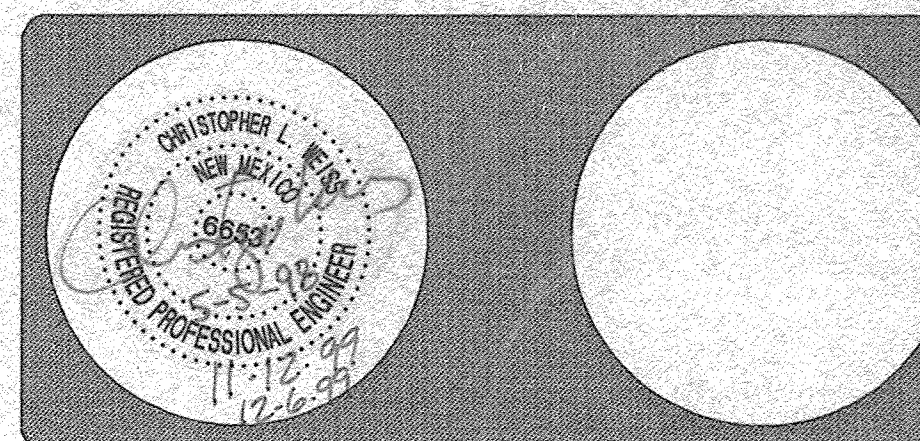

MOUNTAIN STATES MUTUAL CASUALTY GROUP

JOURNAL CENTER
VHGA PROJECT NO. 918

DATE: MAY 1998 DRN BY: BJB © Copyright 1997
FILE: CHK BY: CLW PLOT: 1=30

DRAINAGE / GRADING PLAN

C1.1
SHEET OF