

GENERAL GRADING NOTES:

1. THE CONTRACTOR SHALL OBTAIN A TOP SOIL DISTURBANCE PERMIT FROM THE CITY OF ALBUQUERQUE, ENVIRONMENTAL HEALTH DIVISION PRIOR TO CONSTRUCTION.
2. THE CONTRACTOR IS TO REFER TO THE EARTHWORK SPECIFICATIONS NOTED IN THE GEOTECHNICAL INVESTIGATION REPORT PREPARED FOR THIS LOT AND CAN BE OBTAINED BE THE OWNER.
3. THE CONTRACTOR SHALL CONFORM TO ALL CITY, COUNTY, STATE AND FEDERAL DUST CONTROL MEASURES AND REQUIREMENTS AND WILL BE RESPONSIBLE FOR PREPARING AND OBTAINING ALL NECESSARY APPLICATIONS, PERMITS AND APPROVALS.
4. PVC DRAINAGE PIPES MAY REQUIRE FIELD ADJUSTMENT DUE TO SUBSURFACE ROCK. CONTRACTOR SHALL PROVIDE POSITIVE DRAINAGE TO INLET/STREET.
5. CONTRACTOR SHALL FIELD VERIFY ALL EXISTING UTILITY CONDITIONS AND NOTIFY THE ENGINEER IMMEDIATELY OF ANY DISCREPANCIES.
6. TWO WORKING DAYS PRIOR TO EXCAVATION THE CONTRACTOR SHALL CONTACT NEW MEXICO ONE CALL SYSTEM (260-1990) FOR LOCATION OF EXISTING UTILITIES.
7. CONTRACTOR SHALL PROVIDE DOUBLE CLEAN-OUTS AT ALL BENDS IN DRAINAGE PIPE.
8. THE TOPSOIL COULD BE SAVED ASIDE FOR RE-USE IN FILLING DISTURBED AREAS AROUND THE STRUCTURE.
9. ALL DISTURBED AREAS ON THE LOT SHALL BE RESEDED WITH NATIVE SEEDING MATERIAL.
10. THE MAXIMUM GRADED SIDE SLOPE SHALL NOT EXCEED 3 FEET (HORIZONTALLY) TO 1 FOOT (VERTICALLY)
11. AREAS DISTURBED DUE TO GRADING SHALL BE RESEDED IN ACCORDANCE WITH CITY OF ALBUQUERQUE STD. SPECIFICATION 1012 - NATIVE GRASS SEEDING, O.A.E.

FEMA FLOODWAY MAP (AGIS)

VICINITY MAP

ZONE ATLAS: D-17

LEGEND

EXISTING PROPOSED

CONTOUR

PROPERTY LINE

ROAD

SETBACK

RETAINING WALL

AS BUILT SPOT ELEVATION

FF=5114.02
FF=5114.08

DRAINAGE CERTIFICATION:

I, JACKIE S. MCDOWELL, P.E., OF MCDOWELL ENGINEERING, INC. NMPE #10903 HEREBY CERTIFY THAT THE AS-BUILT DRAINAGE CONDITIONS OF THE SITE ARE IN SUBSTANTIAL COMPLIANCE WITH THE APPROVED GRADING AND DRAINAGE PLAN, TO THE BEST OF MY KNOWLEDGE AND BELIEF. AS-BUILT ELEVATIONS ARE SHOWN ON THE PLAN WHERE THE ORIGINAL DESIGN ELEVATION HAS BEEN CROSSED OUT AND THE AS-BUILT ELEVATION ADDED.

Jackie S. McDowell
JACKIE S. MCDOWELL, P.E.
3-18-04
DATE



Jackie S. McDowell
JACKIE S. MCDOWELL, P.E.
10-3-02
Rev. 12-6-02

DRAINAGE PLAN

SCOPE:

Pursuant to the latest City of Albuquerque Ordinance, the Drainage Plan shown hereon outlines the drainage management criteria for controlling developed runoff on and exiting the project site. Two buildings are proposed for the subject property (2 lots), with associated access, parking and landscaping.

EXISTING CONDITIONS:

Presently the 1.19 acre site is undeveloped. The site is bounded on the west by Washington Street, on the north by Wolcott Avenue, and on the east by Hancock Court. The site slopes from the northeast to the southwest at approximately 4%. As shown by the FEMA Map Panel No. 136, dated April 2, 2002, the site is not located in a 100-year floodplain. No offsite runoff enters the property.

PROPOSED CONDITIONS:

As shown by the plan, the buildings are located within the westerly half of Lot #3 and within the easterly half of Lot #4. On site flows will drain around the structures and flow to the southwest. All roof drainage will discharge from the roofs to the south and west and continue to flow to Washington Street. Runoff will continue to be allowed to free discharge to the adjacent street, per the Bohannon Huston Journal Center Master Drainage plan (COA File No. D17/D3). Supplemental calculations have been provided to the City of Albuquerque Hydrology Department.

CALCULATIONS:

The calculations shown hereon define the 100 year/6 hour design storm falling within the project area under existing and developed conditions. The Hydrology is per "Section 22.2, Hydrology of the Development Process Manual, Volume 2, Design Criteria, for the City of Albuquerque, New Mexico in cooperation with Bernalillo County, New Mexico and the Albuquerque Metropolitan Arroyo Flood Control Authority, latest edition.

Existing Treatment Types:

Treatment A = 1.19 acres
Treatment B = 0 acres
Treatment C = 0 acres
Treatment D = 0 acres

Proposed Treatment Types:

Treatment A = 0.00 acres
Treatment B = 0.23 acres
Treatment C = 0.00 acres
Treatment D = 0.96 acres

Using the values above produces the following storm water flows and volumes:

Existing 100-year Flow = 1.86 cfs
Proposed 100-year Flow = 5.04 cfs

Existing 100-year Volume = 2289 cu. ft.
Proposed 100-year Volume = 8039 cu. ft.

PROPERTY ADDRESS:

7420 Washington Street (Lot #3)
7421 Hancock Court (Lot #4)


TOPOGRAPHY:

Topographic information provided by Precision Surveying dated September 2002.

Survey Legend

N 90°00'00" E	MEASURED BEARING AND DISTANCES
○	FOUND AND USED MONUMENT AS DESIGNATED
□	UTILITY PEDESTAL
⊗	SANITARY SEWER MANHOLE
△	CENTERLINE MONUMENT
⊙	WATER METER
⊗	WATER VALVE
⊙	FIRE HYDRANT
⊙	TELEPHONE MANHOLE

GRAPHIC SCALE

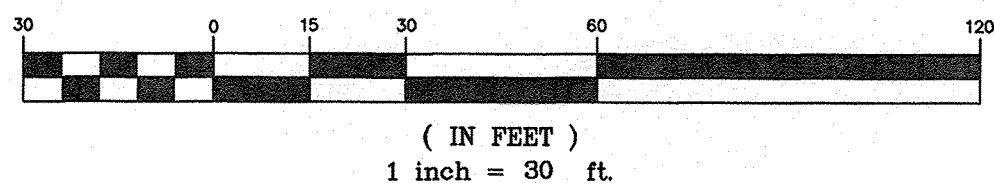

LOCATION OF UTILITY LINES ARE APPROXIMATE
SIZE OF LINE BASED ON AS-BUILT DATA OBTAINED
FROM THE CITY OF ALBUQUERQUE

LOTS 3 & 4, JOURNAL CENTER


WITHIN
PHASE 2, UNIT 1

ALBUQUERQUE, BERNALILLO COUNTY, NEW MEXICO

Survey Notes

- 1) REFER TO PLAT ENTITLED "PLAT OF JOURNAL CENTER PHASE 2, UNIT 1" LYING AND SITUATE WITHIN PROJECTED SECTION 12, T.11 N., R. 3 E., ELENA GALLEGO GRANT, N.M.P.M., ALBUQUERQUE, BERNALILLO COUNTY, NEW MEXICO, FILED IN THE OFFICE OF THE COUNTY CLERK OF BERNALILLO COUNTY ON MARCH 15, 2001, IN BOOK 2001C, PAGE 84.
- 2) ELEVATION DATUM IS BASED ON NGVD 1929 FROM NMSHC MONUMENT "9-D17", ELEVATION (FEET) = 5124.4
- 3) IMPROVEMENTS SHOWN ARE CURRENT AS OF SEPTEMBER 16, 2002, DATE OF FIELD SURVEY.
- 4) LOCATION OF UNDERGROUND UTILITIES AND EASEMENTS NOT VERIFIED BY THIS PLAN. UNDERGROUND UTILITIES MAY EXIST WHERE NONE ARE SHOWN. UNDERGROUND UTILITY LOCATION IS BASED UPON INFORMATION PROVIDED BY OTHERS AND MAY BE INCOMPLETE OR OBSOLETE AT THE TIME OF CONSTRUCTION. THE OWNER SHOULD INFORM HIMSELF OF THE LOCATION OF ANY UTILITY LINE, PIPELINE, OR UNDERGROUND UTILITY LINE IN OR NEAR THE AREA OF THE WORK IN ADVANCE OF AND DURING EXCAVATION WORK. THE OWNER IS FULLY RESPONSIBLE FOR ANY AND ALL DAMAGE CAUSED BY ITS FAILURE TO LOCATE, IDENTIFY AND PRESERVE ANY AND ALL EXISTING UTILITIES, PIPELINES AND UNDERGROUND UTILITY LINES. THE OWNER IS URGED TO COMPLY WITH STATE STATUTES, MUNICIPAL AND LOCAL ORDINANCES, RULES AND REGULATIONS, IF ANY, PERTAINING TO THE LOCATION OF THESE LINES, IN PLANNING AND CONDUCTING EXCAVATION. THE OWNER SHOULD MAKE THEMSELVES AWARE OF REGULATIONS STATED IN CHAPTER 82, ARTICLE 14, NMSA 1978 RELATING TO EXCAVATION DAMAGE TO PIPELINES AND UNDERGROUND UTILITY LINES.

GRADING
10-1-02
1=30
BRE0102L

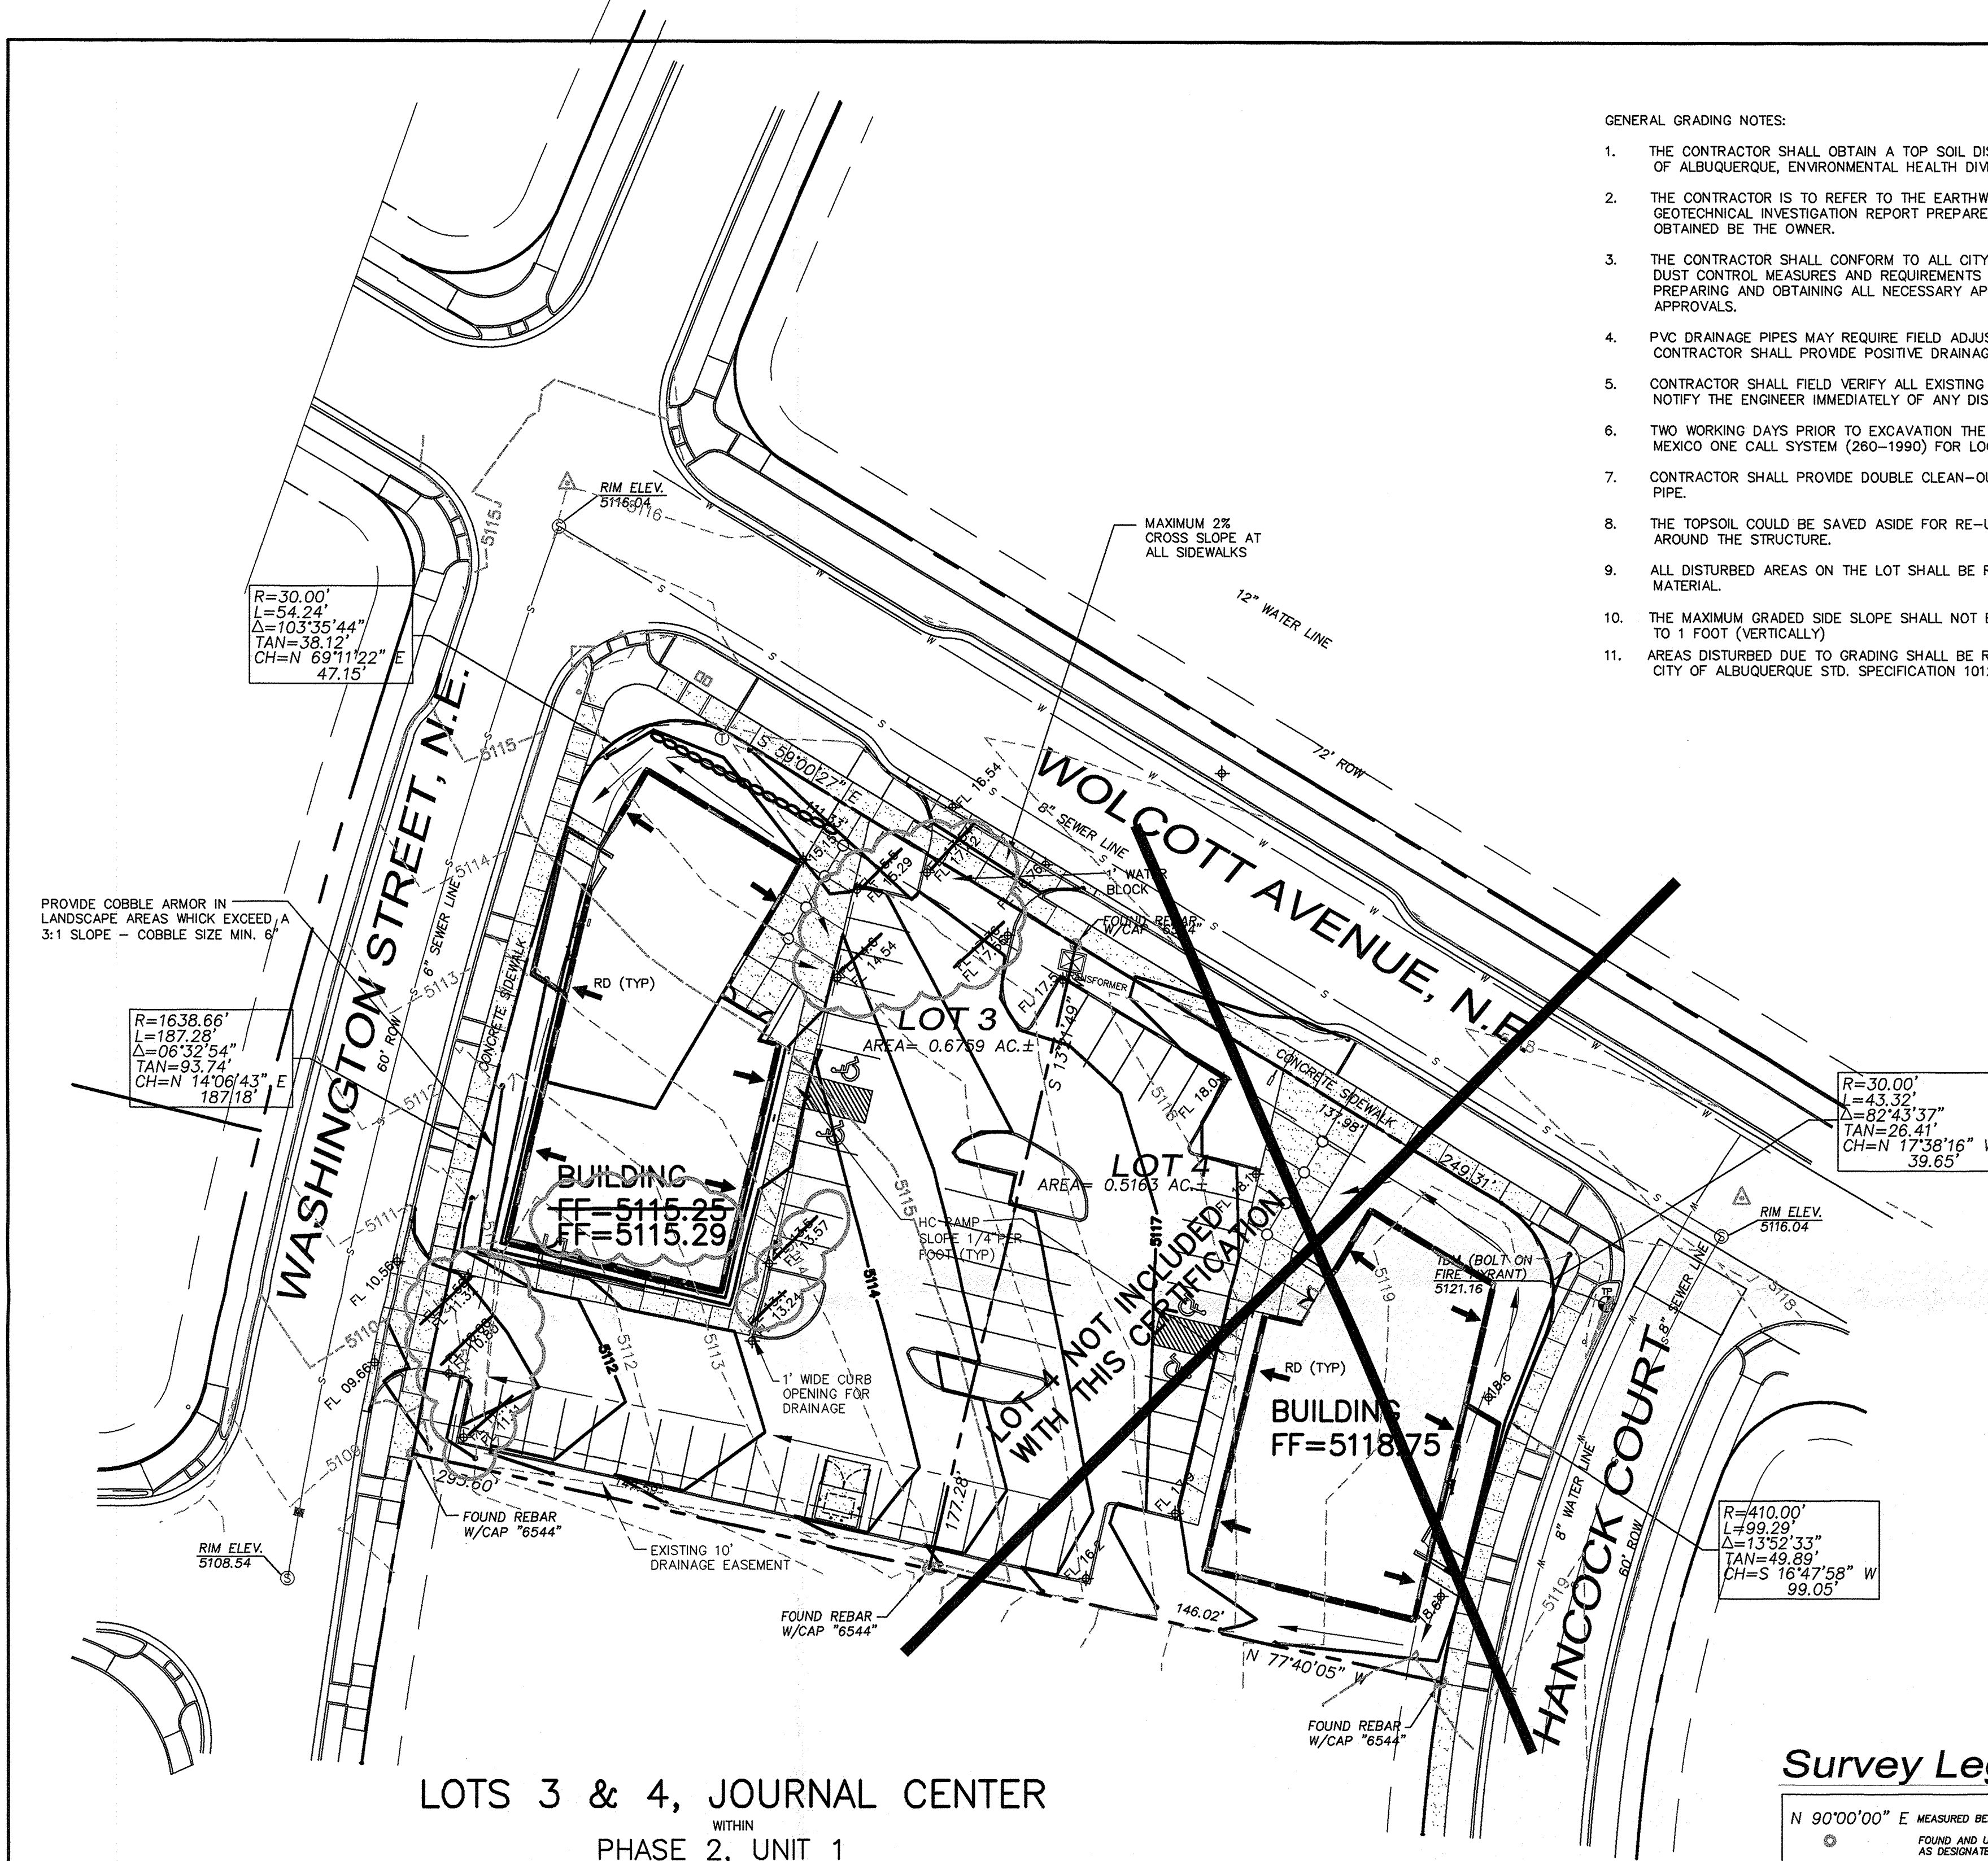

LOTS 3 & 4, JOURNAL CENTER
WITHIN
PHASE 2, UNIT 1
ALBUQUERQUE, BERNALILLO COUNTY, NEW MEXICO

Survey Notes

- 1) REFER TO PLAT ENTITLED "PLAT OF JOURNAL CENTER PHASE 2, UNIT 1" LYING AND SITUATE WITHIN PROJECTED SECTION 12, T.11 N., R. 3 E., ELENA GALLEGOS GRANT, N.M.P.M., ALBUQUERQUE, BERNALILLO COUNTY, NEW MEXICO, FILED IN THE OFFICE OF THE COUNTY CLERK OF BERNALILLO COUNTY ON MARCH 15, 2001, IN BOOK 2001C, PAGE 84.
- 2) ELEVATION DATUM IS BASED ON NGVD 1929 FROM NMHC MONUMENT "9-D17", ELEVATION (FEET) = 5124.4
- 3) IMPROVEMENTS SHOWN ARE CURRENT AS OF SEPTEMBER 16, 2002, DATE OF FIELD SURVEY.
- 4) LOCATION OF UNDERGROUND UTILITIES AND EASEMENTS NOT VERIFIED BY THIS PLAN. UNDERGROUND UTILITIES MAY EXIST WHERE NONE ARE SHOWN. UNDERGROUND UTILITY LOCATION IS BASED UPON INFORMATION PROVIDED BY OTHERS AND MAY BE INCOMPLETE OR OBSOLETE AT THE TIME OF CONSTRUCTION. THE OWNER SHOULD INFORM HIMSELF OF THE LOCATION OF ANY UTILITY LINE, PIPELINE, OR UNDERGROUND UTILITY LINE IN OR NEAR THE AREA OF THE WORK IN ADVANCE OF AND DURING EXCAVATION WORK. THE OWNER IS FULLY RESPONSIBLE FOR ANY AND ALL DAMAGE CAUSED BY ITS FAILURE TO LOCATE, IDENTIFY AND PRESERVE ANY AND ALL EXISTING UTILITIES, PIPELINES AND UNDERGROUND UTILITY LINES. THE OWNER IS URGED TO COMPLY WITH STATE STATUTES, MUNICIPAL AND LOCAL ORDINANCES, RULES AND REGULATIONS, IF ANY, PERTAINING TO THE LOCATION OF THESE LINES, IN PLANNING AND CONDUCTING EXCAVATION. THE OWNER SHOULD MAKE THEMSELVES AWARE OF REGULATIONS STATED IN CHAPTER 62, ARTICLE 14, NMSA 1978 RELATING TO EXCAVATION DAMAGE TO PIPELINES AND UNDERGROUND UTILITY LINES.


GRADING
10-1-02
1=30
BRO102L

GENERAL GRADING NOTES:


1. THE CONTRACTOR SHALL OBTAIN A TOP SOIL DISTURBANCE PERMIT FROM THE CITY OF ALBUQUERQUE, ENVIRONMENTAL HEALTH DIVISION PRIOR TO CONSTRUCTION.
2. THE CONTRACTOR IS TO REFER TO THE EARTHWORK SPECIFICATIONS NOTED IN THE GEOTECHNICAL INVESTIGATION REPORT PREPARED FOR THIS LOT AND CAN BE OBTAINED BY THE OWNER.
3. THE CONTRACTOR SHALL CONFORM TO ALL CITY, COUNTY, STATE AND FEDERAL DUST CONTROL MEASURES AND REQUIREMENTS AND WILL BE RESPONSIBLE FOR PREPARING AND OBTAINING ALL NECESSARY APPLICATIONS, PERMITS AND APPROVALS.
4. PVC DRAINAGE PIPES MAY REQUIRE FIELD ADJUSTMENT DUE TO SUBSURFACE ROCK. CONTRACTOR SHALL PROVIDE POSITIVE DRAINAGE TO INLET/STREET.
5. CONTRACTOR SHALL FIELD VERIFY ALL EXISTING UTILITY CONDITIONS AND NOTIFY THE ENGINEER IMMEDIATELY OF ANY DISCREPANCIES.
6. TWO WORKING DAYS PRIOR TO EXCAVATION THE CONTRACTOR SHALL CONTACT NEW MEXICO ONE CALL SYSTEM (260-1990) FOR LOCATION OF EXISTING UTILITIES.
7. CONTRACTOR SHALL PROVIDE DOUBLE CLEAN-OUTS AT ALL BENDS IN DRAINAGE PIPE.
8. THE TOPSOIL COULD BE SAVED ASIDE FOR RE-USE IN FILLING DISTURBED AREAS AROUND THE STRUCTURE.
9. ALL DISTURBED AREAS ON THE LOT SHALL BE RESEEDED WITH NATIVE SEEDING MATERIAL.
10. THE MAXIMUM GRADED SIDE SLOPE SHALL NOT EXCEED 3 FEET (HORIZONTALLY) TO 1 FOOT (VERTICALLY)
11. AREAS DISTURBED DUE TO GRADING SHALL BE RESEEDED IN ACCORDANCE WITH CITY OF ALBUQUERQUE STD. SPECIFICATION 1012 - NATIVE GRASS SEEDING, O.A.E.

Survey Legend

N 90°00'00" E MEASURED BEARING AND DISTANCES	
●	FOUND AND USED MONUMENT AS DESIGNATED
□	UTILITY PEDESTAL
⊙	SANITARY SEWER MANHOLE
△	CENTERLINE MONUMENT
⊕	WATER METER
⊗	WATER VALVE
⚡	FIRE HYDRANT
⓪	TELEPHONE MANHOLE

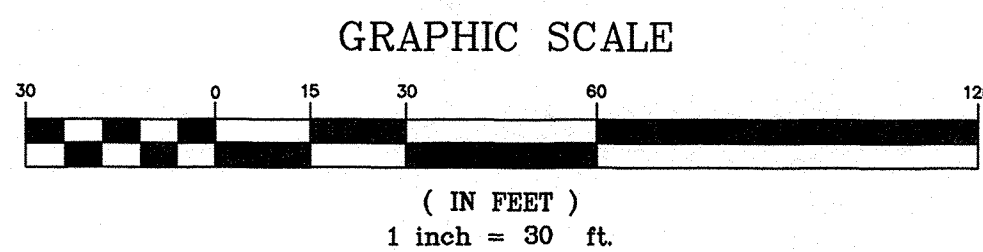

LOCATION OF UTILITY LINES ARE APPROXIMATE
SIZE OF LINE BASED ON AS-BUILT DATA OBTAINED
FROM THE CITY OF ALBUQUERQUE

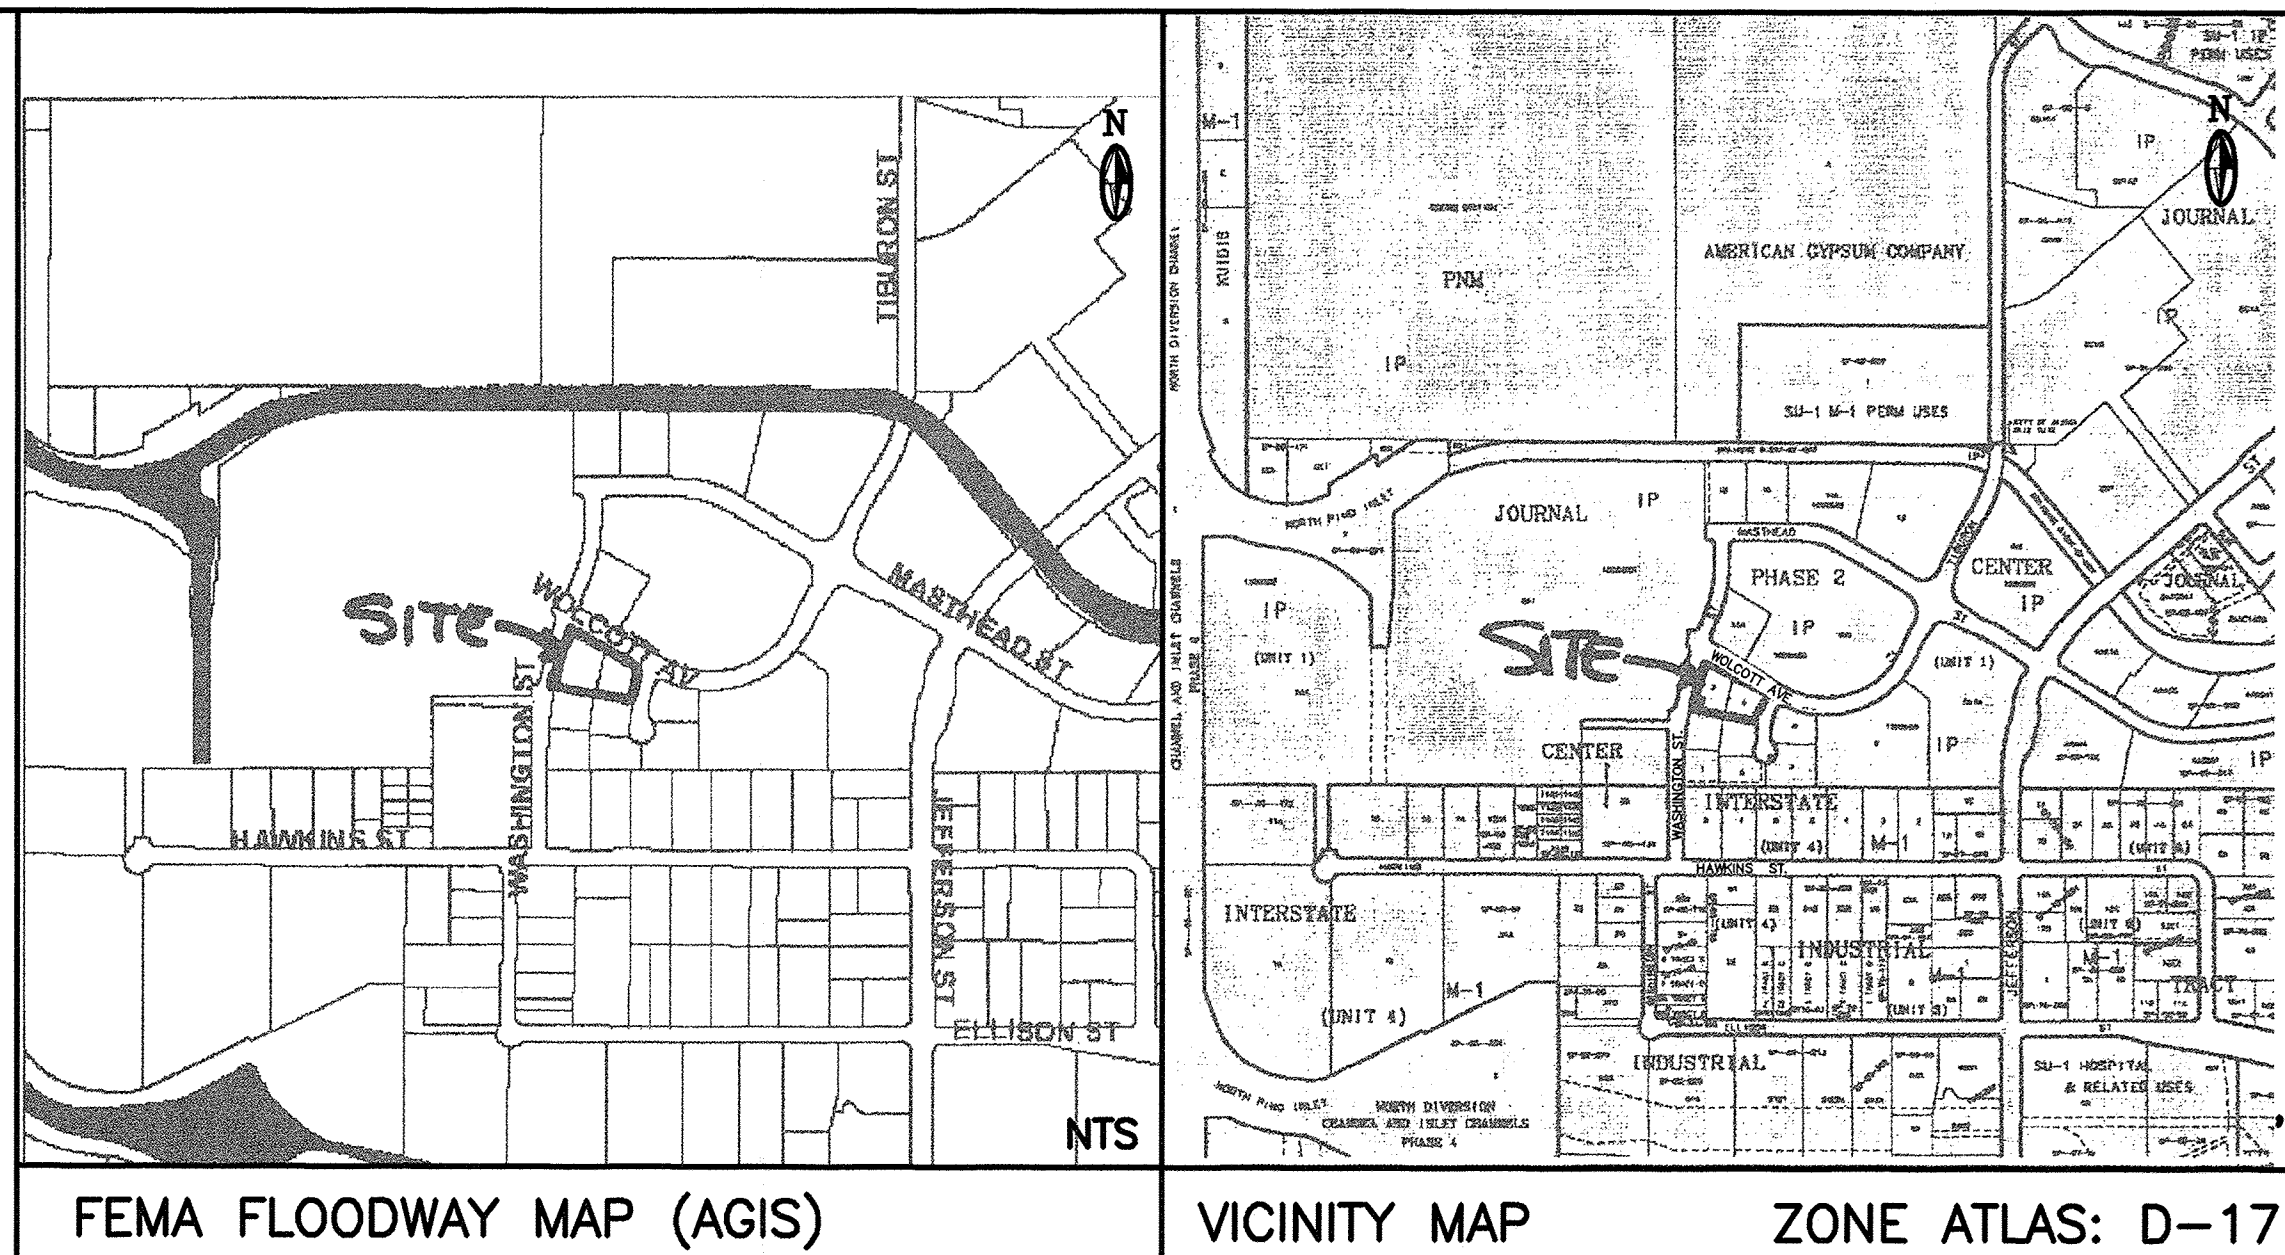

DRAINAGE PLAN

SCOPE:

Pursuant to the latest City of Albuquerque Ordinance, the Drainage Plan shown hereon outlines the drainage management criteria for controlling developed runoff on and exiting the project site. Two buildings are proposed for the subject property (2 lots), with associated access, parking and landscaping.

EXISTING CONDITIONS:

Presently the 1.19 acre site is undeveloped. The site is bounded on the west by Washington Street, on the north by Wolcott Avenue, and on the east by Hancock Court. The site slopes from the northeast to the southwest at approximately 4%. As shown by the FEMA Map Panel No. 136, dated April 2, 2002, the site is not located in a 100-year floodplain. No offsite runoff enters the property.

PROPOSED CONDITIONS:

As shown by the plan, the buildings are located within the westerly half of Lot #3 and within the easterly half of Lot #4. On site flows will drain around the structures and flow to the southwest. All roof drainage will discharge from the roofs to the south and west and continue to flow to Washington Street. Runoff will continue to be allowed to free discharge to the adjacent street, per the Bohannon Huston Journal Center Master Drainage plan (COA File No. D17/D3). Supplemental calculations have been provided to the City of Albuquerque Hydrology Department.

CALCULATIONS:

The calculations shown hereon define the 100 year/6 hour design storm falling within the project area under existing and developed conditions. The Hydrology is per "Section 22.2, Hydrology of the Development Process Manual, Volume 2, Design Criteria, for the City of Albuquerque, New Mexico in cooperation with Bernalillo County, New Mexico and the Albuquerque Metropolitan Arroyo Flood Control Authority, latest edition.

Existing Treatment Types:

Treatment A = 1.19 acres
Treatment B = 0 acres
Treatment C = 0 acres
Treatment D = 0 acres

Proposed Treatment Types:

Treatment A = 0.00 acres
Treatment B = 0.23 acres
Treatment C = 0.00 acres
Treatment D = 0.96 acres

Using the values above produces the following storm water flows and volumes:

Existing 100-year Flow = 1.86 cfs
Proposed 100-year Flow = 5.04 cfs

Existing 100-year Volume = 2289 cu. ft.
Proposed 100-year Volume = 8039 cu. ft.

PROPERTY ADDRESS:

7420 Washington Street (Lot #3)
7421 Hancock Court (Lot #4)

TOPOGRAPHY:

Topographic information provided by Precision Surveying dated September 2002.

LEGEND


EXISTING	PROPOSED
CONTOUR	5116 5850
PROPERTY LINE	
ROAD	
SETBACK	
RETAINING WALL	
AS BUILT SPOT ELEVATION	FF=5114.02 FF=5114.06

DRAINAGE CERTIFICATION:

I, JACKIE S. MCDOWELL, P.E., OF MCDOWELL ENGINEERING, INC. NMPE #10903 HEREBY CERTIFY THAT THE AS-BUILT DRAINAGE CONDITIONS OF THE SITE ARE IN SUBSTANTIAL COMPLIANCE WITH THE APPROVED GRADING AND DRAINAGE PLAN, TO THE BEST OF MY KNOWLEDGE AND BELIEF. AS-BUILT ELEVATIONS ARE SHOWN ON THE PLAN WHERE THE ORIGINAL DESIGN ELEVATION HAS BEEN CROSSED OUT AND THE AS-BUILT ELEVATION ADDED.

Jackie S. McDowell
JACKIE S. MCDOWELL, P.E.




9-4-03
DATE

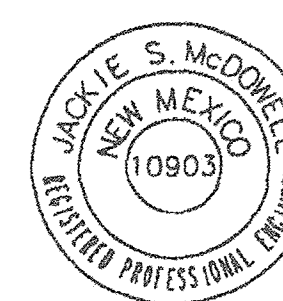

Jackie S. McDowell
JACKIE S. MCDOWELL, P.E.

10-3-02
Rev. 12-6-02

BERNALILLO COUNTY		NEW MEXICO	
LOTS 3 & 4, JOURNAL CENTER PHASE 2, UNIT 1			
CHAPMAN JOURNAL CENTER DEVELOPMENT			
McDowell Engineering Inc.			
Designed JSM	Drawn STAFF	Checked JSM	Sheet of
File BRE0102L	Date NOVEMBER, 2002	C-2.1	

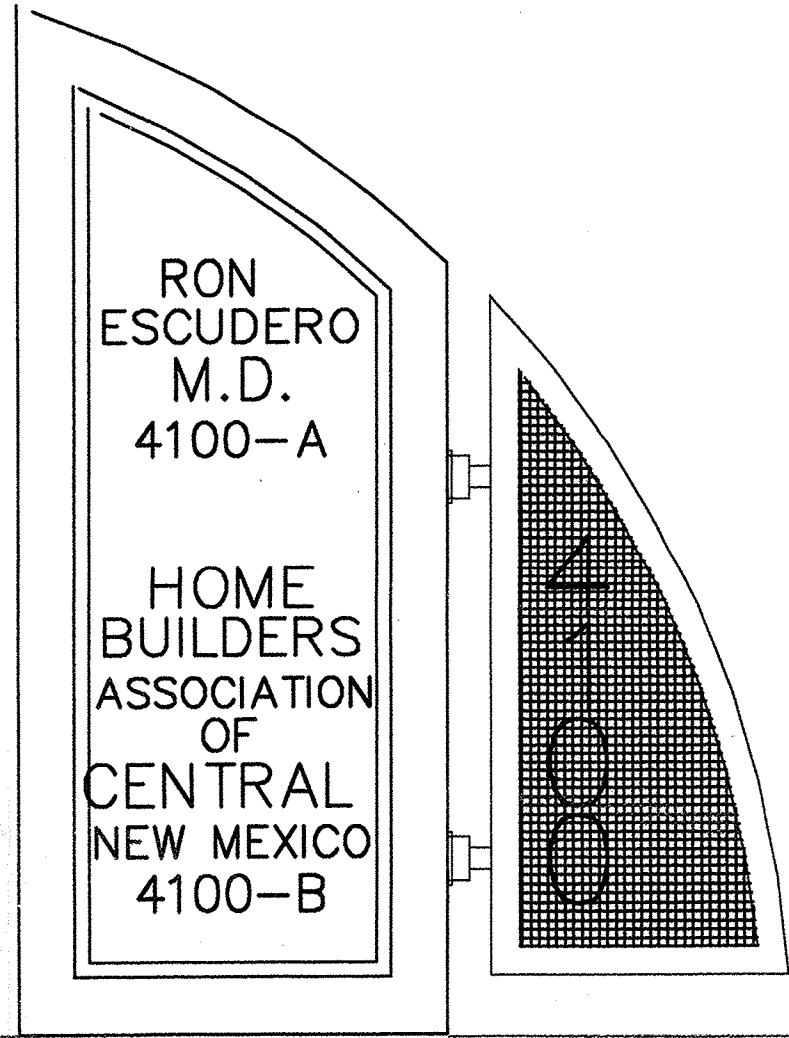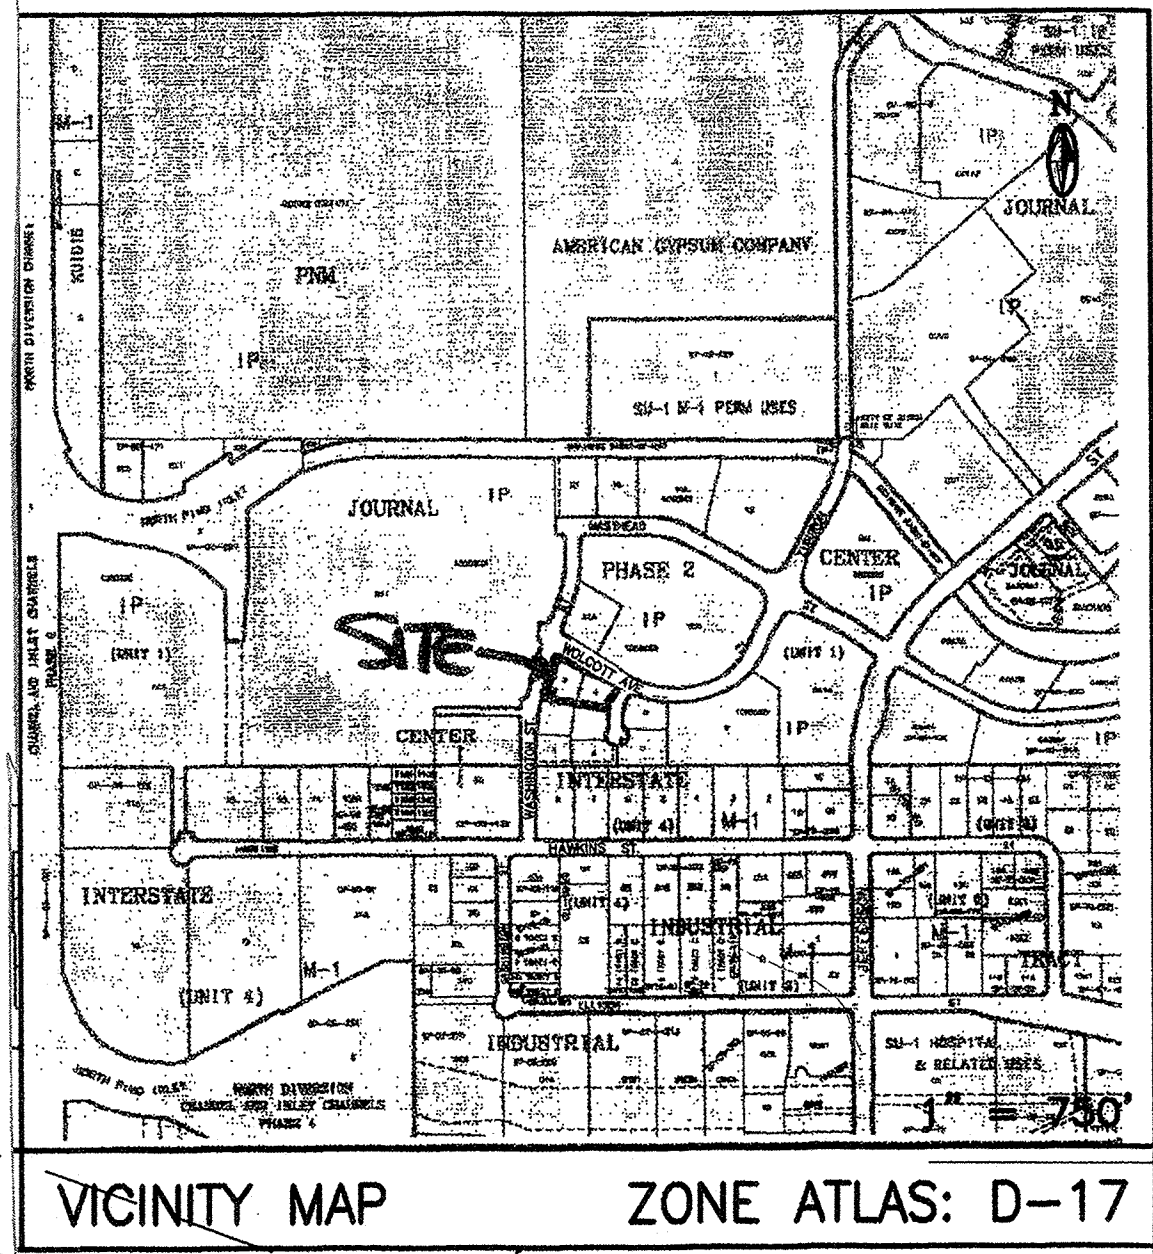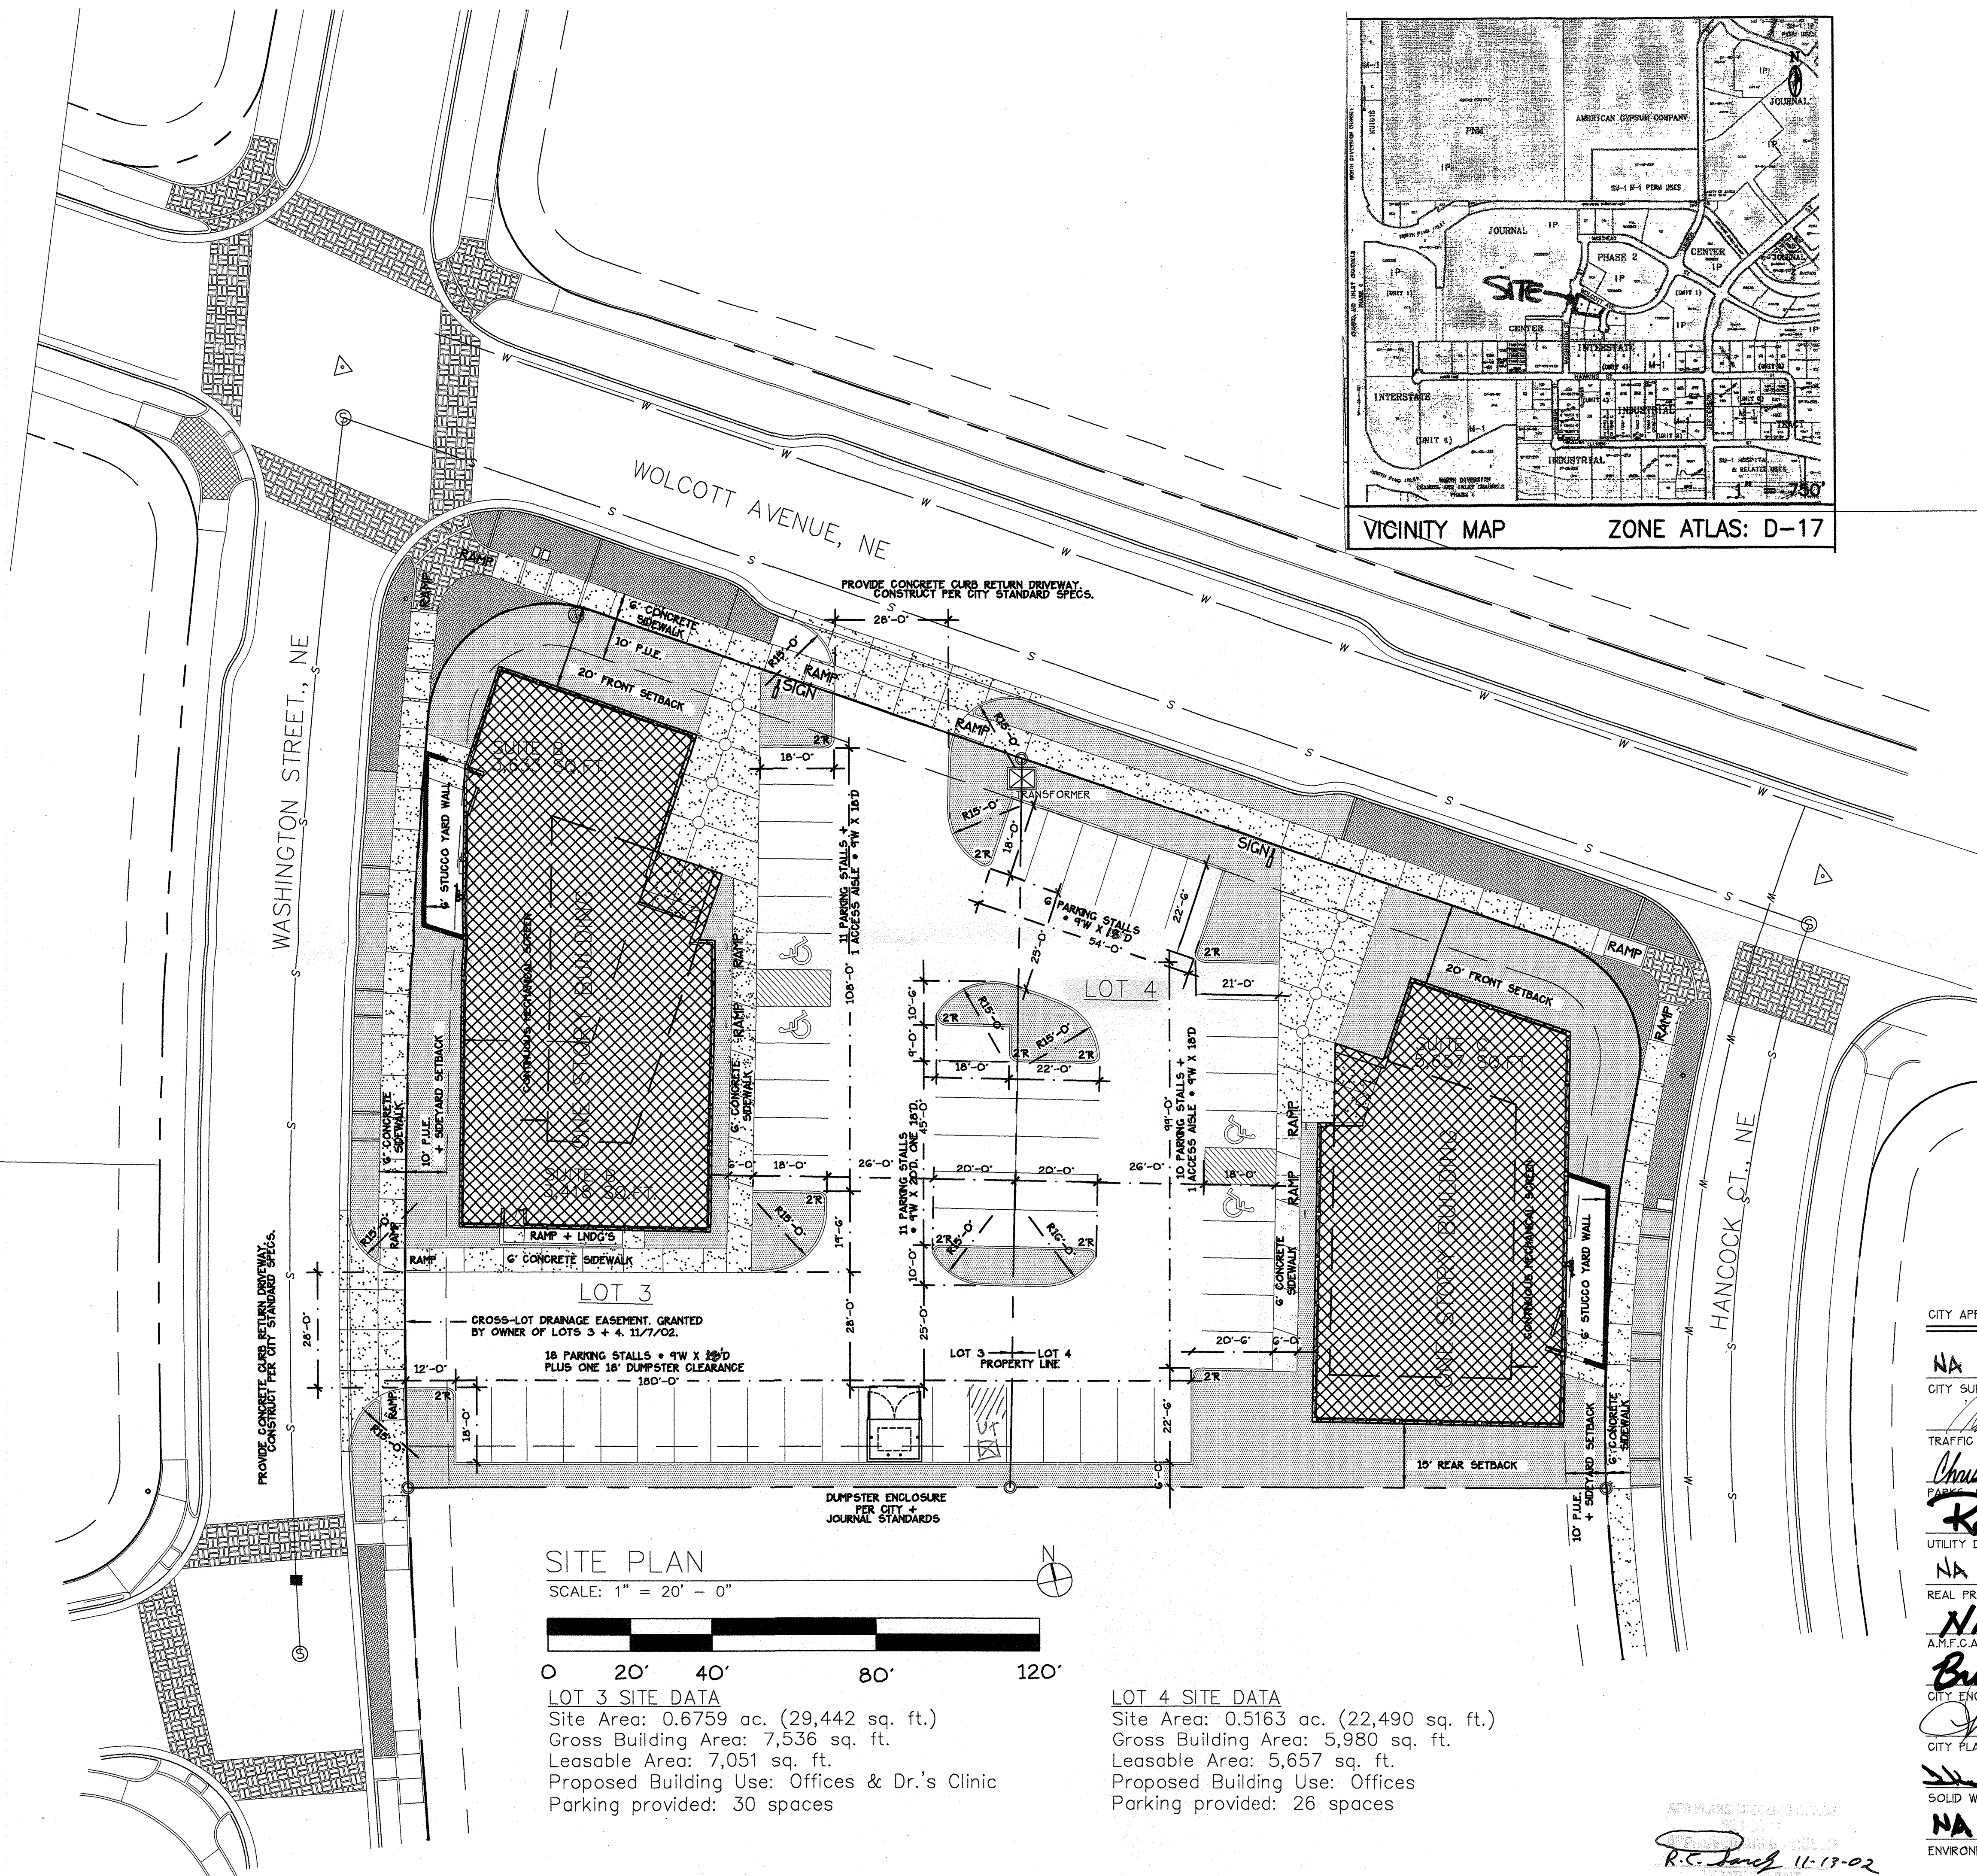


TYPICAL MONUMENT SIGN
6' HIGH X 5' WIDE

PLAN LEGEND

- BUILDING AREA
- CONCRETE PAVEMENT
- NEW LANDSCAPED AREAS
- EXISTING LANDSCAPED AREAS


SITE PLAN

SCALE: 1" = 20' - 0"

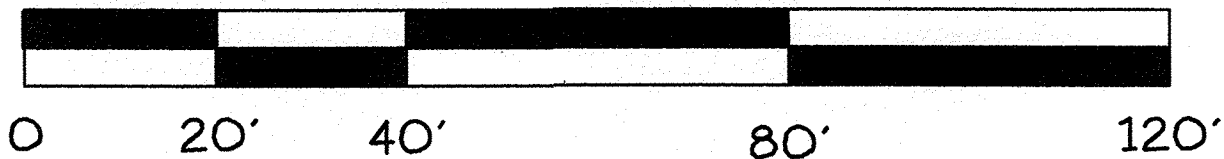

LOT 3 SITE DATA
Site Area: 0.6759 ac. (29,442 sq. ft.)
Gross Building Area: 7,536 sq. ft.
Leasable Area: 7,051 sq. ft.
Proposed Building Use: Offices & Dr.'s Clinic
Parking provided: 30 spaces

LOT 4 SITE DATA
Site Area: 0.5163 ac. (22,490 sq. ft.)
Gross Building Area: 5,980 sq. ft.
Leasable Area: 5,657 sq. ft.
Proposed Building Use: Offices
Parking provided: 26 spaces

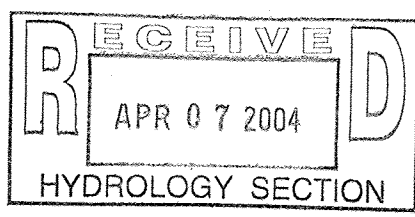

CITY APPROVALS:	PROJECT NO:
NA	1002277
CITY SURVEYOR	DATE:
TRAFFIC ENGINEERING	DATE:
CHRISTINA SANDORAL	11/13/02
PARKS & RECREATION	DATE:
ROGER A. SHAN	11-14-02
UTILITY DEVELOPMENT	DATE:
NA	
REAL PROPERTY DIVISION	DATE:
N/A	
A.M.F.C.A.	DATE:
BRAD D. BIGHA	11/14/02
CITY ENGINEER	DATE:
SHERAN MATSON	11/13/2002
CITY PLANNER, ALBUQUERQUE PLANNING DIVISION	DATE:
SOLID WASTE	DATE:
NA	11-13-02
ENVIRONMENTAL HEALTH	DATE:

DORMAN and BREEN

RICHARD DORMAN F.A.I.A.
ALBUQUERQUE, NM 505-299-5940

LAURENCE BREEN A.I.A.
SANTA FE, NM 505-982-9196

4100 Wolcott Avenue NE, Lot 3

4110 Wolcott Avenue NE, Lot 4

LOTS 3 & 4 JOURNAL CENTER 2

Albuquerque, New Mexico

SHEET TITLE:

SITE PLAN - DRB

JOB NUMBER:

0247

DATE:


11-8-02

REVISIONS:	DATE:
Permit Set	10-8
Lot 4 PERMIT	6-27-03

SHEET:


C-1.1

2 OF 22

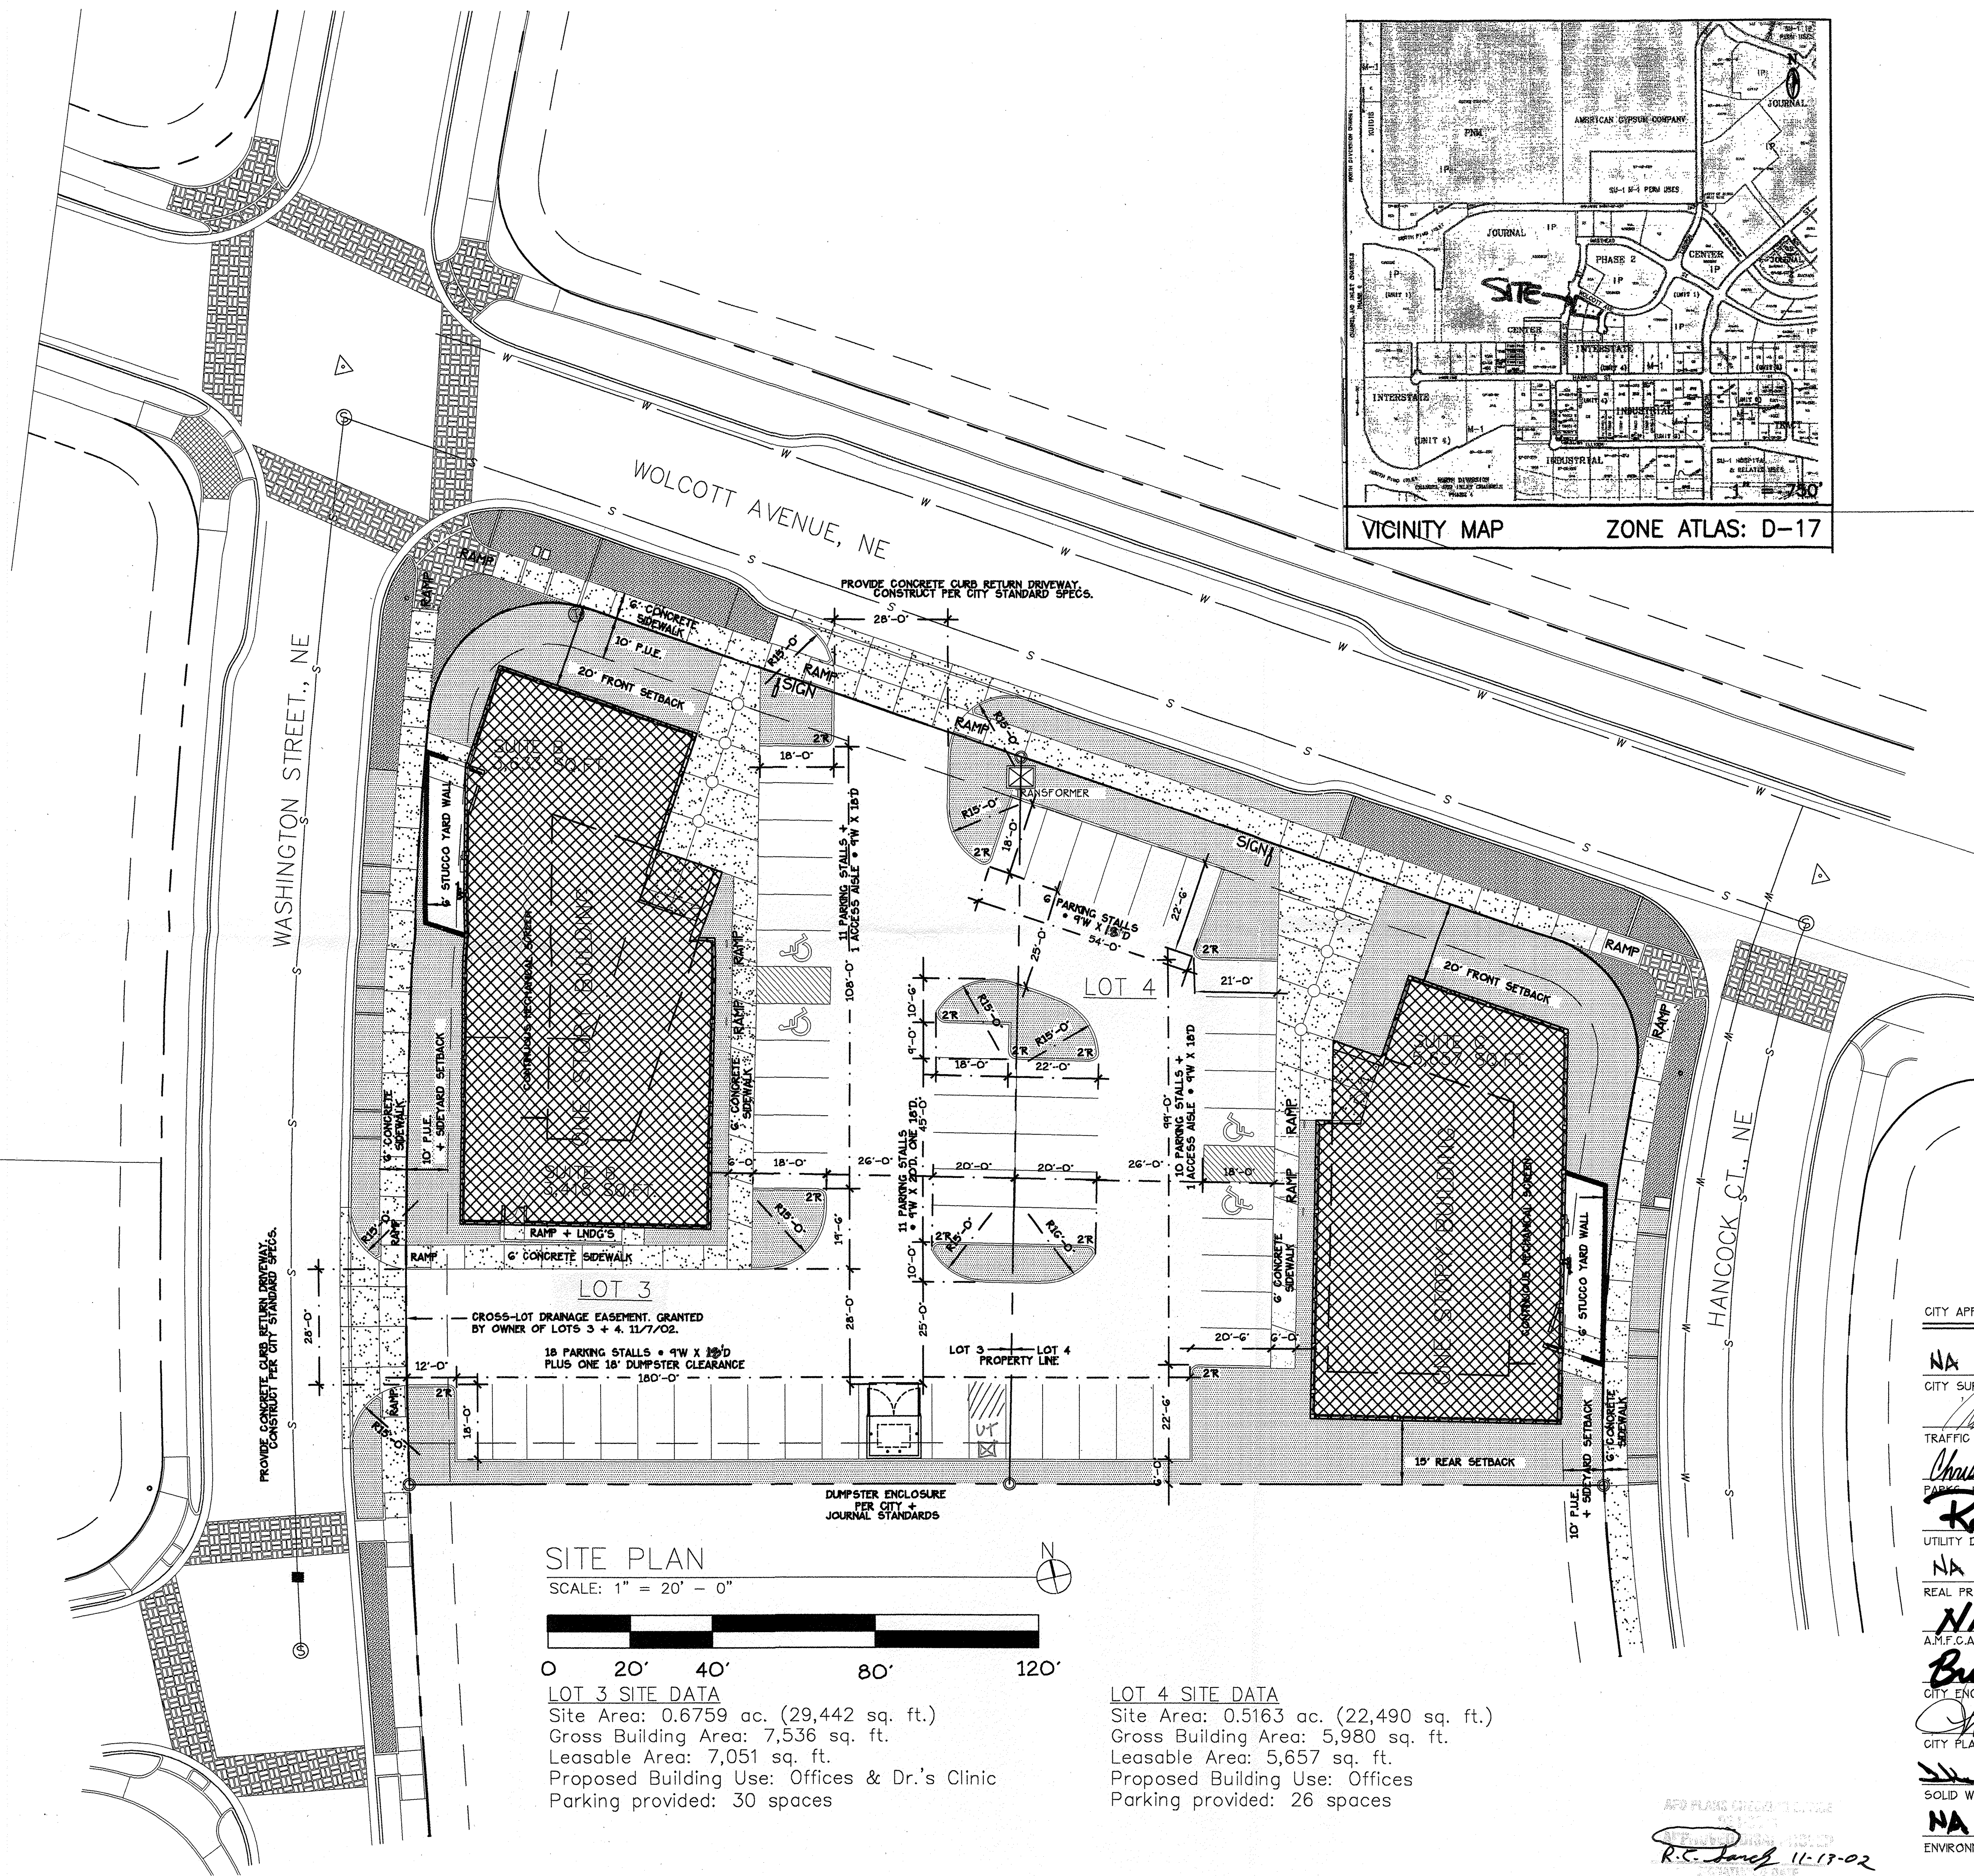

SITE PLAN

SCALE: 1" = 20' - 0"

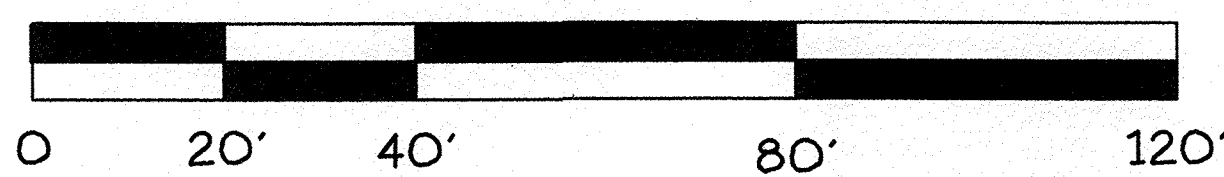


LOT 3 SITE DATA

Site Area: 0.6759 ac. (29,442 sq. ft.)
 Gross Building Area: 7,536 sq. ft.
 Leasable Area: 7,051 sq. ft.
 Proposed Building Use: Offices & Dr.'s Clinic
 Parking provided: 30 spaces

LOT 4 SITE DATA

Site Area: 0.5163 ac. (22,490 sq. ft.)
 Gross Building Area: 5,980 sq. ft.
 Leasable Area: 5,657 sq. ft.
 Proposed Building Use: Offices
 Parking provided: 26 spaces


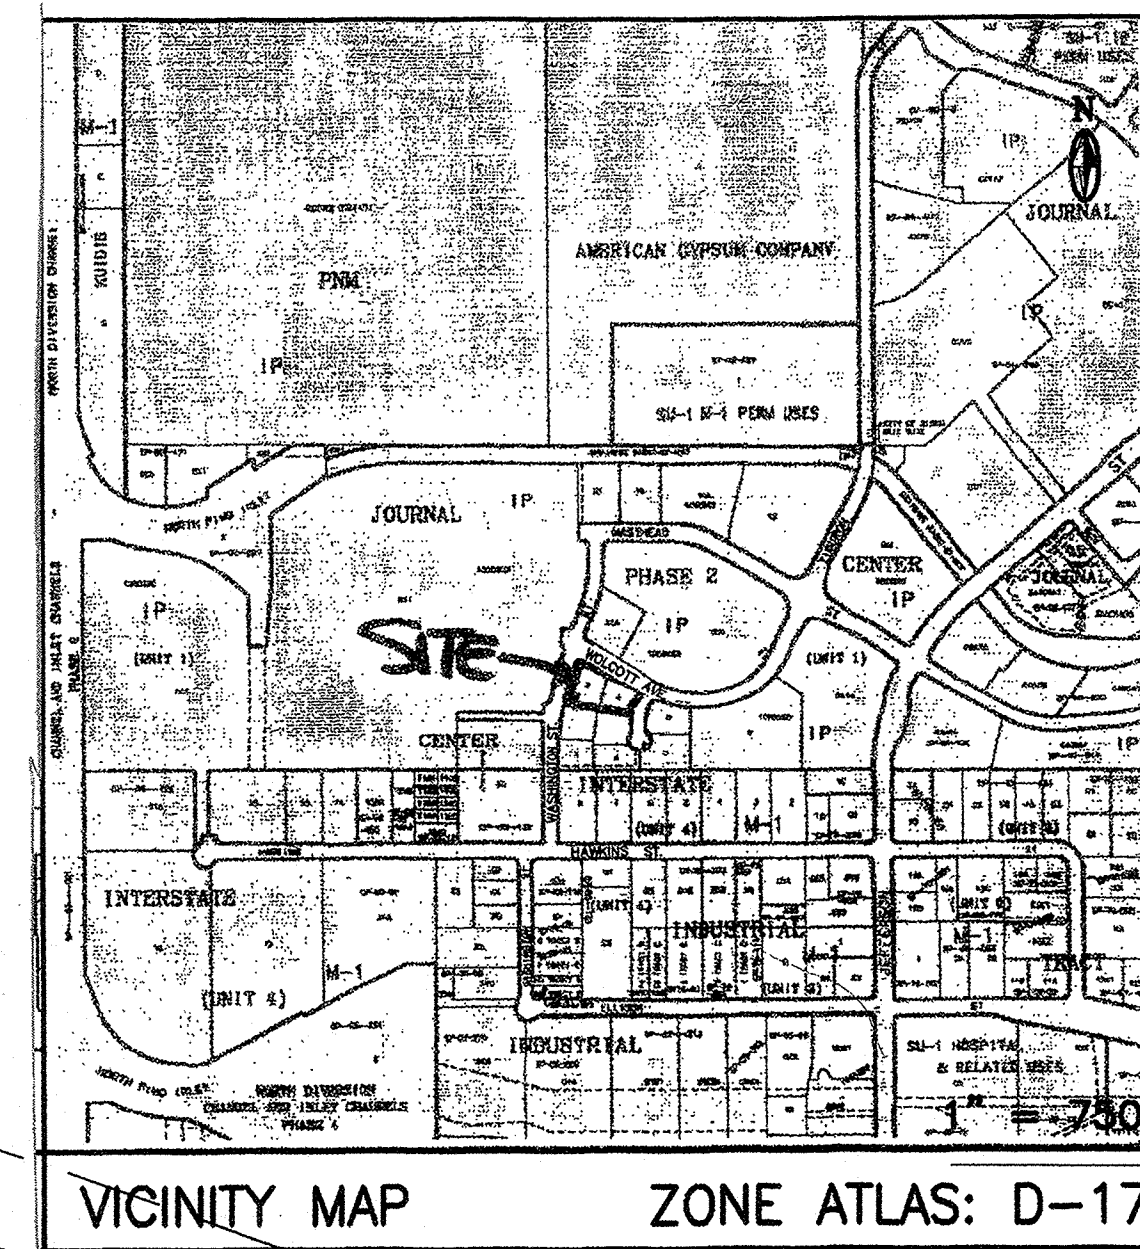


RON
 ESCUDERO
 M.D.
 4100-A

HOME
 BUILDERS
 ASSOCIATION
 OF
 CENTRAL
 NEW MEXICO
 4100-B

TYPICAL
 MONUMENT SIGN
 6' HIGH X 5' WIDE

PLAN LEGEND

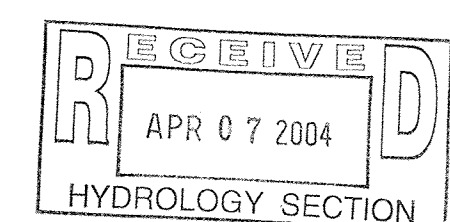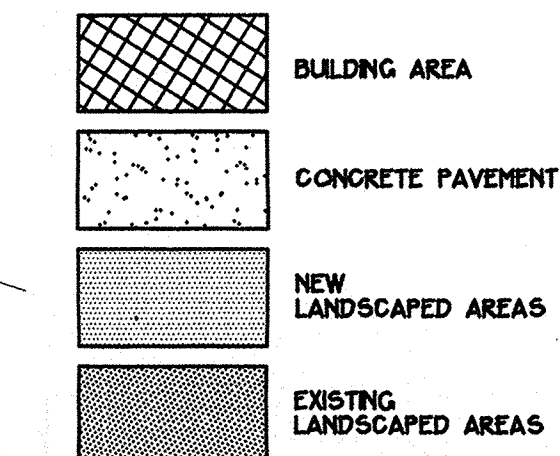

CITY APPROVALS:	PROJECT NO: 1002277
NA	02DRB-01571
CITY SURVEYOR	DATE: 11/14/02
TRAFFIC ENGINEERING	DATE: 11/13/02
Christina Sandora	DATE: 11-14-02
PARK RECREATION	
Roger A. Shum	
UTILITY DEVELOPMENT	
NA	
REAL PROPERTY DIVISION	DATE: 11/14/02
N/A	
A.M.F.C.A.	DATE: 11/13/2002
Brandy L. Bigler	
CITY ENGINEER	DATE: 11-13-02
Cherian Matson	
CITY PLANNER, ALBUQUERQUE PLANNING DIVISION	
SOLID WASTE	DATE: 11-13-02
NA	
ENVIRONMENTAL HEALTH	DATE:

DORMAN and BREEN
 RICHARD DORMAN F.A.I.A.
 ALBUQUERQUE, NM 505-299-5940
 LAURENCE BREEN A.I.A.
 SANTA FE, NM 505-982-9196

4100 Wolcott Avenue NE, Lot 3
 4110 Wolcott Avenue NE, Lot 4
 LOTS 3 & 4 JOURNAL CENTER 2
 Albuquerque, New Mexico

SHEET TITLE:
 SITE PLAN - DRB

JOB NUMBER:
 0247

DATE:
 11-8-02

REVISIONS:
 Permit Set 10-8
 Lot 4 PERMIT 627.03

C-1.1
 2 OF 22