
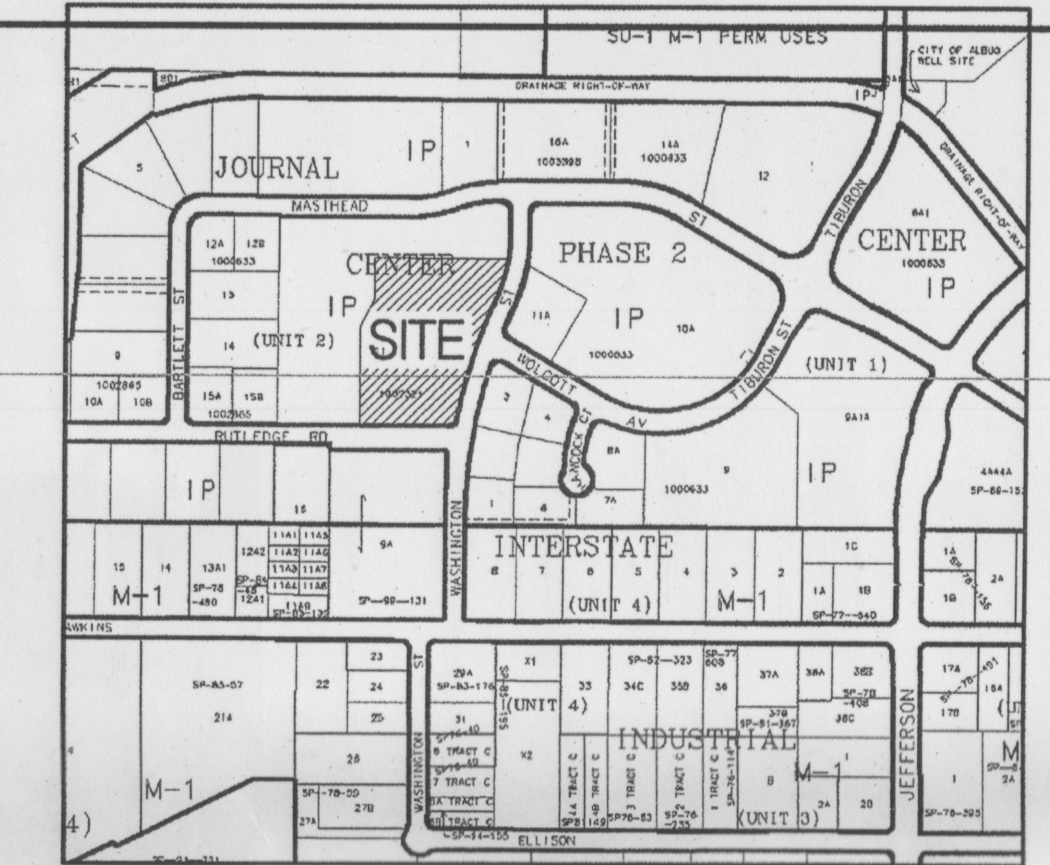




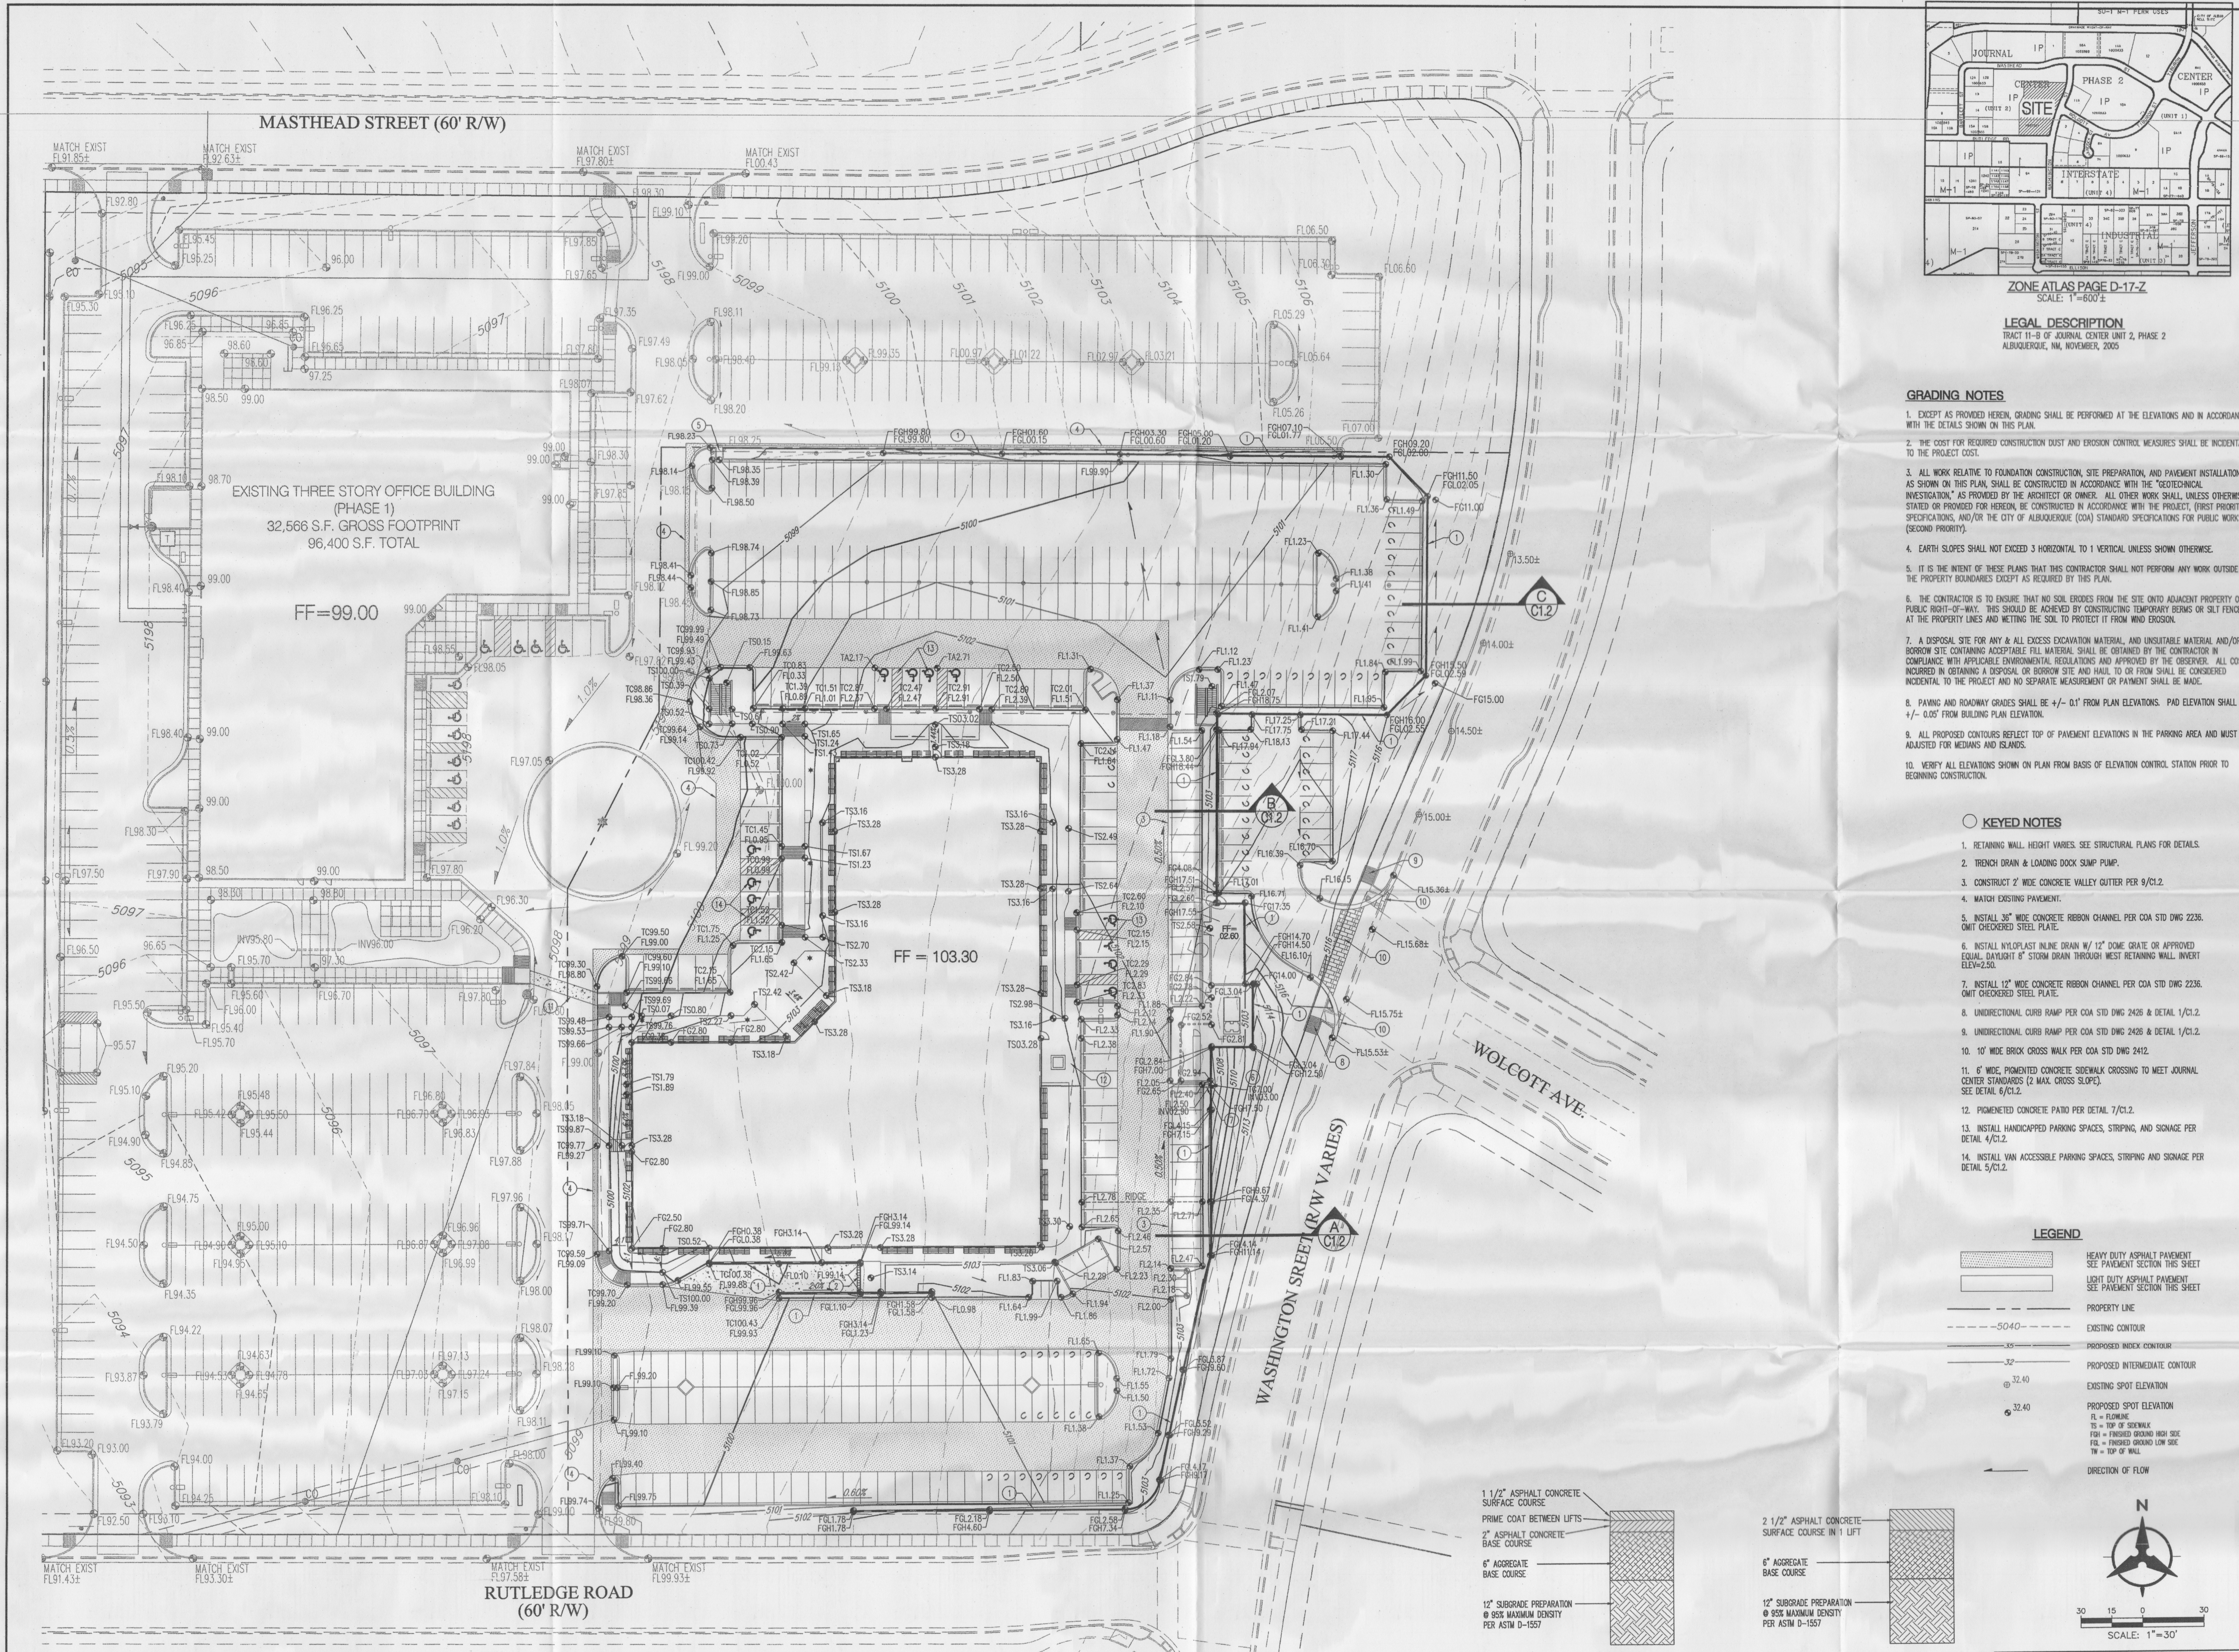


ZONE ATLAS PAGE D-17-Z
SCALE: 1"=600'
LEGAL DESCRIPTION
TRACT 11-B OF JOURNAL CENTER UNIT 2, PHASE 2
ALBUQUERQUE, NM, NOVEMBER, 2005

- GRADING NOTES**
- EXCEPT AS PROVIDED HEREIN, GRADING SHALL BE PERFORMED AT THE ELEVATIONS AND IN ACCORDANCE WITH THE DETAILS SHOWN ON THIS PLAN.
 - THE COST FOR REQUIRED CONSTRUCTION DUST AND EROSION CONTROL MEASURES SHALL BE INCIDENTAL TO THE PROJECT COST.
 - ALL WORK RELATIVE TO FOUNDATION CONSTRUCTION, SITE PREPARATION, AND PAVEMENT INSTALLATION, AS SHOWN ON THIS PLAN, SHALL BE CONSTRUCTED IN ACCORDANCE WITH THE "GEOTECHNICAL INVESTIGATION," AS PROVIDED BY THE ARCHITECT OR OWNER. ALL OTHER WORK SHALL, UNLESS OTHERWISE STATED OR PROVIDED FOR HEREON, BE CONSTRUCTED IN ACCORDANCE WITH THE PROJECT, (FIRST PRIORITY) SPECIFICATIONS, AND/OR THE CITY OF ALBUQUERQUE (COA) STANDARD SPECIFICATIONS FOR PUBLIC WORKS (SECOND PRIORITY).
 - EARTH SLOPES SHALL NOT EXCEED 3 HORIZONTAL TO 1 VERTICAL UNLESS SHOWN OTHERWISE.
 - IT IS THE INTENT OF THESE PLANS THAT THIS CONTRACTOR SHALL NOT PERFORM ANY WORK OUTSIDE OF THE PROPERTY BOUNDARIES EXCEPT AS REQUIRED BY THIS PLAN.
 - THE CONTRACTOR IS TO ENSURE THAT NO SOIL ERODES FROM THE SITE ONTO ADJACENT PROPERTY OR PUBLIC RIGHT-OF-WAY. THIS SHOULD BE ACHIEVED BY CONSTRUCTING TEMPORARY BERMS OR SILT FENCE AT THE PROPERTY LINES AND WETTING THE SOIL TO PROTECT IT FROM WIND EROSION.
 - A DISPOSAL SITE FOR ANY & ALL EXCESS EXCAVATION MATERIAL, AND UNSUITABLE MATERIAL AND/OR A BORROW SITE CONTAINING ACCEPTABLE FILL MATERIAL SHALL BE OBTAINED BY THE CONTRACTOR IN COMPLIANCE WITH APPLICABLE ENVIRONMENTAL REGULATIONS AND APPROVED BY THE OBSERVER. ALL COSTS INCURRED IN OBTAINING A DISPOSAL OR BORROW SITE AND HAIL TO OR FROM SHALL BE CONSIDERED INCIDENTAL TO THE PROJECT AND NO SEPARATE MEASUREMENT OR PAYMENT SHALL BE MADE.
 - PAVING AND ROADWAY GRADES SHALL BE +/- 0.1' FROM PLAN ELEVATIONS. PAD ELEVATION SHALL BE +/- 0.05' FROM BUILDING PLAN ELEVATION.
 - ALL PROPOSED CONTOURS REFLECT TOP OF PAVEMENT ELEVATIONS IN THE PARKING AREA AND MUST BE ADJUSTED FOR MEDANS AND ISLANDS.
 - VERIFY ALL ELEVATIONS SHOWN ON PLAN FROM BASIS OF ELEVATION CONTROL STATION PRIOR TO BEGINNING CONSTRUCTION.

- KEYED NOTES**
- RETAINING WALL, HEIGHT VARIES. SEE STRUCTURAL PLANS FOR DETAILS.
 - TRENCH DRAIN & LOADING DOCK SUMP PUMP.
 - CONSTRUCT 2' WIDE CONCRETE VALLEY CUTTER PER 9/C1.2.
 - WATCH EXISTING PAVEMENT.
 - INSTALL 36" WIDE CONCRETE REBORN CHANNEL PER COA STD DWG 2236. OMIT CHECKERED STEEL PLATE.
 - INSTALL NYLOPLAST ALINE DRAIN W/ 12" DOME GRATE OR APPROVED EQUAL. DAYLIGHT 8" STORM DRAIN THROUGH WEST RETAINING WALL. INVERT ELEV.=2.50.
 - INSTALL 12" WIDE CONCRETE REBORN CHANNEL PER COA STD DWG 2236. OMIT CHECKERED STEEL PLATE.
 - UNIDIRECTIONAL CURB RAMP PER COA STD DWG 2426 & DETAIL 1/C1.2.
 - UNIDIRECTIONAL CURB RAMP PER COA STD DWG 2426 & DETAIL 1/C1.2.
 - 10' WIDE BRICK CROSS WALK PER COA STD DWG 2412.
 - 6' WIDE, PAVEMENTED CONCRETE SIDEWALK CROSSING TO MEET JOURNAL CENTER STANDARDS (2 MAX. CROSS SLOPE). SEE DETAIL 6/C1.2.
 - PAVEMENTED CONCRETE PATIO PER DETAIL 7/C1.2.
 - INSTALL HANDICAPPED PARKING SPACES, STRIPING, AND SIGNAGE PER DETAIL 4/C1.2.
 - INSTALL VAN ACCESSIBLE PARKING SPACES, STRIPING AND SIGNAGE PER DETAIL 5/C1.2.

- LEGEND**
- HEAVY DUTY ASPHALT PAVEMENT
SEE PAVEMENT SECTION THIS SHEET
 - LIGHT DUTY ASPHALT PAVEMENT
SEE PAVEMENT SECTION THIS SHEET
 - PROPERTY LINE
 - EXISTING CONTOUR
 - PROPOSED INDEX CONTOUR
 - PROPOSED INTERMEDIATE CONTOUR
 - EXISTING SPOT ELEVATION
 - PROPOSED SPOT ELEVATION
 - FL = FLOWLINE
 - TS = TOP OF SIDEWALK
 - FGH = FINISHED GROUND HIGH SIDE
 - FWL = FINISHED GROUND LOW SIDE
 - TH = TOP OF WALL
 - DIRECTION OF FLOW

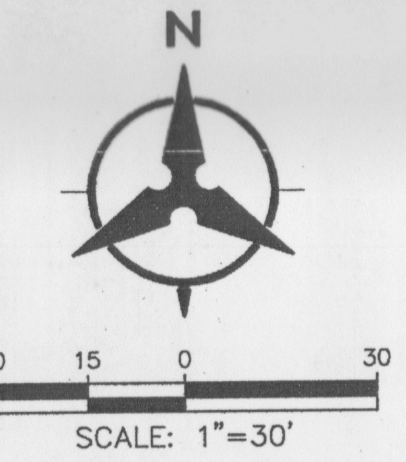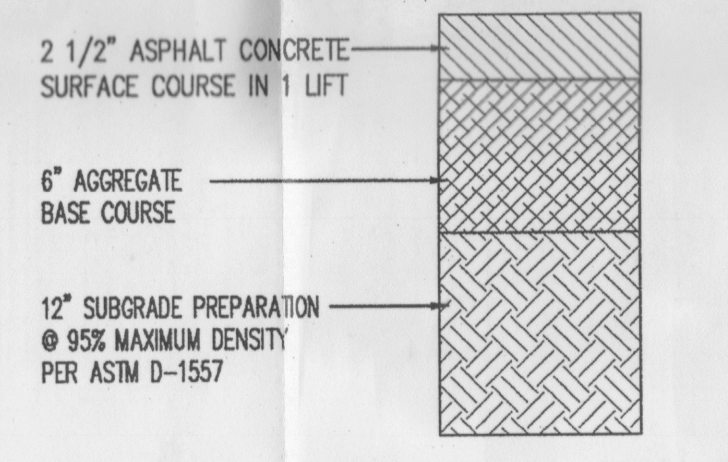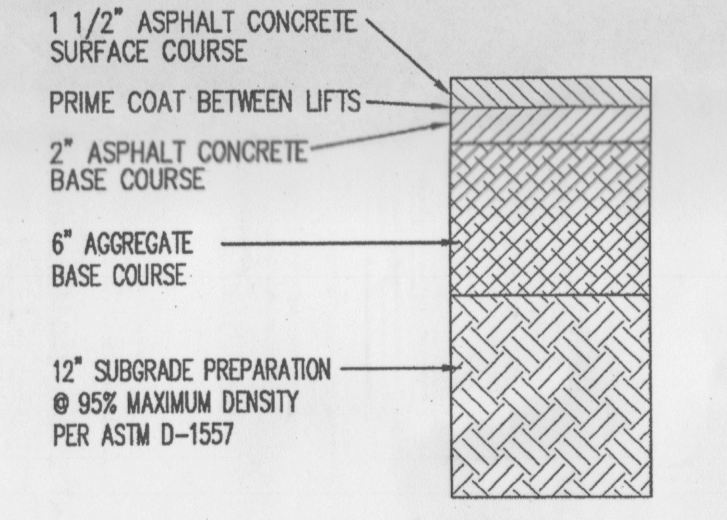

ARCHITECTS - PLANNERS - AIA

1306 RIO GRANDE BLVD NW
ALBUQUERQUE, NM 87104
505-255-6400 505-268-6954 FAX
WWW.NCA-ARCHITECTS.COM

ARCHITECT

CONSULTANT

PROJECT TITLE

**US FOREST SERVICE
PHASE II**

ALBUQUERQUE
NEW MEXICO

REVISIONS:

MK	DATE	DESCRIPTION

DRAWN BY: BO
CHECKED BY: GSB

PROJECT NUMBER:
A10.08

DATE:
09.06.10

SHEET TITLE:
GRADING & DRAINAGE PLAN


SHEET NO:
C2.0

SEP 13 2010
HYDROLOGY
SECTION

Mullen Heller
Architecture P.C.
1015 Tijeras Avenue NW
Suite 220
Albuquerque 87102
505 268 4144 [p]
505 268 4244 [f]

project title
Landlafford Development
SNC of Jefferson Street and Masthead
Albuquerque, New Mexico
sheet title
Site Development Plan for Building Permit

sheet-
A001

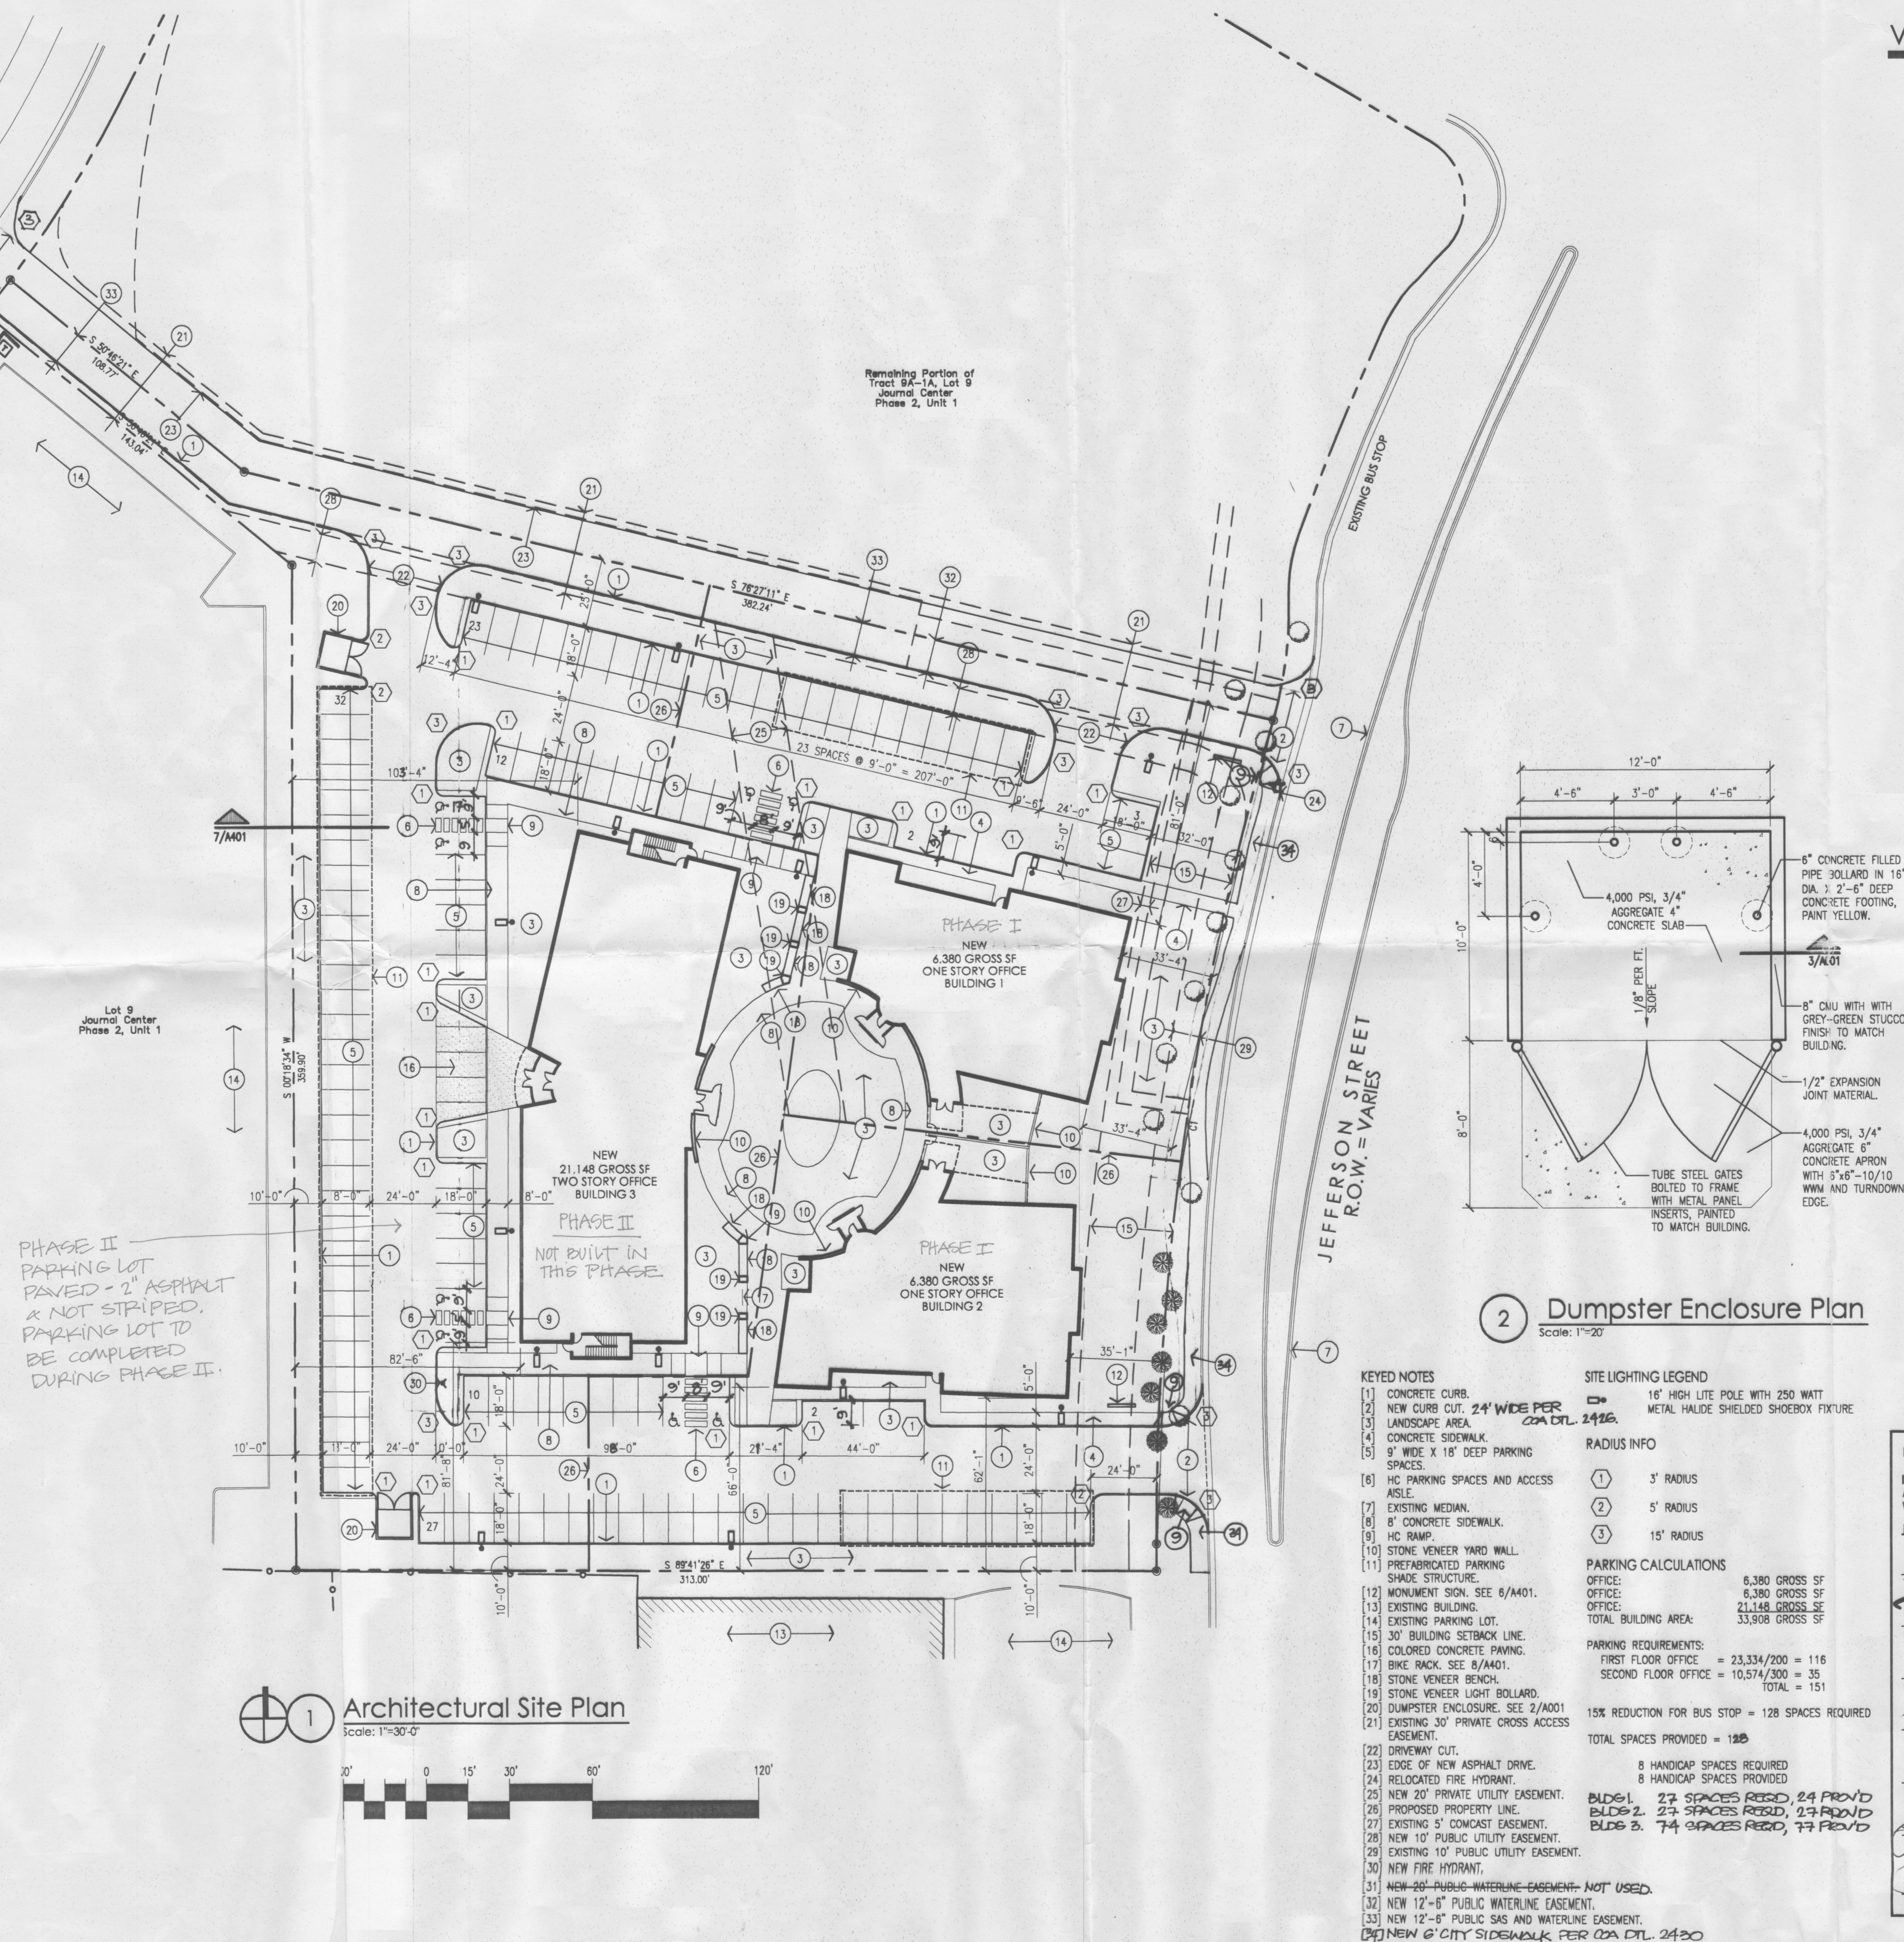


DRAINAGE CERTIFICATION


I, John M. MacKenzie, NMPE 11619, of the firm Mark Goodwin & Associates, P.A., hereby certify that this project has been graded and will drain in substantial compliance with and in accordance with the design intent of the approved plan dated 11/29/2005. The record information edited onto the original design document has been obtained by Joaquin Arqueles of the firm Joaquin Arqueles Jr. Land Surveying. I further certify that I have personally visited the project site on 8/3/2006 and have determined by visual inspection that the survey data provided is representative of actual site conditions and is true and correct to the best of my knowledge and belief. This certification is submitted in support of a request for Grading Certification approval.

The record information presented hereon is not necessarily complete and intended only to verify substantial compliance of the grading and drainage aspects of this project. Those relying on the record document are advised to obtain independent verification of its accuracy before using it for any other purpose.

John M. MacKenzie 8-3-06
JOHN M. MACKENZIE NMPE 11619
Temp. CO requested only
(Deficiencies Exist)
for Bldg on Tract 9-A-1A-2-B
& 9-A-1A-2-C

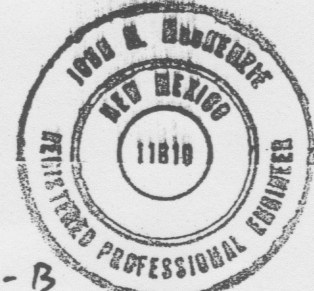

Deficiencies Addressed
Permanent CO Requested
John M. MacKenzie 8-31-06

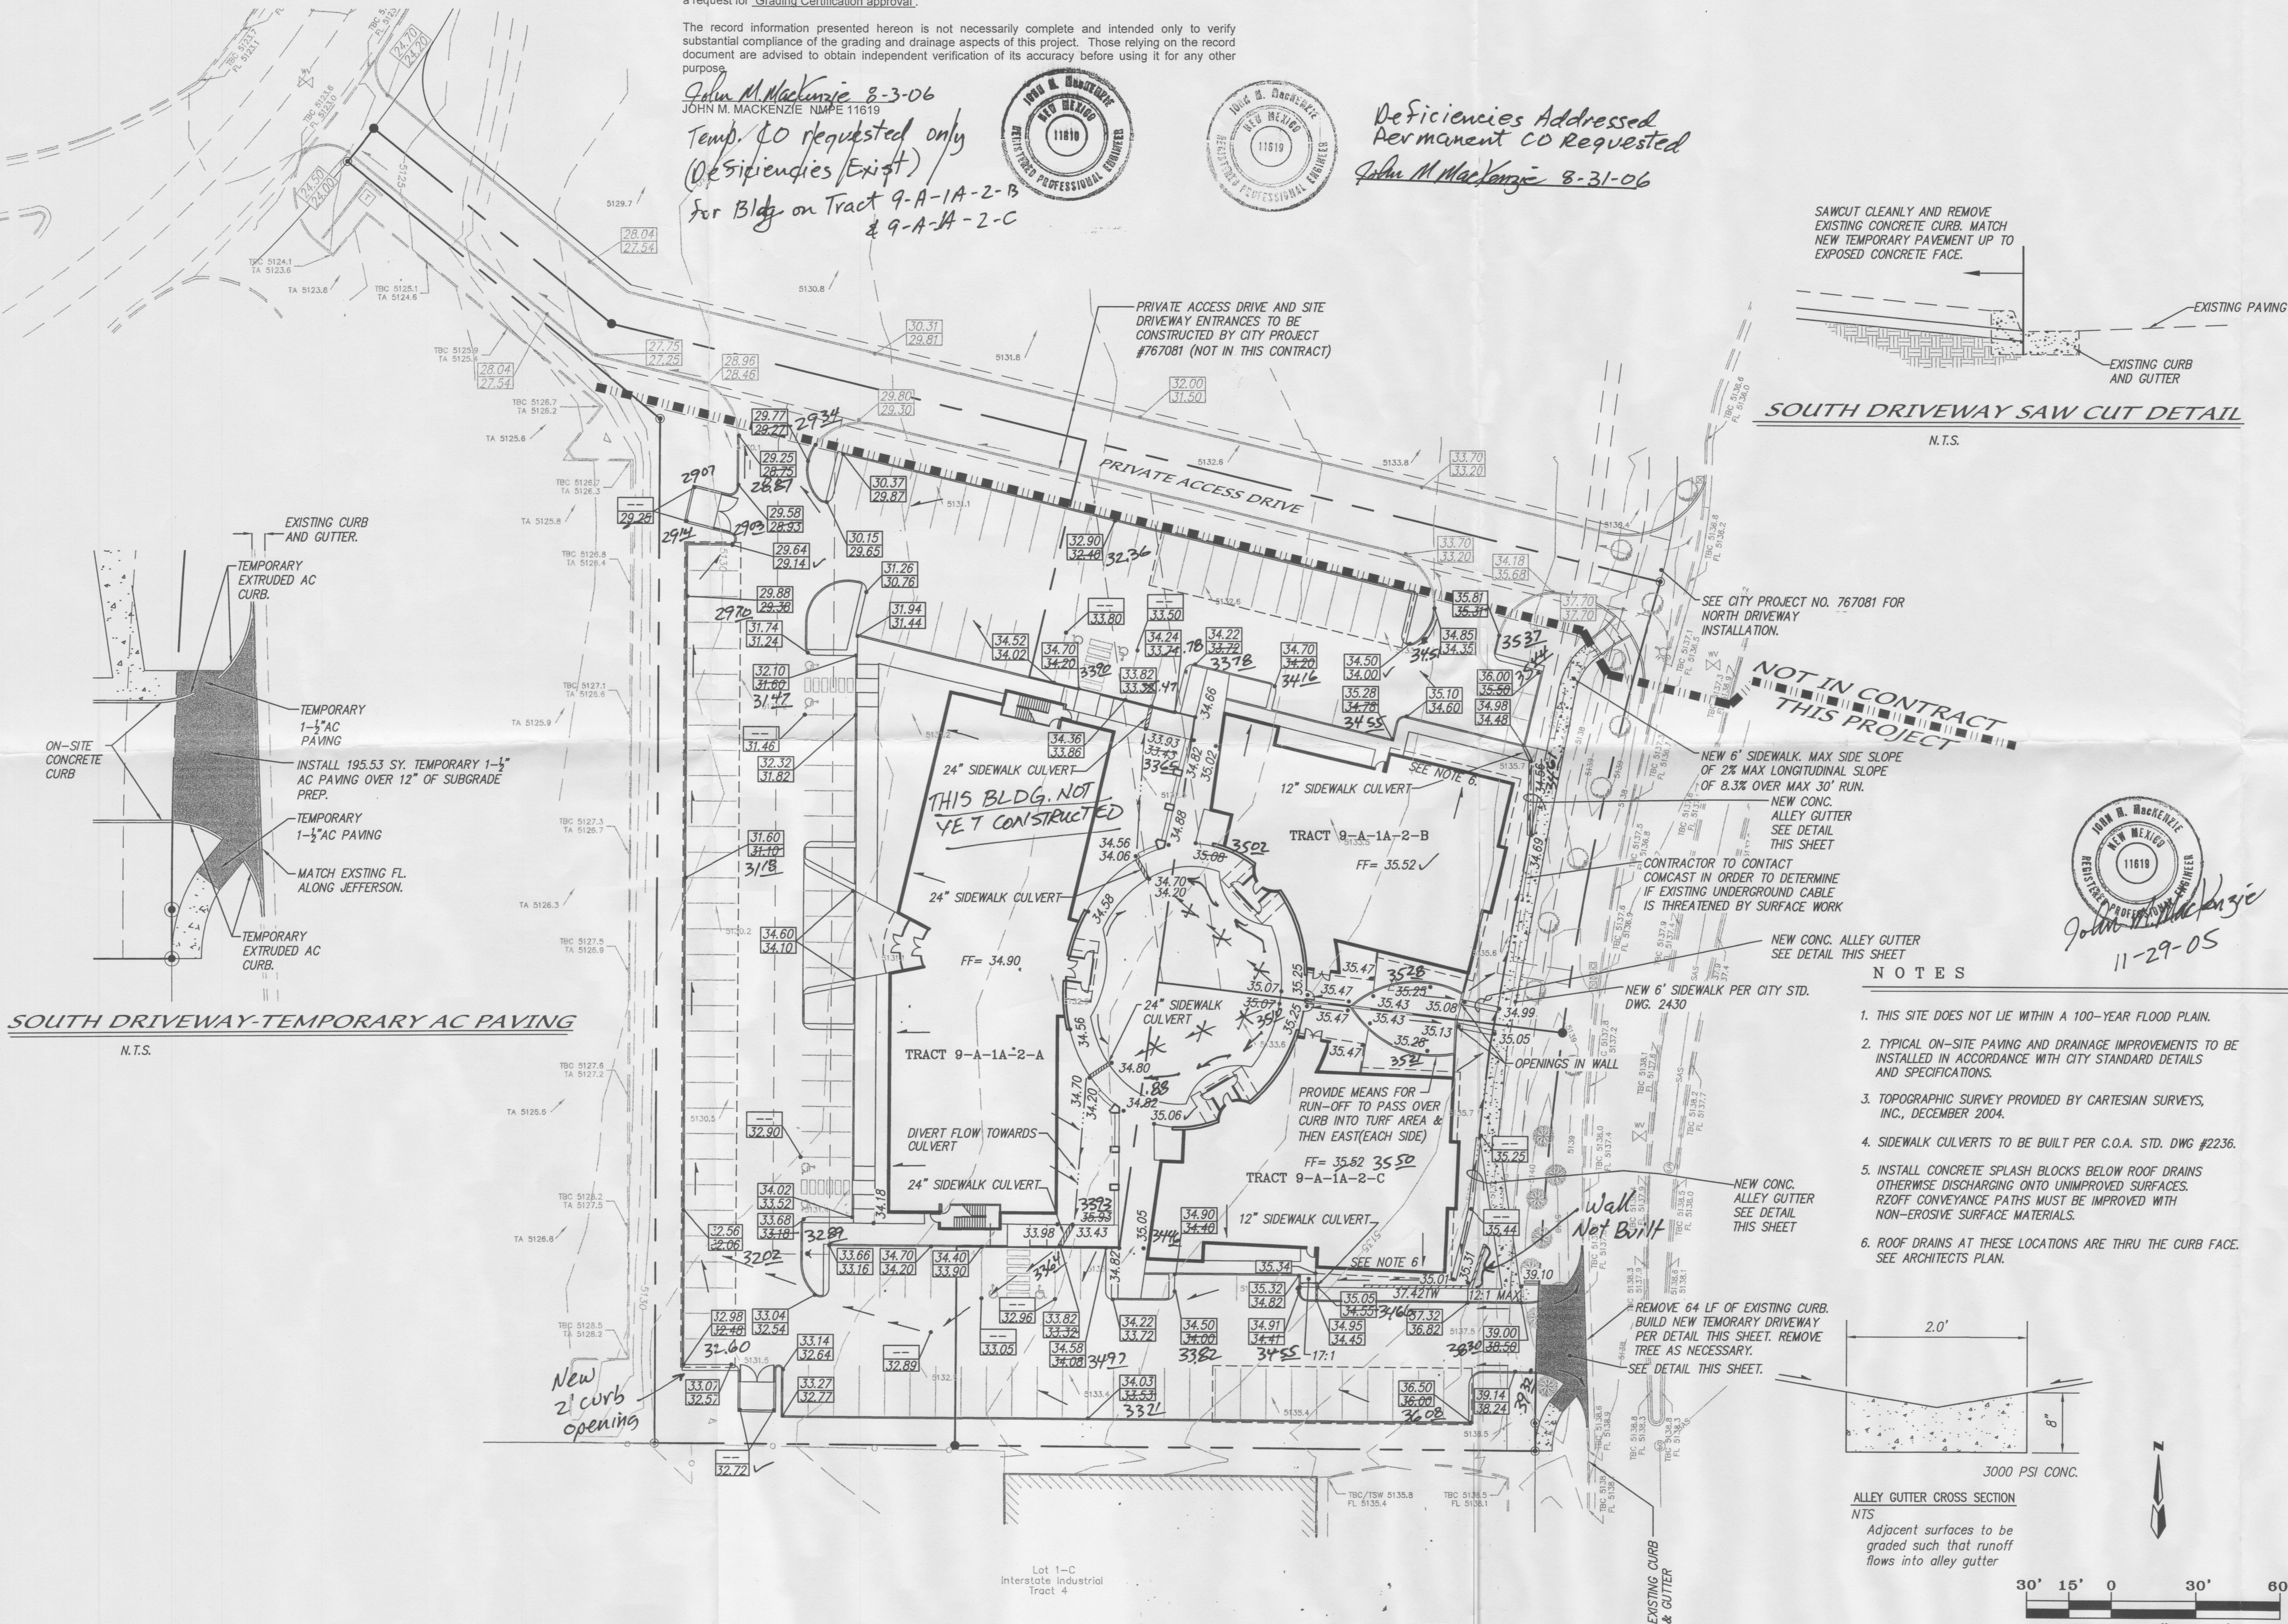

VICINITY MAP ZONE MAP: D-17-Z

ACS BENCHMARK

ACS MONUMENT "16-E 17" ELEV. = 5144.74

LEGAL DESCRIPTION


TRACT 9-A-1A-2-A, 9-A-1A-2-B, AND 9-A-1A-2-C
JOURNAL CENTER PHASE 2, UNIT 1

LEGEND


- N 90°00'00" E RECORD BEARING AND DISTANCES
- FOUND REBAR WITH CAP "LS 6544"
 - SANITARY SEWER MANHOLE
 - STORM DRAIN MANHOLE
 - FIRE HYDRANT
 - WATER VALVE
 - CHAIN LINK FENCE
 - UNDERGROUND ELECTRIC BOX
 - TRANSFORMER
 - DECIDUOUS TREE
 - CONIFEROUS TREE
 - RETAINING WALL
 - LANDSCAPE SWALE
 - FF= XX.XX
 - NEW SPOT ELEVATION
 - As Built
 - TOP OF CURB ELEVATION & FLOWLINE ELEVATION
 - FLOW DIRECTION
 - NOT IN THIS CONTRACT

NOTES

- THIS SITE DOES NOT LIE WITHIN A 100-YEAR FLOOD PLAIN.
- TYPICAL ON-SITE PAVING AND DRAINAGE IMPROVEMENTS TO BE INSTALLED IN ACCORDANCE WITH CITY STANDARD DETAILS AND SPECIFICATIONS.
- TOPOGRAPHIC SURVEY PROVIDED BY CARTESIAN SURVEYS, INC., DECEMBER 2004.
- SIDEWALK CULVERTS TO BE BUILT PER C.O.A. STD. DWG #2236.
- INSTALL CONCRETE SPLASH BLOCKS BELOW ROOF DRAINS OTHERWISE DISCHARGING ONTO UNIMPROVED SURFACES. RZOFF CONVEYANCE PATHS MUST BE IMPROVED WITH NON-EROSIVE SURFACE MATERIALS.
- ROOF DRAINS AT THESE LOCATIONS ARE THRU THE CURB FACE. SEE ARCHITECTS PLAN.

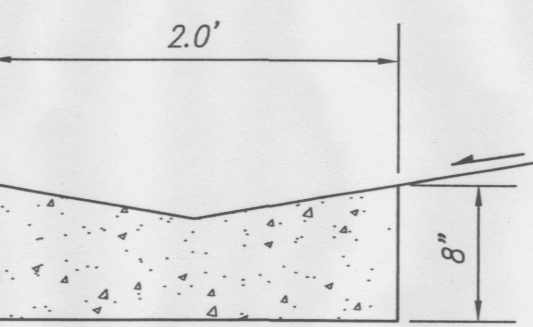

ALLEY GUTTER CROSS SECTION
N.T.S.
Adjacent surfaces to be graded such that runoff flows into alley gutter

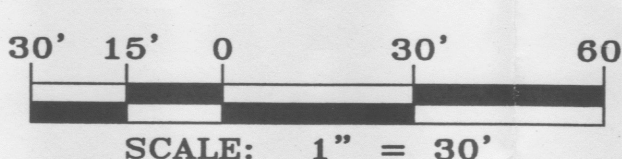

JOURNAL CENTER LAW OFFICE

GRADING & DRAINAGE PLAN

dmg MARK GOODWIN & ASSOCIATES, P.A.
CONSULTING ENGINEERS
P.O. BOX 90606
ALBUQUERQUE, NEW MEXICO 87199
(505)828-2200, FAX (505)797-9539

Designed: JMM Drawn: JCC Checked: DMG Sheet C-101
Scale: 1" = 1' Date: 9-24-05 Job: A04092