


# CITY OF ALBUQUERQUE

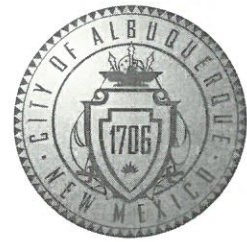

January 19, 2017

Gilbert Aldaz, PE  
Applied Engineering & Surveying Inc.  
1605 Blair Dr. NE  
Albuquerque, NM

**Re: AMAFCA  
3901 Masthead St NE  
Request Permanent C.O. - Accepted  
Engineer's Stamp dated: 9-26-16 (D17D095)  
Certification dated: 1-18-17**

Dear Mr. Valdez,


Based on the Certification received 1/17/2017, the site is acceptable for permanent release of Certificate of Occupancy by Hydrology.

PO Box 1293 If you have any questions, you can contact me at 924-3999 or Totten Elliott at 924-3982.

Albuquerque

Sincerely,

New Mexico 87103

  
Shahab Biazar, P.E.  
City Engineer, Planning Dept.  
Development Review Services


[www.cabq.gov](http://www.cabq.gov)

TE/SB

C: email Cordova, Camille C.; Miranda, Rachel; Sandoval, Darlene M.; Blocker, Lois




# AMAFCA Drainage R/W

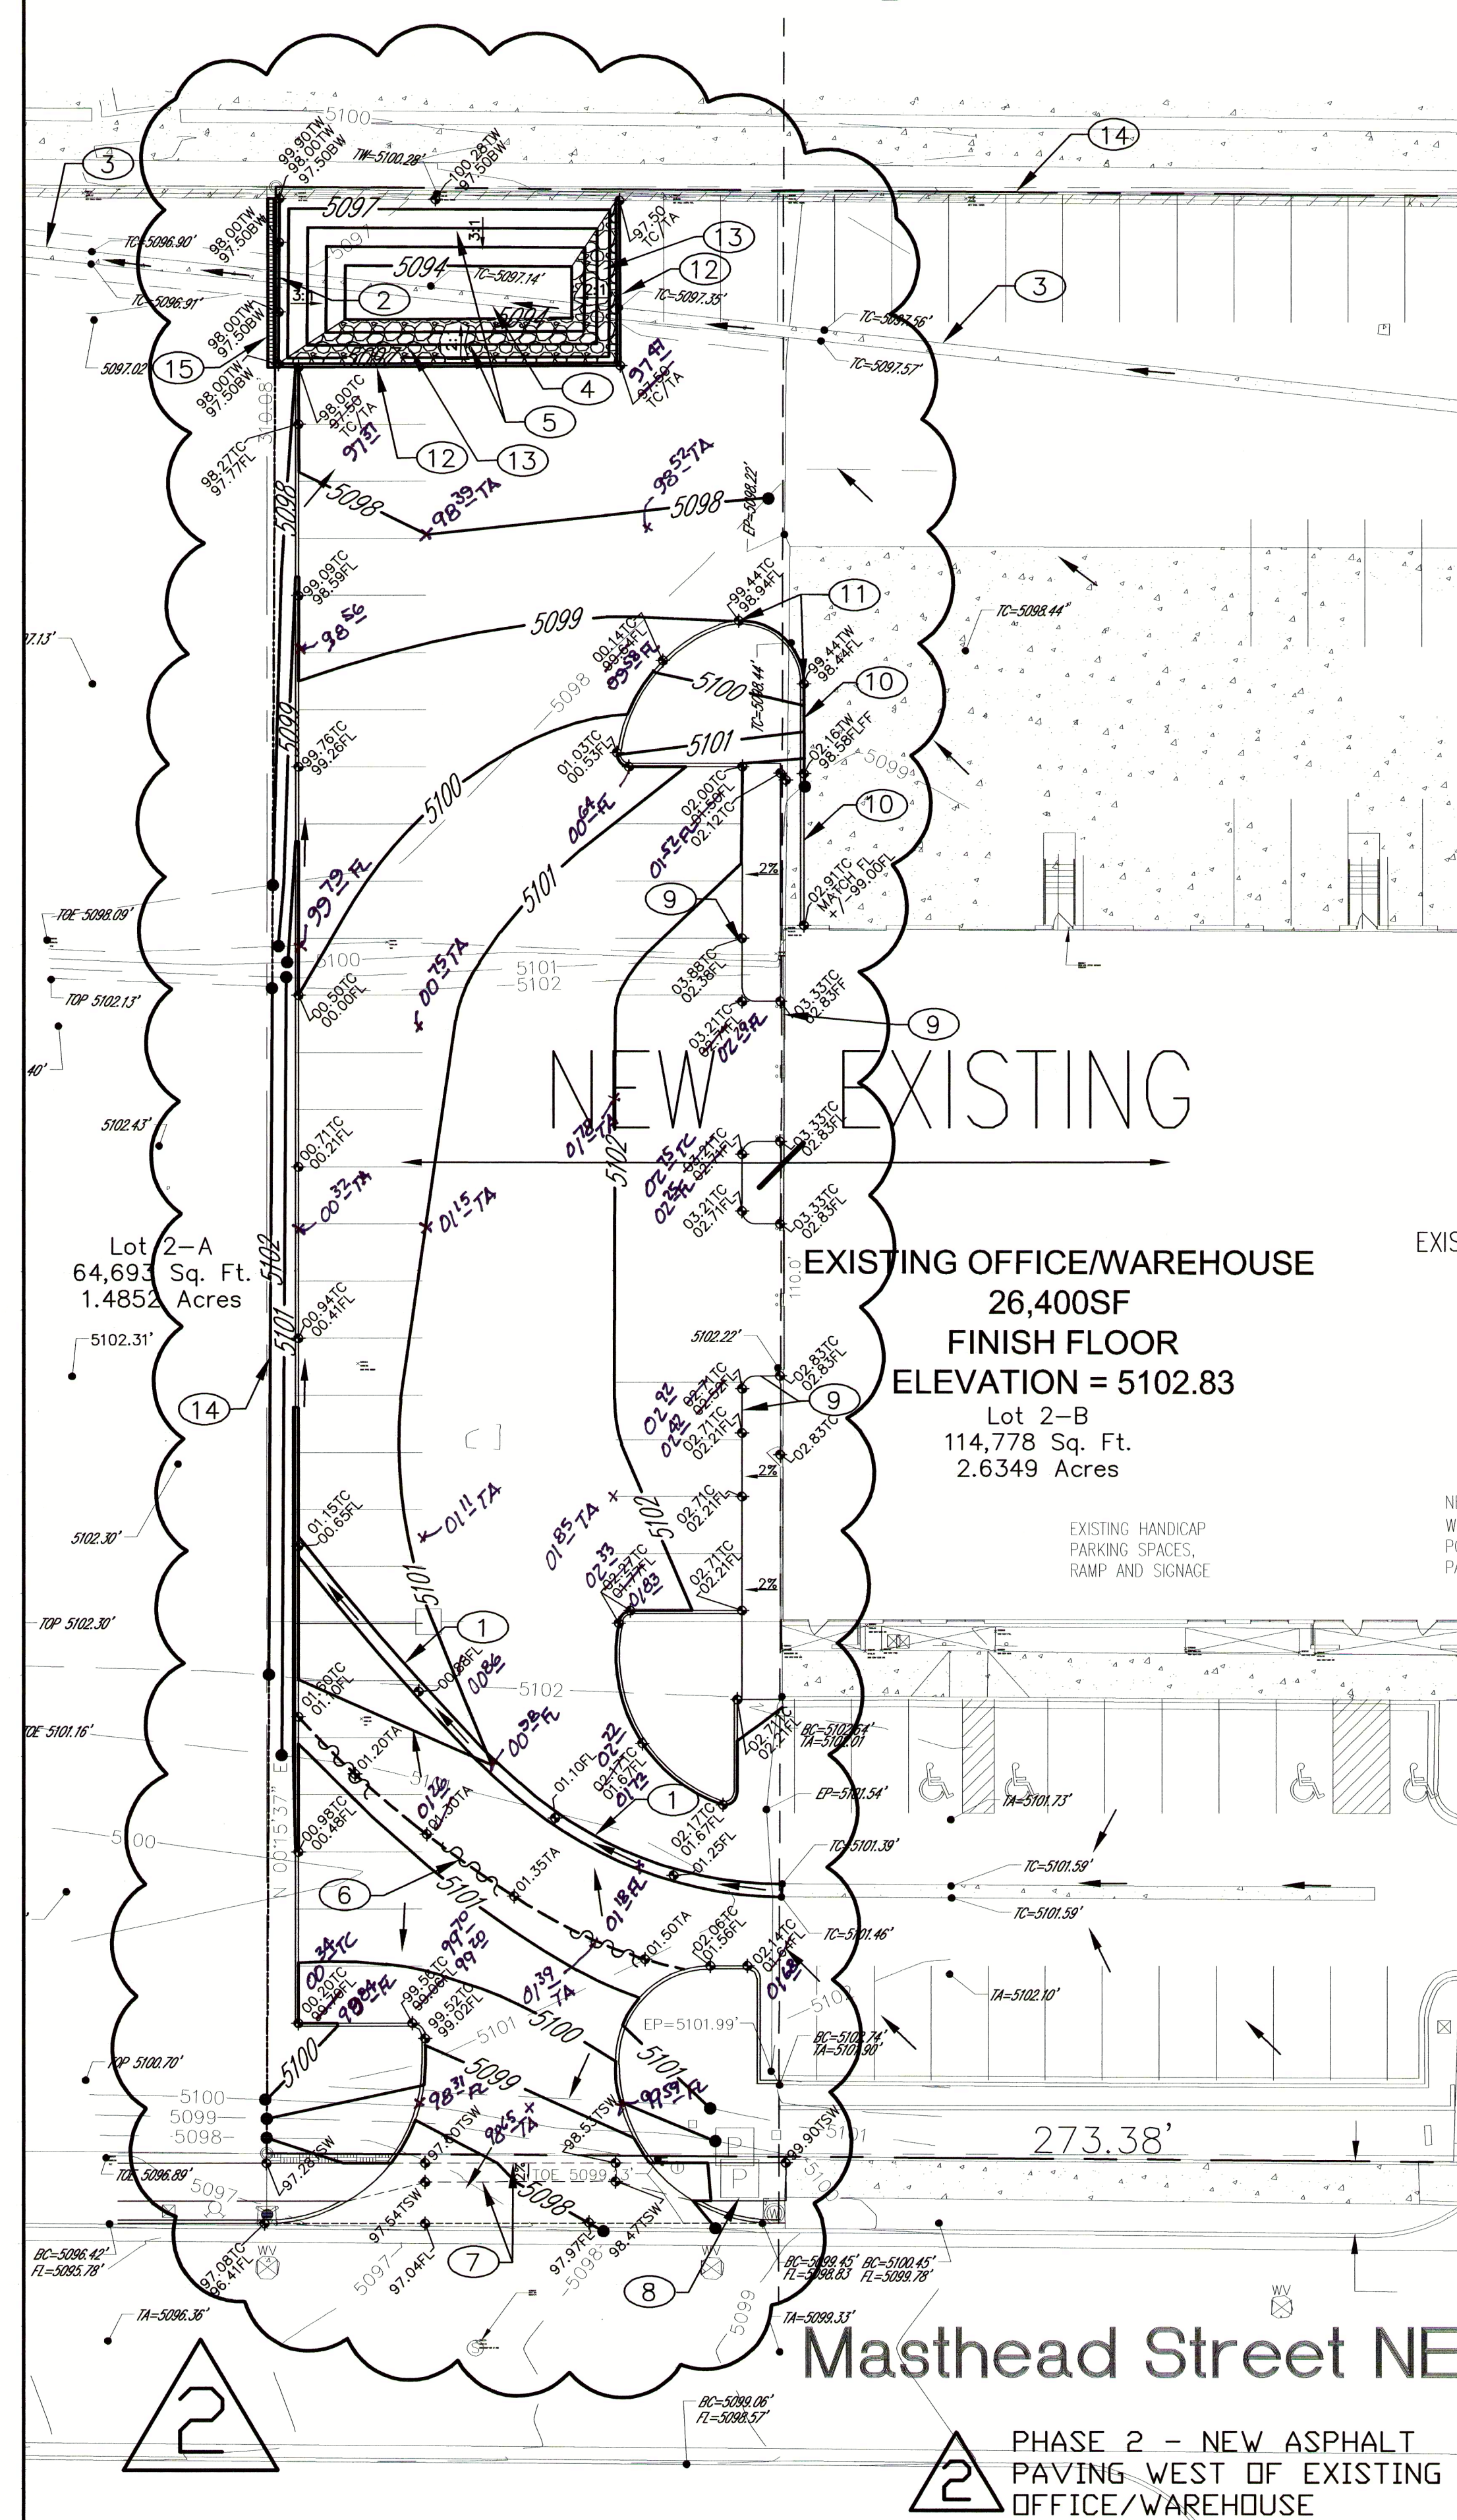

## GRADING PLAN - WEST DRIVEWAY

SCALE: 1" = 20'

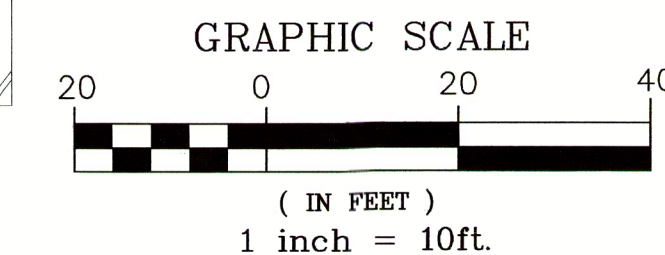

## DRAINAGE CALCULATIONS

### DRAINAGE PLAN

THE FOLLOWING ITEMS CONCERNING THE NEW STAR OFFICE/WAREHOUSE BUILDING AT 3901 MASTHEAD STREET NE, ALBUQUERQUE, NEW MEXICO, GRADING AND DRAINAGE PLAN ARE CONTAINED HEREON:

1. GRADING PLAN
2. VICINITY MAP (D-17)

### EXISTING CONDITIONS

AS SHOWN BY THE VICINITY MAP, THE SITE IS LOCATED ON THE NORTH SIDE OF MASTHEAD STREET AND TO THE EAST OF BARILETT STREET NE AT 3901 MASTHEAD STREET NE. (SEE ATTACHED VICINITY MAP (D-17)). THE PARCEL'S LEGAL DESCRIPTION IS LOT 2-B, JOURNAL CENTER PHASE 2, UNIT 1. THE PROPERTY IS BOUNDED ON THE NORTH BY THE NORTH PINO ARROYO, TO THE EAST BY LOT 1, TO THE WEST BY LOT 2-A AND TO THE SOUTH BY MASTHEAD STREET NE. THIS LOT CONTAINS APPROXIMATELY 2.63 ACRES AND THE EASTERN 3/4 IS CURRENTLY DEVELOPED WITH AN EXISTING OFFICE/WAREHOUSE AND PAVING IMPROVEMENTS.

THERE IS CURRENTLY AN APPROVED MASTER GRADING AND DRAINAGE PLAN APPROVED BY THE CITY HYDROLOGY DEPARTMENT FOR LOT 2 WHICH IS NOW CONSIDERED LOT 2-A AND LOT 2-B DUE TO A RECENT REPLAT.

### PROPOSED CONDITIONS

AS SHOWN BY THIS GRADING PLAN PREPARED FOR THIS SITE, THE INTENT IS TO SHOW THE PROPOSED GRADING FOR THE NEW ENTRY/PARKING LOT ALONG THE WESTERN 1/4 OF LOT 2-B COMPLIES WITH THE ORIGINAL LOT 2 APPROVED MASTER DRAINAGE PLAN, WHERE ALL FLOW FROM THESE IMPROVEMENTS WILL DISCHARGE TO THE NORTHWEST CORNER OF LOT 2-B AND DISCHARGE INTO AN EXISTING 2' WIDE CONCRETE SWALE THAT RUNS ALONG THE ENTIRE NORTH BOUNDARY OF LOT 2-A AND ULTIMATELY OUTFALLS INTO AN EXISTING RUNDOWN AT THE NORTHWEST CORNER OF LOT 2-A, WHICH DISCHARGES INTO THE AMAFCA MAINTAINED NORTH PINO.

### DRAINAGE CALCULATIONS

1. PRECIPITATION ZONE = 2
2. DESIGN STORM = DEPTH (INCHES) AT 100-YEAR STORM  
6-HOUR = 2.35 INCHES  
24-HOUR = 2.75 INCHES  
10 DAY = 3.75 INCHES
3. PEAK DISCHARGE (CFS/ACRE) FIR 100-YEAR, ZONE 2, TABLE A-2:  
 $Q = 1.56 \text{ CFS/ACRE SOIL UNCOMPACTED "A"}$   
 $Q = 2.28 \text{ CFS/ACRE LANDSCAPED "B"}$   
 $Q = 3.14 \text{ CFS/ACRE COMPACTED SOIL "C"}$   
 $Q = 4.70 \text{ CFS/ACRE IMPERVIOUS AREA "D"}$   
FOR WATERSHEDS LESS THAN OR EQUAL TO 40 ACRES
4. EXCESS PRECIPITATION, E (INCHES), 6 HOUR STORM, ZONE 2, TABLE A-8:  
 $E = 0.53 \text{ INCHES SOIL UNCOMPACTED "A"}$   
 $E = 0.78 \text{ INCHES LANDSCAPED "B"}$   
 $E = 1.13 \text{ INCHES COMPACTED SOIL "C"}$   
 $E = 2.12 \text{ INCHES IMPERVIOUS AREA "D"}$

### PROPOSED CONDITIONS ON SITE:

TOTAL AREA = 114,778 SF = 2.63 ACRES  
BASIN D-1  
IMPERVIOUS AREA EXISTING:  
EXISTING BUILDING ROOF AREA = 26,400 SF = 0.61 AC  
EXISTING EMPLOYEE PARKING LOT AREA, LOADING DOCK AREA AND SIDEWALK AREA = 55,750 SF = 1.26 AC  
EXISTING LANDSCAPING AREA = 7,650 SF = 0.18 AC

IMPERVIOUS AREA PROPOSED:  
NEW PROPOSED PAVING AREA = 19,050 SF = 0.44 AC  
NEW LANDSCAPED AREA PROPOSED = 2,778 SF = 0.06 AC  
 $Q(\text{PROPOSED-6HR}) = (2.28 \times 0.24) + (4.70 \times 2.32) = 11.45 \text{ CFS PROPOSED ONSITE FLOW INTO NORTHWEST CORNER LOT 2-A}$   
 $V(\text{PROPOSED-6HR}) = ((0.78 \times 0.24) + (2.12 \times 2.32)) / 12 \times 43.560 = 18.543 \text{ CF} = 0.43 \text{ AC-FT PROPOSED VOLUME INTO NORTHWEST CORNER LOT 2-A}$

BASIN D-2  
IMPERVIOUS AREA PROPOSED:  
NEW PROPOSED PAVING AREA = 2,125 SF = 0.05 AC  
NEW LANDSCAPED AREA PROPOSED = 1,400 SF = 0.03 AC  
 $Q(\text{PROPOSED-6HR}) = (2.28 \times 0.03) + (4.70 \times 0.05) = 0.37 \text{ CFS PROPOSED ONSITE FLOW INTO MASTHEAD STREET NE}$   
 $V(\text{PROPOSED-6HR}) = ((0.78 \times 0.03) + (2.12 \times 0.05)) / 12 \times 43.560 = 470 \text{ CF} = 0.01 \text{ AC-FT PROPOSED VOLUME INTO MASTHEAD STREET NE}$

7. SIZE RUNDOWN CURB OPENING AT NORTHWEST CORNER:  
 $Q(\text{PROPOSED-6HR}) = 11.45 \text{ CFS PROPOSED ONSITE FLOW INTO NORTHWEST CORNER LOT 2-A}$   
CHECK WEIR CAPACITY:  
 $Q(\text{CAPACITY}) = C \times L \times H^{3/2}$   
 $L = Q / C \times H^{3/2}$   
 $Q = 11.45 \text{ CFS}, H = 0.5 \text{ FEET}, C = 3$   
 $L = 11.45 / (3 \times 0.5^{3/2}) = 10.79 \text{ FEET}$   
USE 11 FEET WIDTH > 10.79 FEET - OK

8. FIRST FLUSH STORM WATER CONTROL MEASURES PER ORDINANCE Q-2013016  
FOR THE PURPOSES OF THE ORDINANCE THE 90TH PERCENTILE STORM EVENT IS 0.44 INCHES FROM IMPERVIOUS AREAS - 0.1" EVAPORATION = 0.34"  
 $V(\text{FIRST FLUSH}) = 0.34" \times \text{TREATMENT "D"} = (0.34" / 12") \times 101,200 \text{ SF} = 2.867 \text{ CF REQUIRED TO BE DETAINED FOR FIRST FLUSH}$   
 $V(\text{PROVIDED AT NORTHWEST CORNER}) = (1.3775 \text{ FT} \times 101,200 \text{ SF} \times 2985 \text{ SF}) \text{ AT EL. 94.0} / 2 \times 3.5 \text{ FEET DEPTH} = 2.931 \text{ CF PROVIDE VOLUME PROVIDE} = 2.931 \text{ CF} > 2.867 \text{ CF REQUIRED - OK}$


## LEGEND

- 5098 - PROPOSED ELEVATION GRADE
- 5100 - EXISTING ELEVATION GRADE
- DRAINAGE FLOW DIRECTION
- AS-BUILT NEW TOP OF CURB ELEVATION
- AS-BUILT NEW FLOWLINE OF CURB ELEVATION
- AS-BUILT NEW TOP OF ASPHALT ELEVATION
- AS-BUILT NEW TOP OF SIDEWALK ELEVATION
- EXISTING ELEVATION

## CONSTRUCTION NOTES:

1. CONSTRUCT 2' WIDE CONCRETE SWALE.
2. 11' WIDE WEIR OPENING IN CUTOFF WALL CENTERED OVER EXISTING CONCRETE SWALE ALLOW FLOWS TO DISCHARGE FROM THIS SITE TO ADJACENT LOT, DO NOT BLOCK FLOWS WITH WALL, SEE DETAIL THIS SHEET.
3. EXISTING 2' WIDE CONCRETE SWALE
4. SAWCUT AND REMOVE EXISTING 2' WIDE CONCRETE SWALE WITHIN POND LIMITS WITH EAST & SOUTH SIDESLOPE S
5. CONSTRUCT NEW RETENTION POND PER GRADES SHOWN AT 2:1 SIDESLOPES AT WITH TOP OF POND ELEVATION = 97.50 FOR RETAINING FIRST FLUSH VOLUME. NORTH AND WEST AT 3:1
6. HIGH POINT/WATER BLOCK.
7. 3' WIDE ADA RAMP AT 2% MAXIMUM CROSS SLOPE ALONG DRIVEWAY.
8. ADJUST MANHOLE RIM ELEVATION TO MATCH NEW SIDEWALK GRADE PER CITY STDS.
9. TRANSITION FROM 0" TO 6" CURB HEIGHT.
10. CONSTRUCT RETAINING WALL TO NEW GRADES SHOW, DESIGNED BY OTHERS.
11. TRANSITION FROM RETAINING WALL TO 6" CURB
12. CONSTRUCT 8" WIDE X 24" DEEP CUTOFF WALL PER CITY STD. DWG. 2415B AT SOUTH AND EAST SIDE OF NEW RETENTION POND.
13. PLACE 8" THICKNESS OF 3"-4" FRACTURED STONE WITH FILTER BLANKET UNDERNEATH STONE PER LIMITS SHOWN.
14. EXISTING PROPERTY LINE.
15. PLACE AND STAKE A 28' LONG WADDLE SOCK AT THE WEST END OF THE NEW CONCRETE CUTOFF WALL DURING CONSTRUCTION REMOVE WHEN ALL CONSTRUCTION COMPLETE.

## VICINITY MAP D-17

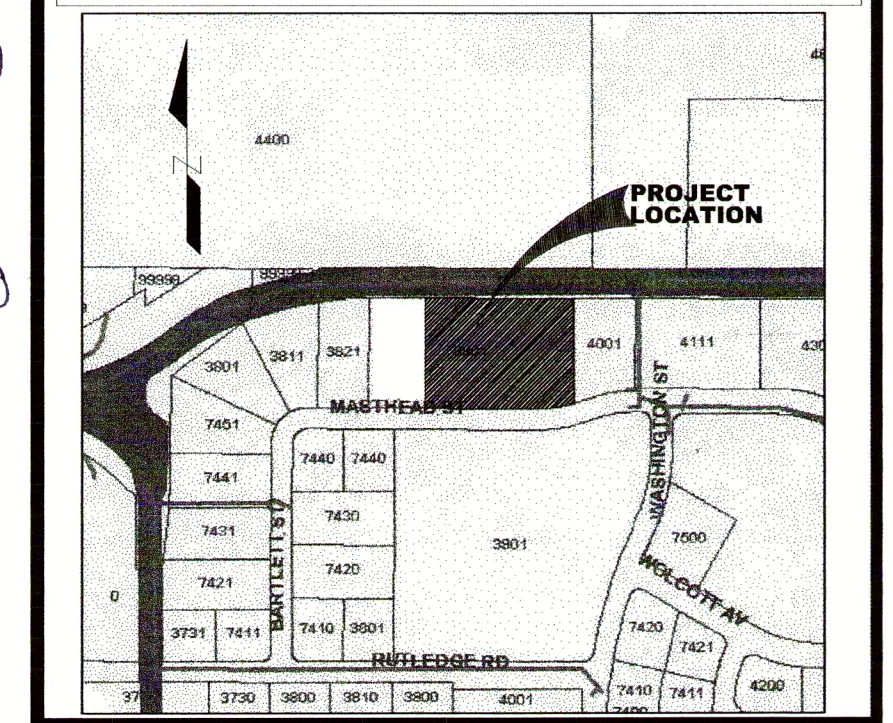


I, GILBERT ALDAZ, NMPE 10849, OF THE FIRM APPLIED ENGINEERING & SURVEYING, INC., HEREBY CERTIFY THAT THIS PROJECT HAS BEEN GRADED AND WILL DRAIN IN SUBSTANTIAL COMPLIANCE WITH AND IN ACCORDANCE WITH THE DESIGN INTENT OF THE APPROVED PLAN DATED SEPTEMBER 26, 2016. THE RECORD INFORMATION EDITED ONTO THE ORIGINAL DESIGN DOCUMENT HAS BEEN OBTAINED BY TIM S. MARTINEZ PS NO. 19982. I FURTHER CERTIFY THAT I HAVE PERSONALLY VISITED THE PROJECT SITE ON JANUARY 16, 2017 AND HAVE DETERMINED BY VISUAL INSPECTION THAT THE SURVEY DATA PROVIDED IS REPRESENTATIVE OF ACTUAL SITE CONDITIONS AND IS TRUE AND CORRECT TO THE BEST OF MY KNOWLEDGE AND BELIEF. THIS CERTIFICATION IS SUBMITTED IN SUPPORT OF A REQUEST FOR CERTIFICATION OF OCCUPANCY.

(DESCRIBE ANY EXCEPTIONS AND/OR QUALIFICATIONS HERE IN A SEPARATE PARAGRAPH) NONE NOTED. SEE REVISION A  
(DESCRIBE ANY DEFICIENCIES AND/OR REQUIRED CORRECTIONS HERE IN A SEPARATE PARAGRAPH) NONE NOTED.

THE RECORD INFORMATION PRESENTED HEREON IS NOT NECESSARILY COMPLETE AND INTENDED ONLY TO VERIFY SUBSTANTIAL COMPLIANCE OF THE GRADING AND DRAINAGE ASPECTS OF THIS PROJECT. THOSE RELYING ON THIS RECORD DOCUMENT ARE ADVISED TO OBTAIN INDEPENDENT VERIFICATION OF ITS ACCURACY BEFORE USING IT FOR ANY OTHER PURPOSES.

Gilbert Aldaz  
GILBERT ALDAZ, NMPE 10849  
01-18-18  
DATE

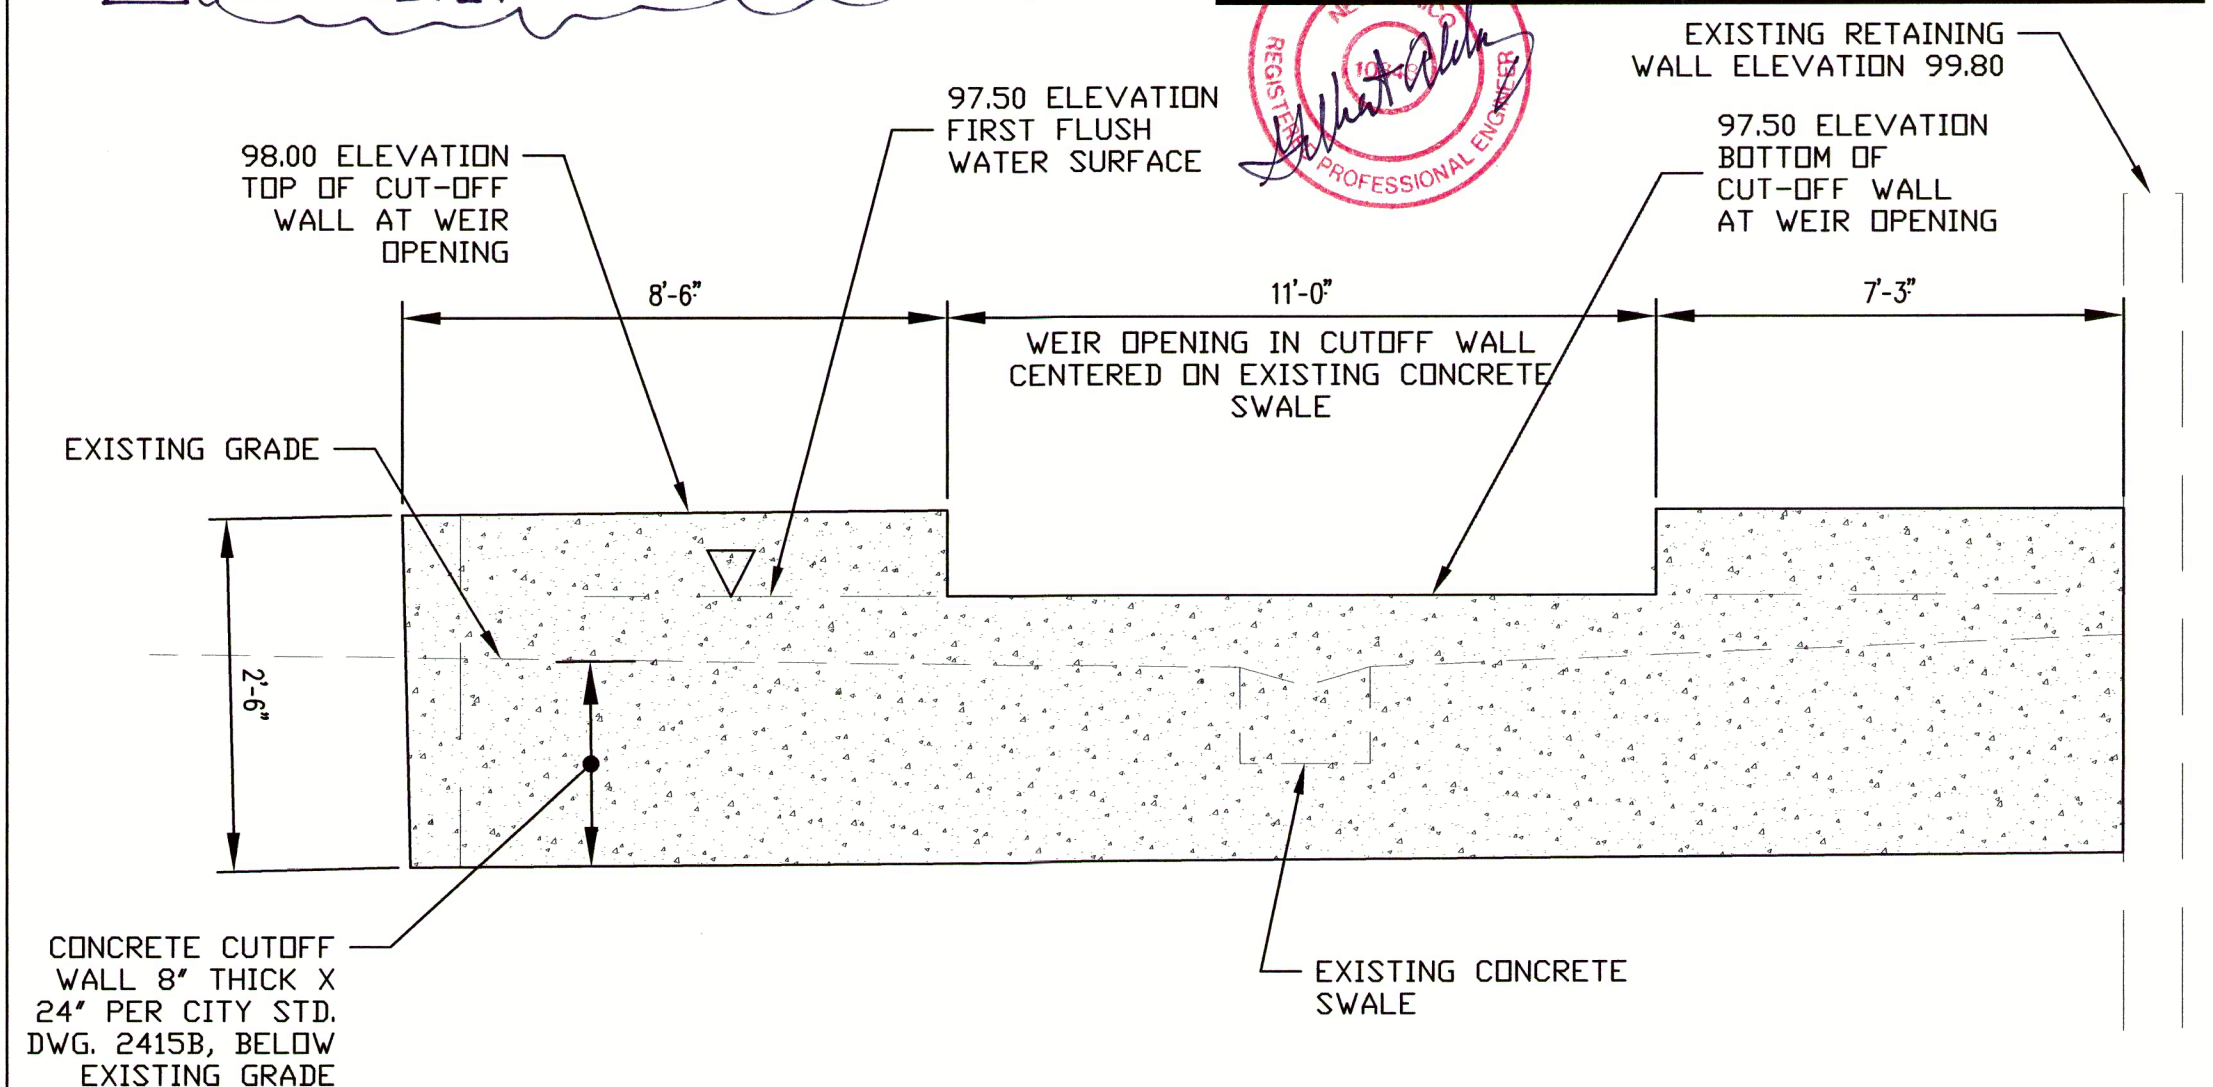

## WEIR OPENING AT NW CORNER - LOOKING WEST

SCALE: N.T.S.


## DRAINAGE AND GRADING PLAN 3901 MASTHEAD STREET NE

APPLIED ENGINEERING AND  
SURVEYING, INC.  
ENGINEERS AND PLANNERS  
1605 Blvd Drive NE  
Albuquerque, New Mexico 87112  
Office: (505) 480-8125  
gab@aeandp.com

DATE/REVISIONS:  
09/26/16 - City  
Comments  
09/27/16 - City  
Comments  
SHEET NUMBER:

1 OF 1



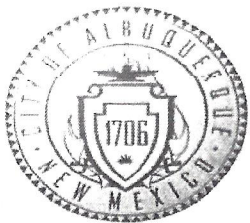

# City of Albuquerque

Planning Department

Development & Building Services Division

## DRAINAGE AND TRANSPORTATION INFORMATION SHEET (REV 09/2015)

Project Title: 3901 Masthead Street NE Building Permit #: \_\_\_\_\_ City Drainage #: D17/D095  
DRB#: \_\_\_\_\_ EPC#: \_\_\_\_\_ Work Order#: \_\_\_\_\_  
Legal Description: Lot 2-B, JOURNAL CENTER PHASE 2, UNIT 1  
City Address: 3901 Masthead Street NE  
Engineering Firm: APPLIED ENGINEERING & SURV INC Contact: GILBERT ALDAZ  
Address: 1605 BLAIR DRIVE NE  
Phone#: 480-8125 Fax#: \_\_\_\_\_ E-mail: galda247@yahoo.com  
Owner: D. Mc CALL Contact: D. Mc CALL  
Address: 703 OSUNA ROAD NE, SUITE 6  
Phone#: 345-4444 Fax#: \_\_\_\_\_ E-mail: midwayleasing@comcast.net  
Architect: TATE FISHBURN ARCH Contact: Tate  
Address: P.O. BOX 2941, CORRALES, NM 87048  
Phone#: 899-9338 Fax#: \_\_\_\_\_ E-mail: tatefishburn@msn.com  
Other Contact: \_\_\_\_\_ Contact: \_\_\_\_\_  
Address: \_\_\_\_\_  
Phone#: \_\_\_\_\_ Fax#: \_\_\_\_\_ E-mail: \_\_\_\_\_

Check all that Apply:

### DEPARTMENT:

- ☐ HYDROLOGY/ DRAINAGE  
☐ TRAFFIC/ TRANSPORTATION  
☐ MS4/ EROSION & SEDIMENT CONTROL

### TYPE OF SUBMITTAL:

☒ ENGINEER/ ARCHITECT CERTIFICATION

- ☐ CONCEPTUAL G & D PLAN  
☐ GRADING PLAN  
☐ DRAINAGE MASTER PLAN  
☐ DRAINAGE REPORT  
☐ CLOMR/LOMR  
☐ TRAFFIC CIRCULATION LAYOUT (TCL)  
☐ TRAFFIC IMPACT STUDY (TIS)  
☐ EROSION & SEDIMENT CONTROL PLAN (ESC)

☐ OTHER (SPECIFY) \_\_\_\_\_

IS THIS A RESUBMITTAL?: Yes ☒ No ☐

DATE SUBMITTED: 01/19/2017

By: Gilbert Aldez

### CHECK TYPE OF APPROVAL/ACCEPTANCE SOUGHT:

- ☐ BUILDING PERMIT APPROVAL  
☒ CERTIFICATE OF OCCUPANCY  
☐ PRELIMINARY PLAT APPROVAL  
☐ SITE PLAN FOR SUB'D APPROVAL  
☐ SITE PLAN FOR BLDG. PERMIT APPROVAL  
☐ FINAL PLAT APPROVAL  
☐ SIA/ RELEASE OF FINANCIAL GUARANTEE  
☐ FOUNDATION PERMIT APPROVAL  
☐ GRADING PERMIT APPROVAL  
☐ SO-19 APPROVAL  
☐ PAVING PERMIT APPROVAL  
☐ GRADING/ PAD CERTIFICATION  
☐ WORK ORDER APPROVAL  
☐ CLOMR/LOMR  
☐ PRE-DESIGN MEETING  
☐ OTHER (SPECIFY) \_\_\_\_\_

COA STAFF: \_\_\_\_\_ ELECTRONIC SUBMITTAL RECEIVED: \_\_\_\_\_