



# *City of Albuquerque*

P.O. BOX 1293 ALBUQUERQUE, NEW MEXICO 87103

January 7, 1994

Bob Ryals  
Ryals Engineering  
4929 Idlewilde SE  
Albuquerque, NM 87108

RE: ENGINEER CERTIFICATION FOR DOUG ZIMMERMAN OFFICE WAREHOUSE  
(D-18/D28) CERTIFICATION STATEMENT DATED 12/23/93

Dear Mr. Ryals:

Based on the information provided on your January 3, 1994 submittal, Engineer Certification for the above referenced site is acceptable.

If I can be of further assistance, please feel free to contact me at 768-2667.

Sincerely,

*Bernie J. Montoya*  
Bernie J. Montoya, CE  
Engineering Associate

BJM/ses/WPHYD8217

xc: Alan Martinez  
File

PUBLIC WORKS DEPARTMENT



# City of Albuquerque

P.O. BOX 1293 ALBUQUERQUE, NEW MEXICO 87103

August 2, 1993

Bob Ryals  
Ryals Engineering  
4929 Idlewilde SE  
Albuquerque, NM 87108

RE: REVISED DRAINAGE PLAN FOR DOUG ZIMMERMAN OFFICE WAREHOUSE  
(D18-D28) REVISION DATED 7/16/93.

Dear Mr. Ryals:

Based on the information provided on your July 20, 1993 resubmittal, the above referenced site is approved for Building Permit.

Please attach a copy of this approved plan to the construction sets prior to sign-off by Hydrology.

Engineer Certification per the D.P.M. checklist will also be required prior to Certificate of Occupancy release.

If I can be of further assistance, please feel free to contact me at 768-2667.

Sincerely,

Bernie J. Montoya, CE  
Engineer Associate

BJM/d1/WPHYD/7881

xc: Alan Martinez  
File


PUBLIC WORKS DEPARTMENT

NOT TO PIPE

$$\frac{(50 \times 116)}{100} \times 3.14 \text{ cfs}$$

## CC TREATMENT

$$\alpha = 24.3^\circ \pm$$

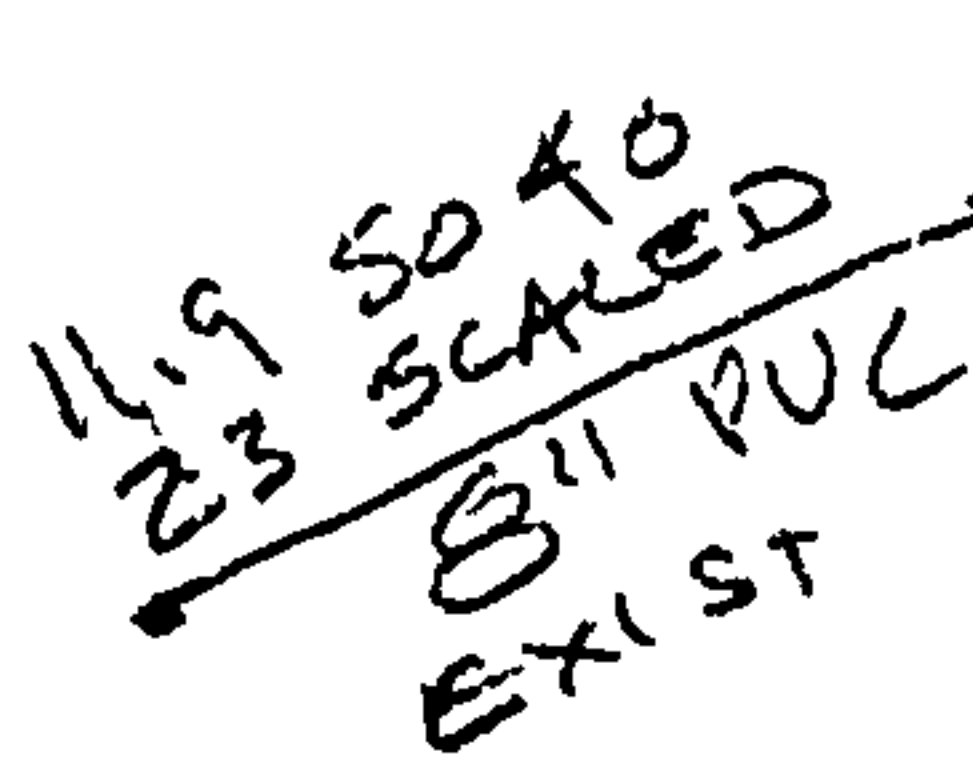

36.5'

---

10" PVC  
PROPOSED

59.5-1


---

10" PVC  
PROPOSED

GRATE

~~Q20 B4 PVC~~

LOADING DOCK

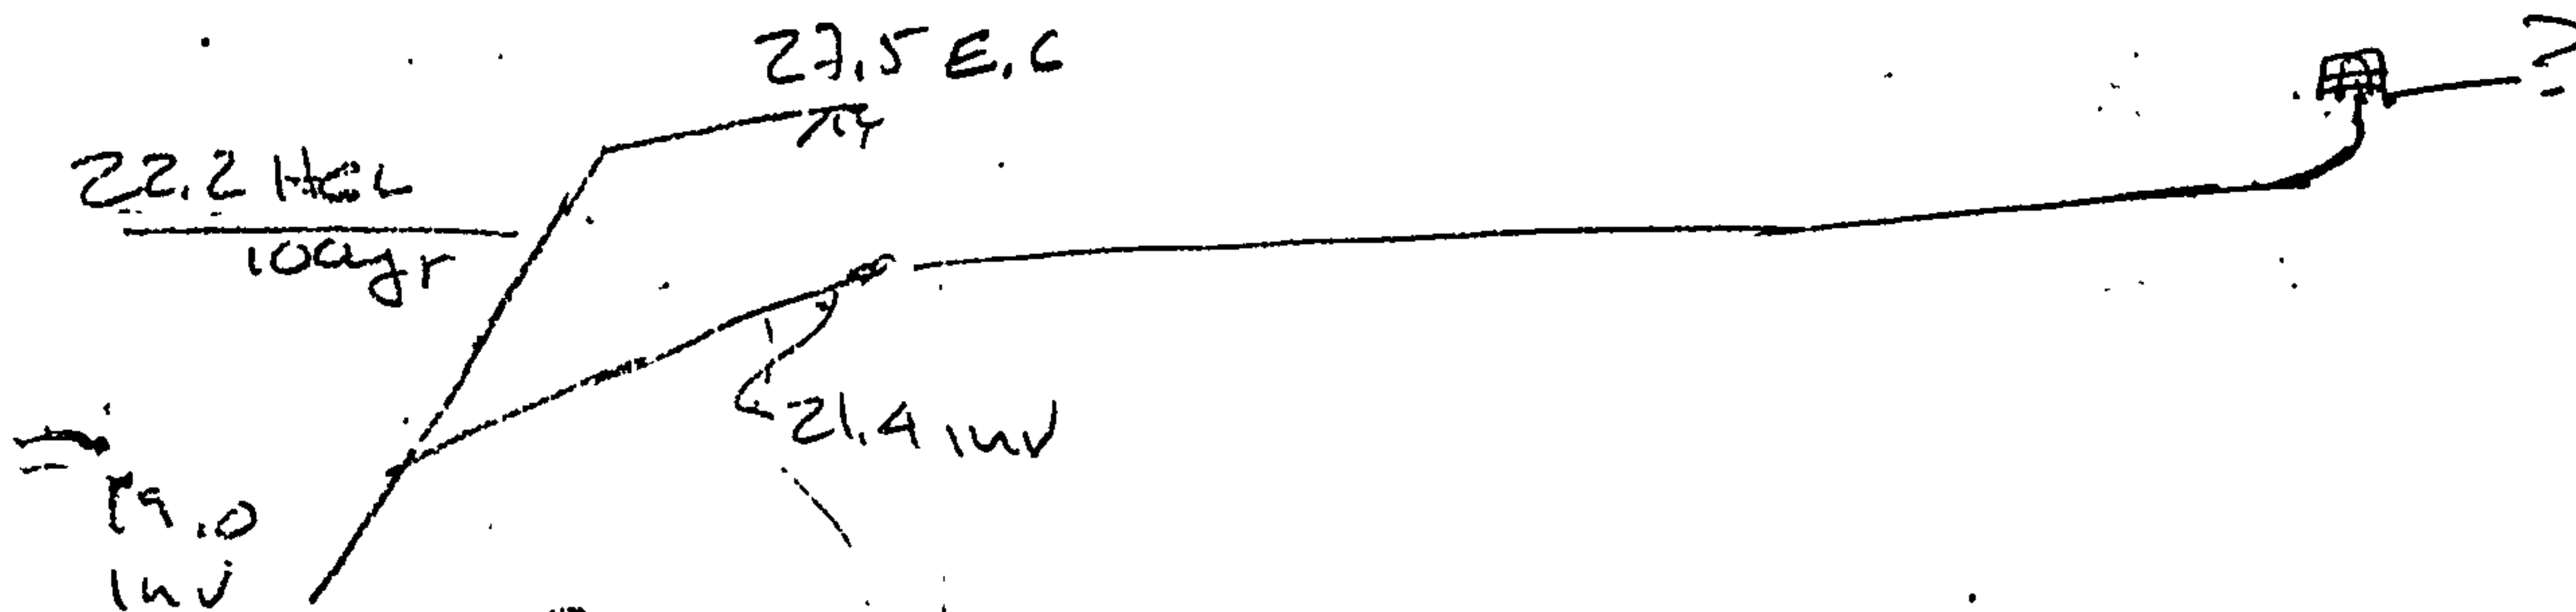
$$L_{\text{actual}} \frac{U_8^2}{z_8} = L_{\text{ref}} \frac{U_{10}^2}{z_8}$$

$$L \rightarrow g = L_{act} \left( \frac{V_0}{V_{10}} \right)^2$$

$$\frac{V_8}{V_{10}} = \left( \frac{D_{10}}{D_8} \right)^2$$

$$L = g = L_{act} \left( \frac{D_{10}}{D_8} \right)^4 = 2.441 \times L_{act}$$

$$= 2,441 \times 23$$

$= 56.15 \text{ say } \underline{\underline{56 \text{ ft.}}}$

$$Z_3 = \cos \theta_2 \sqrt{v}$$

(2) CONTRAST = 10%  $\rightarrow$  2%

See Stroeter & Wylie 7<sup>th</sup> Ed p 243-244

$$h_{\text{contraction}} = \left( \frac{1}{C_c} - 1 \right)^2 \frac{V_2^2}{2g}$$


$$V_2 = V_{small}$$

from table in ~~Stroter~~ <sup>Log</sup> for  $A_2/A_1 = 0.10 = 0.0$ ,  $C_c = 0.13$

$$h_c = \left( \frac{1}{1.813} - 1 \right)^2 \frac{V_0^2}{2g} = 0.053 \frac{V_0^2}{2g}$$


from above,  $V_0^2/2g = 2.441 \times V_{10}^2/2g$

$$\therefore h_c = 2.441 \times 0.053 = 0.129 \approx 0.13 \text{ } U_0^2/2g$$

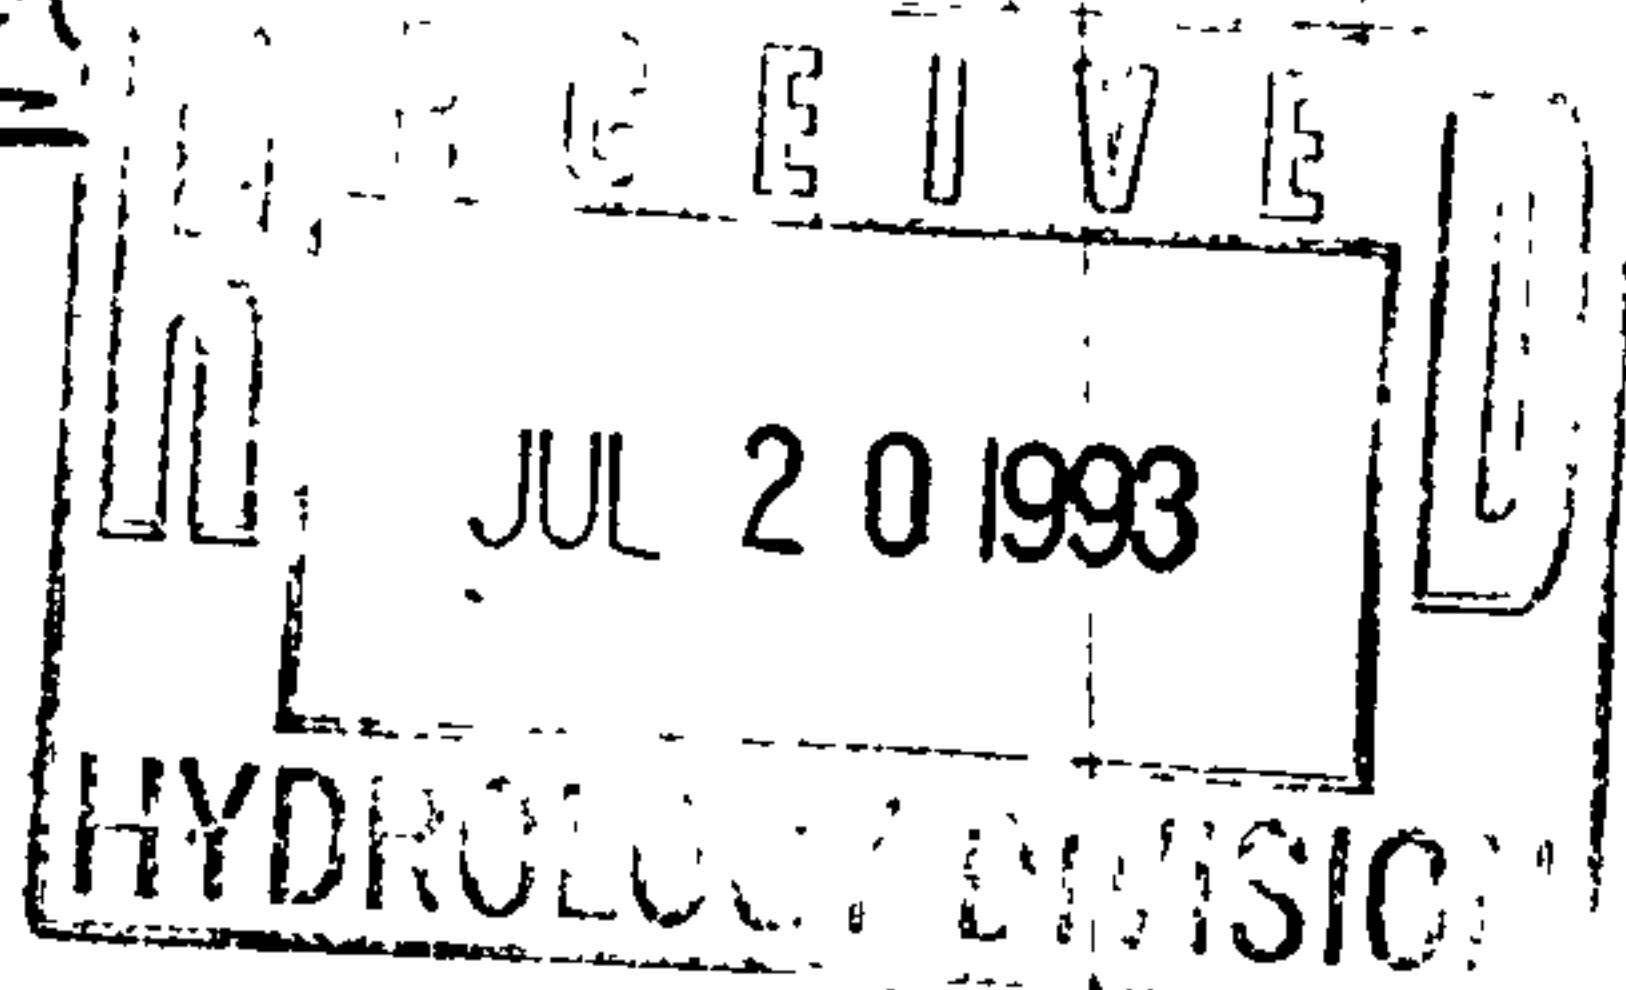

D 18 /

- (3) GET HEAD REQUIRE FOR Q AS WEIR EQUATION  
DESIGN GRATE SO HEAD REQUIRED FOR GRATE  
← HEAD FOR WEIR

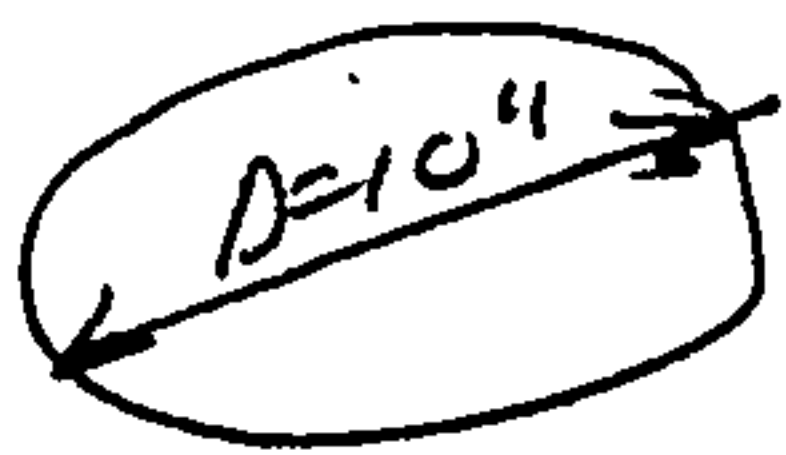

$$D = 10''$$

$$L = \text{Perimeter} = \pi D = 31.42'' \\ = 2.62'$$

$$Q = C \cdot L \cdot H^{3/2}$$

$$\text{Use } C = 3.0, \text{ } L = H$$

$$2.73 = 3 \cdot 2.62 \times H^{3/2}$$

$$H^{3/2} = \frac{2.73}{3 \times 2.62} = 0.347$$

$$\left\{ V = Q/A = V_{\text{WEIR}} = \frac{2.73}{144 \times 2.62} = 2.13 \text{ FPS} \right\}$$

$$H = 0.347^{2/3} = 0.494' \approx \underline{\underline{0.49'}}$$

TRY 18" SQUARE GRATE #4 REBAR @ 4" OC (5 per side)  
16 MORE SIDES, CONSIDER FOR AREA

$$18 - (5 \times 4/8) = 15.5'' \text{ per side opening}$$

$$15.5^2 = 240.25 \text{ in}^2 = 1.668 \text{ ft}^2$$

$$\text{ORIFICE } Q = CA \sqrt{2gh}$$

Use  $C = 0.60$  for grates - as per Neenah Foundry calcs

$$h = \frac{(Q/A)^2}{2g} \frac{1}{C^2} = \frac{(2.73/1.668)^2}{2 \times 32.2} \cdot \frac{1}{(0.6)^2} = 0.116' < 0.49'$$

- (4) FRICTION LOSS IN PVC PIPE

$$h_f = 4.727 \times \frac{L}{D^{4.87}} \left( \frac{Q}{C} \right)^{1.85} \quad C_{\text{PVC}} = 140$$

$$L = L_{8''} + L_{10''} = 56 + 96 = 152$$

conservative

add 10% for minor losses not including contractor

$$L_{\text{use}} = 1.1 \times 152 = 167.2$$

$$h_f = \frac{4.727 \cdot 167.2}{(10/12)^{4.87}} \frac{(2.73)^{1.85}}{(140)^{1.85}} = \frac{1920.59 \cdot 6.411}{140^{1.85}} = \frac{12312.19}{9339.79} = 1.318 \approx \underline{\underline{1.32}}$$



(5) Velocity head in 10" pipe  $= V^2/2g = h_v$

$$V = Q/A \quad A_{10"} = \frac{\pi (10/12)^2}{4} = 0.545 \text{ sq ft}$$

$$V = \frac{2.73}{0.545} = 5.009 \approx 5.01 \text{ fps}$$

$$\frac{V^2}{2g} = \frac{V^2}{2 \times 32.2} = 0.390 \text{ ft}$$

(6) TOTAL HEAD REQUIRED

SUM OF LOSSES + HEAD OVER WEIR

SINCE  $V_{WEIR} \approx 2.1 \text{ fps} < V_{PIPE} 5.0 \text{ fps}$ , ASSUME CONSERVE  
MUST GENERATE VELOCITY HEAD, WHICH IS LOST AS  
FLOW ENTERS CHANNEL

$$\begin{aligned} H_{TOT} &= H_f + H_{WEIR} + H_{CONTRACTION} + H_{VELOCITY} + H_{EXIT LOSS} \\ &= 1.32 + 0.49 + \frac{V_{10"}^2}{2g} (0.13 + 1 + 0 + 0.0) \\ &= 1.81 + 0.44 = 2.25' \end{aligned}$$

$$H_{GL} + H_{TOT} = 22.2 + 2.25 = 24.45'$$

(7)  $H_{TOT}$  EXCLUSIVE OF WHAT NEEDED TO GET FLOW INTO PIPE

$$1.81 + 0.13 \times 0.39 = 1.86'$$

$$22.2 + 1.86 = 24.06$$

SET PIPE ENTRY ABOVE 24.06 FOR DESIGN

(8)  $H$  TO GET FLOW INTO PIPE  $H_{WEIR} + H_v$  CONSERVE

$$0.49 + 0.39 = 0.88$$

$$TA - 0.88 = \underline{24.12} > 24.06 \text{ OK}$$

$$100 \text{ gals} = 25 \text{ sec } 24.12$$



RECEIVED

JUL 20 1993



# City of Albuquerque

P.O. BOX 1293 ALBUQUERQUE, NEW MEXICO 87103

July 14, 1993

Bob Ryals  
Ryals Engineering  
4929 Idlewilde SE  
Albuquerque, NM 87108

RE: REVISED DRAINAGE PLAN FOR DOUG ZIMMERMAN OFFICE WAREHOUSE (D18-D<sup>28</sup>)  
ENGINEER'S STAMP DATED 7/2/93.

Dear Mr. Ryals:

Based on the information provided on your July 6, 1993 submittal, listed are some concerns that will need to be addressed prior to final approval:

1. Copy of signed and recorded replat.
2. Hydraulics for the original concept where done using 1.12 cfs as the total flowrate. You must analyze the Hydraulics using a new total of 3.13 cfs. Show hydraulics for the inlet and pipes.
3. You may need to design for storage of the excess flows that the inlet and pipes will not be able to carry. Use the D.P.M. checklist as a guide for ponding requirements.

If I can be of further assistance, please feel free to contact me at 768-2667.

Sincerely,

*Bernie J. Montoya*  
Bernie J. Montoya, CE  
Engineer Associate

BJM/d1/WPHYD/7847

xc: File

PUBLIC WORKS DEPARTMENT



# *City of Albuquerque*

P.O. BOX 1293 ALBUQUERQUE, NEW MEXICO 87103

May 21, 1992

August F. Mosimann  
Engineering Associates, Inc.  
540 Chama, NE Suite #11  
Albuquerque, New Mexico 87108

RE: REVISED DRAINAGE PLAN FOR 6000 SAN FRANCISCO, NE (D-18/D3)  
REVISION DATED MAY 18, 1992

Dear Mr. Mosimann:

Based on the information provided on your submittal of May 18, 1992, the above referenced plan is approved for Building Permit.

Please attach a copy of this plan to the construction sets prior to sign-off by Hydrology.

Prior to Certificate of Occupancy release, Engineer's Certification per the DPM Checklist will be required.

If I can be of further assistance, please feel free to call me at 768-2650.

Cordially,



Bernie J. Montoya, C.E.  
Engineering Assistant

xc Alan Martinez

BJM/bsj  
(WP+3319)

PUBLIC WORKS DEPARTMENT

NOTE: IF PIPE IS INSTALLED AFTER CHANNEL LINING IS IN PLACE FOLLOW THIS DETAIL

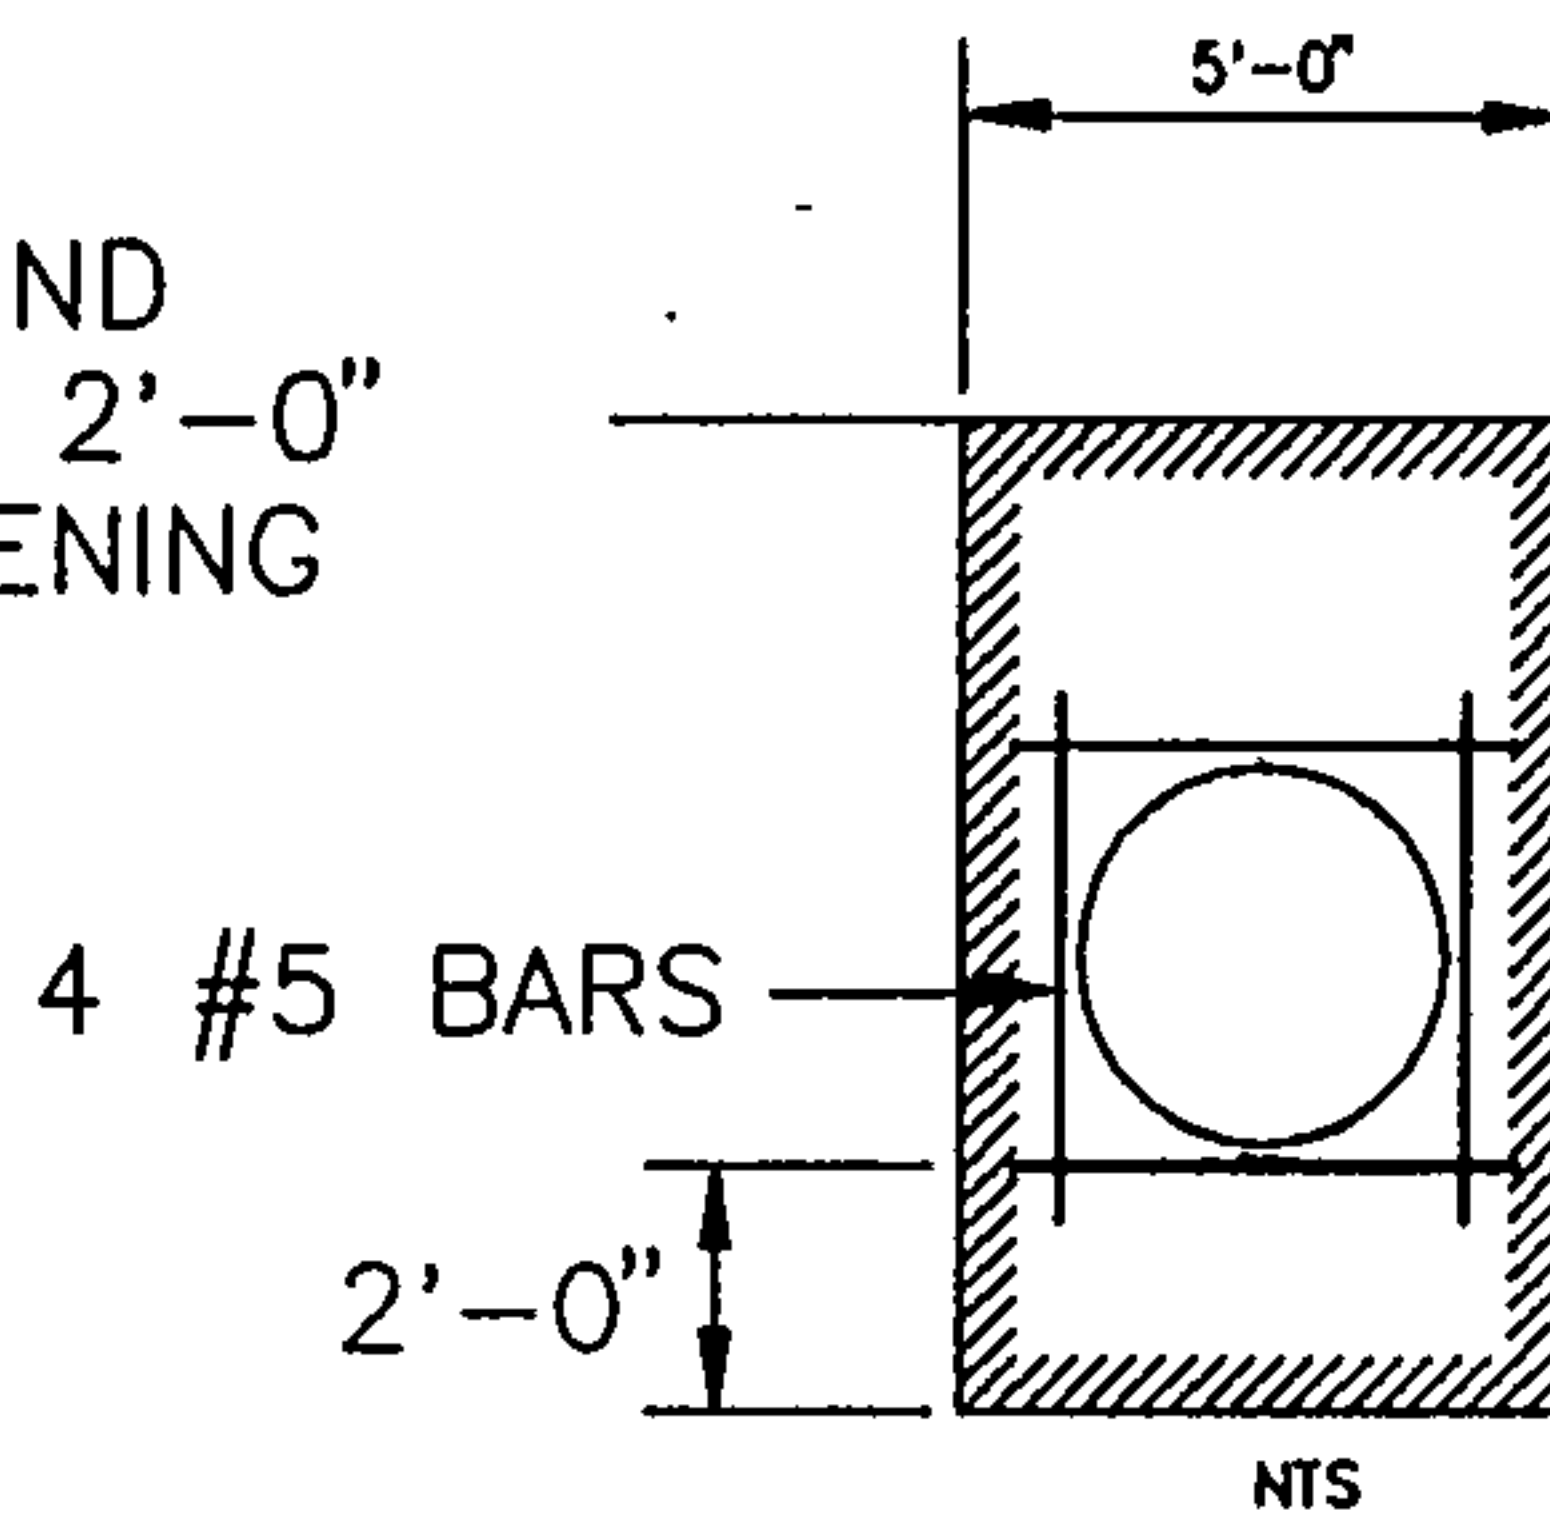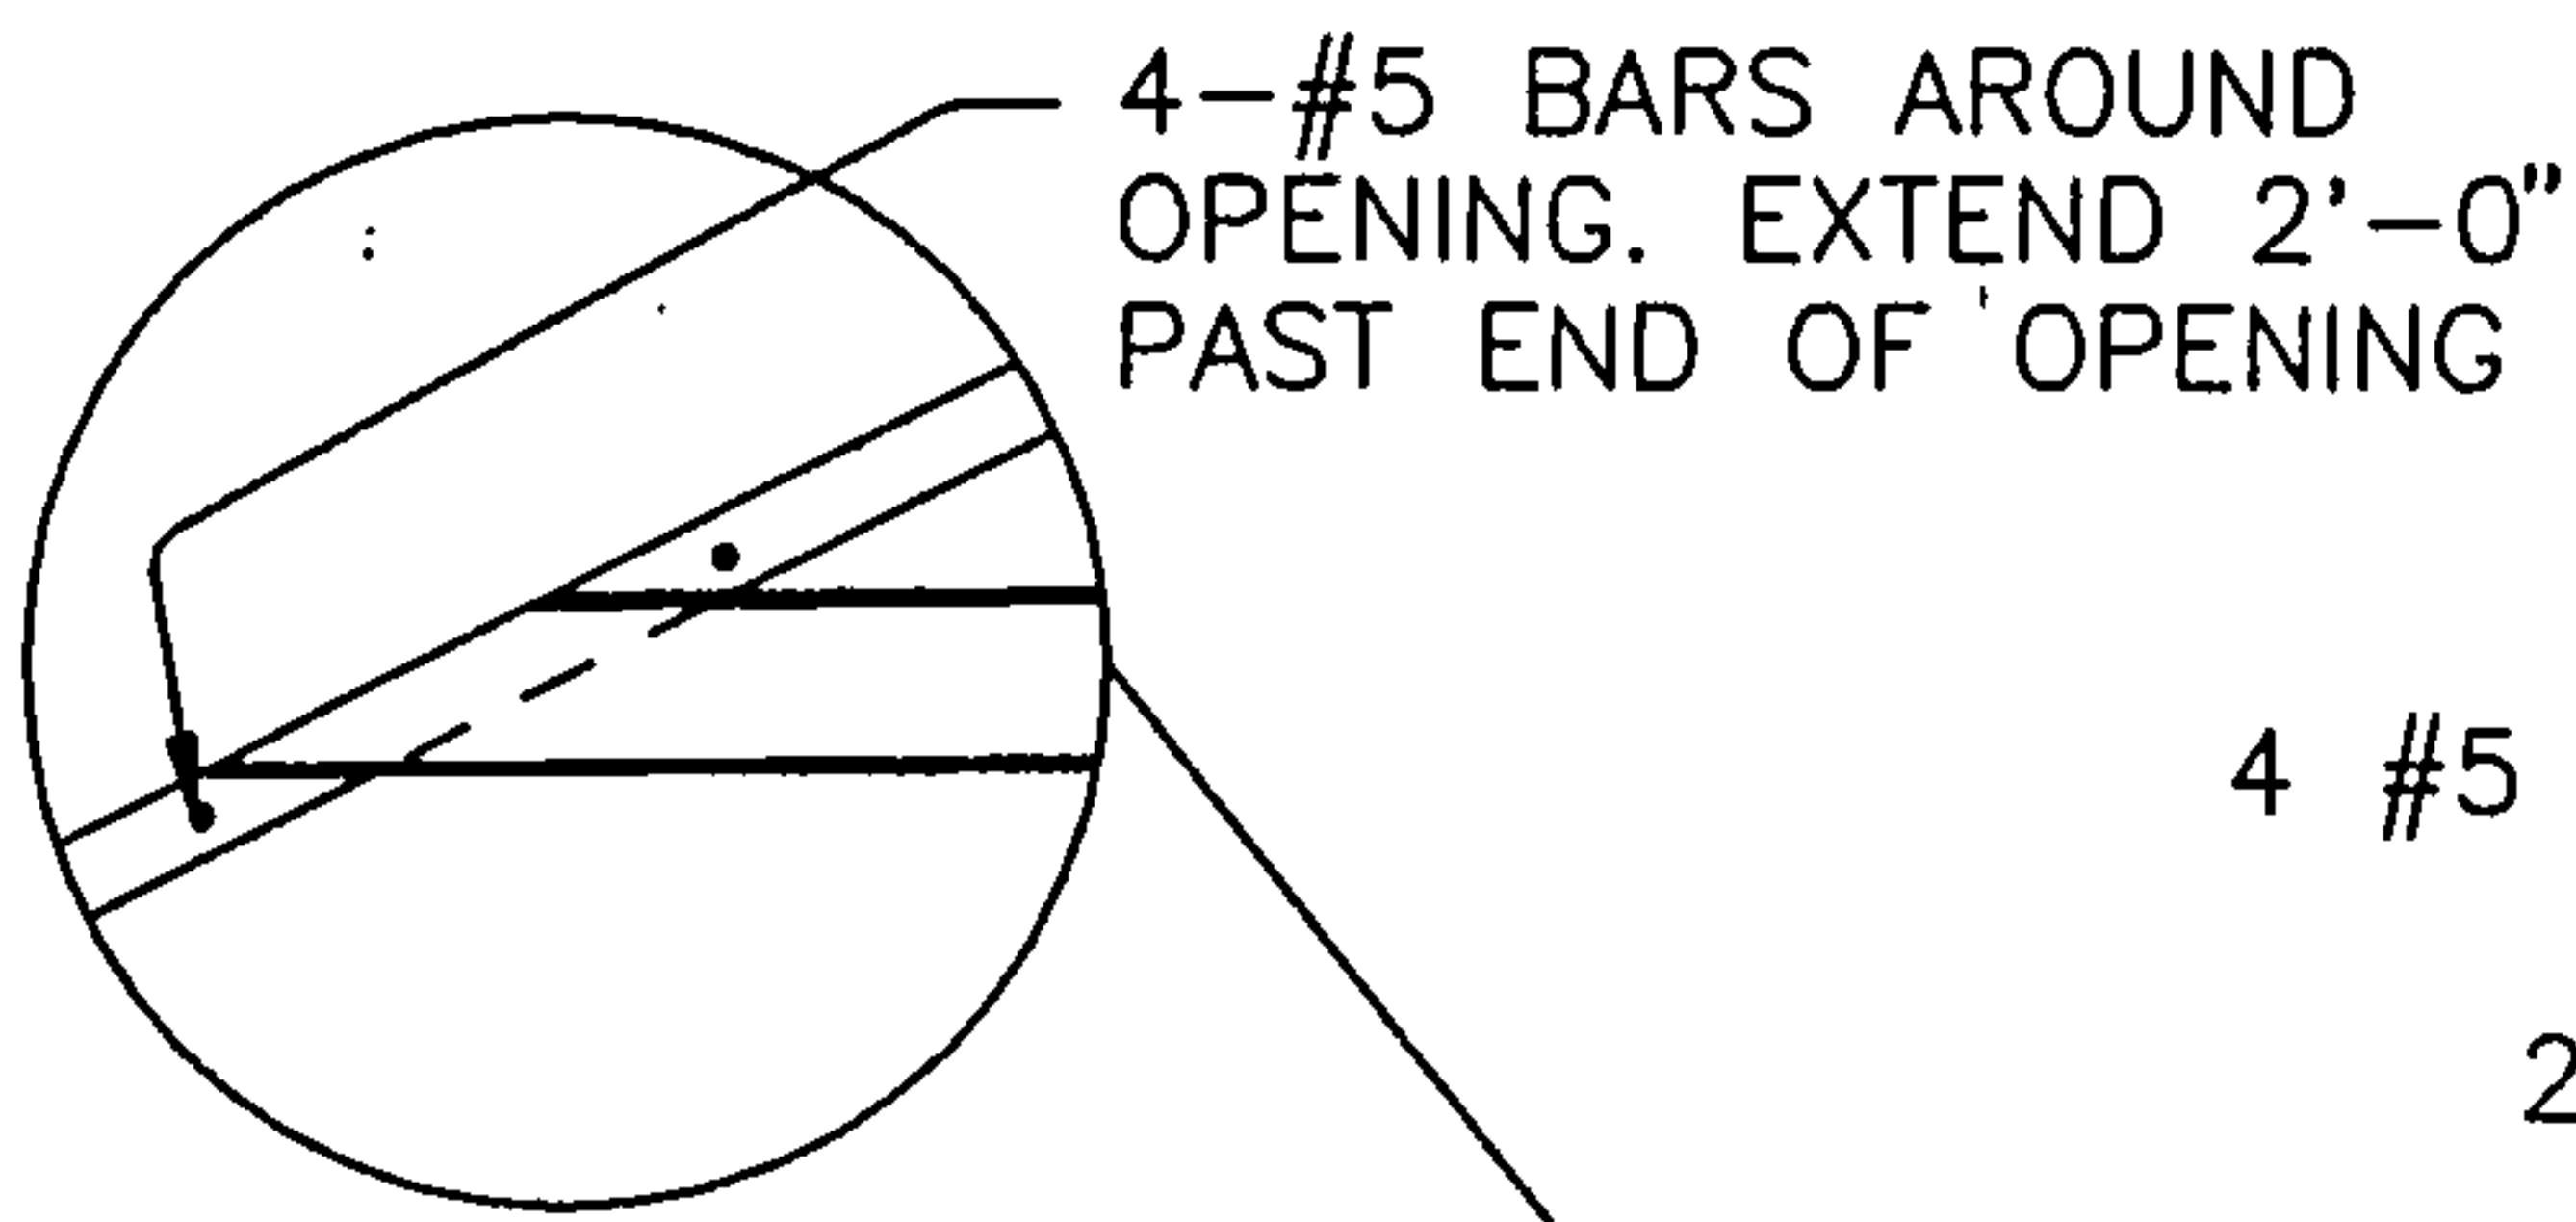

1. SAW CUT AS SHOWN.  
DO NOT REMOVE  
REINFORCING STEEL.
2. PLACE PIPE AND  
RECOMPACT SOIL.
3. PLACE ADDITIONAL STEEL  
AROUND OPENING.
4. POUR NEW CONCRETE.

CL NORTH PINO  
CHANNEL

LOT 12-A

PROPERTY  
LINE


11.89'  
FIELD VERIFY

5219.00  
OUTLET  
INVERT

1% SLOPE

PROVIDE COUPLING  
AT PROPERTY LINE

INSTALL 8 IN. DIA, SCHEDULE 40  
PVC PIPE BETWEEN NORTH PINO  
CHANNEL AND LOT 12A PROPERTY  
LINE

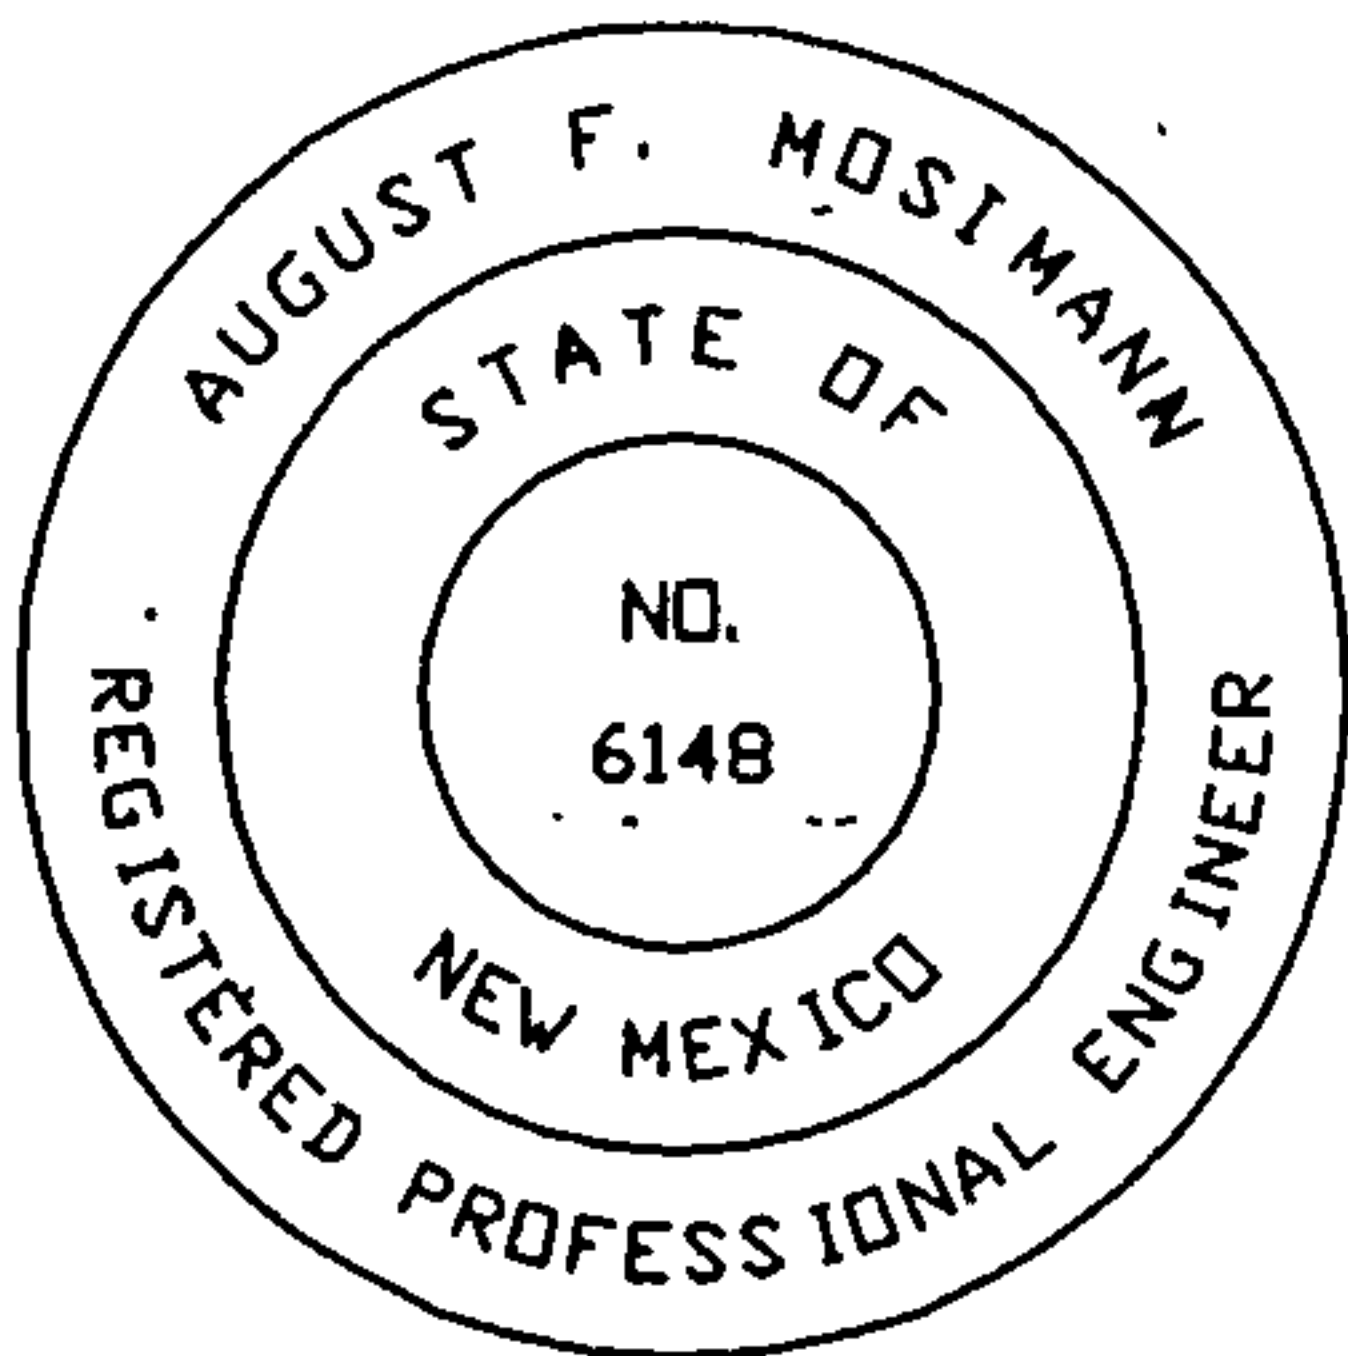

DETAIL

SCALE: 1"=10'

APPROVED FOR RECORD DRAWINGS

CHIEF CONSTRUCTION ENGINEER

DATE

APPROVED FOR CONSTRUCTION

CITY ENGINEER

DATE

CITY OF ALBUQUERQUE

APPROVALS

ENGINEER

DATE

TITLE:

D.R.C. CHAIRPERSON

BALDWIN OFFICE/WAREHOUSE  
STORM DRAIN INSTALLATION

WATER/  
WASTE WATER

HYDROLOGY

PROJECT NO.  
4056.91


MAP NO. D-18  
SHEET 3 OF 3



# LOT 12A

# LOT 12B

INSTALL 8 IN. DIAMETER  
SCHEDULE 40 PVC  
DRAIN PIPE BETWEEN  
CHANNEL WALL AND  
LOT 12A PROPERTY  
LINE. SEE DETAIL ON  
SHEET 3.

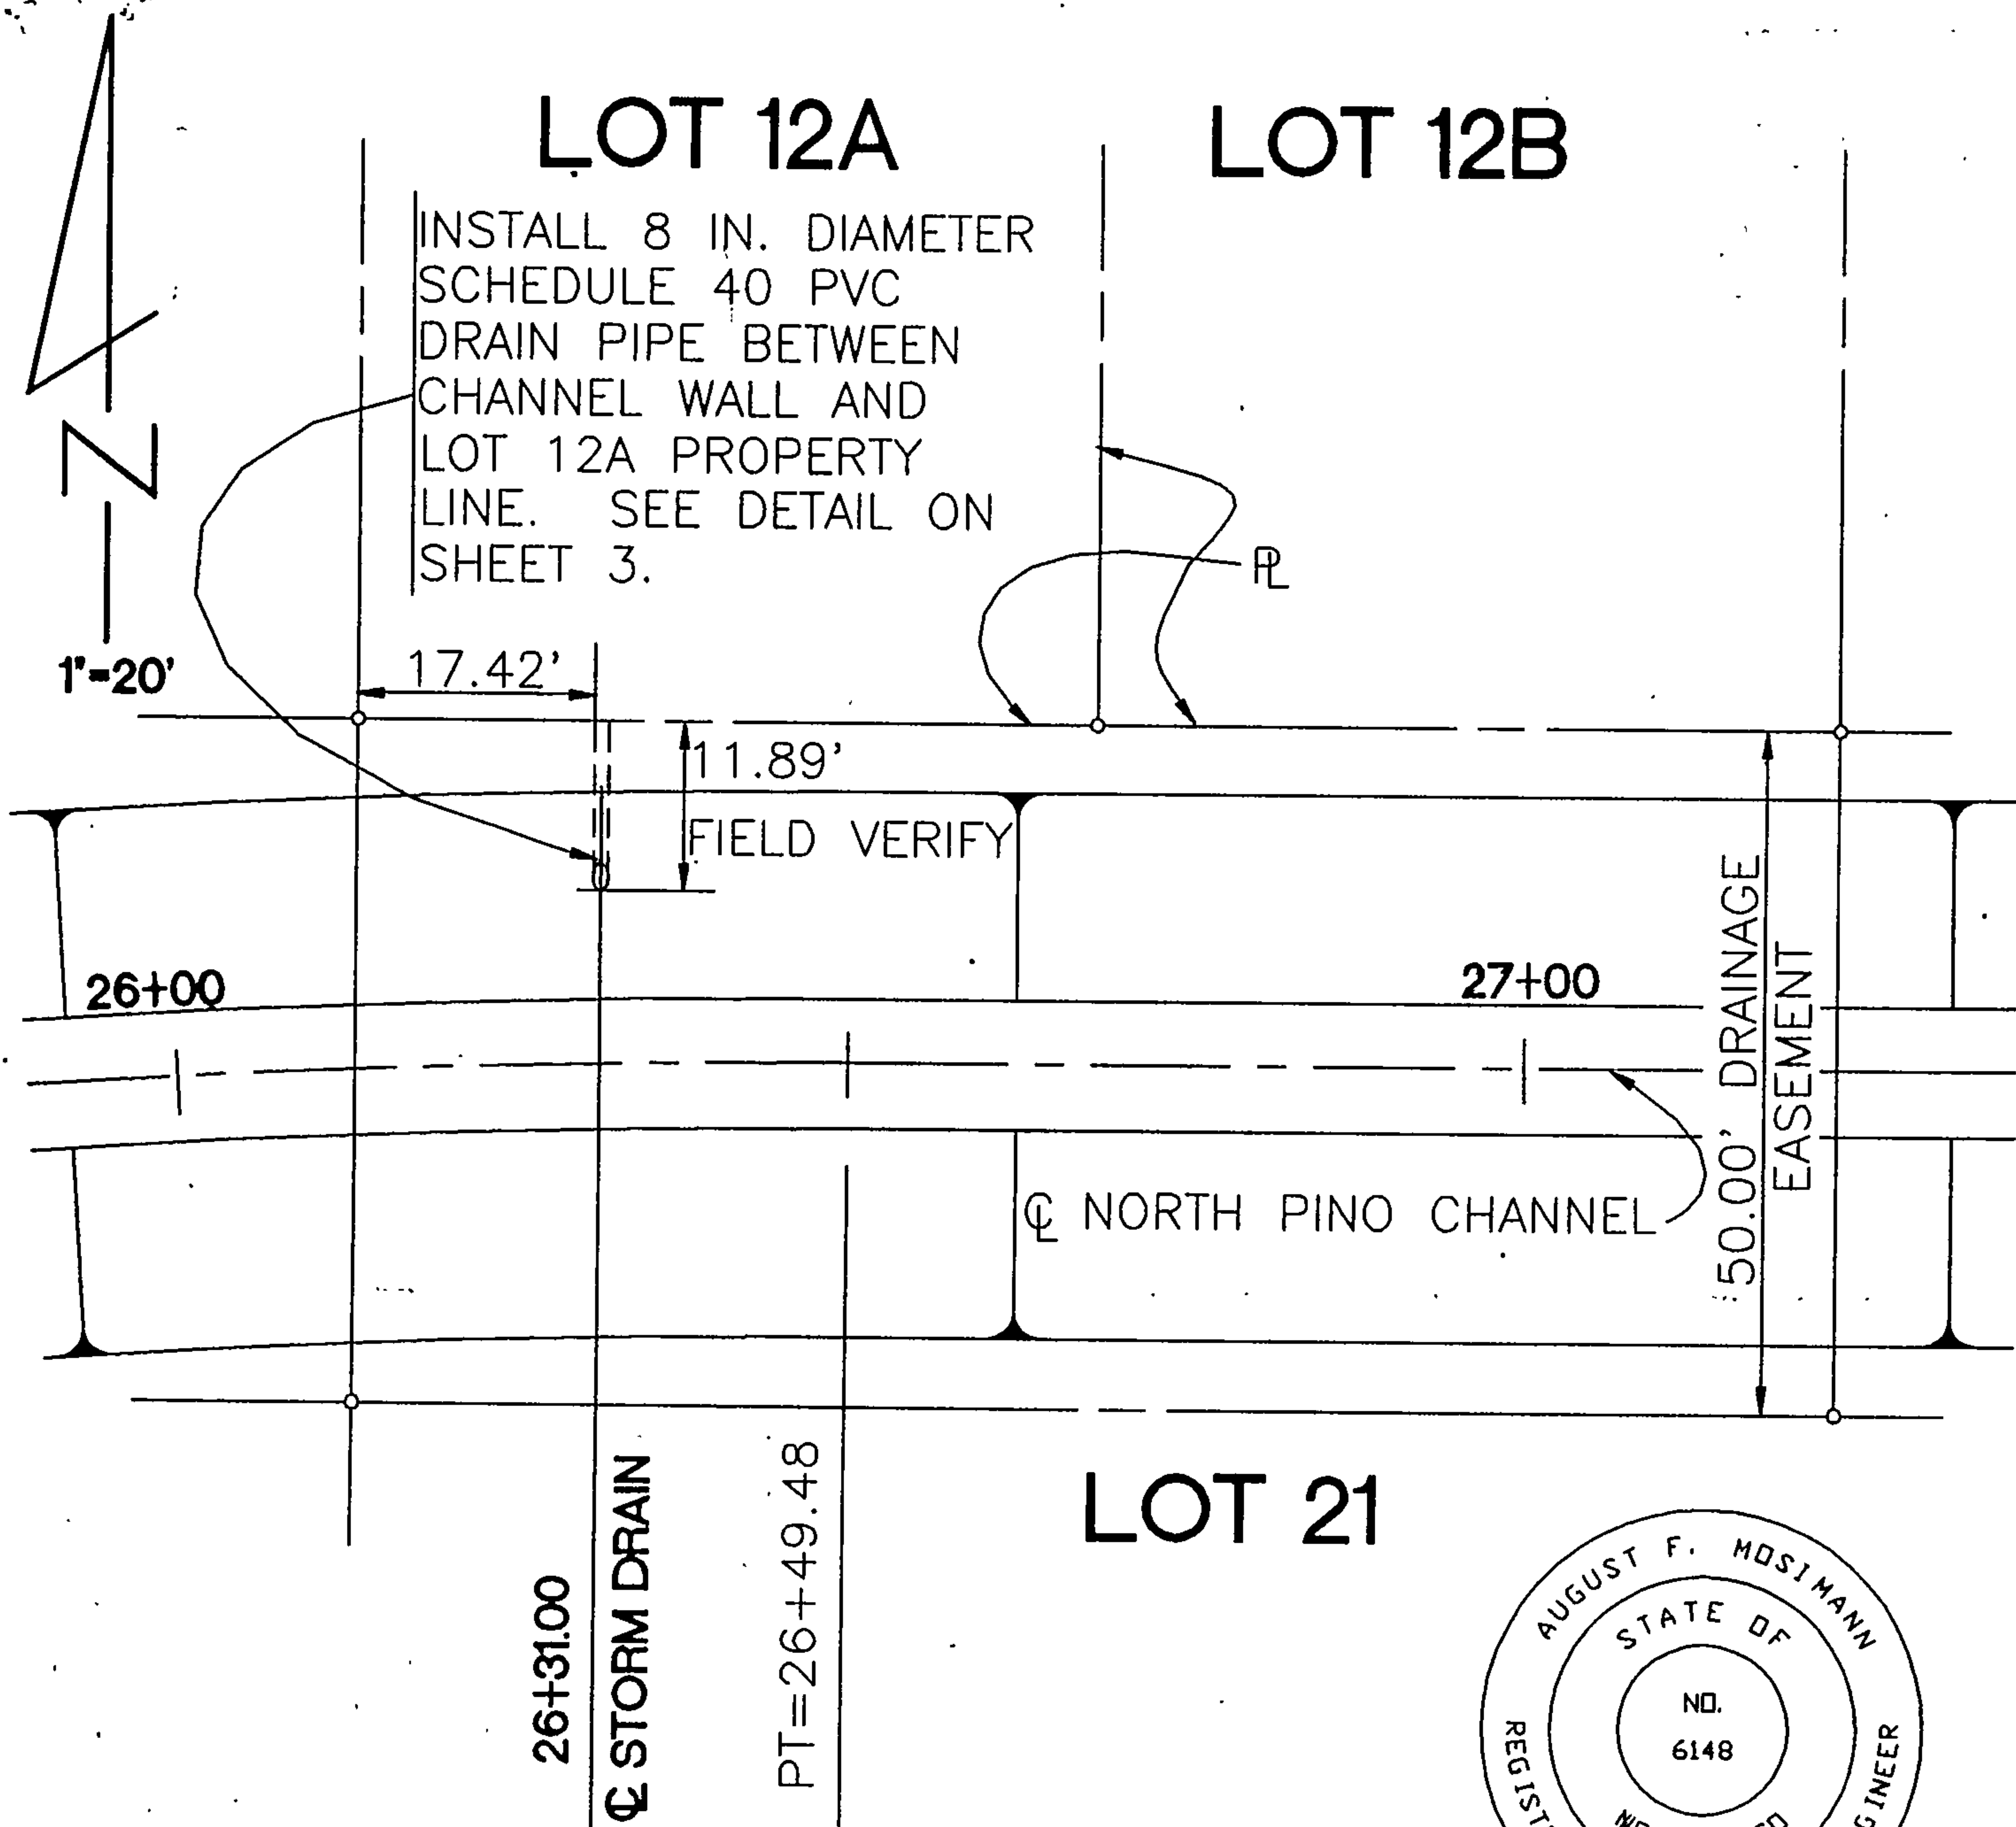

## PLAN

APPROVED FOR RECORD DRAWINGS

APPROVED FOR CONSTRUCTION

CHIEF CONSTRUCTION ENGINEER

DATE

CITY ENGINEER

DATE

## CITY OF ALBUQUERQUE

APPROVALS

ENGINEER

DATE

TITLE:

D.R.C. CHAIRPERSON

BALDWIN OFFICE/WAREHOUSE  
STORM DRAIN INSTALLATION

WATER/  
WASTE WATER

HYDROLOGY

PROJECT NO.  
4056.91

MAP NO. D-18  
SHEET 2 OF 3