


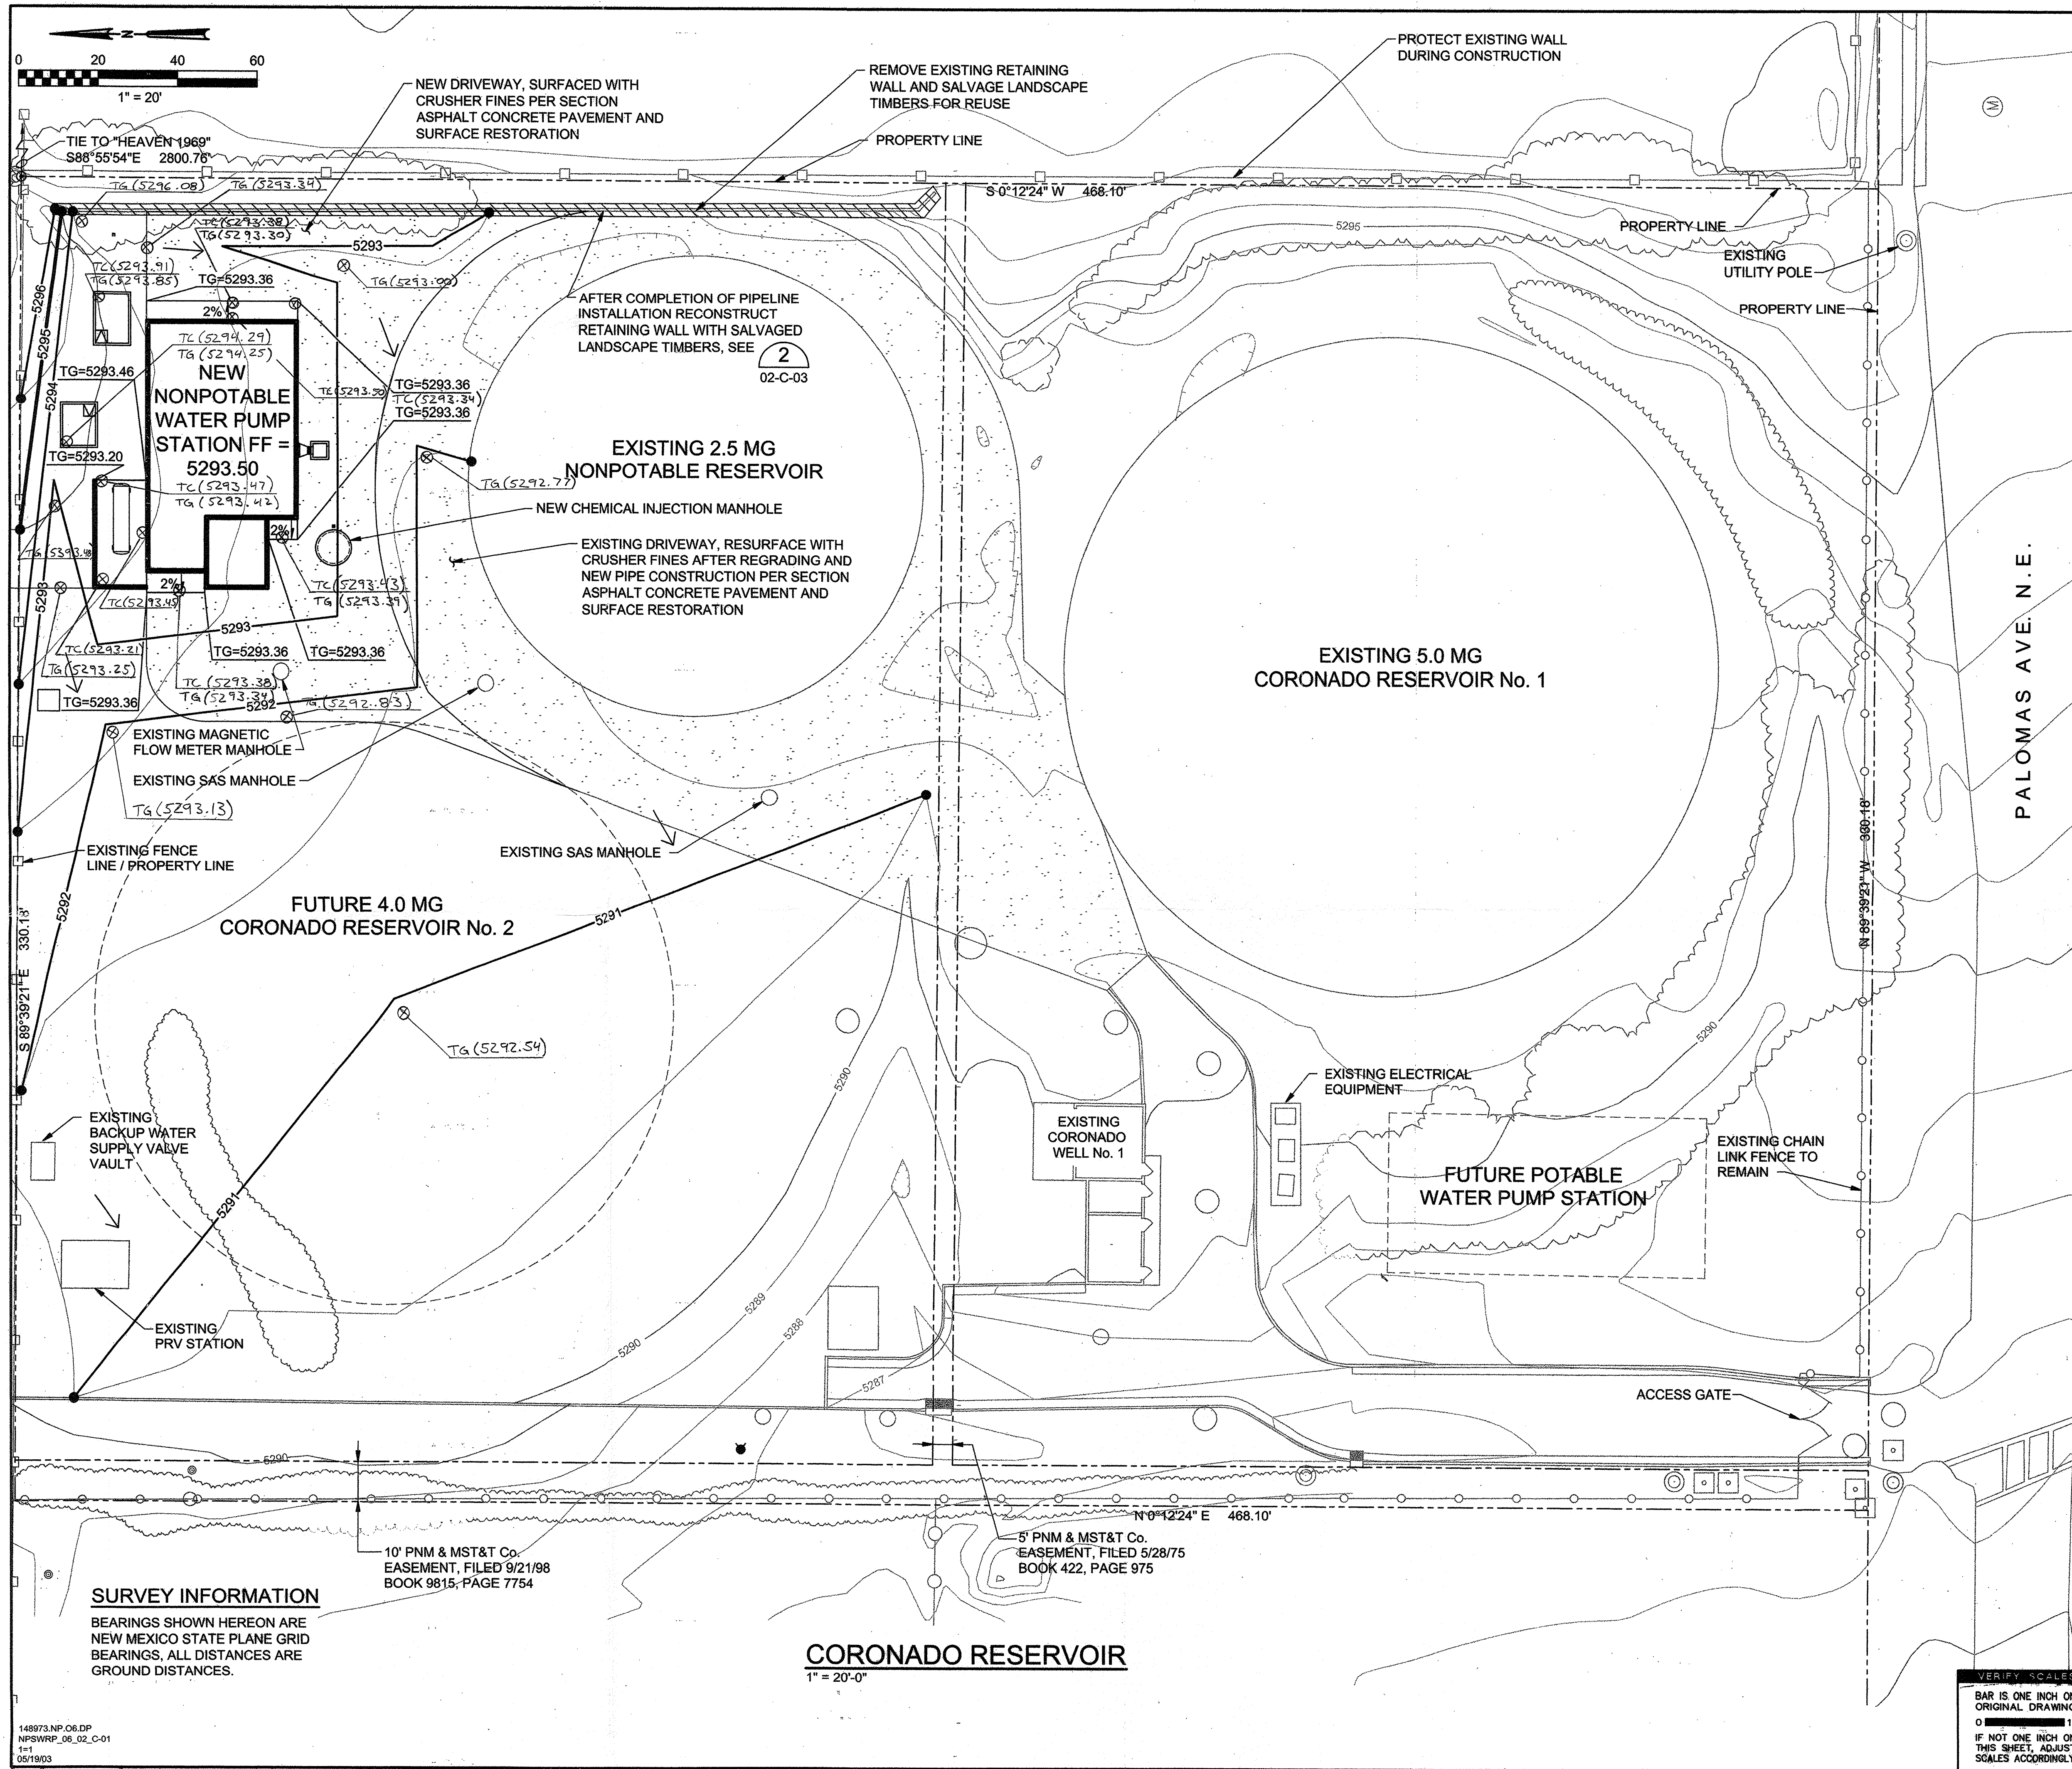

CONSTRUCTION NOTE:

1. ALL AREAS DISTURBED BY THE CONSTRUCTION ACTIVITIES, AND NOT SPECIFICALLY SCHEDULED TO RECEIVE OTHER SURFACE TREATMENTS, SHALL BE GRADED SMOOTH AND SEEDED WITH STANDARD CITY NATIVE GRASS SEED MIX (EAST SIDE MIX) IN ACCORDANCE WITH SECTION 02920-RECLAMATION SEEDING.

2. CONTRACTOR SHALL PROVIDE AND MAINTAIN ACCESS TO THE EXISTING CORONADO WELL AND RESERVOIR FACILITIES, BY WATER UTILITY DIVISION PERSONNEL, AT ALL TIMES.



TC TOP OF CONCRETE
TG TOP OF GROUND

5291.50 (5291.20)
DESIGN (ASBUILT)

I, MIKE BREWER, NMPE 14226, OF THE FIRM CH2M HILL, INC. HERE BY CERTIFY THAT THIS PROJECT HAS BEEN GRADED AND WILL DRAIN IN SUBSTANTIAL COMPLIANCE WITH AND IN ACCORDANCE WITH THE DESIGN INTENT OF THE APPROVED PLAN DATED 05/19/2003. THE RECORD INFORMATION EDITED ONTO THE ORIGINAL DESIGN DOCUMENT HAS BEEN OBTAINED BY ME OR UNDER MY DIRECT SUPERVISION AND IS TRUE AND CORRECT TO THE BEST OF MY KNOWLEDGE AND BELIEF. THIS CERTIFICATION IS SUBMITTED IN SUPPORT OF A REQUEST FOR CERTIFICATE OF OCCUPANCY (PERM.).

THE RECORD INFORMATION PRESENTED HEREON IS NOT NECESSARILY COMPLETE AND INTENDED ONLY TO VERIFY SUBSTANTIAL COMPLIANCE OF THE GRADING AND DRAINAGE ASPECTS OF THIS PROJECT. THOSE RELYING ON THIS RECORD DOCUMENT ARE ADVISED TO OBTAIN INDEPENDENT VERIFICATION OF ITS ACCURACY BEFORE USING IT FOR ANY OTHER PURPOSE

Mike Brewer,
DATE 6/6/05

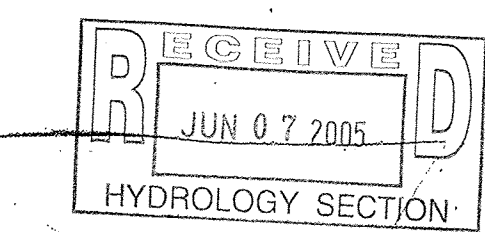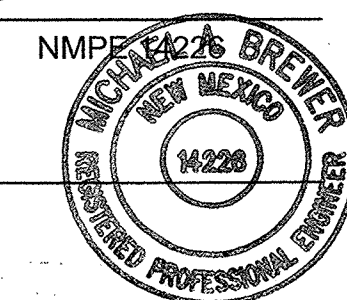

CH2MHILL
6001 Indian School Rd. N.E., SUITE 350
Albuquerque, New Mexico 87110
(505) 884-5600

CITY OF ALBUQUERQUE
PUBLIC WORKS DEPARTMENT
ENGINEERING DIVISION

TITLE: NONPOTABLE WATER PUMP STATIONS AND RESERVOIRS
CORONADO SITE GRADING & DEMOLITION PLAN

DESIGN REVIEW COMMITTEE	CITY ENGINEER APPROVAL	Mo./Day/Yr.	Mo./Day/Yr.
APPROVED JUL 21 2003 DESIGN REVIEW COMMITTEE	APPROVED JUL 21 2003 CITY ENGINEER		
DESIGNED BY: MAB	DATE: 01/01/03		
DRAWN BY: EJA	DATE: 02/02/03		
CHECKED BY: DS	DATE: 05/09/03		

CITY PROJECT NO. 5762.07
Zone Map No. D-18
SHEET 15 OF 134
DRAWING NO. 02-C-01