


C:\PROJECTS\SAN PEDRO BASINS.DWG 4-8-04 9:27:44 am LST



SCALE: 1"=300'

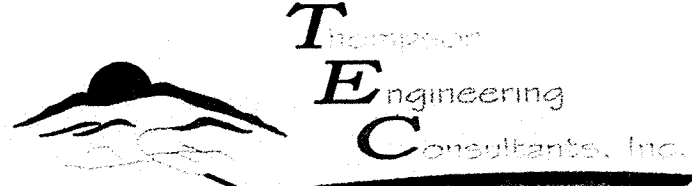

4600 JUAN TABO NE, SUITE C    PHONE: (505) 271-2199  
ALBUQUERQUE, NEW MEXICO 87111    FAX: (505) 257-5422

CITY OF ALBUQUERQUE  
PUBLIC WORKS DEPARTMENT  
ENGINEERING DEVELOPMENT GROUP

TITLE:                    SAN PEDRO DRIVE  
                                 DRAINAGE BASIN LOCATIONS


|                         |                        |                    |                 |  |
|-------------------------|------------------------|--------------------|-----------------|--|
| Design Review Committee | City Engineer Approval | Last Design Update | No. / Day / Yr. |  |
|                         |                        |                    |                 |  |
| City Project No.        | Zone Map No.           | Sheet No.          | No. / Day / Yr. |  |
|                         |                        |                    |                 |  |

PLATE 1

RECEIVED  
FEB 16 2006  
HYDROLOGY SECTION

| ENGINEERS SEAL |  | SURVEY INFORMATION |      | BENCH MARKS |      | AS BUILT INFORMATION       |      |
|----------------|--|--------------------|------|-------------|------|----------------------------|------|
|                |  | FIELD NOTES        |      |             |      |                            |      |
|                |  | NO.                | BY   | DATE        | XXXX | CONTRACTOR                 |      |
|                |  |                    |      |             | XXXX | WORK STARTED BY            | DATE |
|                |  |                    |      |             | XXXX | SUPERVISOR'S ACCEPTANCE BY | DATE |
|                |  | NO.                | DATE | REMARKS     | XXXX | FIELD VERIFICATION BY      | DATE |
|                |  |                    |      | REVISIONS   | XXXX | DRAWING CHECKED BY         | DATE |
|                |  |                    |      | DESIGN      | XXXX | MICRO—FILM INFORMATION     |      |
|                |  | DESIGNED BY        | DATE |             |      | RECORDED BY                | DATE |
|                |  | DRAWN BY           | DATE |             |      | NO.                        |      |
|                |  | CHECKED BY         | DATE |             |      |                            |      |





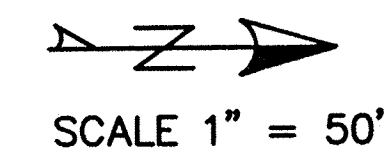


RECEIVED  
FEB 16 2006  
HYDROLOGY SECTION



Z:\PROJECTS\SAN PEDRO COLLECTORS\PLANSET\CHANNEL-11EDWG 4-8-04 1:3547 pm EST

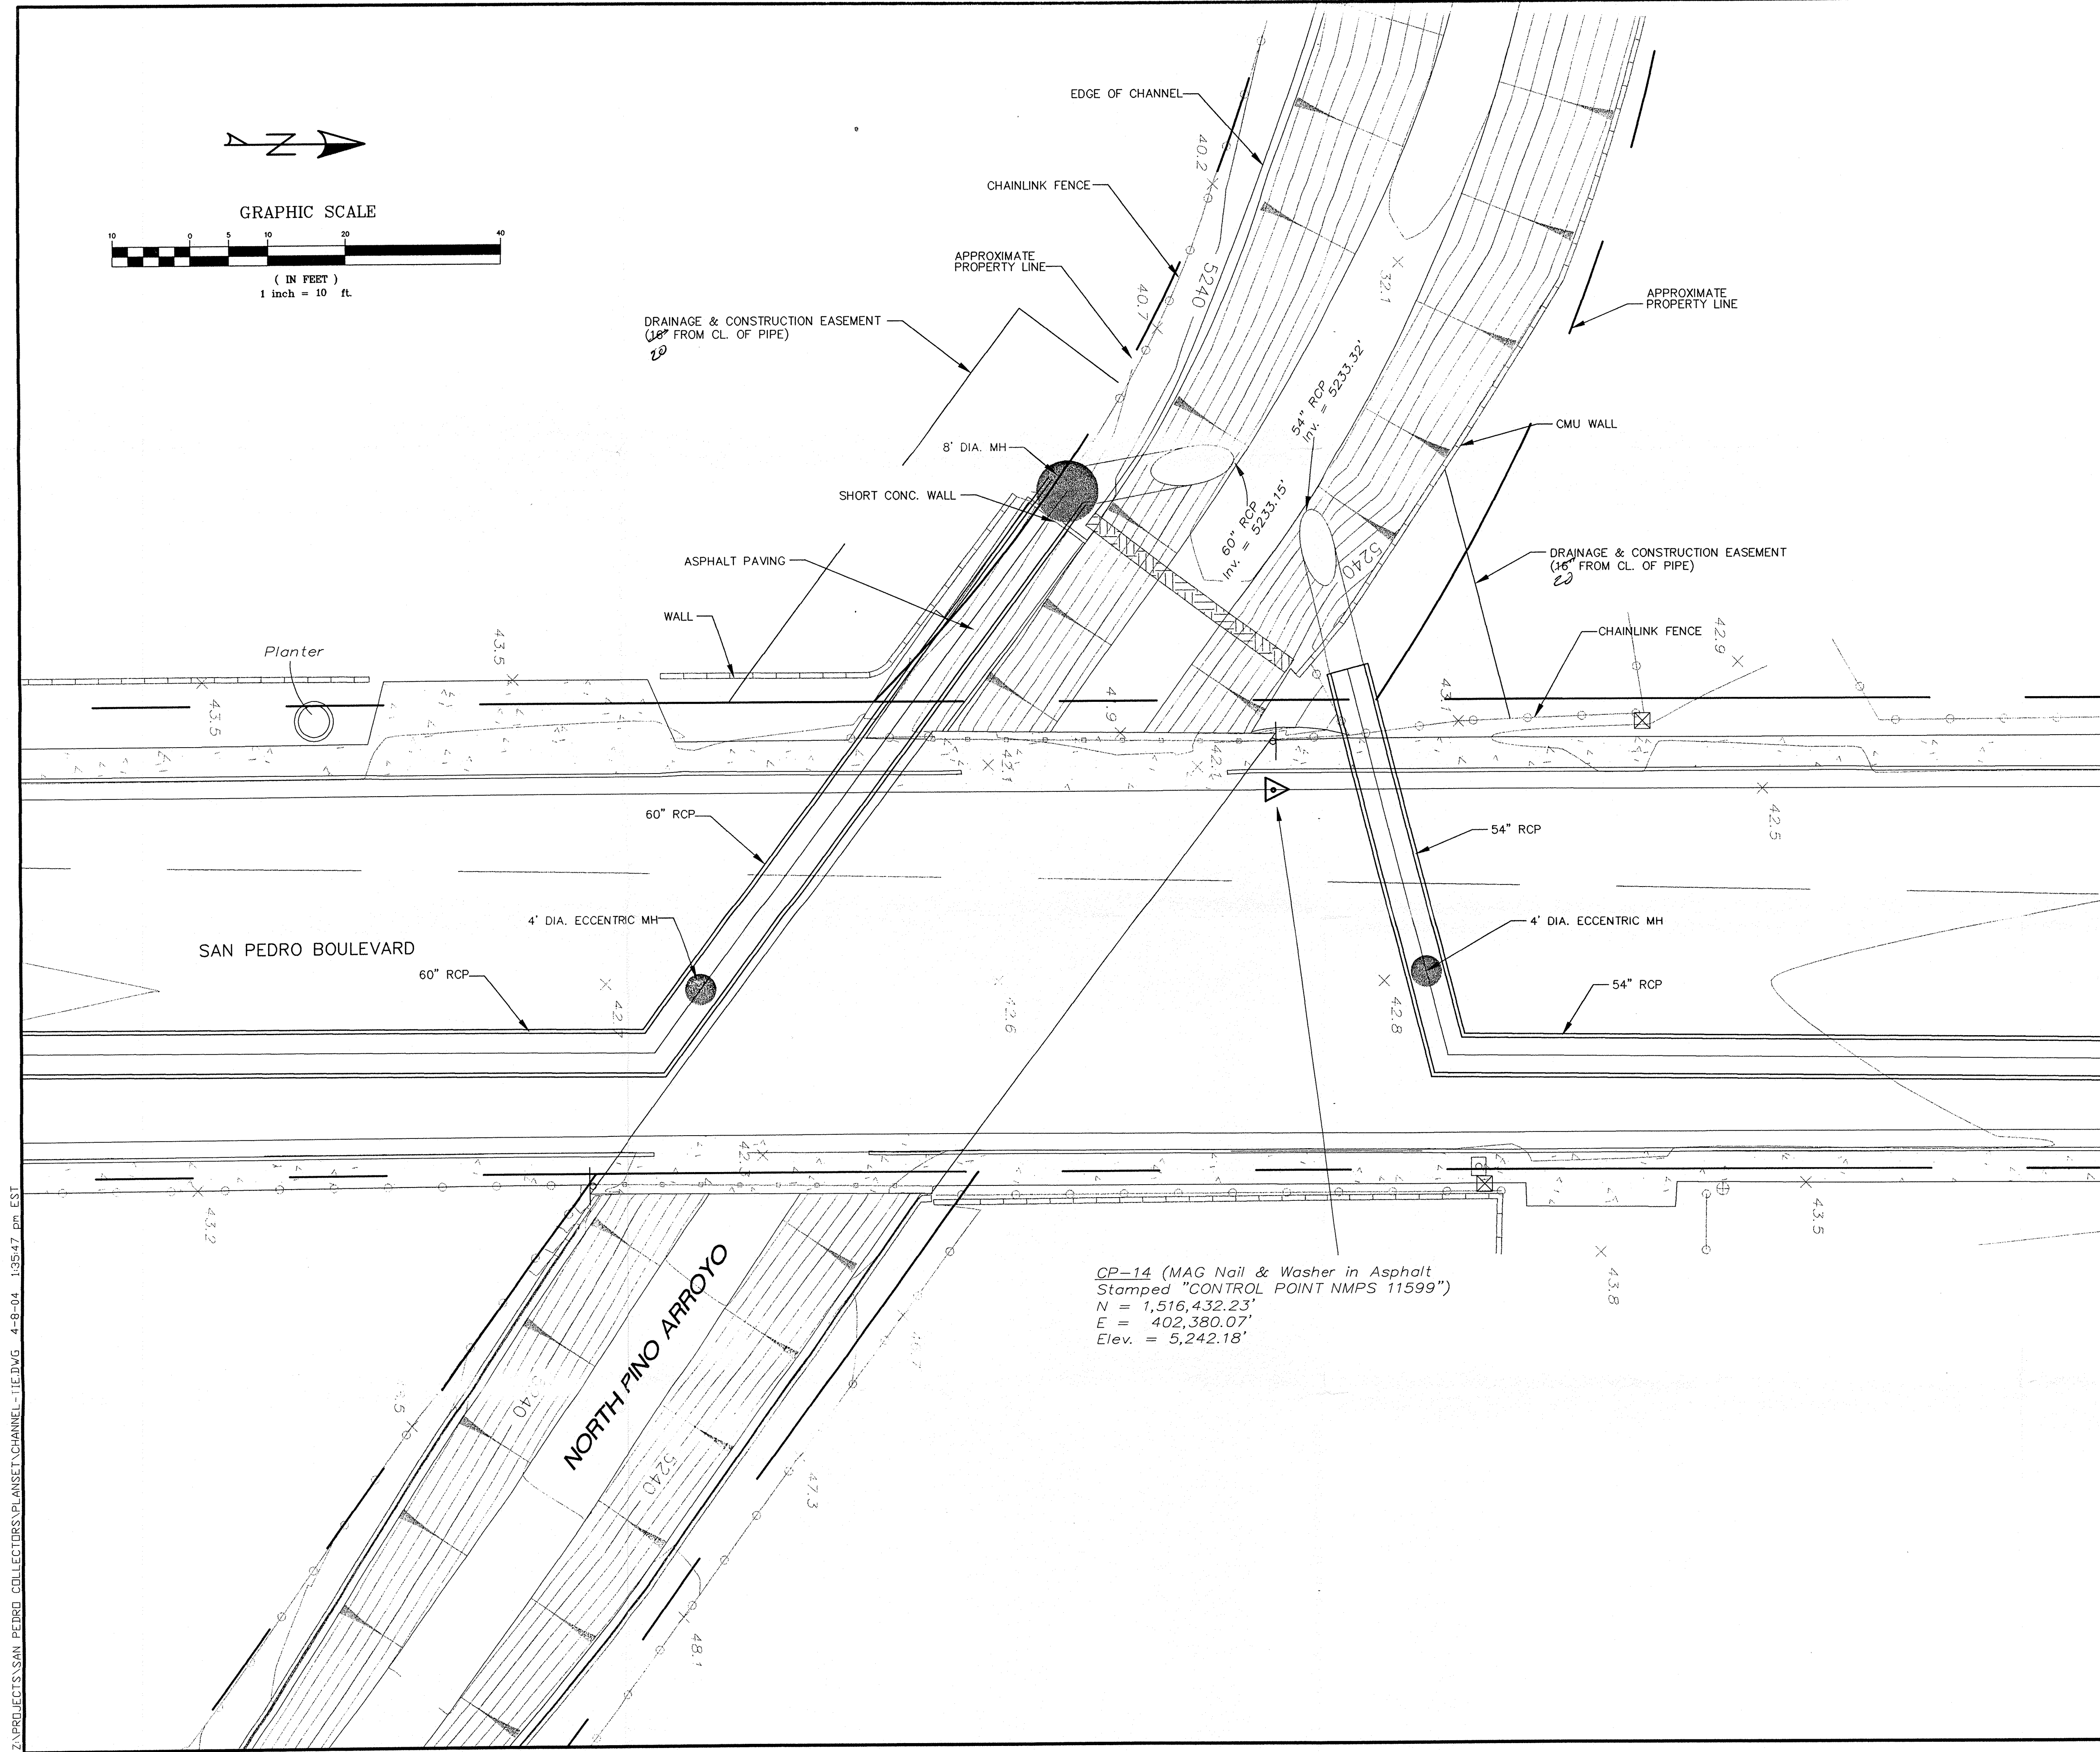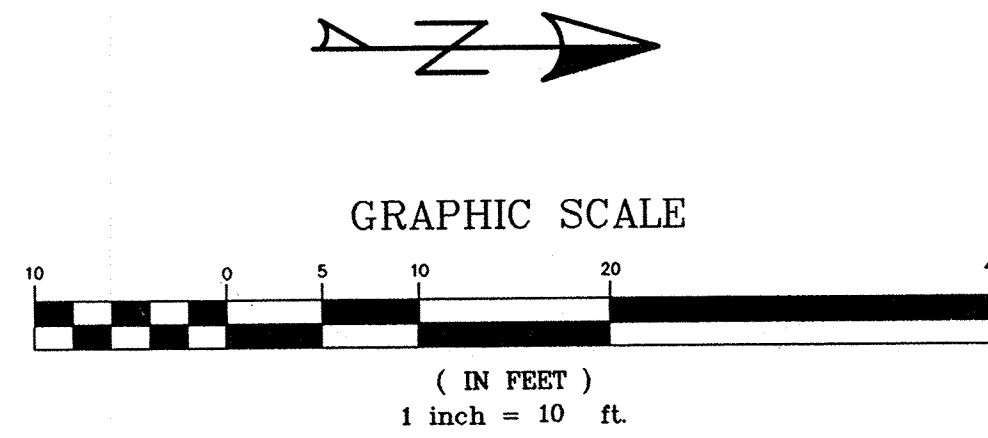

CP-14 (MAG Nail & Washer in Asphalt  
Stamped "CONTROL POINT NMPS 11599")  
N = 1,516,432.23'  
E = 402,380.07'  
Elev. = 5,242.18'

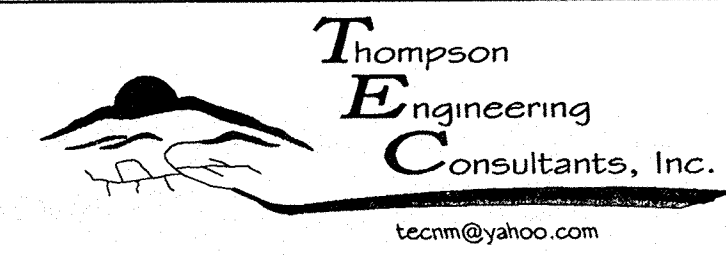

|                                                                                 |                        |                    |                 |
|---------------------------------------------------------------------------------|------------------------|--------------------|-----------------|
| CITY OF ALBUQUERQUE<br>PUBLIC WORKS DEPARTMENT<br>ENGINEERING DEVELOPMENT GROUP |                        |                    |                 |
| TITLE: <b>SAN PEDRO BOULEVARD<br/>NORTH PINO COLLECTOR DETAIL</b>               |                        |                    |                 |
| Design Review Committee                                                         | City Engineer Approval | Last Design Update | No. / Day / Yr. |
| City Project No.                                                                | Zone Map No.           | Sheet No.          | <b>PLATE 3</b>  |

| AS BUILT INFORMATION   |      | BENCH MARKS |      | SURVEY INFORMATION |    | ENGINEERS SEAL |  | REVISIONS   |      | DATE |     |
|------------------------|------|-------------|------|--------------------|----|----------------|--|-------------|------|------|-----|
| CONTRACTOR             | DATE | XXXX        | XXXX | NO.                | BY |                |  | NO.         | DATE | DBT  | DBT |
| WORKED BY              | DATE | XXXX        | XXXX |                    |    |                |  | DESIGNED BY | DATE | DBT  | DBT |
| INSPECTED BY           | DATE | XXXX        | XXXX |                    |    |                |  | DRAWN BY    | DATE | DBT  | DBT |
| ACCEPTANCE BY          | DATE | XXXX        | XXXX |                    |    |                |  | CHECKED BY  | DATE | DBT  | DBT |
| VERIFICATION BY        | DATE | XXXX        | XXXX |                    |    |                |  |             |      |      |     |
| DRAWINGS BY            | DATE | XXXX        | XXXX |                    |    |                |  |             |      |      |     |
| REVISIONS BY           | DATE | XXXX        | XXXX |                    |    |                |  |             |      |      |     |
| MICRO-FILM INFORMATION | DATE | XXXX        | XXXX |                    |    |                |  |             |      |      |     |
| RECORDED BY            | DATE | XXXX        | XXXX |                    |    |                |  |             |      |      |     |
| NO.                    |      | XXXX        | XXXX |                    |    |                |  |             |      |      |     |

