CITY OF ALBUQUERQUE

January 8, 2016



Asa Nilsson-Weber, P.E. Isaacson & Arfman, PA 128 Monroe St NE Albuquerque, NM 87108

Re: Broadstone Promenade Phase 10

6400 San Pedro Dr. NE Permanent CO – Accepted

Engineer's Stamp dated: 5-26-15 (D18D054A)

Certification dated: 1-7-16

Dear Ms. Nilsson-Weber,

Based upon the information provided in your submittal received 1/7/2016, the above referenced Certification received is acceptable for the release of Certificate of Occupancy by Hydrology.

PO Box 1293

If you have any questions, you can contact me at 924-3696 or Totten Elliott at 924-3982.

Albuquerque

Sincerely,

New Mexico 87103

Rita Harmon, P.E.

www.cabq.gov

Senior Engineer, Planning Dept.

Development Review Services

TE/RH

C:

email

Cordova, Camille C.; Connor, Miranda, Rachel; Sandoval, Darlene M.; Barreras, Gary S.; Blocker, Lois

DRAINAGE CERTIFICATION NOTES——CONT'D: I, Fred C. Arfman, NMPE 7322, Genevieve L. Donart NMPE 15088 PHASE 7: or Åsa Nilsson-Weber, NMPE 17631 of the firm Isaacson & Arfman, P.A., hereby certify that this project has been graded RIM ELEVATION OF INLET (ITEM 8) SHALL BE VERIFIED and will drain in substantial compliance with and in accordance PRIOR TO FINAL CERTIFICATION. with the design intent of the approved plan dated May 26, 2015; Grading And Drainage Plan CG1.1-CG1.4. The record PHASES 8&9: information edited onto the original design document has been SIDEWALK CULVERT SHALL BE CONSTRUCTED PRIOR TO obtained by Russ P. Hugg, NMPS 9750, of the firm Surv-Tek, Inc. I further certify that I or someone under my direct PHASE 10 CERTIFICATION. supervision have personally visited the project site at various DRAIN PIPES SHALL BE INSTALLED PRIOR TO PHASE 10 times as documented below and have determined by visual CERTIFICATION. inspection that the survey data provided is representative of actual site conditions and is true and correct to the best of CHIPPED SIDEWALK CONCRETE AND DEFORMED DRAINAGE PIPES. DRAIN PIPES SHALL BE REINSTALLED my knowledge and belief. This certification is submitted in support of a request for Permanent Certification of Occupancy for those individual buildings listed below. PRIOR TO FINAL CERTIFICATION. The record information presented hereon is not necessarily complete and intended only to verify substantial compliance of the grading and drainage aspects of this project. Those relying on this record document are advised to obtain independent verification of its accuracy before using it for any other Genevieve L. Donart NMPE 15088 Fred C. Arfman NMPE 7322 Åsa Nilsson-Weber NMPE 17631 BUILDING NO PH 1/BLDG Clea Wilnon Weber 8-17-15 1 PH 2/FIT. BLD(& POOL Two C. Or Gener 08.25-15/2 AREA BLDGS 20&22 Genvius L. DD 9/28/15 /3/6/A Qua Wilson Weber 10-28-15 Cara Wilnon-Weber PH 7/ BLDG

PHS 8&9/ Ou Clibson Weber 12-2-15 12 13 114 BLDGS 5&6 (RAMADA BLDG) Cha Wilsson-Weber 12-14-15 Qua Wilnon-Weber 12-22-15 (Chall Inon- Weber 01-07-16)

NOTES: PHASE 1

SHALL BE CONSTRUCTED PRIOR TO CERTIFICATION OF BUILDING 2. PHASE 2:

SIDEWALK CULVERT NOT CONSTRUCTED. CULVERT

/2\LOWER/ADJUST STORM DRAIN GRATES TO GRADE. TO BE VERIFIED PRIOR TO CERTIFICATION OF PHASE 3. PHASE 3:

3\INSTALLATION OF SIDEWALK CULVERT OR PVC PIPES TO BE VERIFIED PRIOR TO CERTIFICATION OF PHASE 4. PHASE 5:

A GRADING OF SLOPE TO BE VERIFIED PRIOR TO

*CERTIFICATION OF PHASE 4.

PHASE 4: COMPLETION OF ITEMS FROM PHASES 3 & 5 TO

BE VERIFIED PRIOR TO FINAL CERTIFICATION. 5\INSTALLATION OF 4" PVC PIPES TO BE VERIFIED

PRIOR TO FINAL CERTIFICATION. /6\LANDSCAPING TO BE ADJUSTED SUCH THAT A SWALE DIRECTS STORM WATER TO PIPES OR SIDEWALK CULVERTS AND THAT TOP OF MATERIAL IS AT INVERT OF PIPE OR CULVERT TO ALLOW FOR FLOW THROUGH. UNDER NO CIRCUMSTANCES SHOULD THE ENDS OF PIPES OR CULVERTS BE

BURIED. THIS SHALL BE VERIFIED PRIOR TO FINAL

CERTIFICATION. <u>√7</u>OBTAIN ADDITIONAL AS-BUILT SPOTS TO ALLOW FOR VERIFICATION OF DRAINAGE PATHS AND SLOPES PRIOR TO FINAL CERTIFICATION.

PHASE 6:

/8\grade a defined swale/overflow path to BOTTOM OF SIDEWALK CULVERT AND LINE SWALE WITH FRACTURED FACE ROCK. TOP OF ROCK ELEVATION SHALL BE AT INVERT OF CULVERT.

CONSTRUCTION OF ITEMS 8 & 9 SHALL BE

COMPLETED BEFORE CERTIFICATION OF PHASE 7. 104" PIPES INSTALLED THROUGH SIDEWALKS.

DRAINAGE SHEET KEY

EAST WEST MIDDLE CG1.4 **CG1.3**

FOR USE ON: **LEGEND** CG1.1, CG1.2, CG1.3, CG.14 PROPOSED CONTOUR - 1' INCREMENT

PROPOSED CONTOUR - 0.5' INCREMENT — — — -75.5 — — PROPOSED SPOT ELEVATION

FLOW ARROW F.F.=XXXX.XX FINISH FLOOR ELEVATION

EXISTING ELEVATION (\pm) TO MATCH. PROVIDE SMOOTH TRANSITION.

ROCK EROSION CONTROL GRADE BREAK

~~~~~

PROPOSED STORM DRAIN (SEE CG5.1) BUILDING PHASE LINE

PHASE 2 **♦**68.08 **♠**78.3

AS-BUILT SPOT ELEVATION

GENERAL NOTES

 \neg BLDG $\overline{23}$

- ENGINEER'S INTENT BEFORE PROCEEDING. COORDINATE WORK WITH SITE PLAN, UTILITY PLAN, PAVING PLAN, AND LANDSCAPE PLAN.
- ALL TRASH, DEBRIS, & SURFACE VEGETATION SHALL BE CLEARED
- AND LEGALLY DISPOSED OF OFFSITE.

IT IS THE CONTRACTOR'S RESPONSIBILITY TO FIELD VERIFY EXISTING

CONDITIONS PRIOR TO CONSTRUCTION. REPORT ALL DISCREPANCIES

TO THE ARCHITECT / ENGINEER AND VERIFY THE ARCHITECT /

- PROPOSED SPOT AND CONTOUR ELEVATIONS SHOWN REPRESENT TOP OF FINISH MATERIAL (I.E. TOP OF CONCRETE, TOP OF CONCRETE BUILDING PAD, TOP OF PAVEMENT MATERIAL, TOP OF LANDSCAPING MATERIAL, ETC.). CONTRACTOR SHALL GRADE, COMPACT SUBGRADE AND DETERMINE EARTHWORK ESTIMATES BASED ON ELEVATIONS SHOWN MINUS FINISH MATERIAL THICKNESSES.
- EXISTING UTILITY LINES ARE SHOWN IN AN APPROXIMATE MANNER ONLY AND MAY BE INCOMPLETE OR OBSOLETE. SUCH LINES MAY OR MAY NOT EXIST WHERE SHOWN OR NOT SHOWN. CONTRACTOR SHALL CONTACT NM-811 FOR UTILITY LINE SPOTS TWO WORKING DAYS PRIOR TO CONDUCTING SITE FIELD WORK. CONTRACTOR SHALL FIELD VERIFY AND LOCATE ALL UTILITIES PRIOR TO COMMENCEMENT OF ANY CONSTRUCTION. CONTRACTOR IS FULLY RESPONSIBLE FOR ANY AND ALL DAMAGE CAUSED BY ITS FAILURE TO LOCATE, IDENTIFY AND PRESERVE ANY AND ALL EXISTING UTILITIES, PIPELINES, AND UNDERGROUND UTILITY LINES.
- ALL NEW PAVEMENT SURFACES SHALL BE CONSTRUCTED WITH POSITIVE SLOPE AWAY FROM BUILDINGS. WHERE NEW GRADES ARE SHOWN AS 'MATCH' OR '±', TRANSITIONS SHALL BE SMOOTH AND ADA ACCESSIBLE.
- SIDESLOPES > 3:1 SHALL HAVE PERMANENT EROSION CONTROL INSTALLED DURING LANDSCAPING PHASE AND WILL NOT BE INCLUDED IN ENGINEER'S CERTIFICATION FOR CERTIFICATE OF OCCUPANCY. NO SLOPE SHALL BE STEEPER THAN 1:1.
- ENGINEER RECOMMENDS THAT OWNER INSPECT SITE YEARLY AND AFTER EACH RAINFALL TO IDENTIFY NEW AREAS OF EROSION AND INSTALL ADDITIONAL EROSION PROTECTION AS NEEDED BASED ON ACTUAL OCCURRENCES.
- PAVEMENT GRADES IN MARKED HANDICAPPED PARKING AREAS SHALL NOT EXCEED 2.0% IN ANY DIRECTION. DESIGN GRADES ARE APPROX. 1.8% TO ALLOW FOR CONSTRUCTION TOLERANCES.

FOR ALL ACCESSIBLE ROUTES, MAXIMUM ALLOWABLE CROSS SLOPE

IS 2.0% AND MAXIMUM LONGITUDINAL SLOPE WITHOUT RAMP IS 5.0%. FOLLOW ALL ADA ACCESSIBILITY GUIDELINES OR CITY CODES, WHICHEVER IS MORE STRINGENT.

DERICKSON

_5272.8 -

AVENUE

- K. IF FIELD GRADE ADJUSTMENTS ARE REQUIRED, THE CONTRACTOR SHALL NOTIFY THE ARCHITECT/ENGINEER.
- ADJUST RIMS OF EXISTING UTILITY FEATURES AS NECESSARY TO MATCH NEW GRADES.
- M. UTILITIES IN PAVED AREAS SHALL BE HS-25 TRAFFIC RATED..
- N. ALL AREAS DISTURBED BY CONSTRUCTION (OUTSIDE PROPOSED TURF AREA) SHALL BE RESEEDED WITH NATIVE GRASS PER C.O.A. SPECIFICATIONS SECTION 1012 (FOR SANDY SOILS) OR AS SPECIFIED ON THE LANDSCAPE PLAN.
- F. A CURRENT STORMWATER CONTROL PERMIT, INCLUDING AN EROSION SEDIMENT CONTROL PLAN (E.S.C.)FOR EROSION AND SEDIMENT CONTROL IS REQUIRED FOR ALL CONSTRUCTION, DEMOLITION CLEARING, AND GRADING OPERATIONS THAT DISTURB THE SOIL ON ONE ACRE OR MORE OF LAND. OWNER WILL COORDINATE. A CITY-APPROVED ESC PERMIT MUST BE INCLUDED WITH THE CONTRACTOR'S SUBMITTAL FOR A ROUGH GRADING, GRADING, PAVING, BUILDING, OR WORK ORDER PERMIT
- POST-CONSTRUCTION MAINTENANCE FOR PRIVATE STORMWATER FACILITIES WILL BE THE RESPONSIBLITY OF THE FACILITIES OWNER. PERIODIC INSPECTION AND CERTIFICATIONS OF THE FACILITIES MAY BE REQUIRED BY THE CITY ENGINEER.
- H. STORMWATER CONTROL MEASURES SHOWN ON THIS PLAN ARE REQUIRED TO PROVIDE MANAGEMENT OF 'FIRST FLUSH' (DEFINED AS THE 90TH PERCENTILE STORM EVENT OR 0.44" OF STORMWATER WHICH DISCHARGES DIRECTLY TO A PUBLIC STORM DRAINAGE SYSTEM).

SEE GEOTECHNICAL REPORT BY WESTERN TECHNOLOGIES FOR SOIL ANALYSIS AND SPECIFIC OVEREXCAVATION AND COMPACTION REQUIREMENTS

SEE STRUCTURAL PLANS FOR THICKNESS OF CONCRETE BLDG. SLABS AND SUB-SURFACE BASE COURSE TO ESTABLISH PAD GRADE AT BUILDINGS.

PROJECT INFORMATION

5276.0

√m 5275.0°

5275.0

PROPERTY: THE SITE IS A PREVIOUSLY DEVELOPED (MOBILE HOME) PROPERTY LOCATED WITHIN C.O.A. VICINITY MAP D-18. THE SITE IS BOUND TO THE SOUTH BY RECENTLY CONSTRUCTED APARTMENTS, TO THE EAST BY UNDEVELOPED PROPERTY, TO THE WEST BY SAN PEDRO DRIVE NE AND TO THE NORTH BY DERICKSON AVENUE NE.

5276.5 - 5278.5

5277.0

5278.0

25 50

VICINITY MAP

DR

PHASING NOTE

CONSTRUCTION SEQUENCE OF BUILDINGS ARE DENOTED ON PLAN

CULVERTS, SIDEWALK DRAIN PIPES) SHALL BE CONSTRUCTED WITH

AS PHASES 1-21. ALL STORM DRAIN TRUNK LINES SHALL BE CONSTRUCTED PRIOR TO START OF BUILDING CONSTRUCTION. ALL

OTHER DRAINAGE IMPROVEMENTS (AREA INLETS, SIDEWALK

EACH BUILDING PHASE PRIOR TO CERTIFICATION.

SANTA MONICA

25 CH_1 A PGJ

SCALE 1"=50"

PROPOSED IMPROVEMENTS: THE PROPOSED IMPROVEMENTS INCLUDE A 21 BUILDING APARTMENT COMPLEX (INCLUDING GARAGE / CARRIAGE UNITS, OFFICE BLDG., HEALTH FACILITY) WITH ASSOCIATED ASPHALT PAVED DRIVES, PARKING, PEDESTRIAN WALKS AND LANDSCAPING.

LEGAL: TRACT 1, SANTA MONICA PLACE, ALBUQUERQUE. NM AREA: 9.2673 ACRES

BENCHMARK: VERTICAL DATUM IS BASED UPON THE ALBUQUERQUE CONTROL SURVEY BENCHMARK "18-E18", ELEVATION = 5269.166 (NGVD88)

EAST (TRACTS 3 AND 4) PREVIOUSLY IMPACTING THIS PROPERTY WILL CONTINUE TO BE DETAINED IN AN EXISTING TEMPORARY DETENTION POND ON TRACT 3. THE PROPOSED 48"Ø PUBLIC STORM DRAIN WILL BE EXTENDED EAST INTO TRACT 3 AND A TEMPORARY STANDPIPE WILL BE CONSTRUCTED WHICH WILL ACCEPT 100% OF THE DETAINED FLOW.

OFF-SITE: DRAINAGE FROM THE UNDEVELOPED TRACTS TO THE

FLOOD HAZARD: THE SUBJECT PROPERTY LIES WITHIN ZONE "X" (AREAS DETERMINED TO BE OUTSIDE 0.2% ANNUAL CHANCE FLOOD PLAIN) IN ACCORDANCE WITH THE NATIONAL FLOOD INSURANCE PROGRAM RATE MAP NO. 35001C0137 F, EFFECTIVE DATE 11-19-03.

SURVEYOR: RUSS P. HUGG, SURV-TEK, INC., (505)897-3366, ALBUQUERQUE, NEW MEXICO.

BROADSTONE 6400 SAN PEDRO DRIVE NE

Albuquerque, New Mexico



World HQ @ ORBArch.com







150

100

U FOR MITPARK 2 20 HOME

ACRES

SU-1

1003916

PLACE

SITE

Contractor must verify all dimensions at project before proceeding with this work.

Do not reproduce these drawings and specifications without the expressed written permission of the Architect. The drawings and specifications are instruments of service and shall remain the property of the Architect whether the project for which they are made is executed or not. These drawings and specifications shall not be used by anyone on any other of this project by others except by the expressed written permission of the Architect.

REVISIONS 6/20/14 DESIGN TEAM COORDINATION 6/20/14 1ST CITY REVIEW


© ORB Architecture, LLC 2013


3 7/9/14 2ND CITY REVIEW 4 7/28/14 DESIGN TEAM COORDINATION

CONSTRUCTION SET

DATE: JULY 28, 2014 ORB # 13-220

OVERALL **GRADING AND DRAINAGE PLAN**

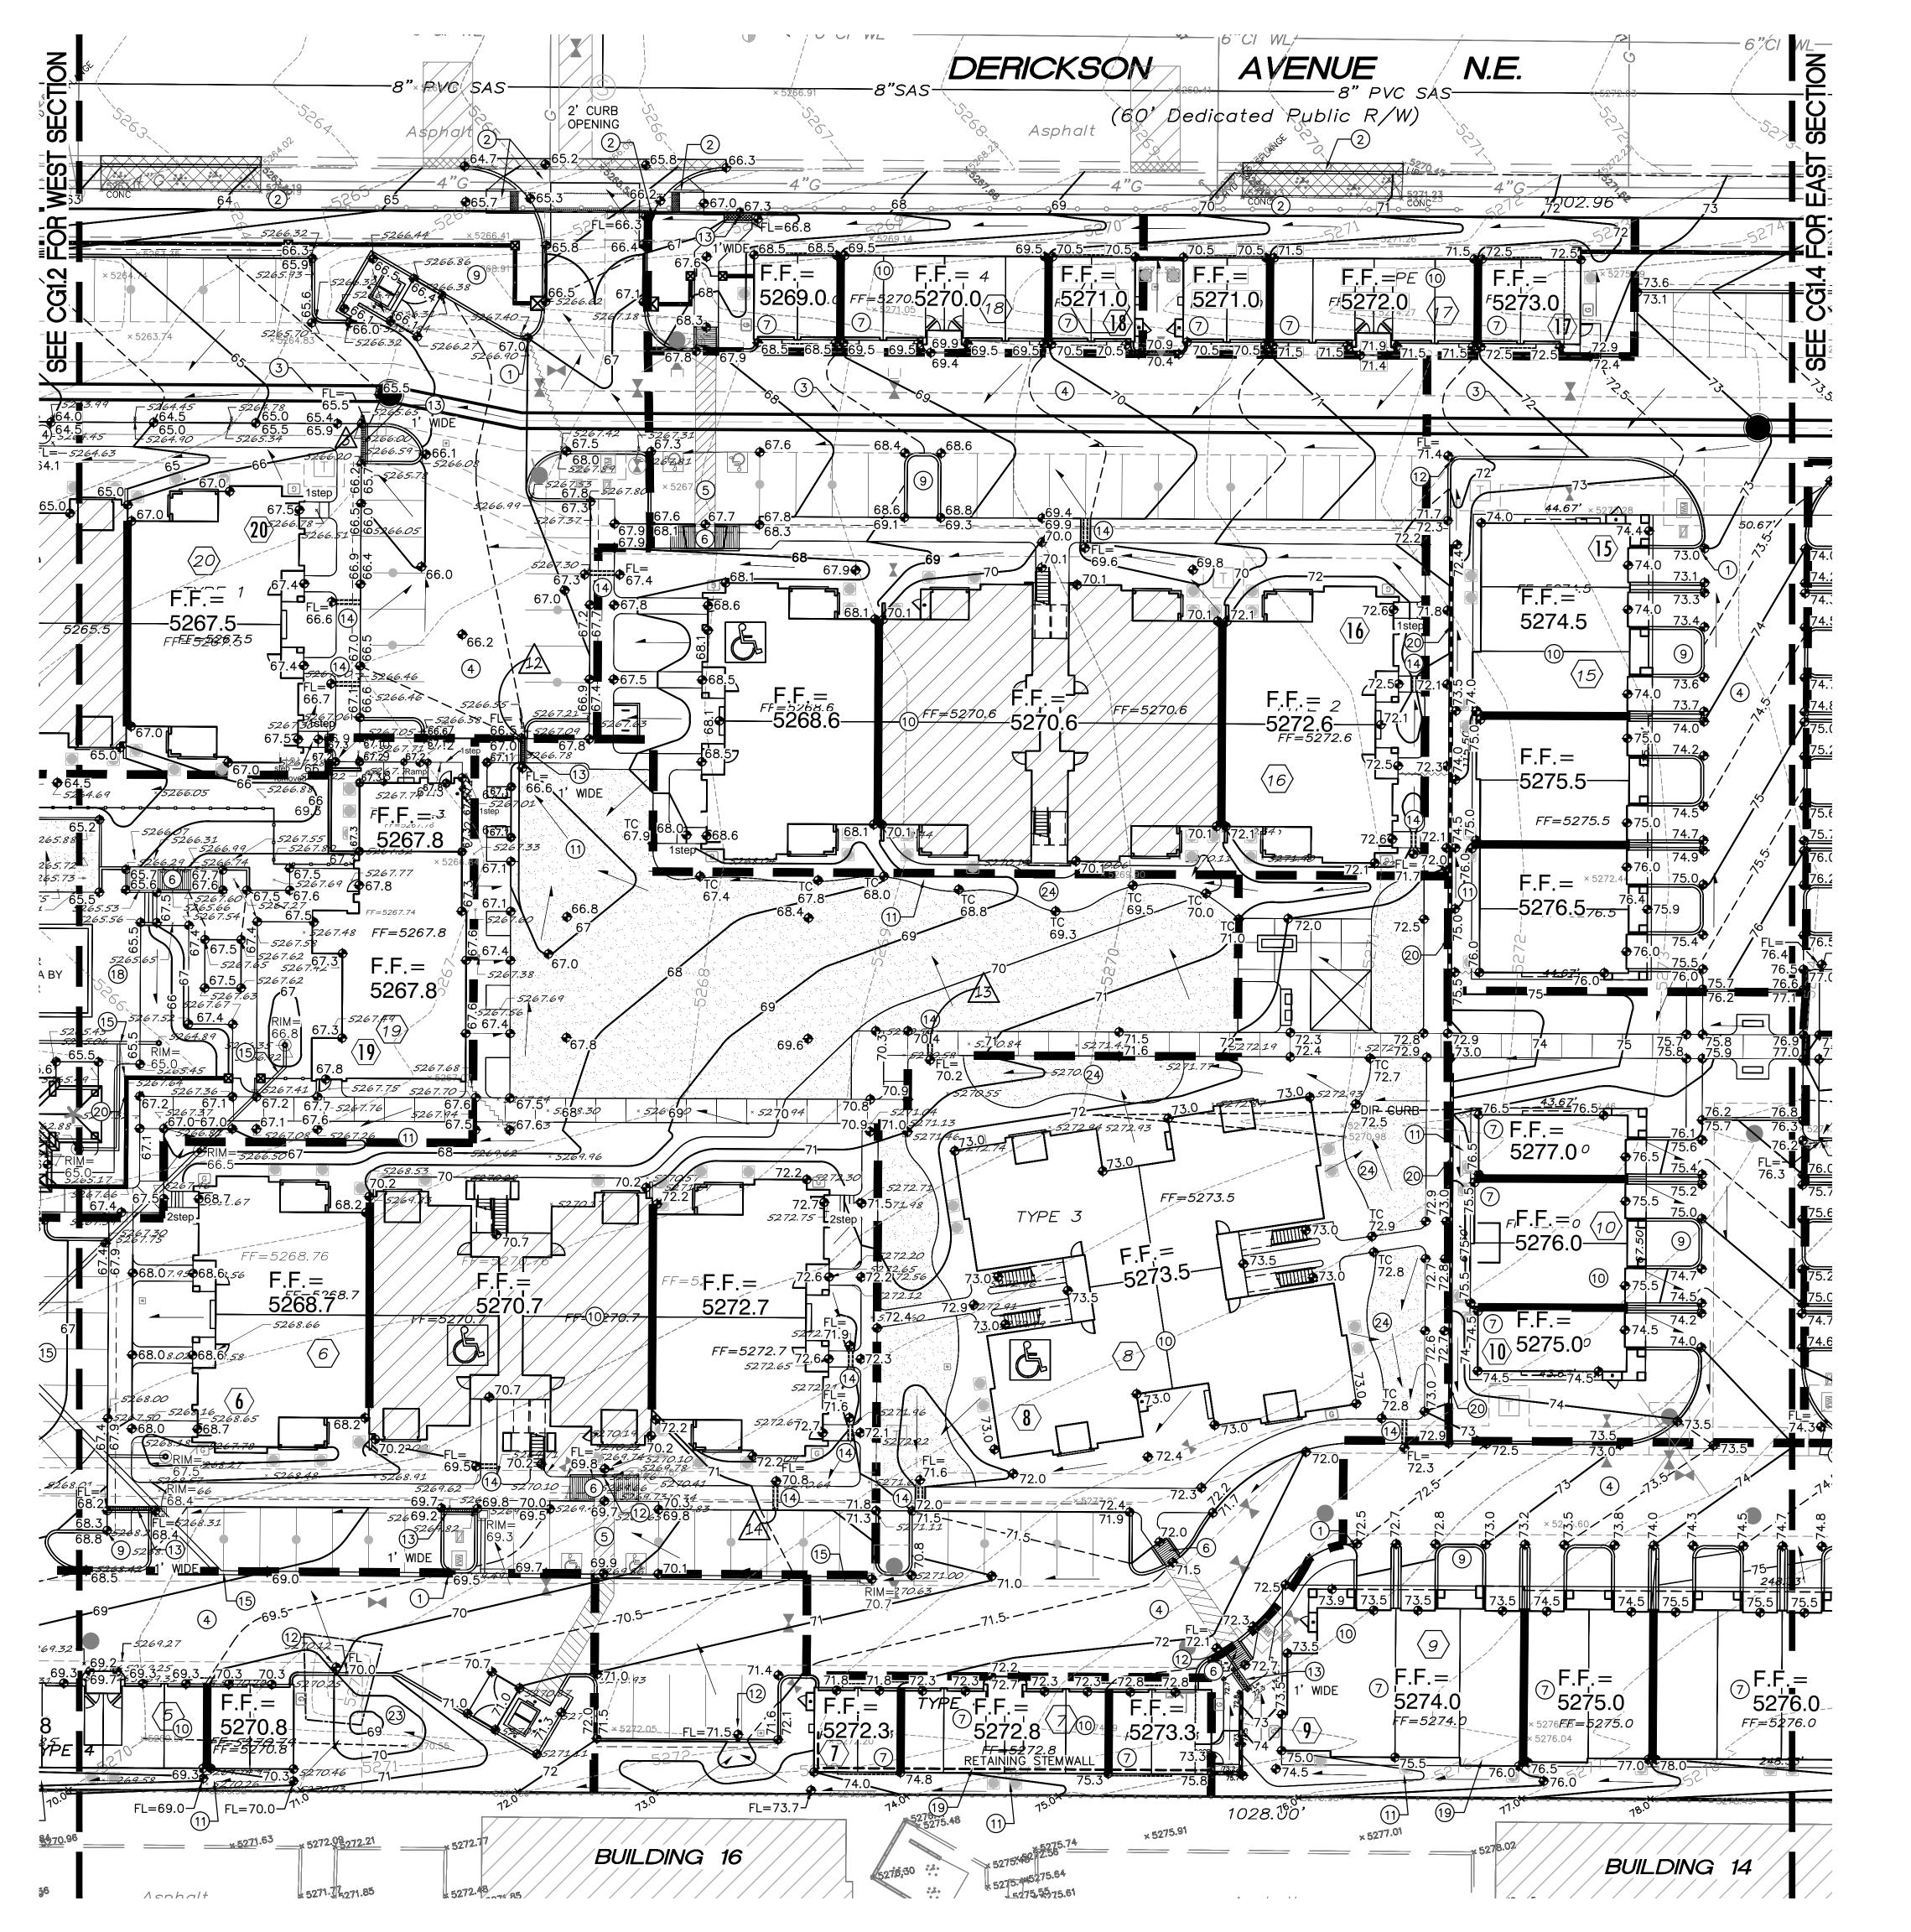

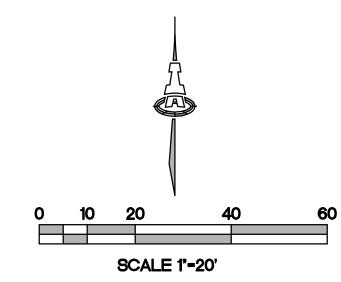


KEYED NOTES

THESE NOTES ARE REFERENCED ON SHEETS CG1.2, CG1.3 AND CG1.4. NOT ALL NOTES ARE USED ON EACH SHEET.

- SPOT ELEVATION LABELS WITHIN GUTTER AREA REPRESENT FLOWLINE UNLESS NOTED. ADD 0.5' TYPICAL FOR TOP OF CURB / TOP OF ADJACENT WALK ELEVATIONS.
- 2. SEE PUBLIC WORK ORDER DRAWINGS FOR CONSTRUCTION WITHIN R.O.W. INCLUDING NEW ACCESS DRIVES WITH CONCRETE VALLEY GUTTER, HANDICAP RAMPS, PUBLIC SIDEWALKS, COVERED SIDEWALK CULVERTS, CURB OPENINGS ETC. GRADES SHOWN FOR INFORMATION ONLY.
- 3. SEE PUBLIC WORK ORDER DRAWINGS FOR CONSTRUCTION OF PUBLIC STORM SEWER SYSTEM WITHIN PUBLIC DRAINAGE EASEMENT THIS AREA.
- CONSTRUCT PAVING, CURBS, WALKS AT ELEVATIONS SHOWN.
 SEE PAVING PLAN, PAVING DETAILS AND ARCHITECTURAL SITE
 DETAILS FOR ADDITIONAL INFORMATION. NOTE THAT PAVEMENT
 SLOPES AND CROSS—SLOPES VARY THROUGHOUT TO ACHIEVE
 GRADES NECESSARY TO ACHIEVE PEDESTRIAN ACCESS, STREET
 STORMWATER CAPACITIES, PIPE COVERAGE, ETC.
- . SLOPES WITHIN HANDICAP PARKING AREAS TO MEET ADA REQUIREMENTS. MAX. SLOPE = 2% IN ANY DIRECTION.
- 6. CONSTRUCT HANDICAP ACCESS RAMP TO ADA STANDARDS. SEE ARCHITECTURAL FOR DETAILS.
- 7. F.F. ELEVATION WITHIN THIS UNIT REFERENCES TOP OF CONCRETE STEP AT BACK OF GARAGE. GRADE AT GARAGE DOOR TO BE 6" BELOW F.F. TO ACCOMMODATE 4" STEP AND PAD SLOPE.
- 8. REGRADE THIS AREA AS SHOWN TO ACCOMMODATE TEMPORARY STORM DRAIN STANDPIPE FOR TRACT 3 AND 4 UNDEVELOPED FLOW. SEE PUBLIC WORK ORDER DRAWINGS FOR ADDITIONAL INFORMATION.
- DEPRESS LANDSCAPING TO 6" (TYPICAL) TO COLLECT LOCALIZED STORMWATER. FLOW IN EXCESS OF AREA CAPACITY WILL OVERFLOW AT LOW POINT. NOTE: DO NOT DEPRESS LANDSCAPING WITHIN 10' OF ANY STRUCTURE.
- 10. BUILDING ROOF DISCHARGE TO BE RELEASED TO ALL SIDES.
 PROVIDE CONCRETE SPLASH BLOCK AT DOWNSPOUT LOCATIONS
 (TYPICAL).
- 11. PROVIDE DEFINED SWALE WITHIN LANDSCAPING THIS AREA.
- 12. PROVIDE 1' WIDE OPENING IN CURB TO PASS FLOW.
- 13. CONSTRUCT ON—SITECOVERED SIDEWALK CULVERT (WIDTH PER PLAN) PER C.O.A. STD. DWG. 2236.
- 14. INSTALL TWO 4" DIA. PVC PIPE DRAINS @ 2% SLOPE THROUGH SIDEWALK PER C.O.A. STD. DWG. 2235. GRADE WITHIN LANDSCAPE TO DIRECT FLOW TO OPENING.
- 15. CONSTRUCT PRIVATE STORM DRAIN SYSTEM. SEE SHEET CG5.1 FOR SIZES / SLOPES / INLET INFORMATION / MATERIALS.
- 16. CONNECTION TO PUBLIC STORM SEWER INLET TO BE CONSTRUCTED PER C.O.A. STD. DWG. 2237. SEE CG5.1 FOR ADDITIONAL INFORMATION.
- 17. NOTE: STORM DRAIN CROSSES PUBLIC UTILITY MAINS THIS
- 18. POOL AREA GRADES SHOWN FOR GENERAL INFORMATION ONLY.
 POOL CONTRACTOR TO PROVIDE FINAL DESIGN GRADES / DECK
 DRAINS ETC.
- 19. CONSTRUCT RETAINING STEMWALL THIS BUILDING TO ACHIEVE GRADES SHOWN. SEE ARCHITECTURAL.
- 20. CONSTRUCT RETAINING WALL TO ACHIEVE GRADE DIFFERENCE THIS AREA. STRUCTURAL / WEEPHOLE DESIGN BY OTHERS.
- 21. 0.1' CONTOURS WITHIN OPEN COURTYARD THIS AREA PROVIDED TO CLARIFY DRAINAGE CONCEPT. COORDINATE WITH LANDSCAPE ARCHITECT.
- 22. EROSION CONTROL (MIN. 6" AVG. DIA. ANGULAR FACED ROCK)
 TO BE INSTALLED ON ALL SIDE SLOPES > 3:1 AND AS SHOWN
 HATCHED.
- 23. CONSTRUCT DEPRESSED LANDSCAPING TO ELEVATIONS SHOWN TO COLLECT SUB-BASIN FLOW. FLOW IN EXCESS OF CAPACITY TO OVERFLOW AT ELEVATION OF 76.5 AS SHOWN. NO DETENTION SHALL OCCUR WITHIN 10' OF ANY STRUCTURE.
- 24. COORDINATE LANDSCAPING FEATURES I.E. MOW CURBS AND PUTTING GREEN WITH LANDSCAPE ARCHITECT WHILE MAINTAINING CLEAR DRAINAGE PATHS SHOWN.

DRAINAGE SHEET KEY

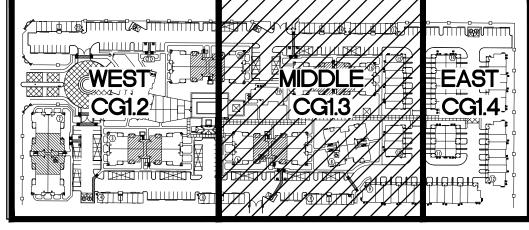

BROADSTONE PROMENADE

6400 SAN PEDRO DRIVE NE Albuquerque, New Mexico



World HQ@ORBArch.com







Contractor must verify all dimensions at project before proceeding with this work.

Do not reproduce these drawings and specifications without the expressed written permission of the Architect. The drawings and specifications are instruments of service and shall remain the property of the Architect whether the project for which they are made is executed or not. These drawings and specifications shall not be used by anyone on any other resident for additions to this project for for completion.

instruments of service and shall remain the property of the Architect whether the project for which they are made is executed or not. These drawings and specifications shall not be used by anyone on any other projects, for additions to this project, or for completion of this project by others except by the expressed written permission of the Architect.

© ORB Architecture, LLC 2013

REVISIONS

1 6/20/14 DESIGN TEAM COORDINATION
2 6/20/14 1ST CITY REVIEW
3 7/9/14 2ND CITY REVIEW

7/28/14 DESIGN TEAM COORDINATION

CONSTRUCTION SET

DATE: IIII V 28 2014 ORR # 13

CG1.3

MIDDLE GRADING AND DRAINAGE PLAN