

CITY OF ALBUQUERQUE

Planning Department
Brennon Williams, Director



Mayor Timothy M. Keller

August 16, 2021

Art Leyba
Catholic Cemetery Association
1900 Edith Blvd NE
Albuquerque, NM 87102

**Re: Niche Bank Buildings & Parking
7999 Wyoming
Request for Certificate of Occupancy
Transportation Development Final Inspection
Engineer's/Architect's Stamp dated 1-23-19 (D19D001A)**

Dear Mr. Leyba,

Based upon the information provided in your pictures received 8-16-21, Transportation Development has no objection to the issuance of a Permanent Certificate of Occupancy. This letter serves as a "green tag" from Transportation Development for a Permanent Certificate of Occupancy to be issued by the Building and Safety Division.

If you have any questions, please contact Ernie Gomez at (505) 924-3981.


Sincerely,

Jeanne Wolfenbarger, P.E.
Traffic Engineer, Planning Dept.
Development Review Services

Ernie Gomez
Plan Checker, Planning Dept.
Development Review Services

EG via: email
C: CO Clerk, File

AS BUILT INFORMATION DATE: _____ DRAWN BY: _____ CHECKED BY: _____ APPROVED BY: _____ DATE: _____		FIELD NOTES DATE: _____ DRAWN BY: _____ CHECKED BY: _____ APPROVED BY: _____ DATE: _____		ENGINEER'S SEAL DATE: _____ DRAWN BY: _____ CHECKED BY: _____ APPROVED BY: _____ DATE: _____	
REVISIONS NO. DATE BY 1 10/16/84 JAW		REVISIONS NO. DATE BY 1 10/16/84 JAW		REVISIONS NO. DATE BY 1 10/16/84 JAW	
PROJECT INFORMATION PROJECT NO. 1001684 PROJECT NAME: 7500 PASO DEL NORTE NE PROJECT LOCATION: PASO DEL NORTE NE PROJECT OWNER: WILSON & COMPANY		PROJECT INFORMATION PROJECT NO. 1001684 PROJECT NAME: 7500 PASO DEL NORTE NE PROJECT LOCATION: PASO DEL NORTE NE PROJECT OWNER: WILSON & COMPANY		PROJECT INFORMATION PROJECT NO. 1001684 PROJECT NAME: 7500 PASO DEL NORTE NE PROJECT LOCATION: PASO DEL NORTE NE PROJECT OWNER: WILSON & COMPANY	

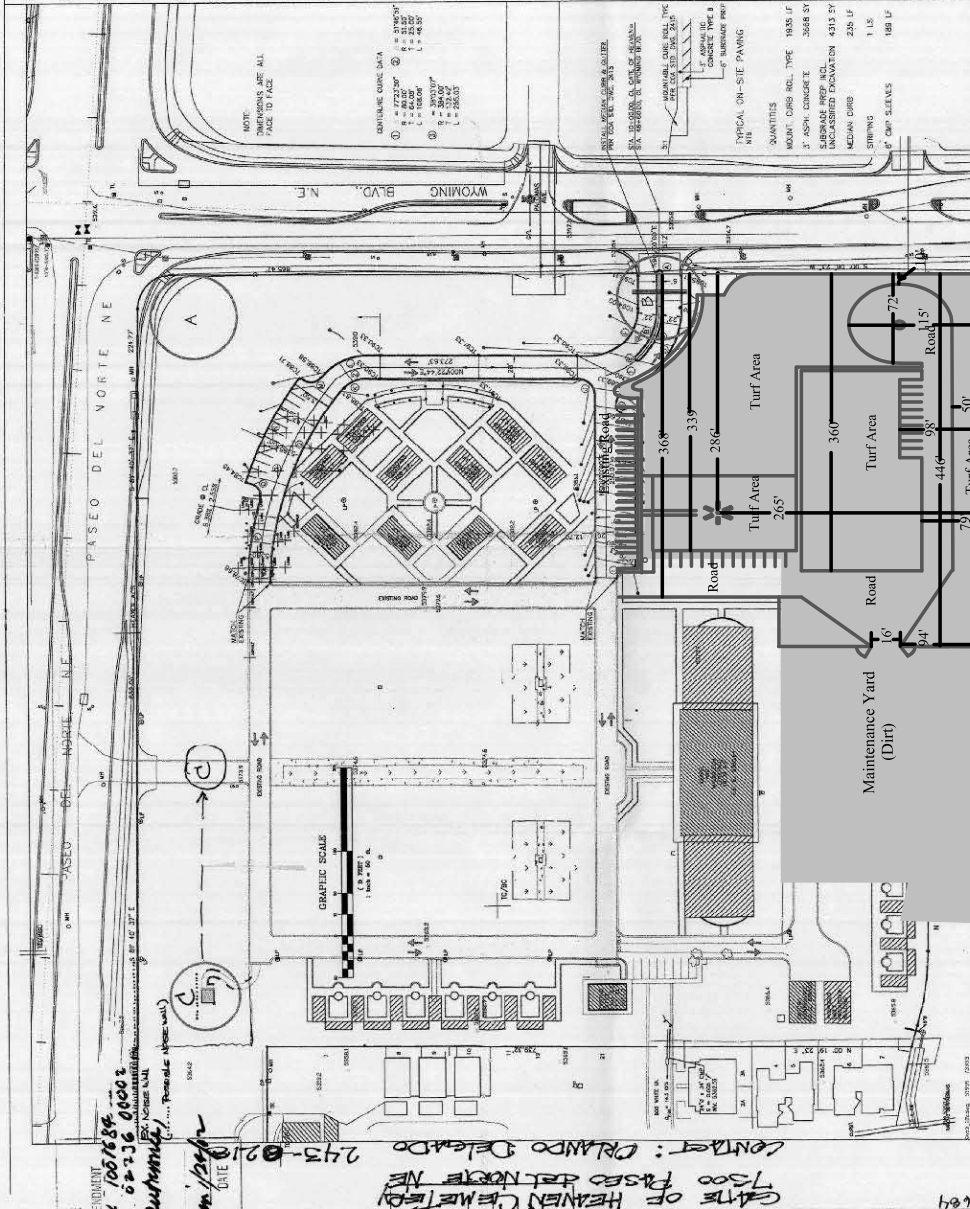

ADMINISTRATIVE
 DEVELOPMENT PLAN AMENDMENT
 1001684
 02-236 00003
 10/16/84
 WAVE, INC. (owner)
 PERGONA
 PLANNING DIRECTOR
 DATE: 10/16/84
 CENTRAL: CRANCO DELCADO
 7500 PASO DEL NORTE NE
 1001684
 02-236 00003
 10/16/84
 WAVE, INC. (owner)
 PERGONA
 PLANNING DIRECTOR
 DATE: 10/16/84

ADMINISTRATIVE AMENDMENT

FILE # 00279 PROJECT # 001912

New ground burial,

altered roadway, and

maintenance yard.

PR-2018

APPROVED BY PR-2018 DATE 23 Jan 2019

ADMINISTRATIVE

DEVELOPMENT PLAN AMENDMENT

1001684

02-136 00002

case, new entrance,

Permit

Richard Brown / 2018

PLANNING DIRECTOR

DATE

43-0210

