


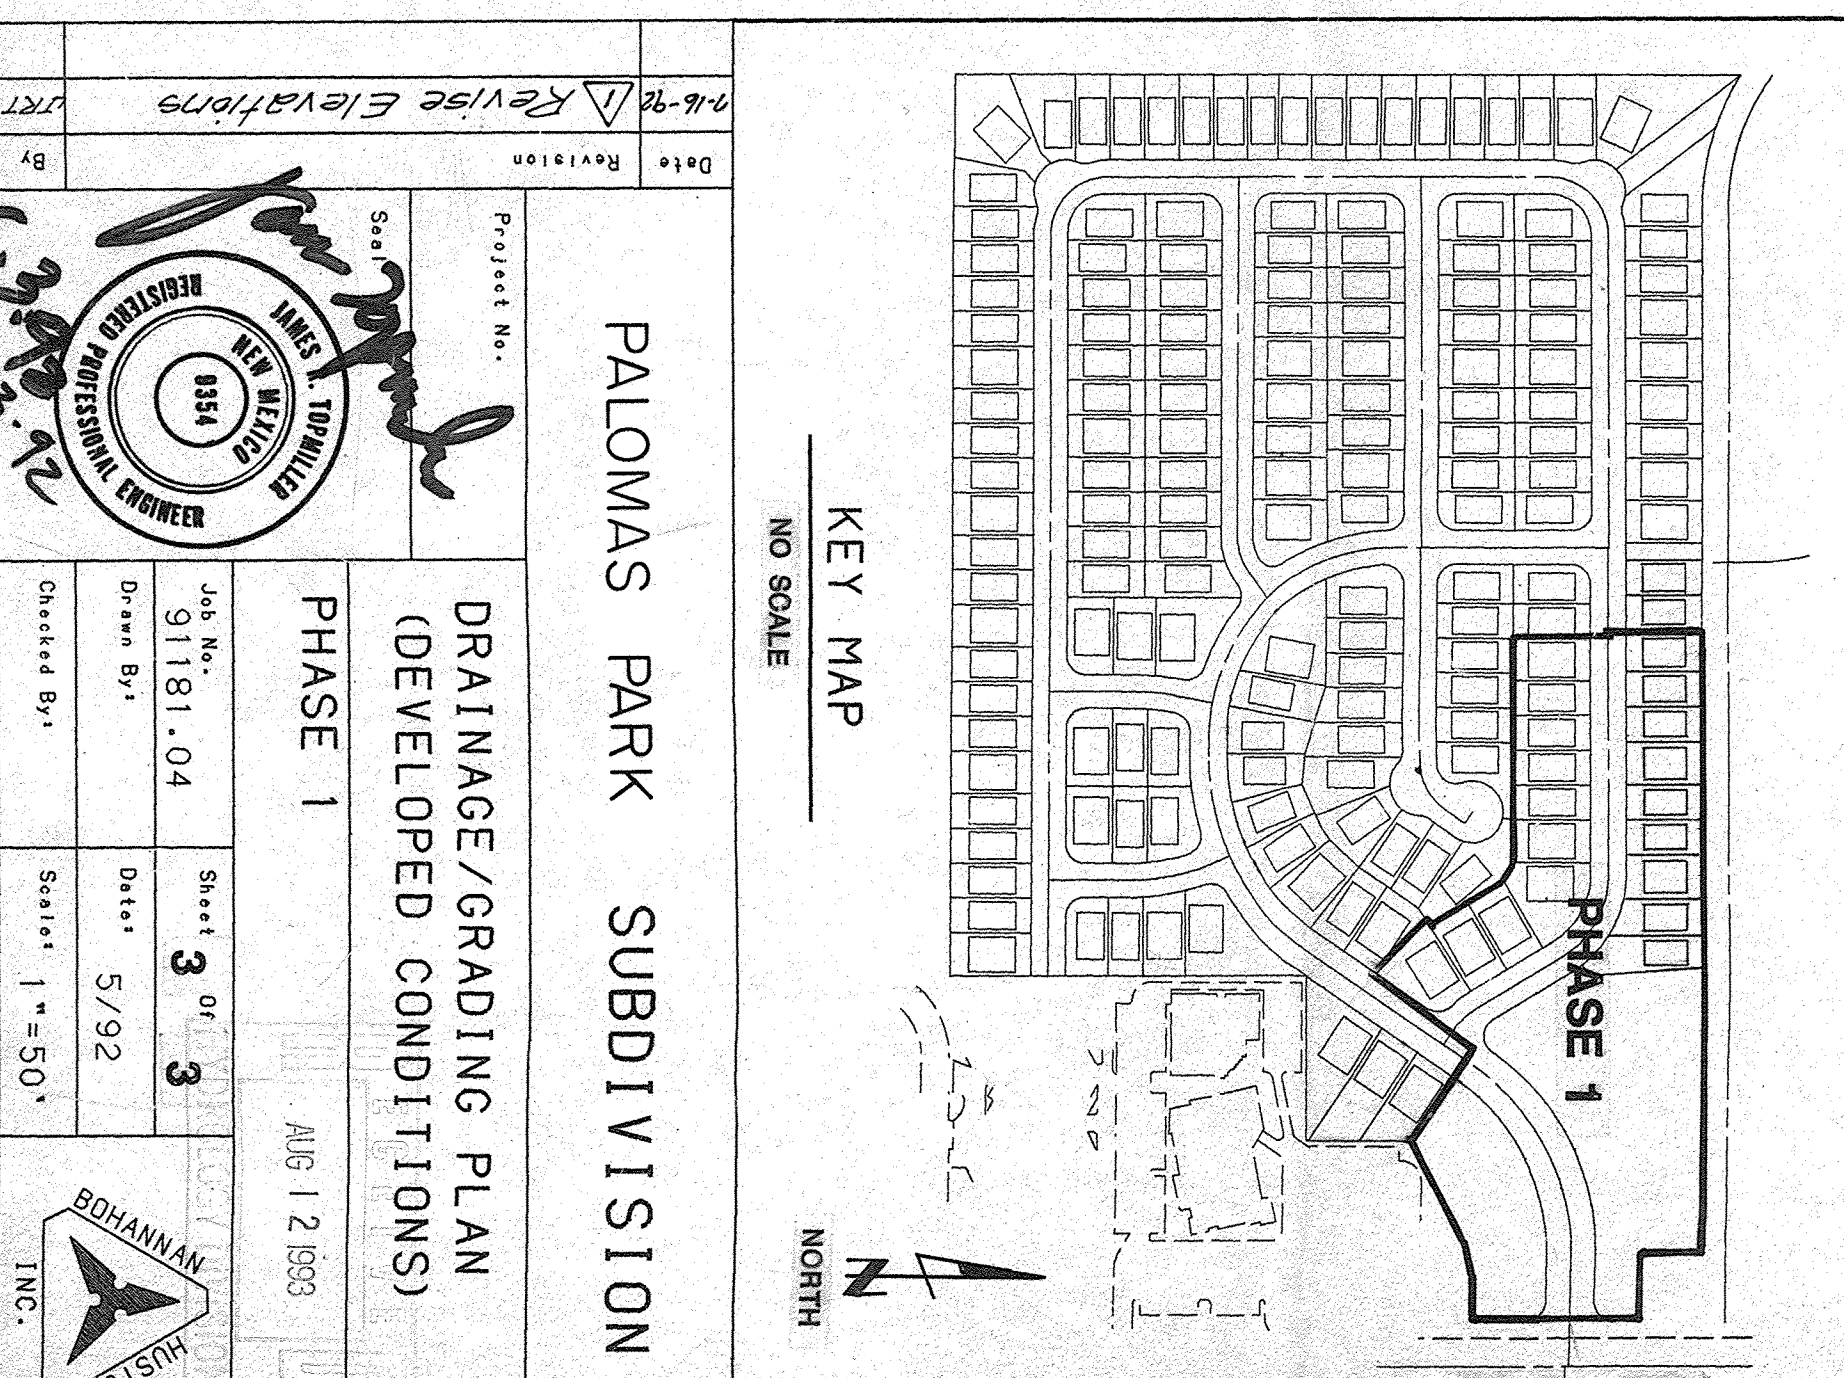
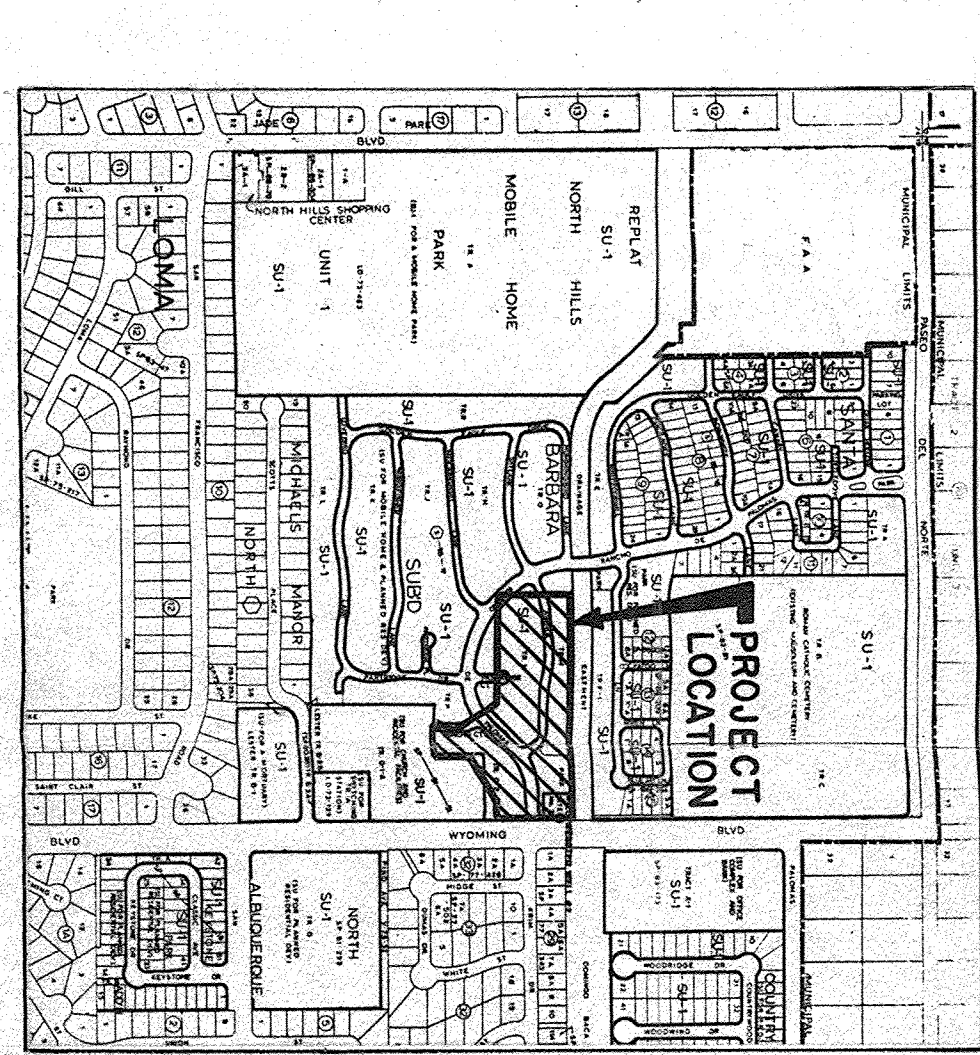
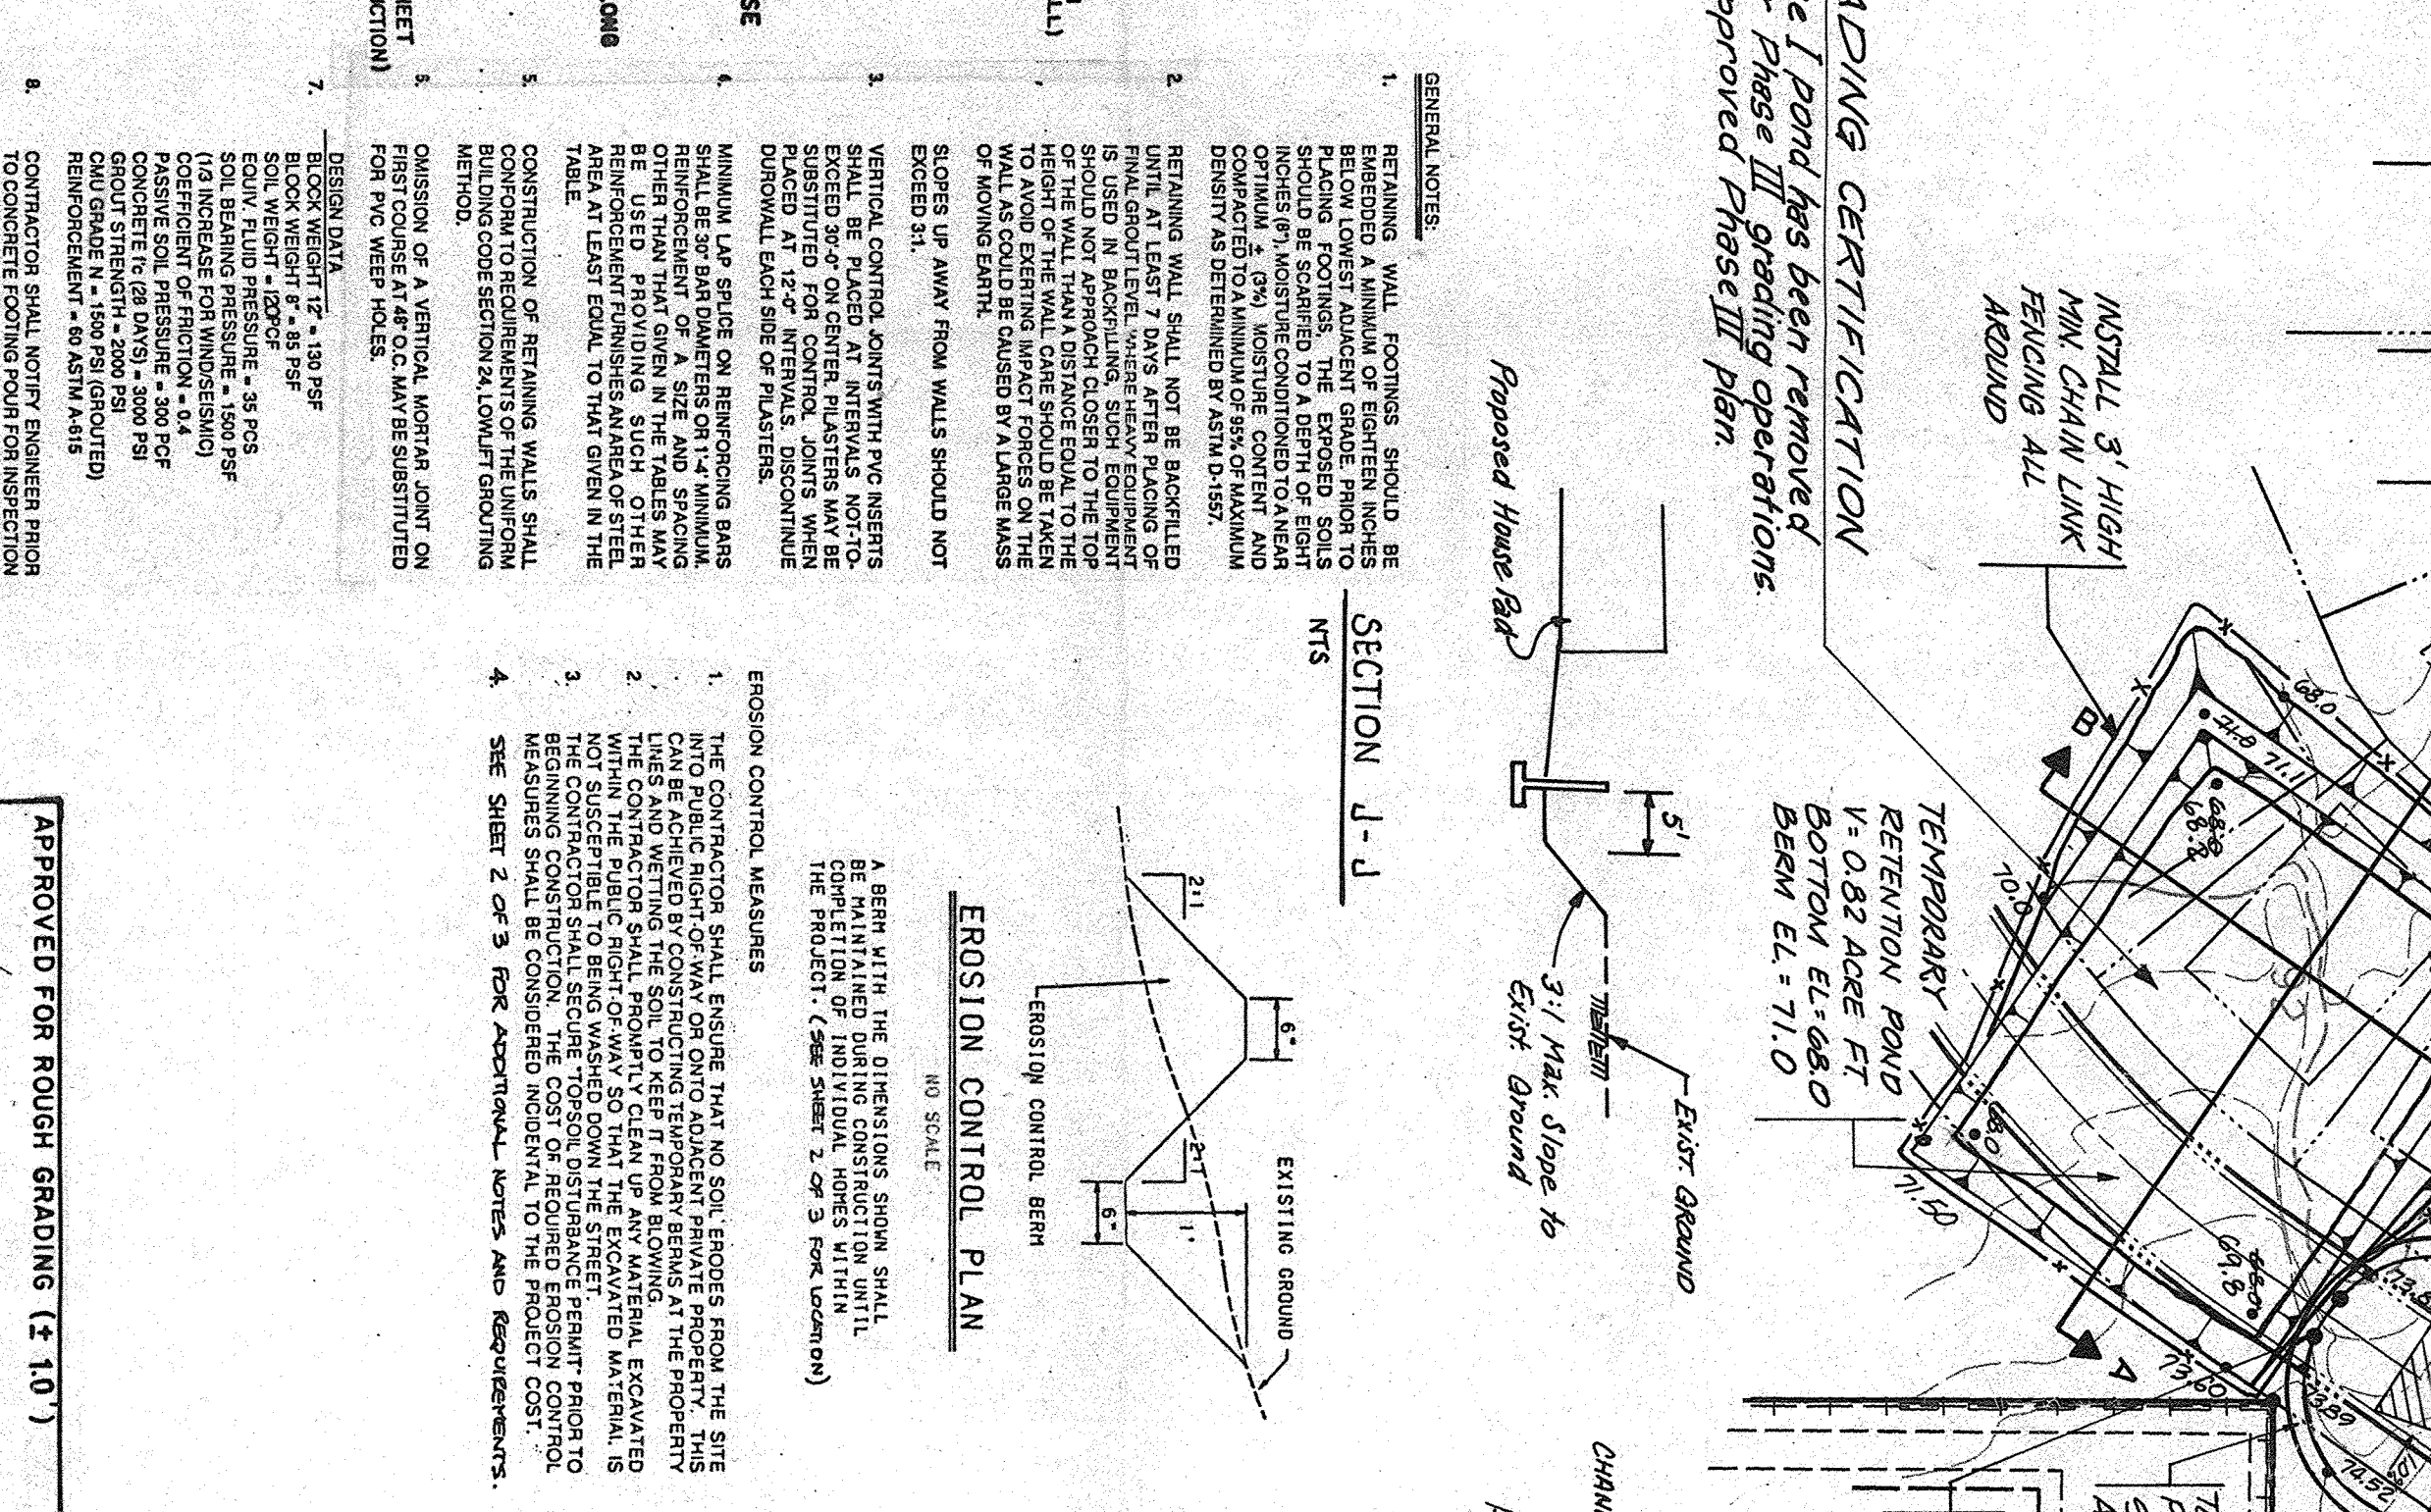
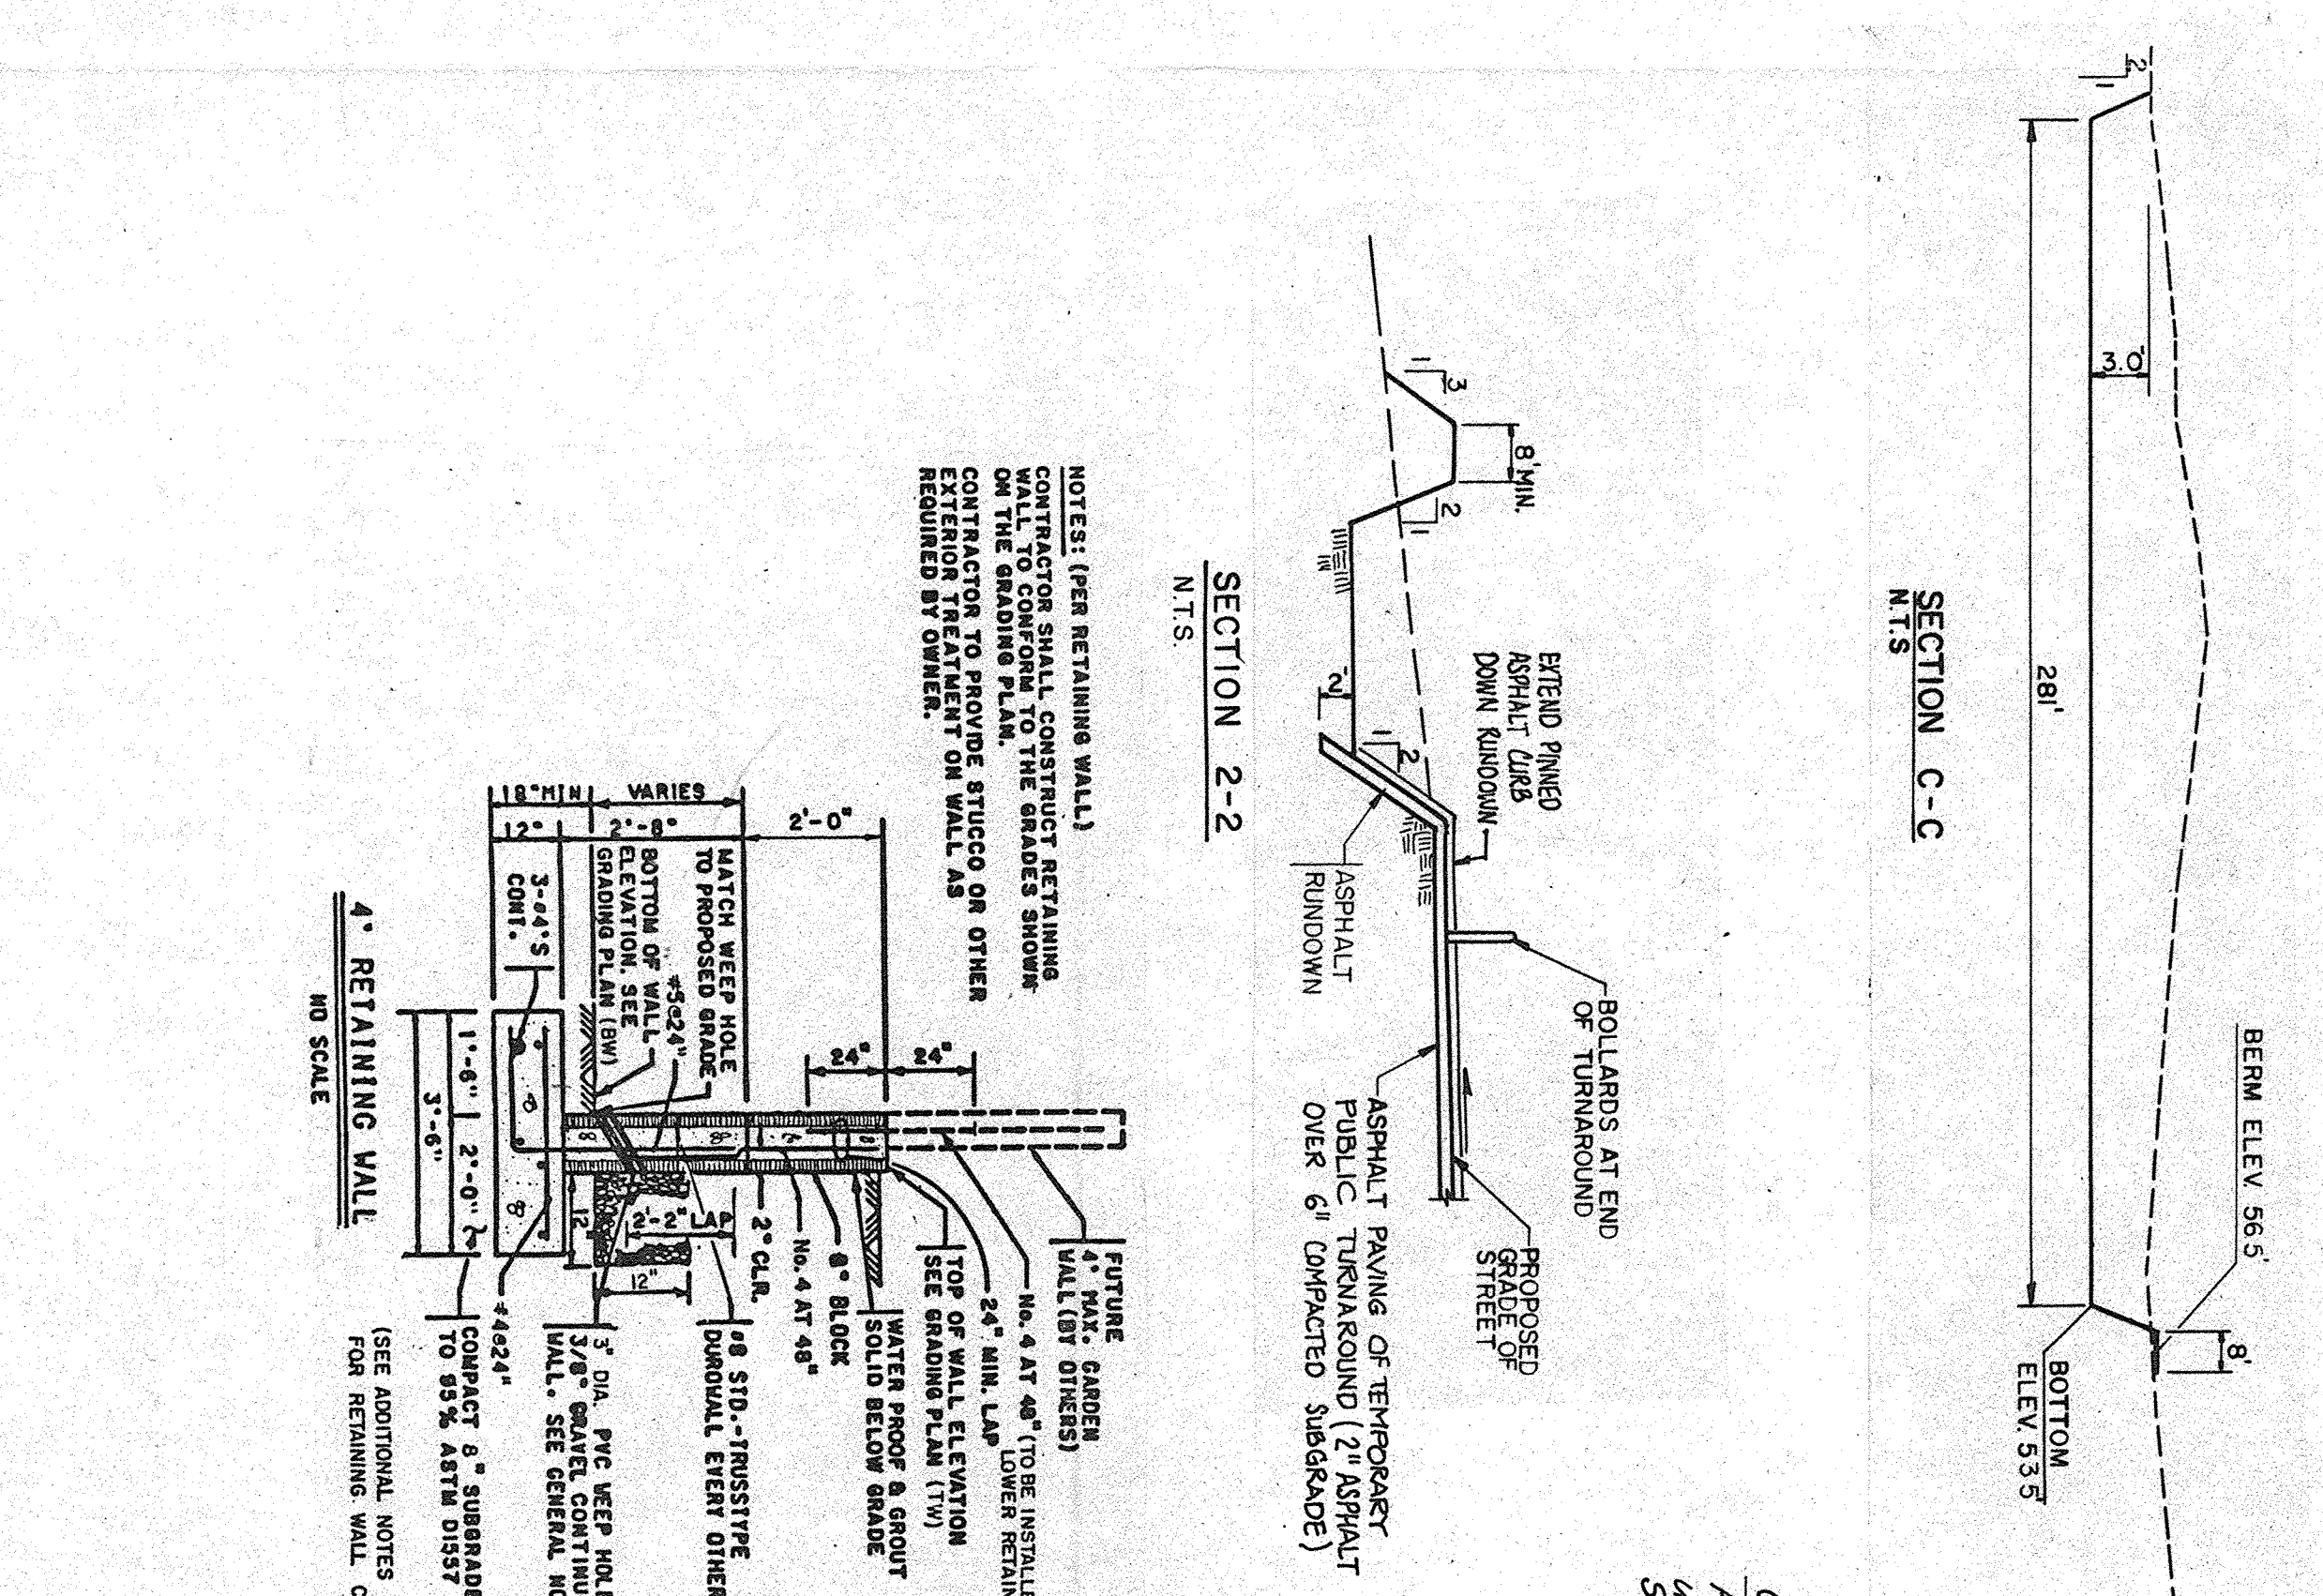
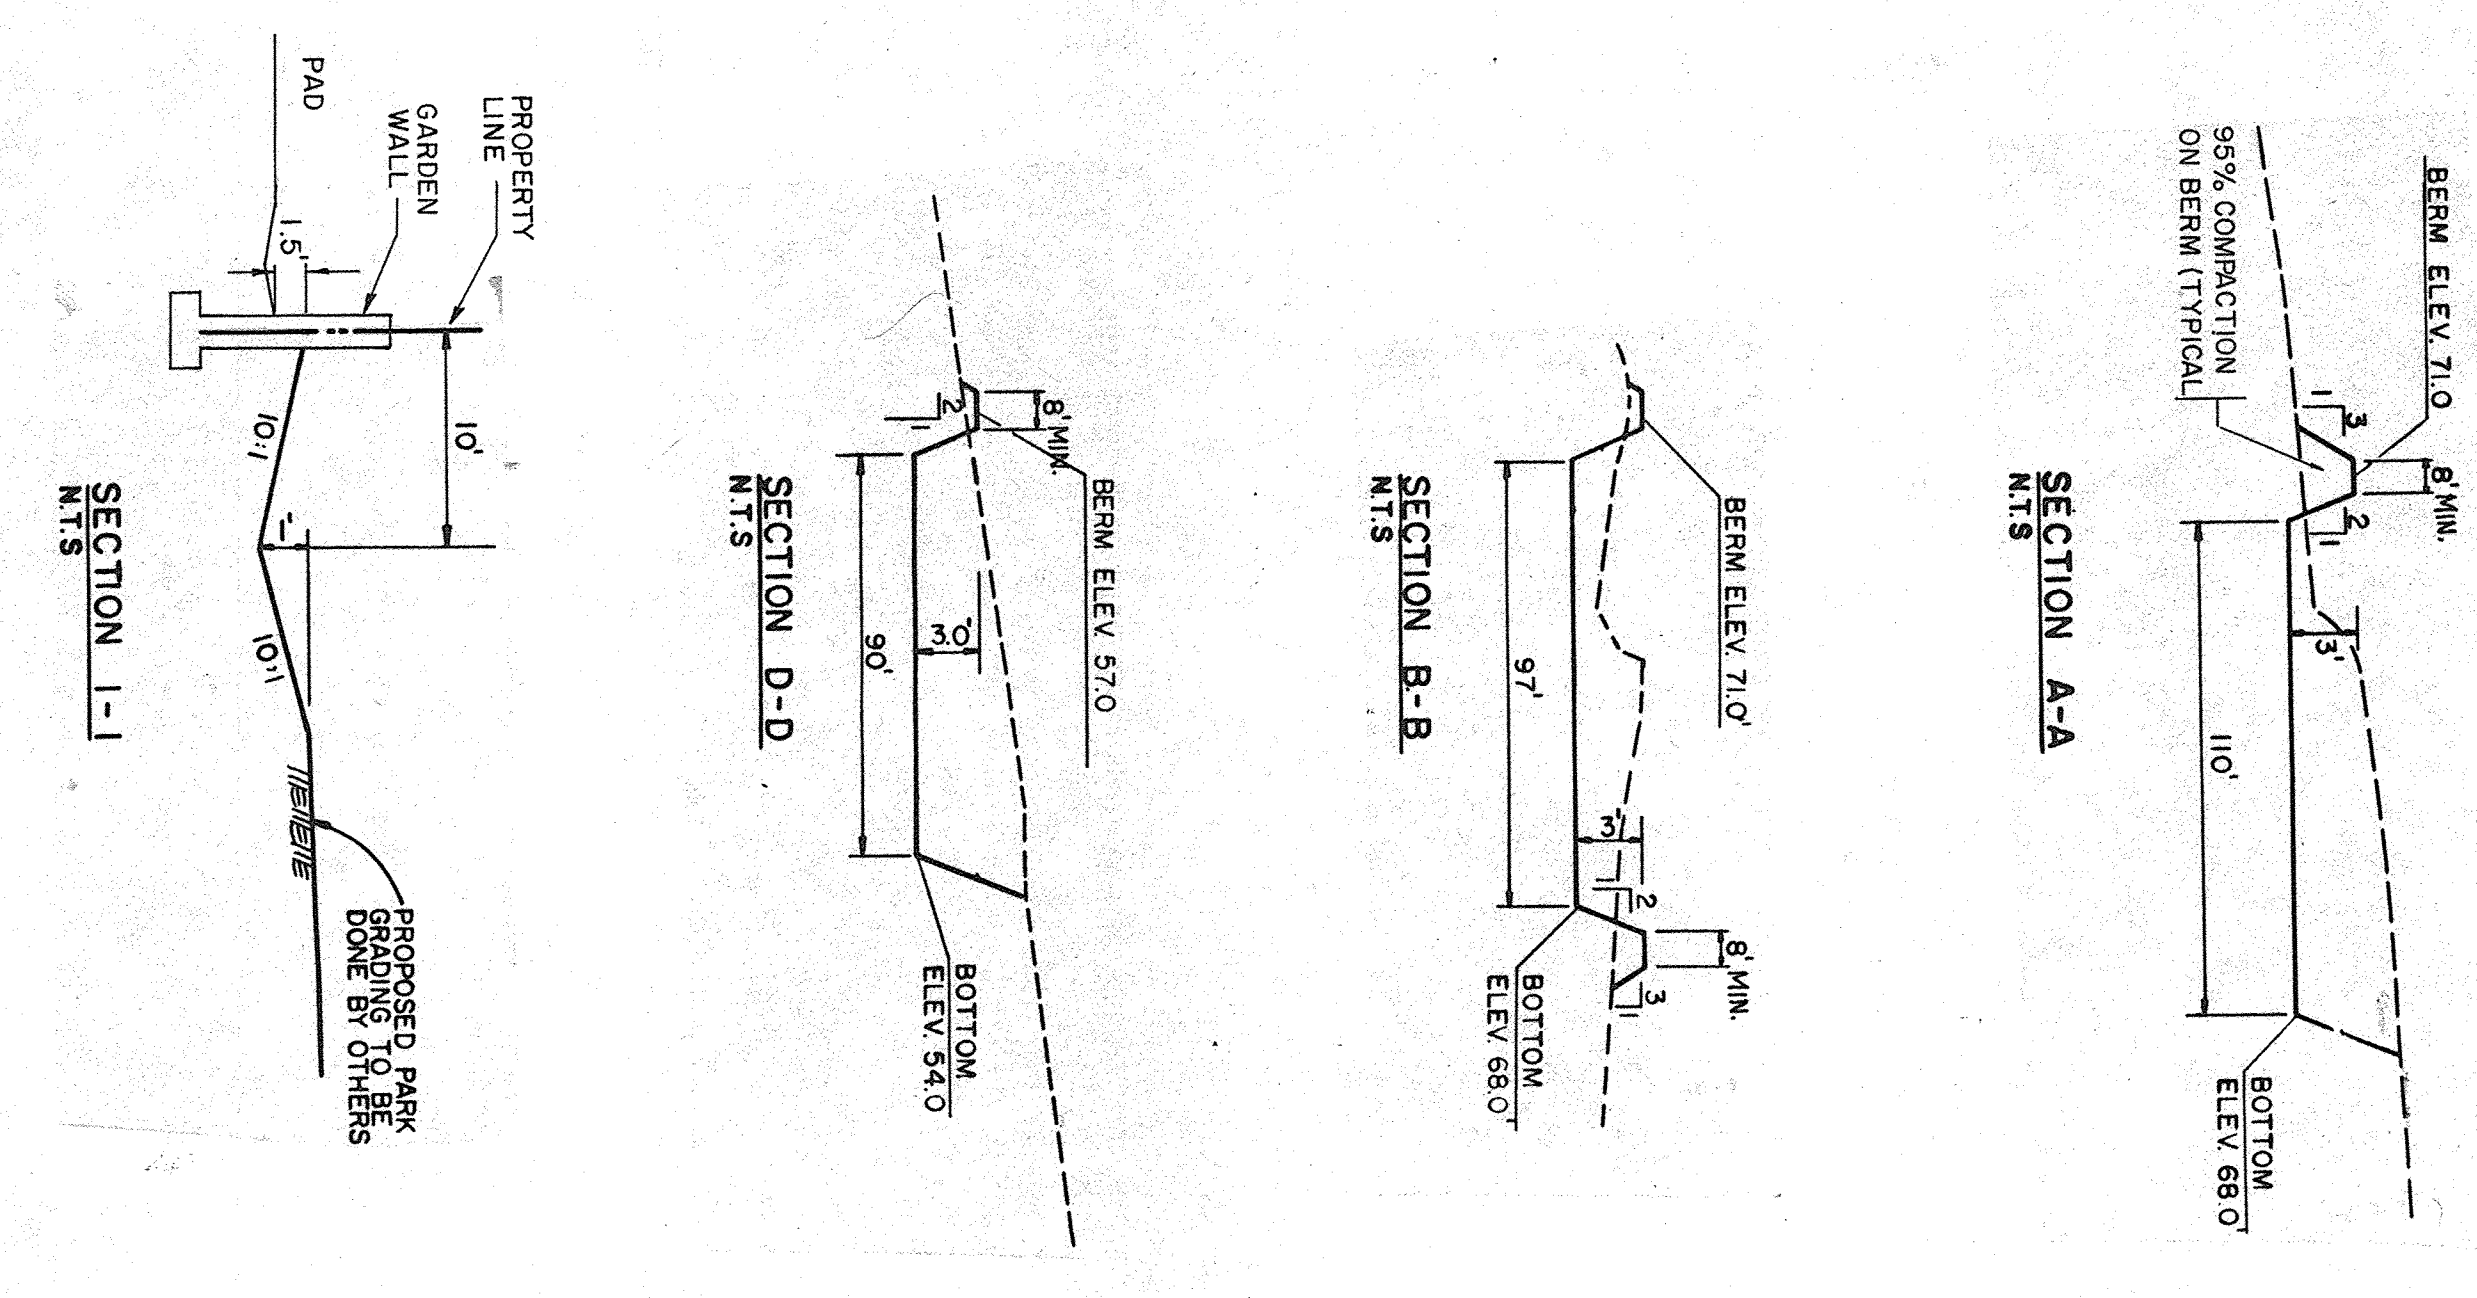


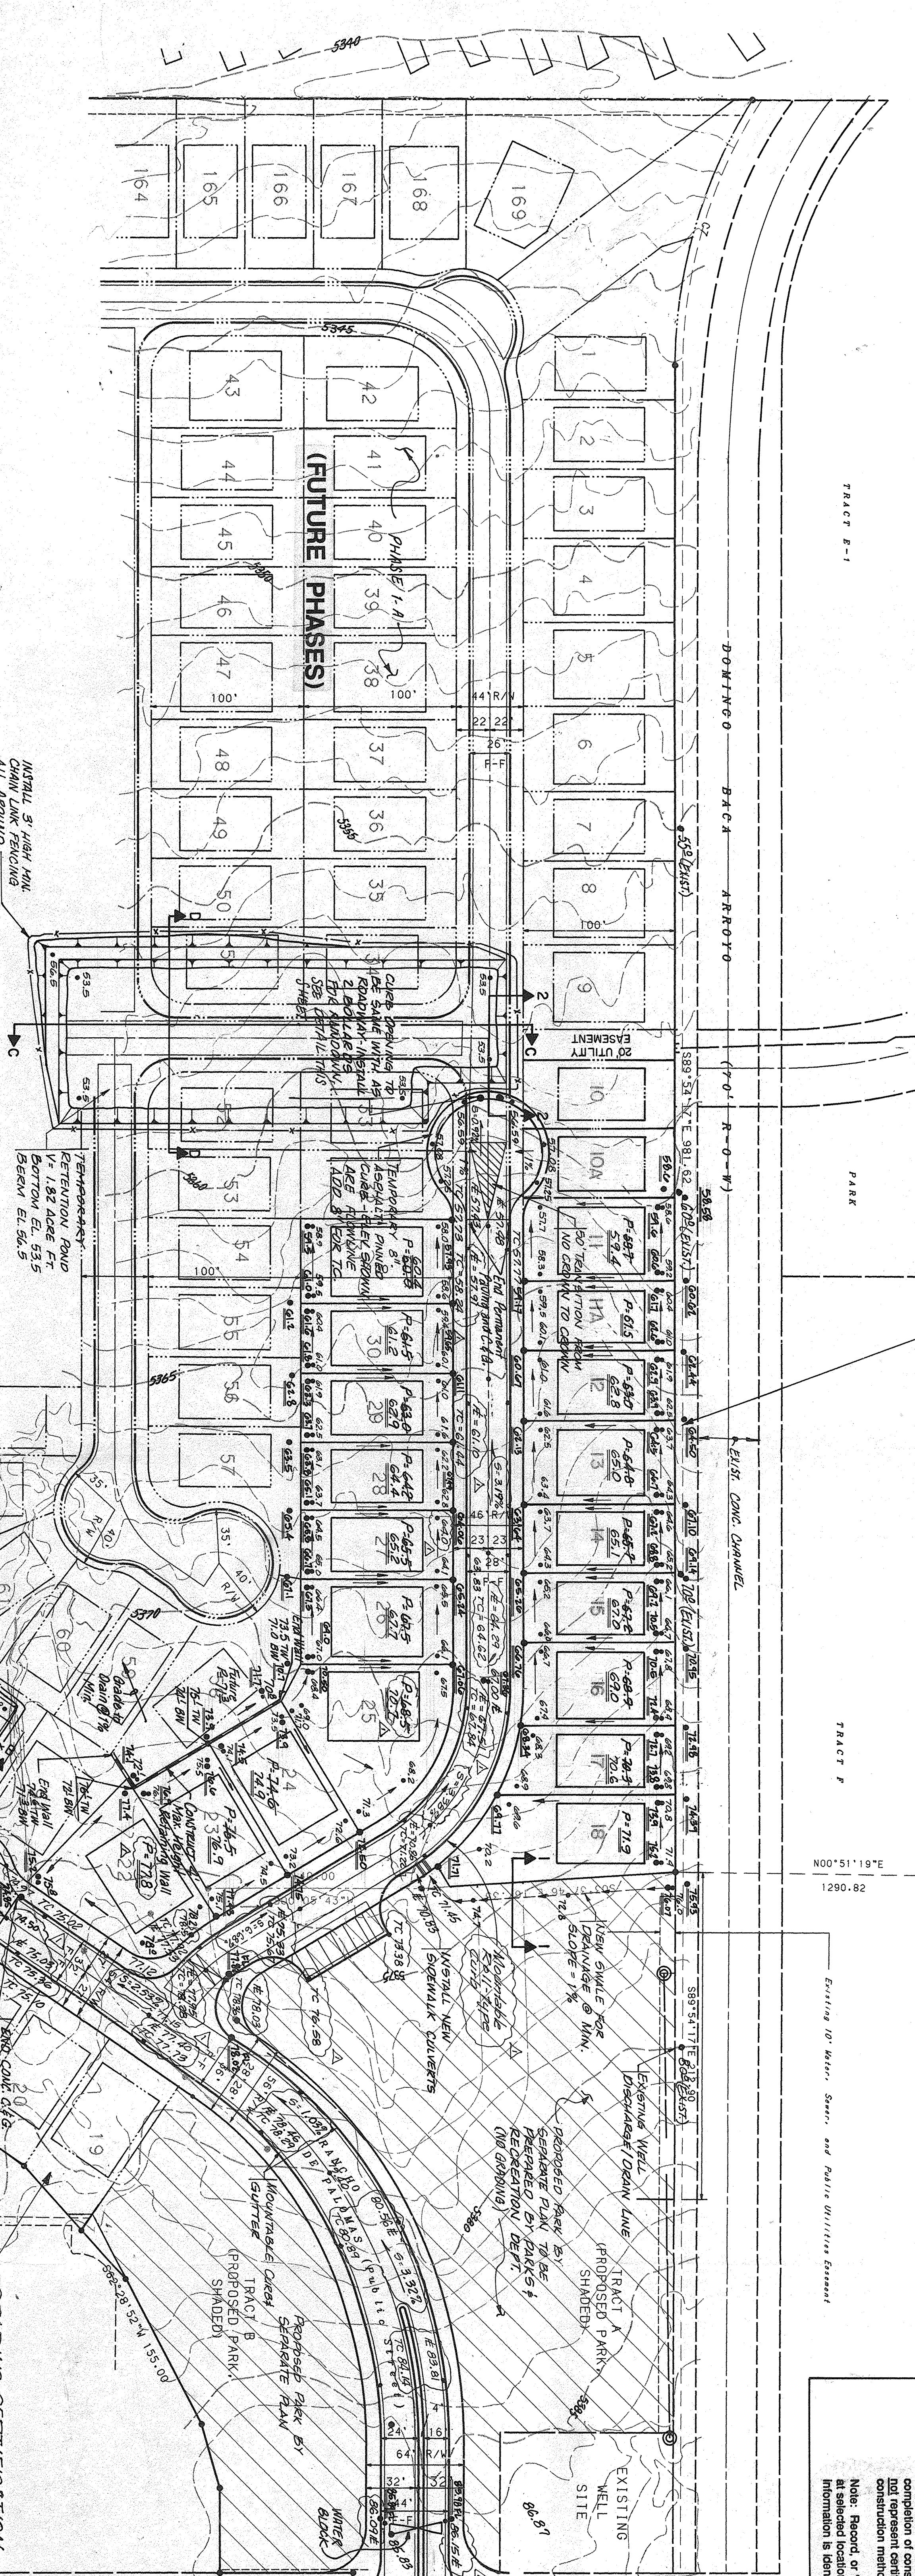



CONTRACTOR TO PROVIDE STUCCO OR OTHER
EXTERIOR TREATMENT ON WALL AS
REQUIRED BY OWNER.

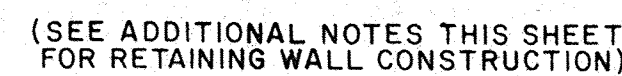

NO SCALE

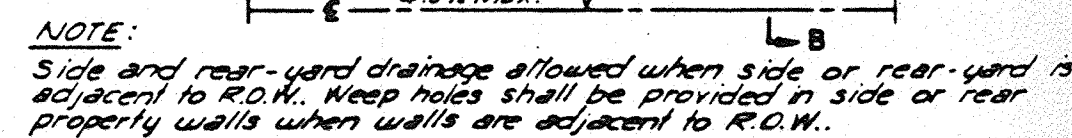

NO SCALE

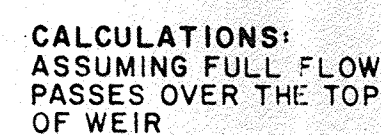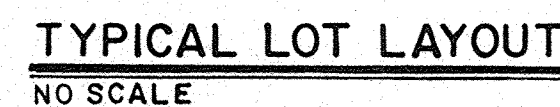

H < 14" OK

NO SCALE



NO SCALE




NTS



NTS



NO SCALE

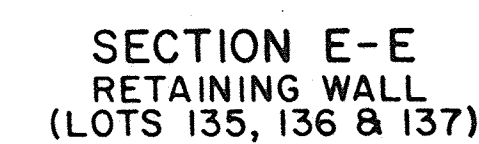

SCALE: $3/8" = 1' - 0'$



SCALE: $3/8" = 1'-0"$



10. PLACEMENT OF THE REINFORCING SHALL BE THE RESPONSIBILITY OF THE CONTRACTOR. IMPROPER PLACEMENT OF FOOTINGS OR REINFORCEMENT SHALL BE CORRECTED AT NO COST TO THE OWNER.

A circular professional engineer seal for James R. Topmiller, a Registered Professional Engineer in New Mexico. The seal features the text "JAMES R. TOPMILLER" around the top inner edge, "NEW MEXICO" around the bottom inner edge, and "REGISTERED PROFESSIONAL ENGINEER" around the outer edge. In the center, the number "9354" is displayed.




CITY OF ALBUQUERQUE
PUBLIC WORKS DEPARTMENT
ENGINEERING GROUP



PALOMAS PARK - PHASE IV
DETAIL SHEET

APPROVALS	ENGINEER	DATE	APPROVALS	ENGINEER	DATE
DRC CHAIRMAN			WATER		
TRANSPORTATION			WASTE WATER		
HYDROLOGY					
DRAWING NO.		MAP NO. D-19	SHEET 11 OF 11		

FILED: DECEMBER 15, 1993 (93-187)

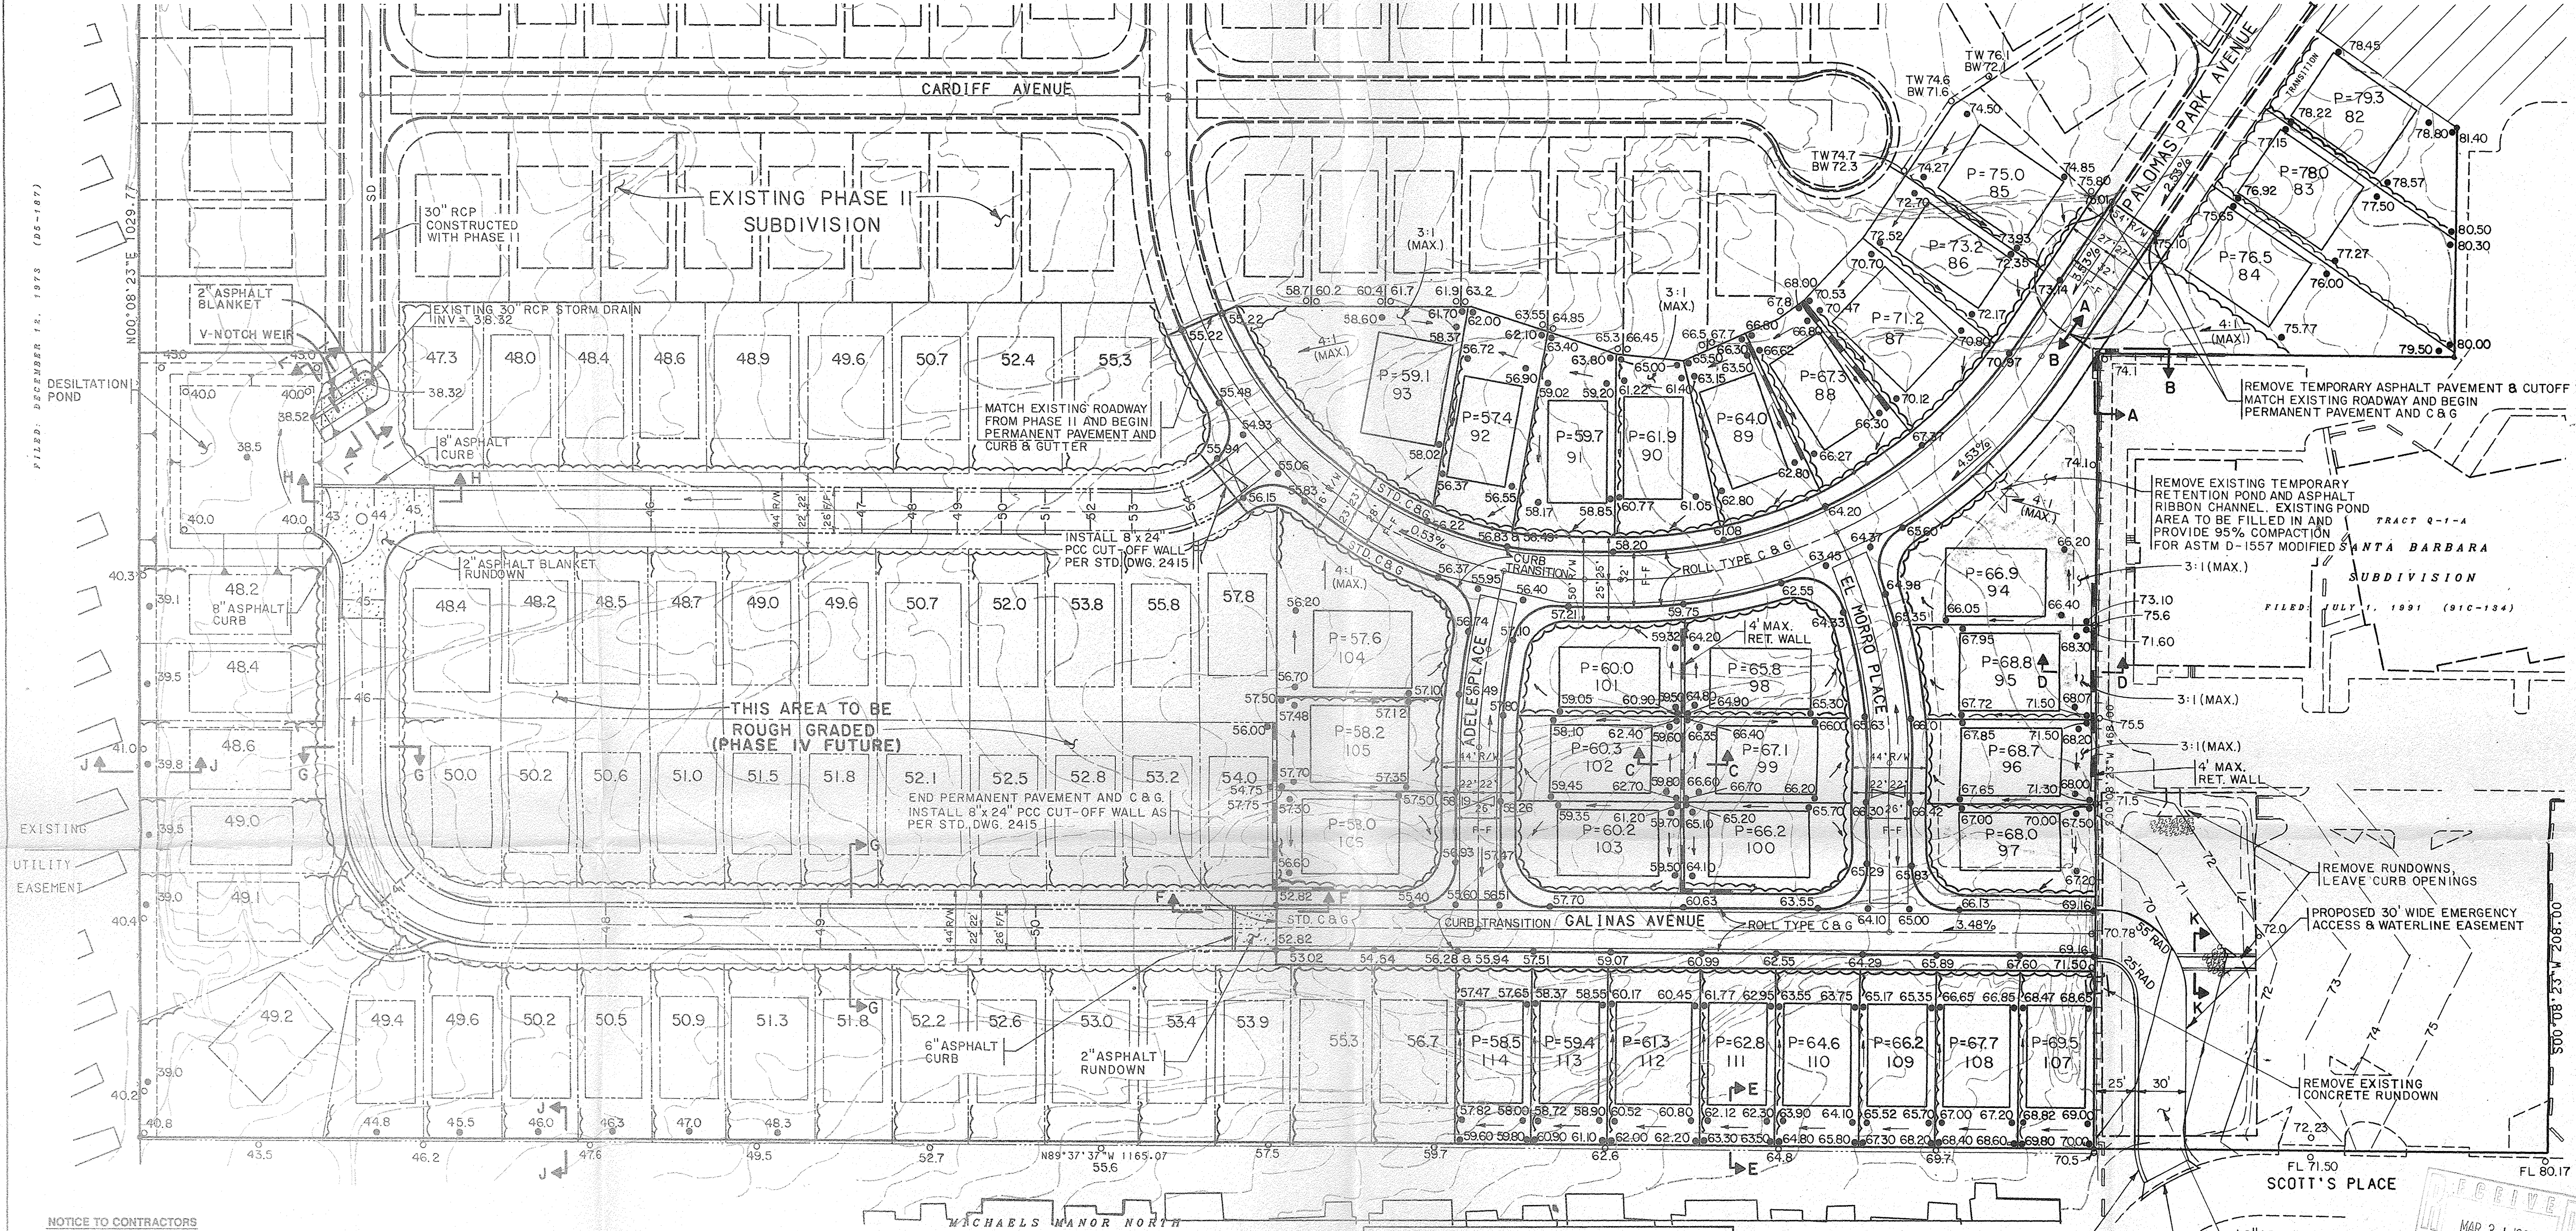

NOTICE TO CONTRACTORS

- AN EXCAVATION/CONSTRUCTION PERMIT WILL BE REQUIRED BEFORE BEGINNING ANY WORK WITHIN THE CITY RIGHT-OF-WAY. AN APPROVED COPY OF THESE PLANS MUST BE SUBMITTED AT THE TIME OF APPLICATIONS FOR THIS PERMIT.
- ALL WORK DETAILED ON THESE PLANS TO BE PERFORMED, EXCEPT AS OTHERWISE STATED OR PROVIDED HEREON, SHALL BE CONSTRUCTED IN ACCORDANCE WITH CITY OF ALBUQUERQUE STANDARD SPECIFICATIONS FOR PUBLIC WORKS CONSTRUCTION, 1986.
- TWO WORKING DAYS PRIOR TO ANY EXCAVATION, CONTRACTOR MUST CONTACT LINE LOCATION SERVICE, 765-1234, FOR LOCATION OF EXISTING UTILITIES.
- PRIOR TO CONSTRUCTION, THE CONTRACTOR SHALL EXCAVATE AND VERIFY THE HORIZONTAL AND VERTICAL LOCATIONS OF ALL OBSTRUCTIONS. SHOULD A CONFLICT EXIST, THE CONTRACTOR SHALL NOTIFY THE ENGINEER SO THAT THE CONFLICT CAN BE RESOLVED WITH A MINIMUM AMOUNT OF DELAY.
- BACKFILL COMPACTION SHALL BE TO RESIDENTIAL STREET USE.
- MAINTENANCE OF THESE FACILITIES SHALL BE THE RESPONSIBILITY OF THE OWNER OF THE PROPERTY SERVED.
- CONTRACTOR MUST OBTAIN A TOPSOIL DISTURBANCE PERMIT FROM THE ENVIRONMENTAL HEALTH DIVISION PRIOR TO CONSTRUCTION.
- THE CONTRACTOR IS TO REFER TO EARTHWORK SPECIFICATIONS AS NOTED IN THE SOILS REPORT PREPARED BY VINYARD AND ASSOCIATES DATED SEPTEMBER 28, 1992.
- THE CONTRACTOR SHALL CONFORM TO ALL CITY, COUNTY, STATE, AND FEDERAL DUST CONTROL MEASURES AND REQUIREMENTS AND WILL BE RESPONSIBLE FOR PREPARING AND OBTAINING ALL NECESSARY APPLICATIONS AND APPROVALS.
- THE CONTRACTOR SHALL ENSURE THAT NO SOIL ERODES FROM THE LOTS INTO PUBLIC RIGHT-OF-WAY. THIS CAN BE ACHIEVED BY CONSTRUCTING TEMPORARY BERMS AS PER DETAIL THIS SHEET AND WETTING THE SOIL TO KEEP IT FROM BLOWING.
- ALL SLOPES MAXIMUM OF 4:1 UNLESS AS OTHERWISE INDICATED.
- ALL SPOT ELEVATIONS ALONG THE PROPOSED STREETS ARE TO TOP OF STANDARD OR MOUNTABLE ROLL TYPE CURB AND GUTTER (AS LABELED) UNLESS OTHERWISE NOTED.

DRAINAGE PLAN

This Phase III drainage plan conforms to the overall drainage plan of the entire site (see Palomas Park Subdivision Drainage Report on June 1992, #D19-D1B).

The east end temporary retention pond constructed for Phase II, and the pond located in the proposed emergency access and waterline easement on the Church property, will be eliminated and regraded. Runoff from the Church property and from the southern portion of this phase will be directed down Galinas Avenue to the west. Peak flow at the downstream end of Galinas Avenue at the Phase III boundary was calculated to be 36.2 cfs (see Drainage Calculations).

A temporary swale will be constructed to carry runoff through the proposed "rough graded" area of the site. The swale is designed to carry peak flow at under 3 fps (non-erosive per DPM, see Drainage Calculations) and approximates the future grade and alignment of Galinas Avenue.

The west end temporary retention pond constructed as part of Phase II will be partially regraded. The remaining portion will serve as a temporary desiltation pond for runoff from this phase. From the desiltation pond, runoff will be diverted to an existing 30 inch RCP storm drain via a 40 foot long channel. All of these temporary improvements will be removed with Phase IV of Palomas Park Subdivision.

A drainage covenant is prepared for the swale and the desiltation pond of Phase III. Public easements are placed over the desiltation pond and swale.

APPROVED FOR ROUGH GRADING (± 1")
[Signature]
HYDROLOGY ENGINEER
4-21-93
DATE

NOTE: ALL CURB AND GUTTER ELEVATIONS SHOWN ARE TOP OF CURB ELEVATIONS.

DRAINAGE CALCULATIONS

SWALE (continuation of Galinas Ave.):

Total area of each treatment (developed portion of Basin H - see overall grading plan)

Treatment B = 0.487 AC
Treatment C = 0.490 AC
Treatment D = 1.322 AC

Discharge from 100-year, 6-hour storm, Zone 3.

From developed portion of Basin H

$Q_{100} = (0.487 \times 2.60) + (0.490 \times 3.45) + (1.322 \times 5.02) = 9.59 \text{ cfs}$

From church property (revised drainage plan for addition to Church of the Risen Savior)


$Q_{100} = 26.6 \text{ cfs}$

Total discharge down swale

$Q_{100} \text{ Total} = 9.59 + 26.6 = 36.2 \text{ cfs}$



Through a trial and error analysis, assuming a discharge of 36.2, the maximum depth in the Galinas Avenue swale is found to be 0.7 ft (S=0.5%). The maximum velocity at peak flow is as follows:

$V_{max} = 1.49/\text{ft} \times R^{2/3} \times S^{1/2} = 1.49/0.3 \times (13.8\text{ft}/29.2\text{ft})^{2/3} \times (.005)^{1/2} = 2.70 \text{ ft/s}$

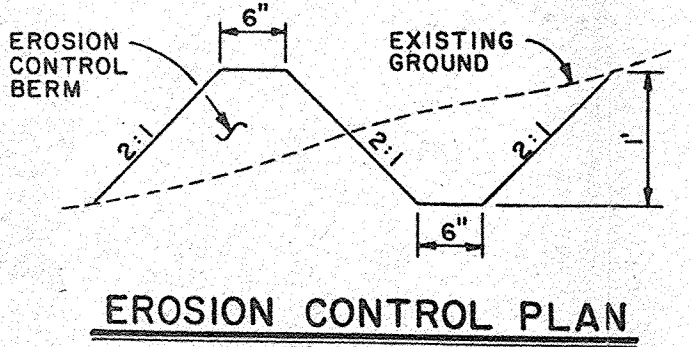


A BERM WITH THE DIMENSIONS SHOWN SHALL BE MAINTAINED DURING CONSTRUCTION UNTIL COMPLETION OF INDIVIDUAL HOMES WITHIN THE PROJECT.

- LEGEND
- EROSION CONTROL BERM
 - EXISTING GROUND ELEVATION
 - PROPOSED GROUND ELEVATION
 - DRAINAGE FLOW DIRECTION
 - RETAINING WALL
 - EXISTING CONTOUR
 - WATER BLOCK (HIGH POINT)
 - PROPOSED CONTOUR

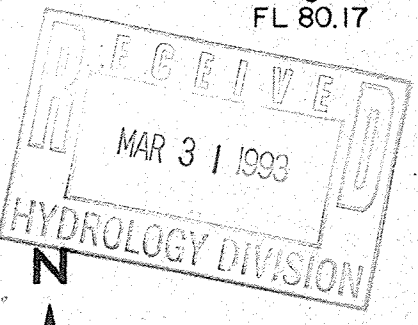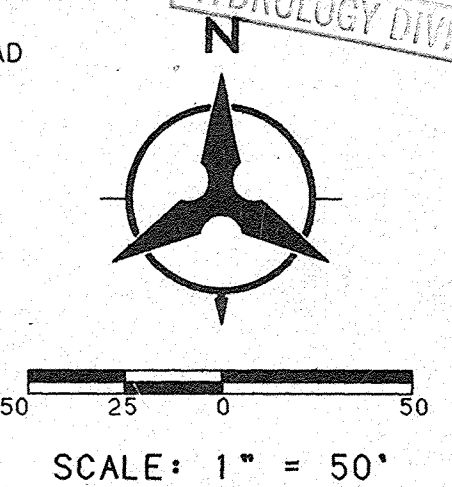


CITY OF ALBUQUERQUE PUBLIC WORKS DEPARTMENT ENGINEERING GROUP					
PALOMAS PARK- PHASE III FINAL GRADING AND DRAINAGE PLAN					
APPROVALS	ENGINEER	DATE	APPROVALS	ENGINEER	DATE
DRG CHAIRMAN			WATER		
TRANSPORTATION			WASTE WATER		
HYDROLOGY					
DRAWING NO.	MAP NO. D-19		SHEET		OF

FIELD NOTES		DATE	NO.
STATION IS A STANDARD USGCS BRASS TABLET			
STAMPED "HEAVEN 1969" SET IN TOP OF A.			
CONCRETE POST FLUSH WITH THE GROUND. LOCATED			
WEST ON PASO DEL NORTE FROM WYOMING BLVD.			
APPROXIMATELY 800 FEET.			
ELEVATION = 5378.787			
MICRO-FILM INFORMATION			
RECORDED BY			
DATE			
NO.			

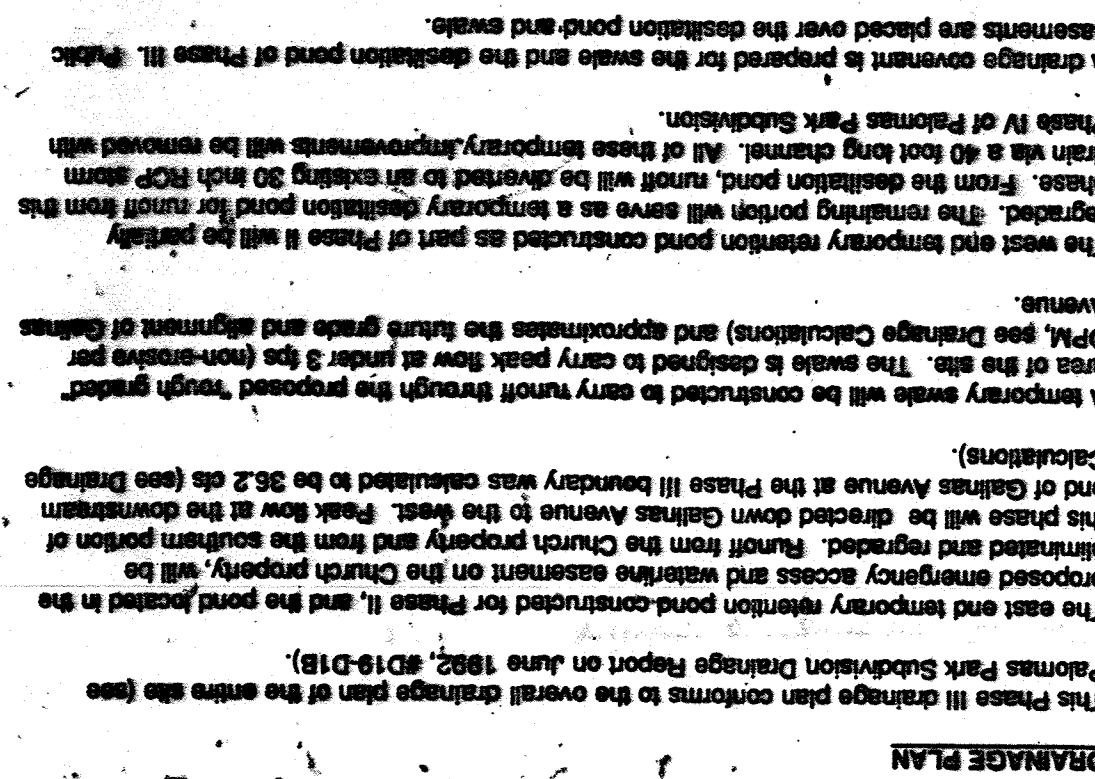

1. AN EXCAVATION/CONSTRUCTION PERMIT WILL BE REQUIRED BEFORE BEGINNING ANY WORK WITHIN OF THE CITY MIGHT-OF-WAY. AN APPROVED COPY OF THESE PLANS MUST BE SUBMITTED AT THE TIME OF APPLICATIONS FOR THIS PERMIT.
2. ALL WORK DETAILED ON THESE PLANS TO BE PERFORMED, MUST AS OTHERWISE STATED ON ACCORDANCE WITH CITY OR ALTERNATIVE, PROVIDED PERSON SHALL BE CONSTRUCTED IN STANDAR SPECIFICATIONS FOR PUBLIC WORKS CONSTRUCTION, 1986.
3. TWO WORKING DAYS PRIOR TO ANY EXCAVATION, CONTRACTOR SHALL LINE CORNER OF EXISTING UTILITIES, 785-1204, FOR LOCATION OF EXISTING UTILITIES.
4. PRIOR TO CONSTRUCTION THE CONTRACTOR SHALL EXCAVATE AND VERIFY THE HORIZONTAL AND VERTICAL LOCATIONS OF ALL OBSTRUCTIONS, SHOULD A DISTURBANCE BE ENCOUNTERED, NOTIFY THE ENGINEER SO THAT THE CONTRACTOR CAN BE RESOLVED WITH A MINIMUM AMOUNT OF DELAY.
5. BACKFILL CONSTRUCTION SHALL BE TO RESIDENTIAL STREET USE.
6. MAINTENANCE OF THESE FACILITIES SHALL BE THE RESPONSIBILITY OF THE OWNER OF THE PROPERTY SERVED.
7. CONTRACTOR MUST OBTAIN A TOPSOIL DISTURBANCE PERMIT FROM THE ENVIRONMENTAL HEALTH DIVISION PRIOR TO CONSTRUCTION.
8. THE CONTRACTOR IS TO REFER TO EARTHWORK SPECIFICATIONS AS NOTED IN THE SOILS REPORT PREPARED BY VINNARD AND ASSOCIATES DATED SEPTEMBER 28, 1992.

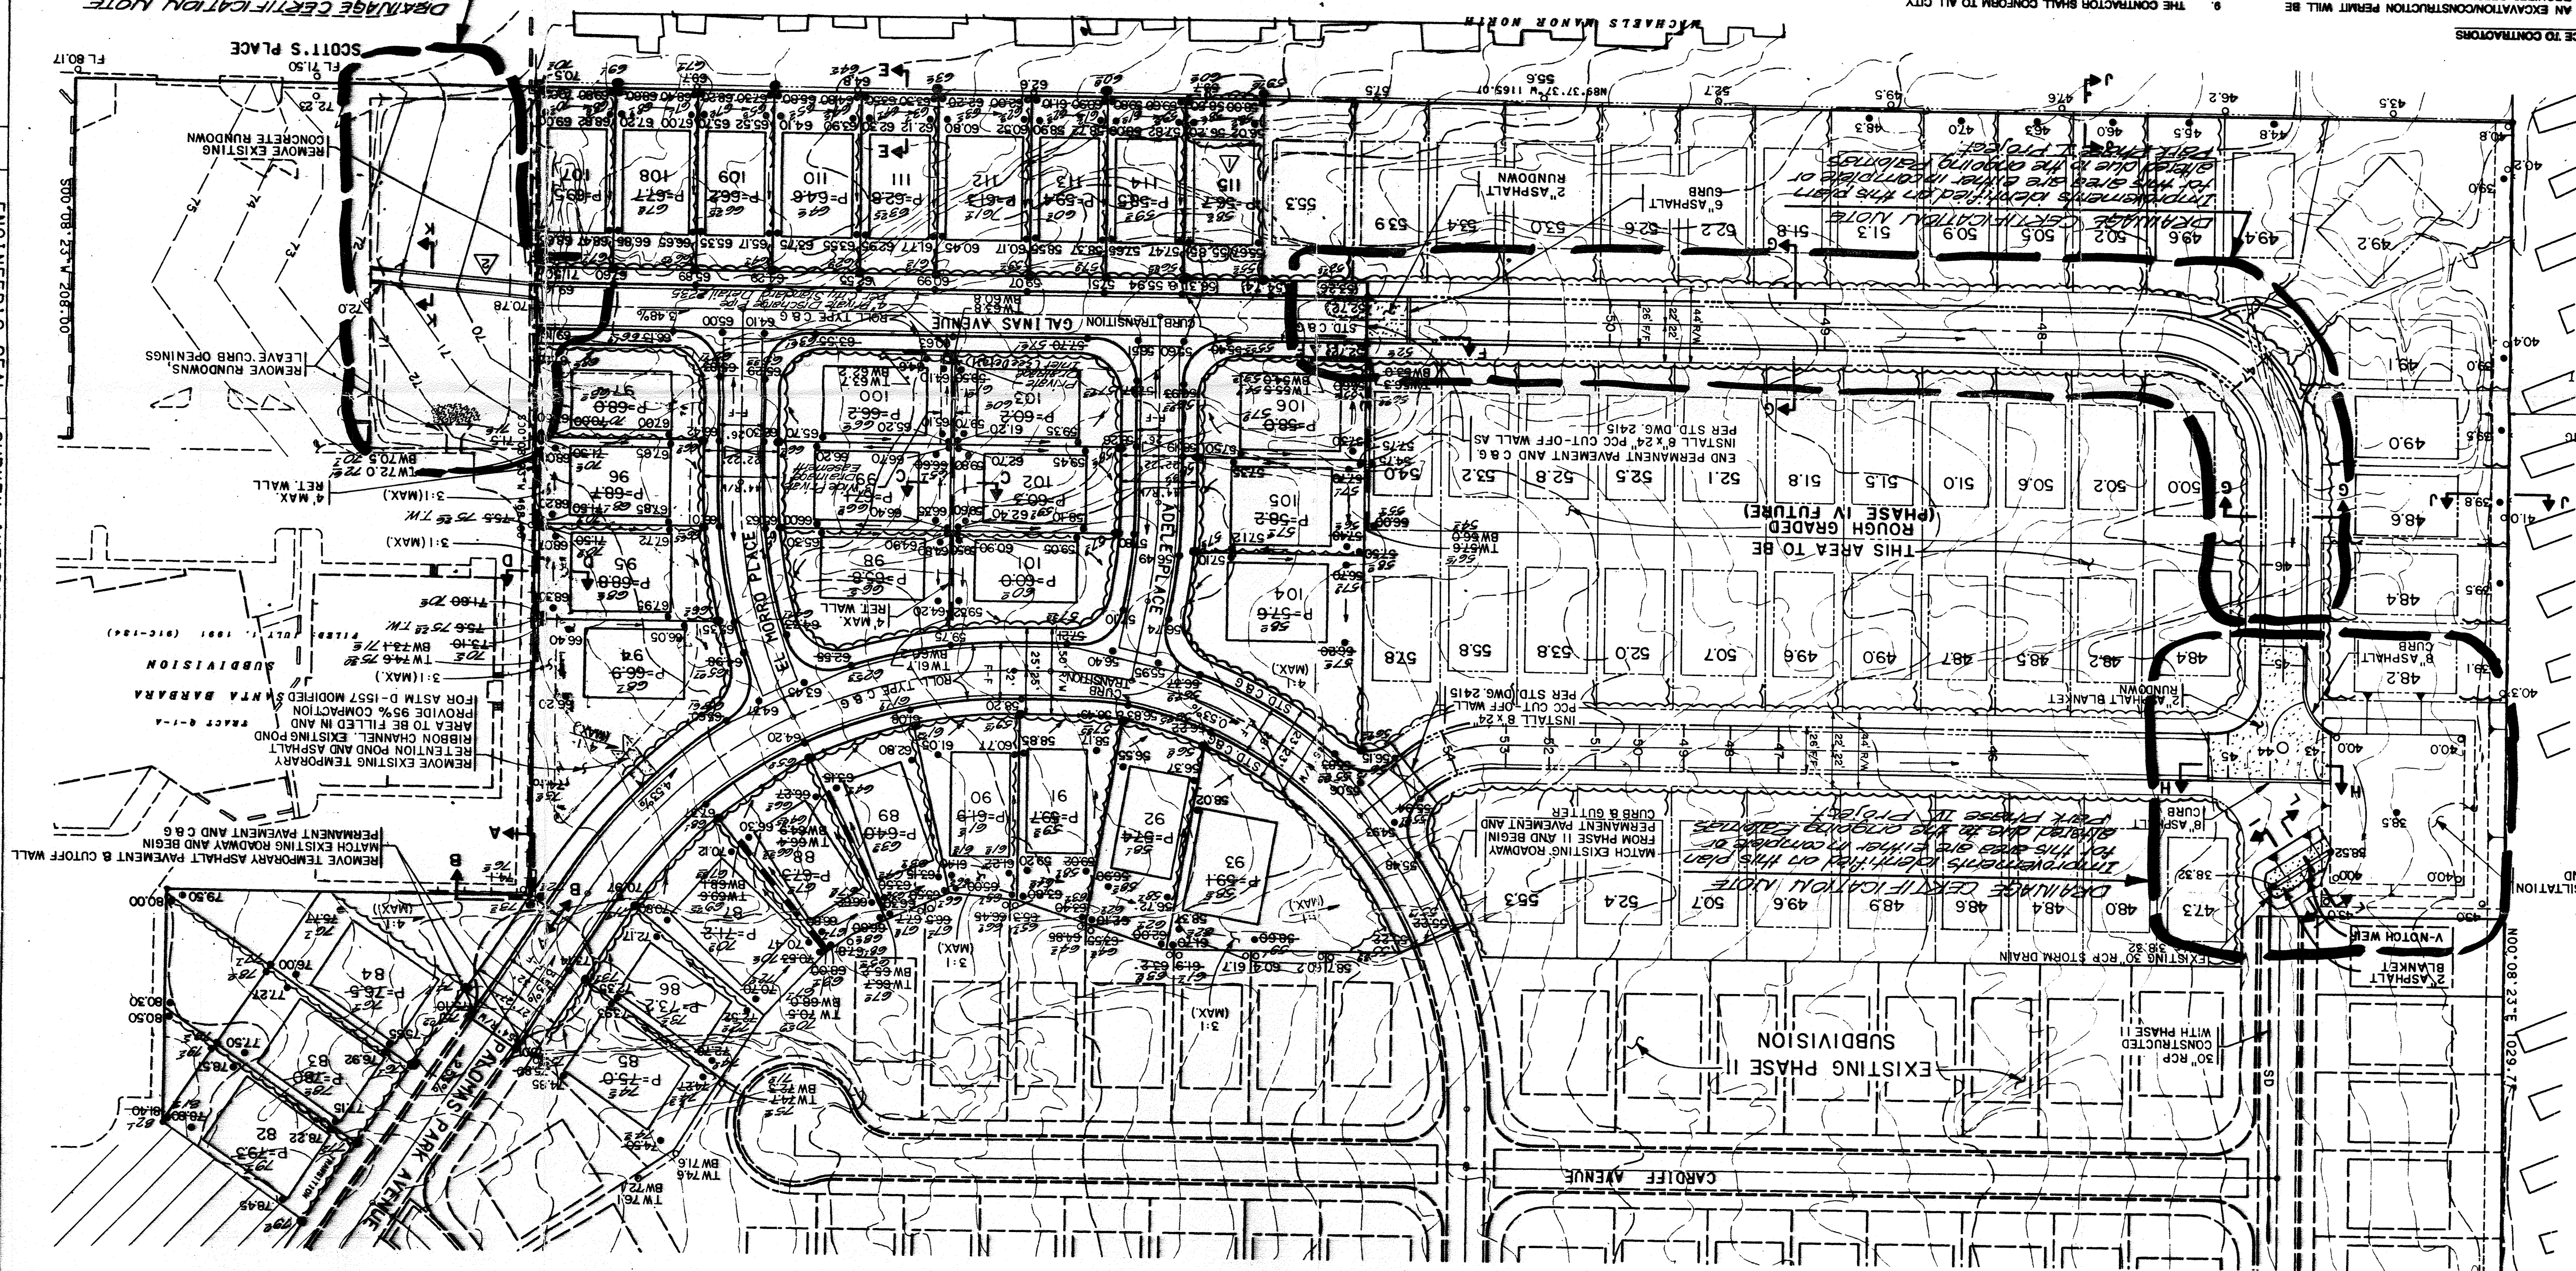


NOTE:
TRACT D
This tract is to be dedicated to the City
of Santa Barbara for use as a park.
The proposed easement will be given to
the City of Santa Barbara for use as a park.

SANTA BARBARA SUBDIVISION

Off-phase site for access. All from
Phase and 11.711 shall be placed
of 3'. The easement shall be given to
the City of Santa Barbara for use as a park.

"NEVEN 1969"
USC & GS Brass Cap
N. 11.711 State Plane Coordinates (Central Zone)
Ground-to-Grid Factor = 0.9995263
Elev. = 5378.787

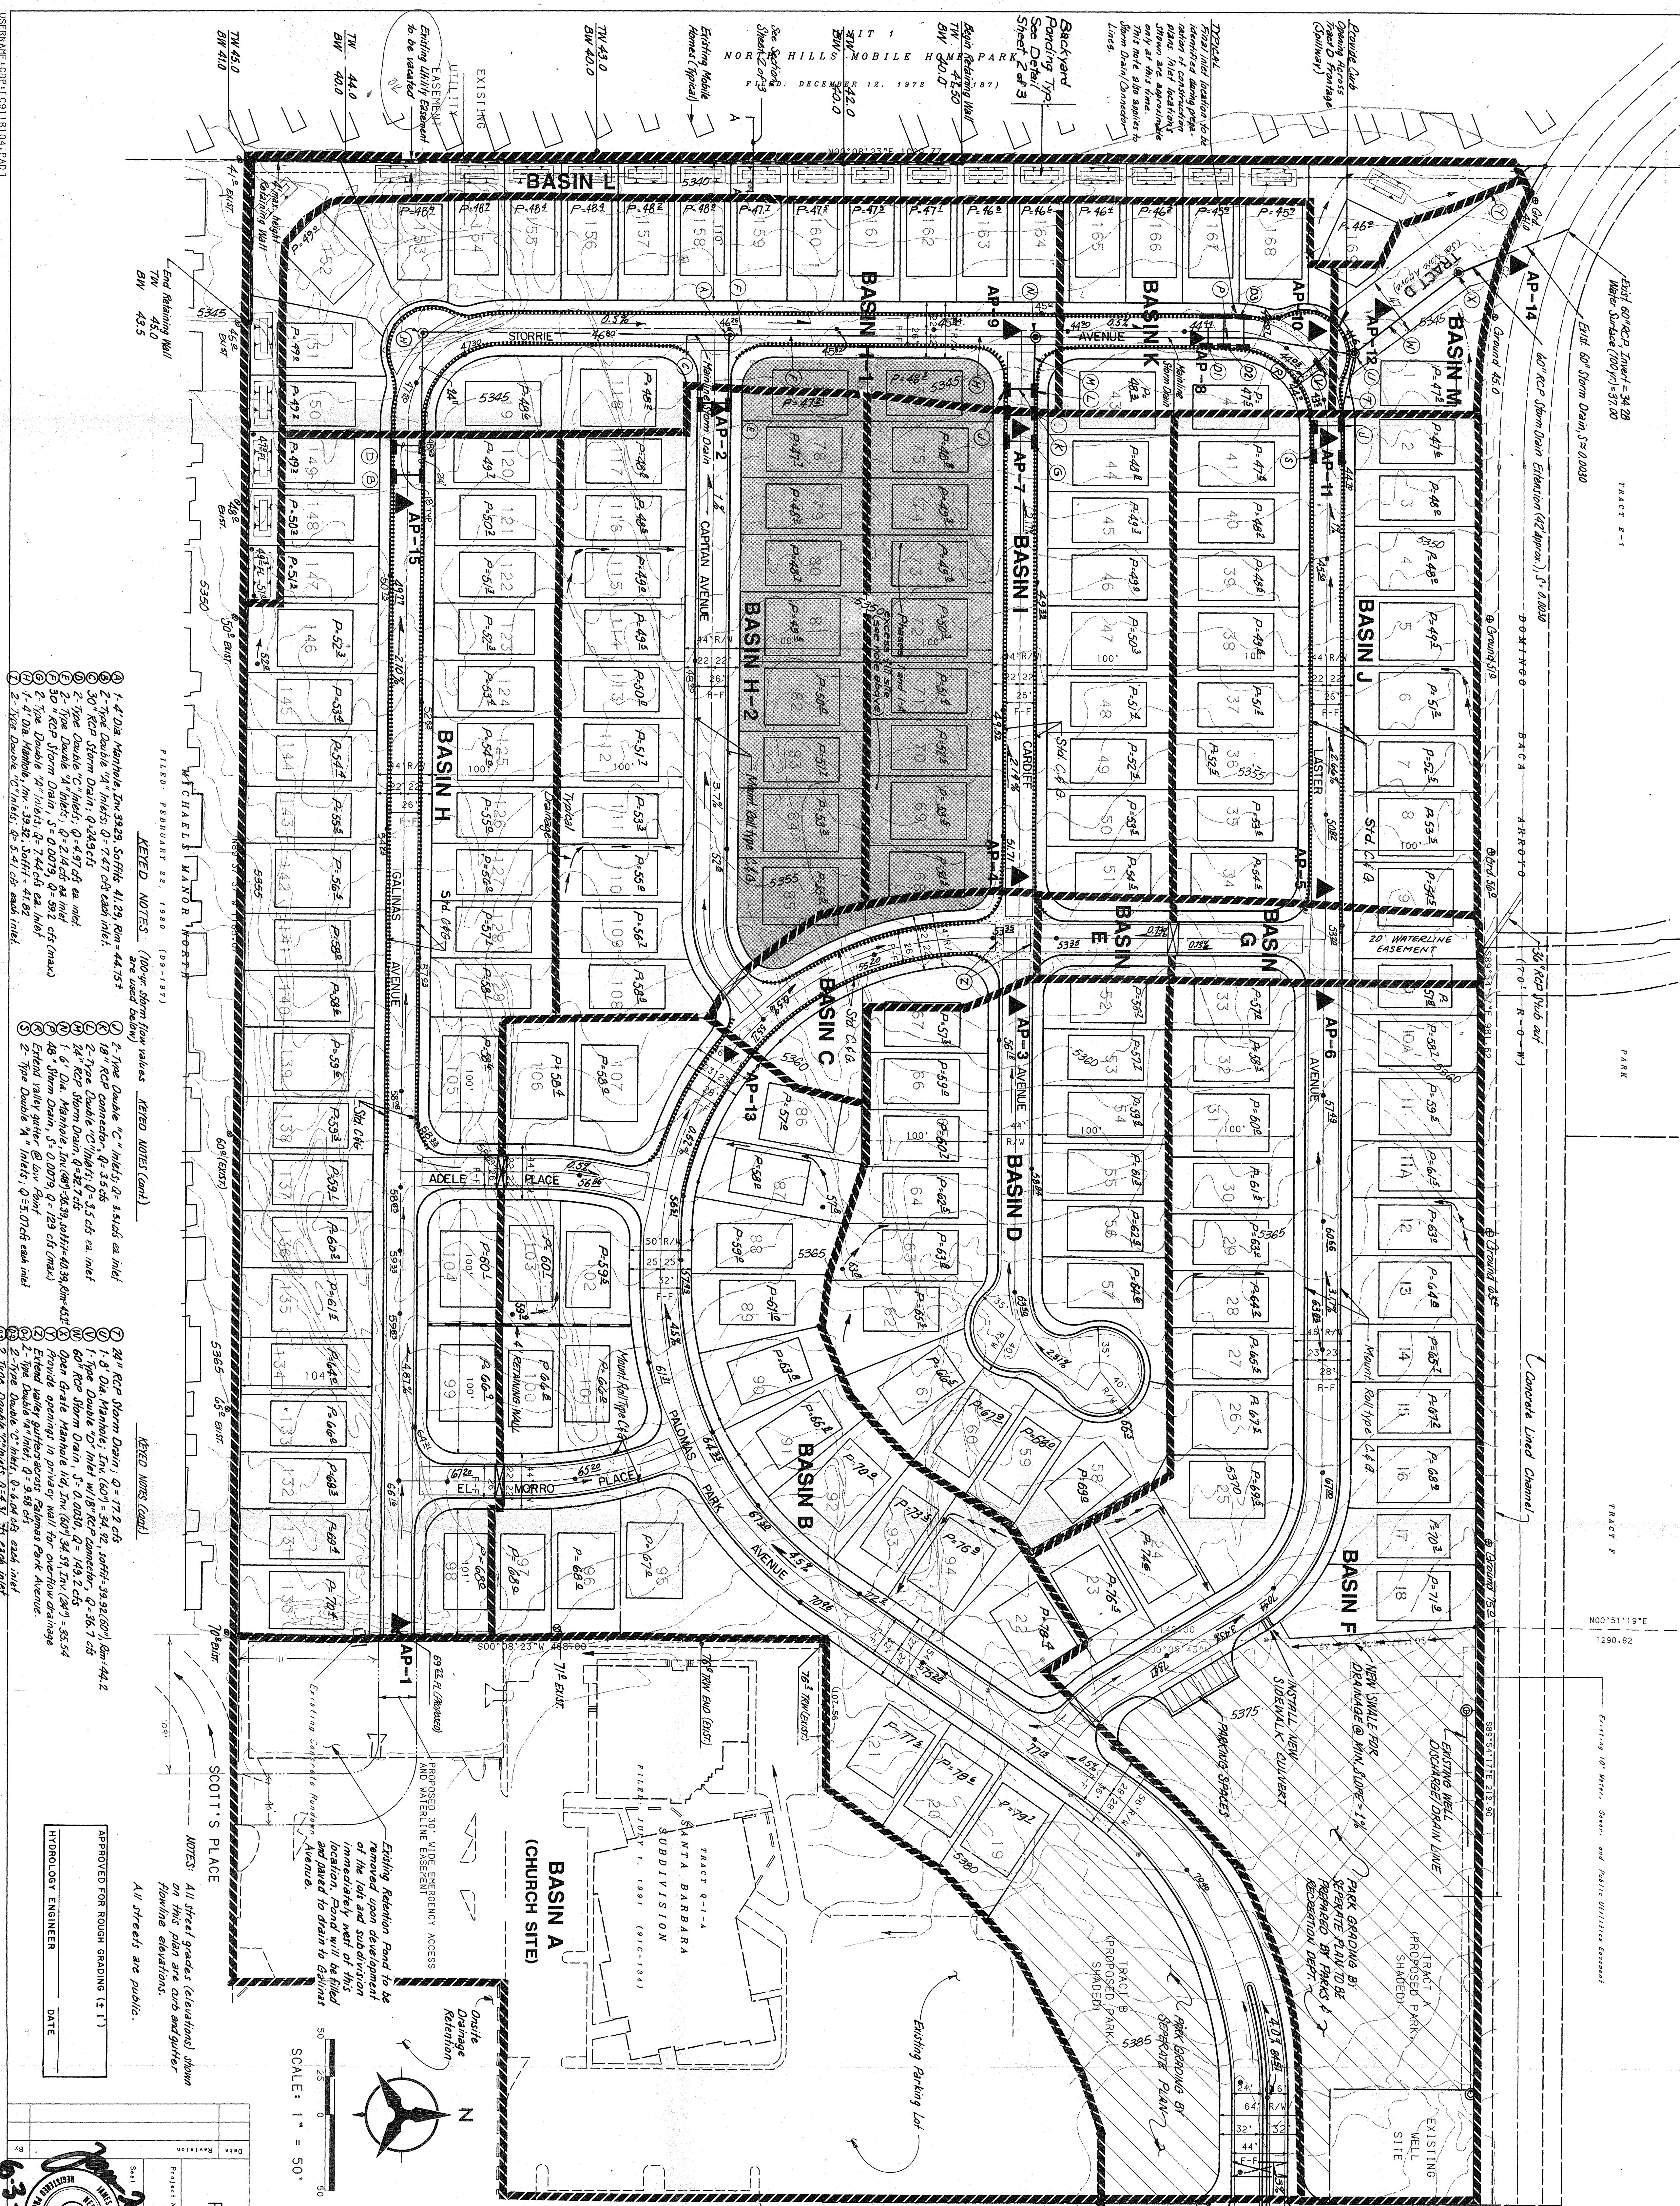

- KEYED NOTES (100'-0\"/>
1. 4\"/>
 2. 2\"/>
 3. 2\"/>
APPROVED FOR ROUGH GRADING (1\"/>

HYDROLOGIST ENGINEER

DATE

PALOMAS PARK SUBDIVISION
DRAINAGE/PRELIMINARY GRADING PLAN
(DEVELOPED CONDITIONS)


ULTIMATE DEVELOPMENT
(ALL PHASES)

Sheet 1 of 3

DATE: 5/92

Scale: 1\"/>

BOHANNAN INC.

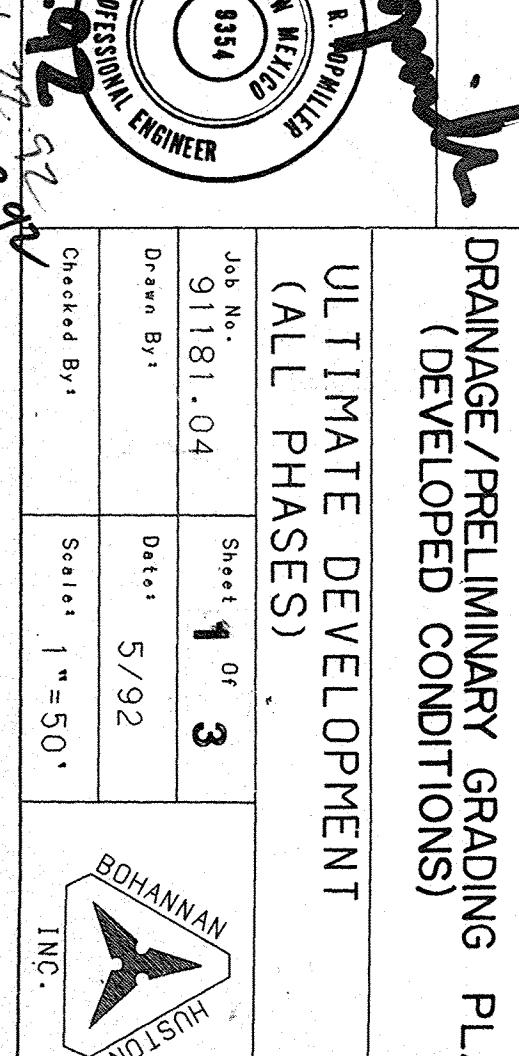

LEGEND

EXISTING CONTOUR

PROPOSED SPOT ELEVATION

PAD ELEVATION

DIRECTION OF FLOW OR SCALE

PROPOSED EROSION CONTROL BERM


PROPOSED WATER BLOCK

STO GAPS & GUTTERS (S & S NOT MARKED IS MOUNT ROLL TYPE)

DRAINAGE BASIN BOUNDARY

RETAINING WALL

FILED: DECEMBER 12, 1973 (95-187)

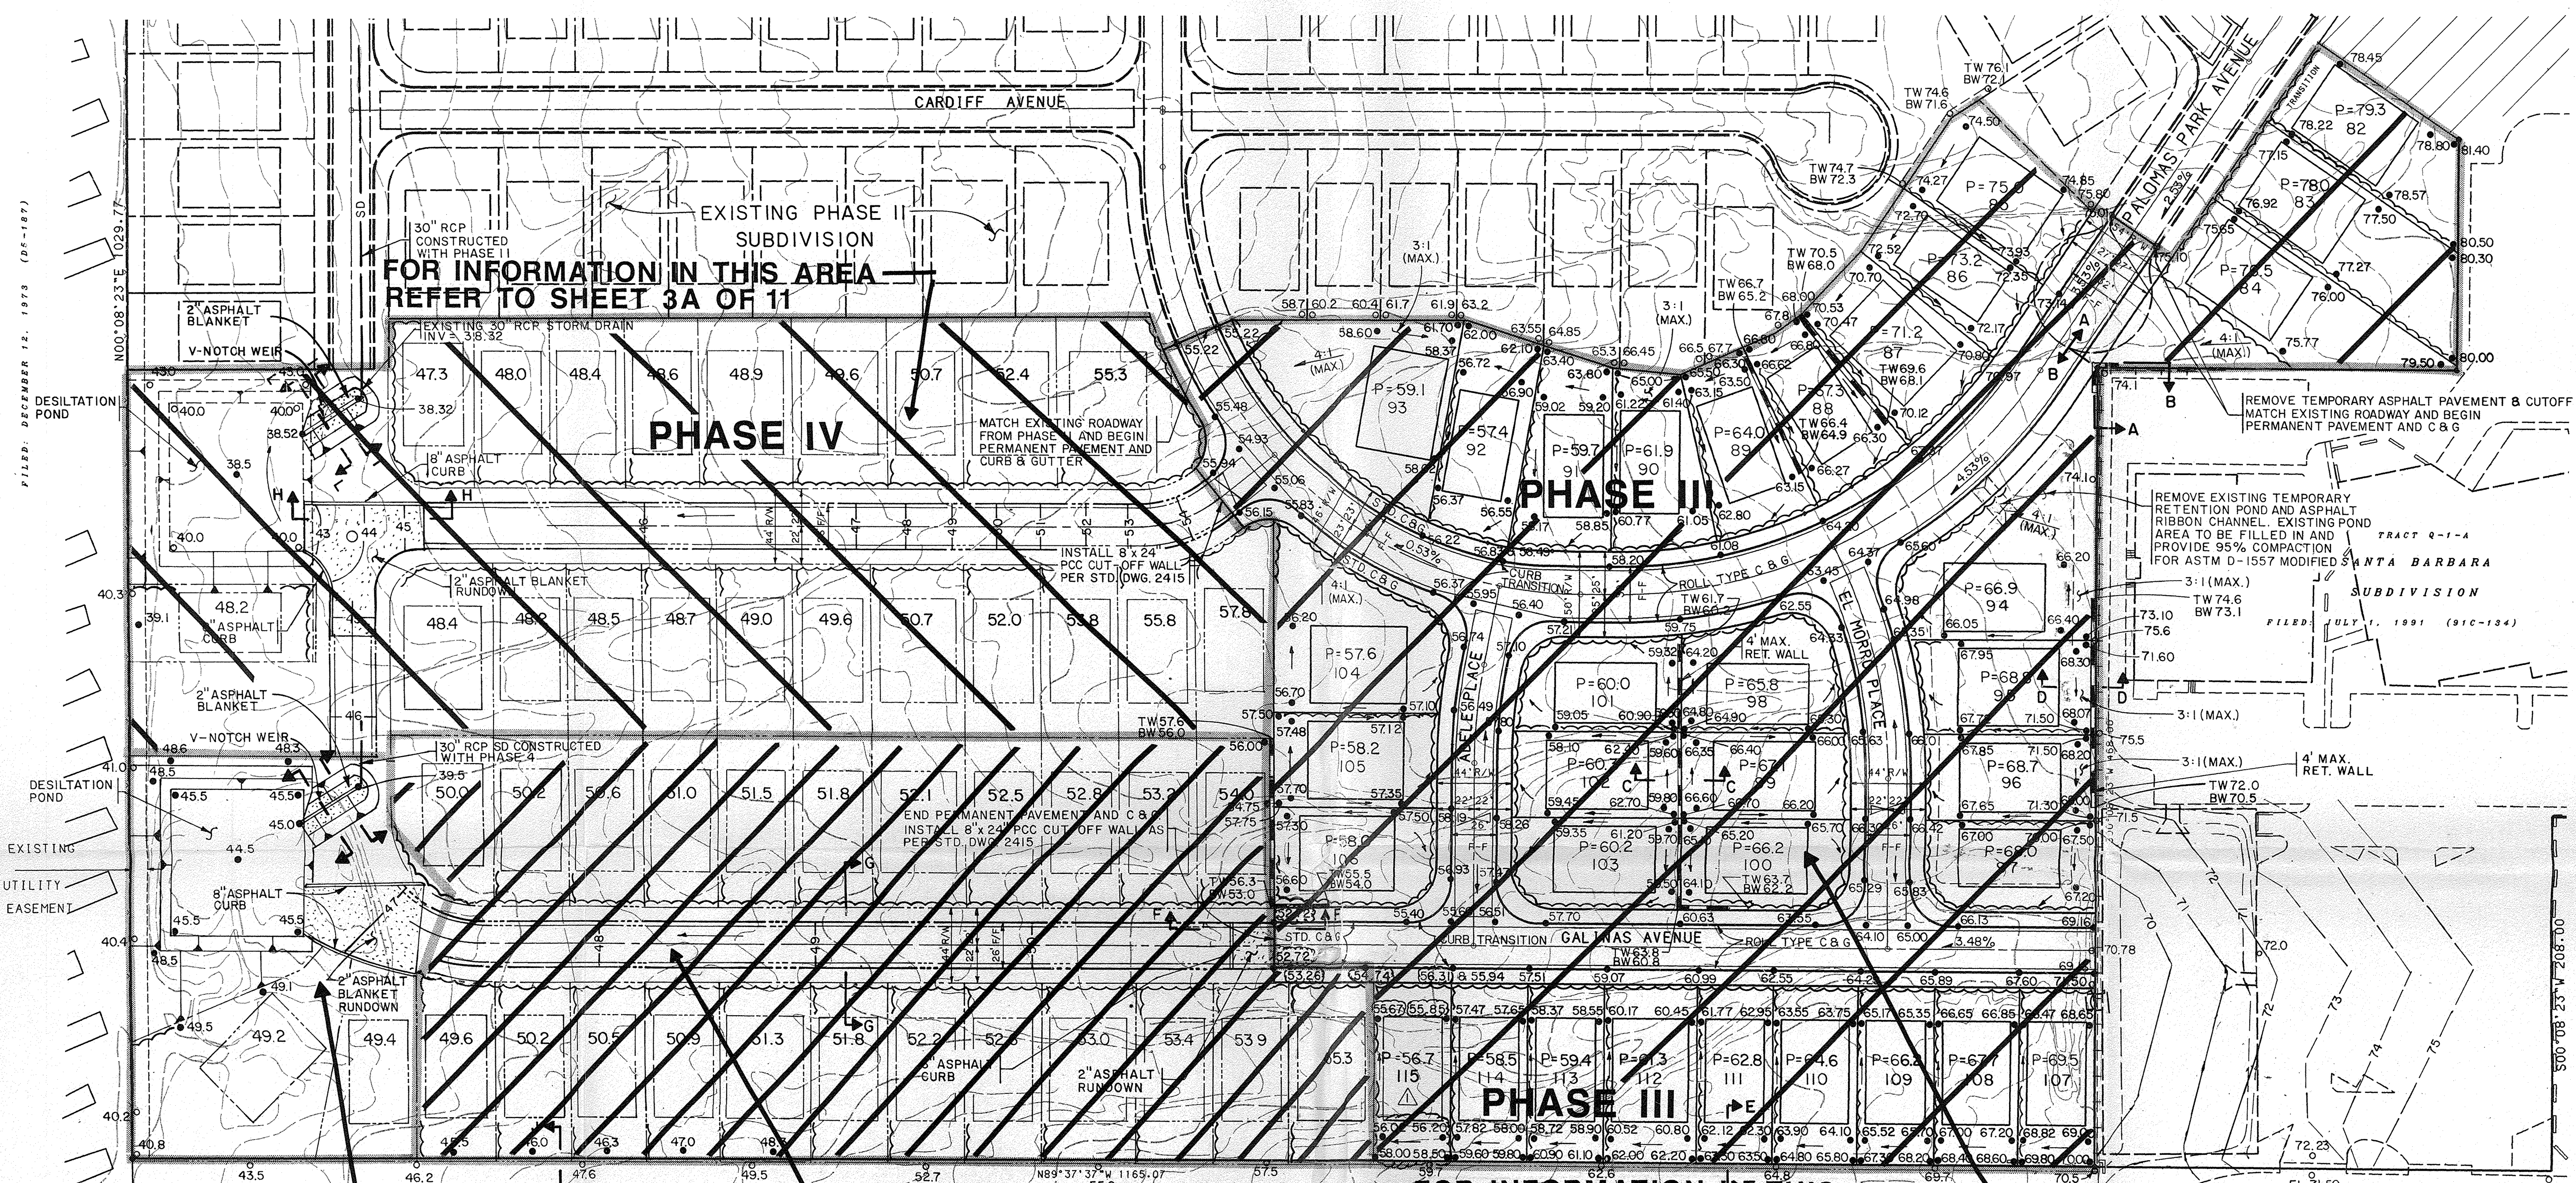

AREA OF CONCERN

NOTICE TO CONTRACTORS

1. AN EXCAVATION/CONSTRUCTION PERMIT WILL BE REQUIRED BEFORE BEGINNING ANY WORK WITHIN THE CITY RIGHT-OF-WAY. AN APPROVED COPY OF THESE PLANS MUST BE SUBMITTED AT THE TIME OF APPLICATIONS FOR THIS PERMIT.
2. ALL WORK DETAILED ON THESE PLANS TO BE PERFORMED, EXCEPT AS OTHERWISE STATED OR PROVIDED HEREON, SHALL BE CONSTRUCTED IN ACCORDANCE WITH CITY OF ALBUQUERQUE STANDARD SPECIFICATIONS FOR PUBLIC WORKS CONSTRUCTION, 1986.
3. TWO WORKING DAYS PRIOR TO ANY EXCAVATION, CONTRACTOR MUST CONTACT LINE LOCATION SERVICE, 765-1234, FOR LOCATION OF EXISTING UTILITIES.
4. PRIOR TO CONSTRUCTION, THE CONTRACTOR SHALL EXCAVATE AND VERIFY THE HORIZONTAL AND VERTICAL LOCATIONS OF ALL OBSTRUCTIONS. SHOULD A CONFLICT EXIST, THE CONTRACTOR SHALL NOTIFY THE ENGINEER SO THAT THE CONFLICT CAN BE RESOLVED WITH A MINIMUM AMOUNT OF DELAY.
5. BACKFILL COMPACTION SHALL BE TO RESIDENTIAL STREET USE.
6. MAINTENANCE OF THESE FACILITIES SHALL BE THE RESPONSIBILITY OF THE OWNER OF THE PROPERTY SERVED.
7. CONTRACTOR MUST OBTAIN A TOPSOIL DISTURBANCE PERMIT FROM THE ENVIRONMENTAL HEALTH DIVISION PRIOR TO CONSTRUCTION.
8. THE CONTRACTOR IS TO REFER TO EARTHWORK SPECIFICATIONS AS NOTED IN THE SOILS REPORT PREPARED BY VINYARD AND ASSOCIATES DATED SEPTEMBER 28, 1992.
9. THE CONTRACTOR SHALL CONFORM TO ALL CITY, COUNTY, STATE, AND FEDERAL DUST CONTROL MEASURES AND REQUIREMENTS AND WILL BE RESPONSIBLE FOR PREPARING AND OBTAINING ALL NECESSARY APPLICATIONS AND APPROVALS.
10. THE CONTRACTOR SHALL ENSURE THAT NO SOIL ERODES FROM THE LOTS INTO PUBLIC RIGHT-OF-WAY. THIS CAN BE ACHIEVED BY CONSTRUCTING TEMPORARY BERMS AS PER DETAIL THIS SHEET AND WETTING THE SOIL TO KEEP IT FROM BLOWING.
11. ALL SLOPES MAXIMUM OF 4:1 UNLESS AS OTHERWISE INDICATED.
12. ALL SPOT ELEVATIONS ALONG THE PROPOSED STREETS ARE TO TOP OF STANDARD OR MOUNTABLE ROLL TYPE CURB AND GUTTER (AS LABELED) UNLESS OTHERWISE NOTED.

IMPORTANT NOTE

THIS SHEET IS FOR THE RELOCATION AND GRADING OF THE DESILTATION POND FOR PHASE IV ONLY.

FOR GRADING AND DRAINAGE INFORMATION OTHER THAN THE DESILTATION POND FOR PHASE IV, REFER TO SHEET 3A OF 11.

FOR GRADING AND DRAINAGE INFORMATION FOR PHASE III, REFER TO PHASE III PLANS.

FUTURE PHASE V FOR INFORMATION IN THIS AREA REFER TO PHASE III PLANS

DRAINAGE PLAN

This Phase III drainage plan conforms to the overall drainage plan of the entire site, see Palomas Park Subdivision Drainage Report on June 1992, #D19-D1B).

The east end temporary retention pond constructed for Phase II, and the pond located in the proposed emergency access and waterline easement on the Church property, will be eliminated and regraded. Runoff from the Church property and the southern portion of this phase will be directed down Galinas Avenue to the west. Peak flow at the downstream end of Galinas Avenue at the Phase III boundary was calculated to be 36.2 cfs (see Drainage Calculations).

A temporary swale will be constructed to carry runoff through the proposed "rough graded" area of the site. The swale is designed to carry peak flow at under 3 fps (non-erosive per DPM, see Drainage Calculations) and approximates future grade and alignment of Galinas Avenue.

The west end temporary retention pond constructed as part of Phase II will be partially regraded. The remaining portion will serve as a temporary desiltation pond for runoff from this phase. From the desiltation pond, runoff will be diverted to an existing 30" RCP storm drain via a 40" long channel. All of these temporary improvements will be removed with Phase IV Palomas Park Subdivision.

A drainage covenant is prepared for the swale and the desiltation pond of Phase III. Per easements are placed over the desiltation pond and swale.

APPROVED FOR ROUGH GRADING (± 1')	
HYDROLOGY ENGINEER	DATE

NOTE: ALL CURB AND GUTTER ELEVATIONS SHOWN ARE TOP OF CURB ELEVATIONS.

RAINAGE CALCULATIONS

SWA (continuation of Galinas Ave.):

Total area to be treated (developed portion of Basin H - see overall grading plan)

Treatment B = 0.487 AC
Treatment C = 0.000 AC
Treatment D = 1.320 AC

Discharge from 100-year, 6-hour storm, Zone 3.

From developed portion of Basin H

$$Q_{100} = (0.487 \times 2.60) + (0.490 \times 3.45) + (1.320 \times 5.02) = 9.59 \text{ cfs}$$


From church property (revised drainage plan for addition to Church of the Risen Savior)

$$Q_{100} = 26.6 \text{ cfs}$$

Total discharge downstream

$$Q_{100} \text{ Total} = 9.59 + 26.6 = 36.2 \text{ cfs}$$

Through trial and error analysis, assuming a discharge of 36.2, the maximum depth in the Galinas Avenue swale is found to be 0.7 ft (S=0.5%). The maximum velocity at peak flow is as follows:


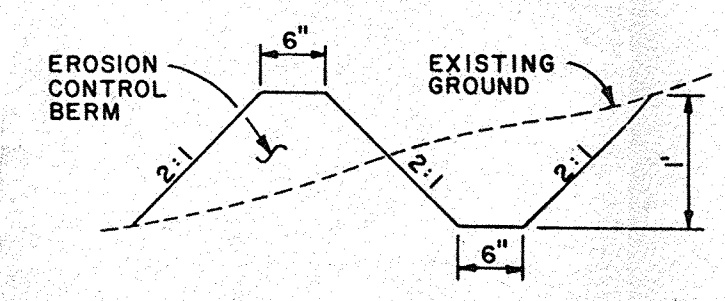
$$V_{max} = 1.49 \text{ m}^3 \text{ s}^{-2} \times 0.5^{1/2} = 1.49 / 0.3 \times (13.8 \text{ ft} / 29.2 \text{ m})^{1/2} \times (0.008)^{1/2} = 2.70 \text{ ft/s}$$


EROSION CONTROL PLAN

NO SCALE


A BERM WITH THE DIMENSIONS SHOWN SHALL BE MAINTAINED DURING CONSTRUCTION UNTIL COMPLETION OF INDIVIDUAL HOMES WITHIN THE PROJECT.

- #### LEGEND
- EROSION CONTROL BERM
 - EXISTING GROUND ELEVATION
 - PROPOSED GROUND ELEVATION
 - DRAINAGE FLOW DIRECTION
 - RETAINING WALL
 - EXISTING CONTOUR
 - WATER BLOCK (HIGH POINT)
 - PROPOSED CONTOUR

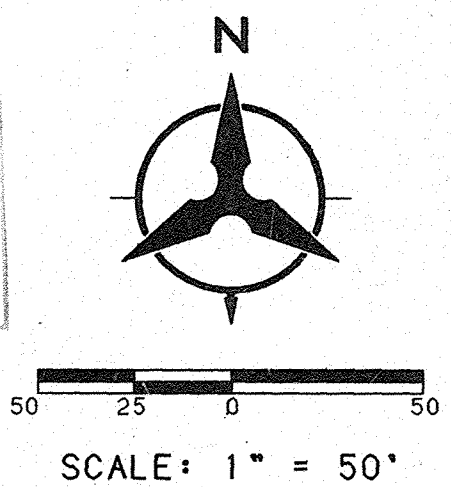
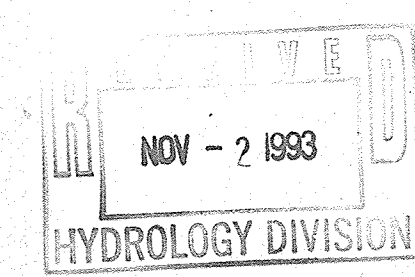


CITY OF ALBUQUERQUE PUBLIC WORKS DEPARTMENT ENGINEERING GROUP					
PALOMAS PARK- PHASE IV GRADING OF DESILTATION POND					
APPROVALS	ENGINEER	DATE	APPROVALS	ENGINEER	DATE
DRC CHAIRMAN			WATER		
TRANSPORTATION			WASTE WATER		
HYDROLOGY					
DRAWING NO.		MAP NO. D-19		SHEET 3B OF 11	

ENGINEER'S SEAL		SURVEY INFORMATION		BENCH MARKS		AS BUILT INFORMATION	
NO.	BY	NO.	DATE	STATION	IS A STANDARD USGS BRASS TABLET	CONTRACTOR	DATE
				STAMPED "HEAVEN 1989" SET IN TOP OF A		STAKED BY	DATE
				CONCRETE POST FLUSH WITH THE GROUND. LOCATED		ACCEPTANCE BY	DATE
				WEST ON PASSED DEL NORTE FROM NYONG BLVD.		FIELD	DATE
				APPROXIMATELY 800 FEET.		DRUMS	DATE
						CORRECTED BY	DATE
						MICRO-FILM INFORMATION	DATE
						RECORDED BY	DATE
						NO.	
						ELEVATION = 5378.787	

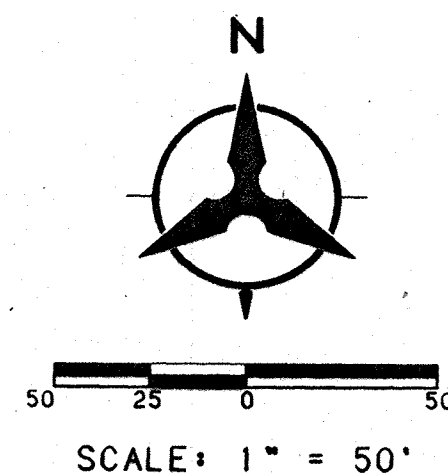

NOTE:
I. PHASES I AND II OF THE OVERALL SUBDIVISION ARE IN FINAL STAGES OF COMPLETION. GRADES SHOWN AS EXISTING ARE DESIGN GRADES ONLY. CONTRACTOR SHALL BE FULLY RESPONSIBLE FOR VERIFYING EXISTING GRADES AND NOTIFYING ENGINEER OF ANY SIGNIFICANT DISCREPANCIES.

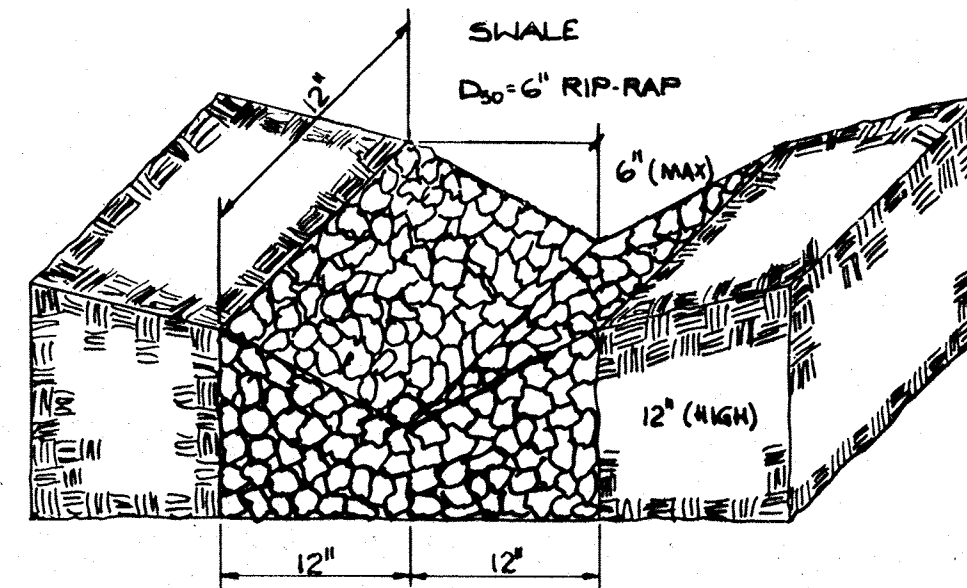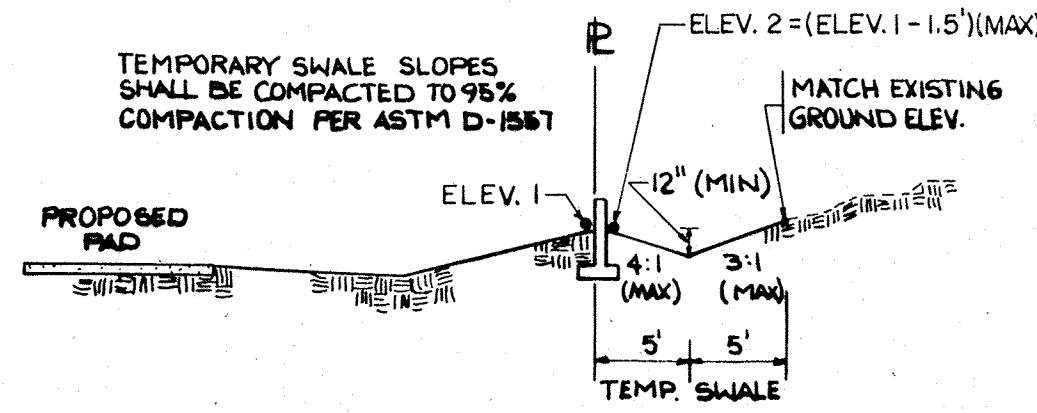

GRADING CERTIFICATION

I, James Topmiller, P.E. #9354, hereby certify that grading at this site is constructed in substantial compliance with this plan, to allow the implementation of the drainage patterns and requirements identified herein. Side yard garden walls will be constructed concurrently with individual home construction, which will implement required side yard swales. As-built grade elevations were verified by field surveys performed by Aldrich Surveying during November 1993, after completion of construction. This statement does not represent certification of contractor's construction methods or materials.

Note: Record, or "as-built" elevations, are shown at selected locations across the site. Record information is identified by a double underline.



NOTICE TO CONTRACTORS

1. AN EXCAVATION/CONSTRUCTION PERMIT WILL BE REQUIRED BEFORE BEGINNING ANY WORK WITHIN THE CITY RIGHT-OF-WAY. AN APPROVED COPY OF THESE PLANS MUST BE SUBMITTED AT THE TIME OF APPLICATION FOR THIS PERMIT.
2. ALL WORK DETAILED ON THESE PLANS TO BE PERFORMED, EXCEPT AS OTHERWISE STATED OR PROVIDED HEREON, SHALL BE CONSTRUCTED IN ACCORDANCE WITH CITY OF ALBUQUERQUE STANDARD SPECIFICATIONS FOR PUBLIC WORKS CONSTRUCTION, 1986.
3. TWO WORKING DAYS PRIOR TO ANY EXCAVATION, CONTRACTOR MUST CONTACT LINE LOCATION SERVICE, 765-1234, FOR LOCATION OF EXISTING UTILITIES.
4. PRIOR TO CONSTRUCTION, THE CONTRACTOR SHALL EXCAVATE AND VERIFY THE HORIZONTAL AND VERTICAL LOCATIONS OF ALL OBSTRUCTIONS. SHOULD A CONFLICT EXIST, THE CONTRACTOR SHALL NOTIFY THE ENGINEER SO THAT THE CONFLICT CAN BE RESOLVED WITH A MINIMUM AMOUNT OF DELAY.
5. BACKFILL COMPACTION SHALL BE TO RESIDENTIAL STREET USE.
6. MAINTENANCE OF THESE FACILITIES SHALL BE THE RESPONSIBILITY OF THE OWNER OF THE PROPERTY SERVED.
7. CONTRACTOR MUST OBTAIN A TOPSOIL DISTURBANCE PERMIT FROM THE ENVIRONMENTAL HEALTH DIVISION PRIOR TO CONSTRUCTION.
8. THE CONTRACTOR IS TO REFER TO EARTHWORK SPECIFICATIONS AS NOTED IN THE SOILS REPORT PREPARED BY VINVARD AND ASSOCIATES DATED SEPTEMBER 28, 1992.
9. THE CONTRACTOR SHALL CONFORM TO ALL CITY, COUNTY, STATE, AND FEDERAL DUST CONTROL MEASURES AND REQUIREMENTS AND WILL BE RESPONSIBLE FOR PREPARING AND OBTAINING ALL NECESSARY APPLICATIONS AND APPROVALS.
10. THE CONTRACTOR SHALL ENSURE THAT NO SOIL ERODES FROM THE LOTS INTO PUBLIC RIGHT-OF-WAY. THIS CAN BE ACHIEVED BY CONSTRUCTING TEMPORARY BERMS AS PER DETAIL THIS SHEET AND WETTING THE SOIL TO KEEP IT FROM BLOWING.
11. TURN BLOCKS ON EDGE ON DOWNSTREAM END OF ALL REAR DRAINING LOTS TO PROVIDE WEEP HOLES IN WALLS (NOT APPLICABLE).
12. ALL SPOTS ELEVATIONS ALONG THE PROPOSED STREETS ARE TO TOP OF STANDARD OR MOUNTABLE ROLL TYPE CURB AND GUTTER (AS LABELED) UNLESS OTHERWISE NOTED.

FOR INFORMATION ONLY

LEGEND

- EROSION CONTROL BERM
- EXISTING GROUND ELEVATIONS
- PROPOSED GROUND ELEVATIONS
- DRAINAGE FLOW DIRECTION
- RETAINING WALL
- PROPOSED STORM DRAIN INLET
- EXISTING STORM DRAIN INLET
- PROPOSED STORM DRAIN MANHOLE
- EXISTING STORM DRAIN MANHOLE
- PROJECT BOUNDARY
- EXISTING CONTOUR
- FUTURE PAD ELEVATIONS


49.5

CITY OF ALBUQUERQUE
PUBLIC WORKS DEPARTMENT
ENGINEERING GROUP

**PALOMAS PARK - PHASE TWO
GRADING PLAN**

APPROVALS	ENGINEER	DATE	APPROVALS	ENGINEER	DATE
DRG. CHAIRMAN	J. R. Topmiller	3-10-93	WATER	N/A	RWK 3-2-93
TRANSPORTATION	J. R. Topmiller	3-10-93	WASTE WATER	N/A	RWK 3-2-93
HYDROLOGY	J. R. Topmiller	3-10-93			

DRAWING NO. 4510.91 MAP NO. D-19 SHEET 3 OF 12

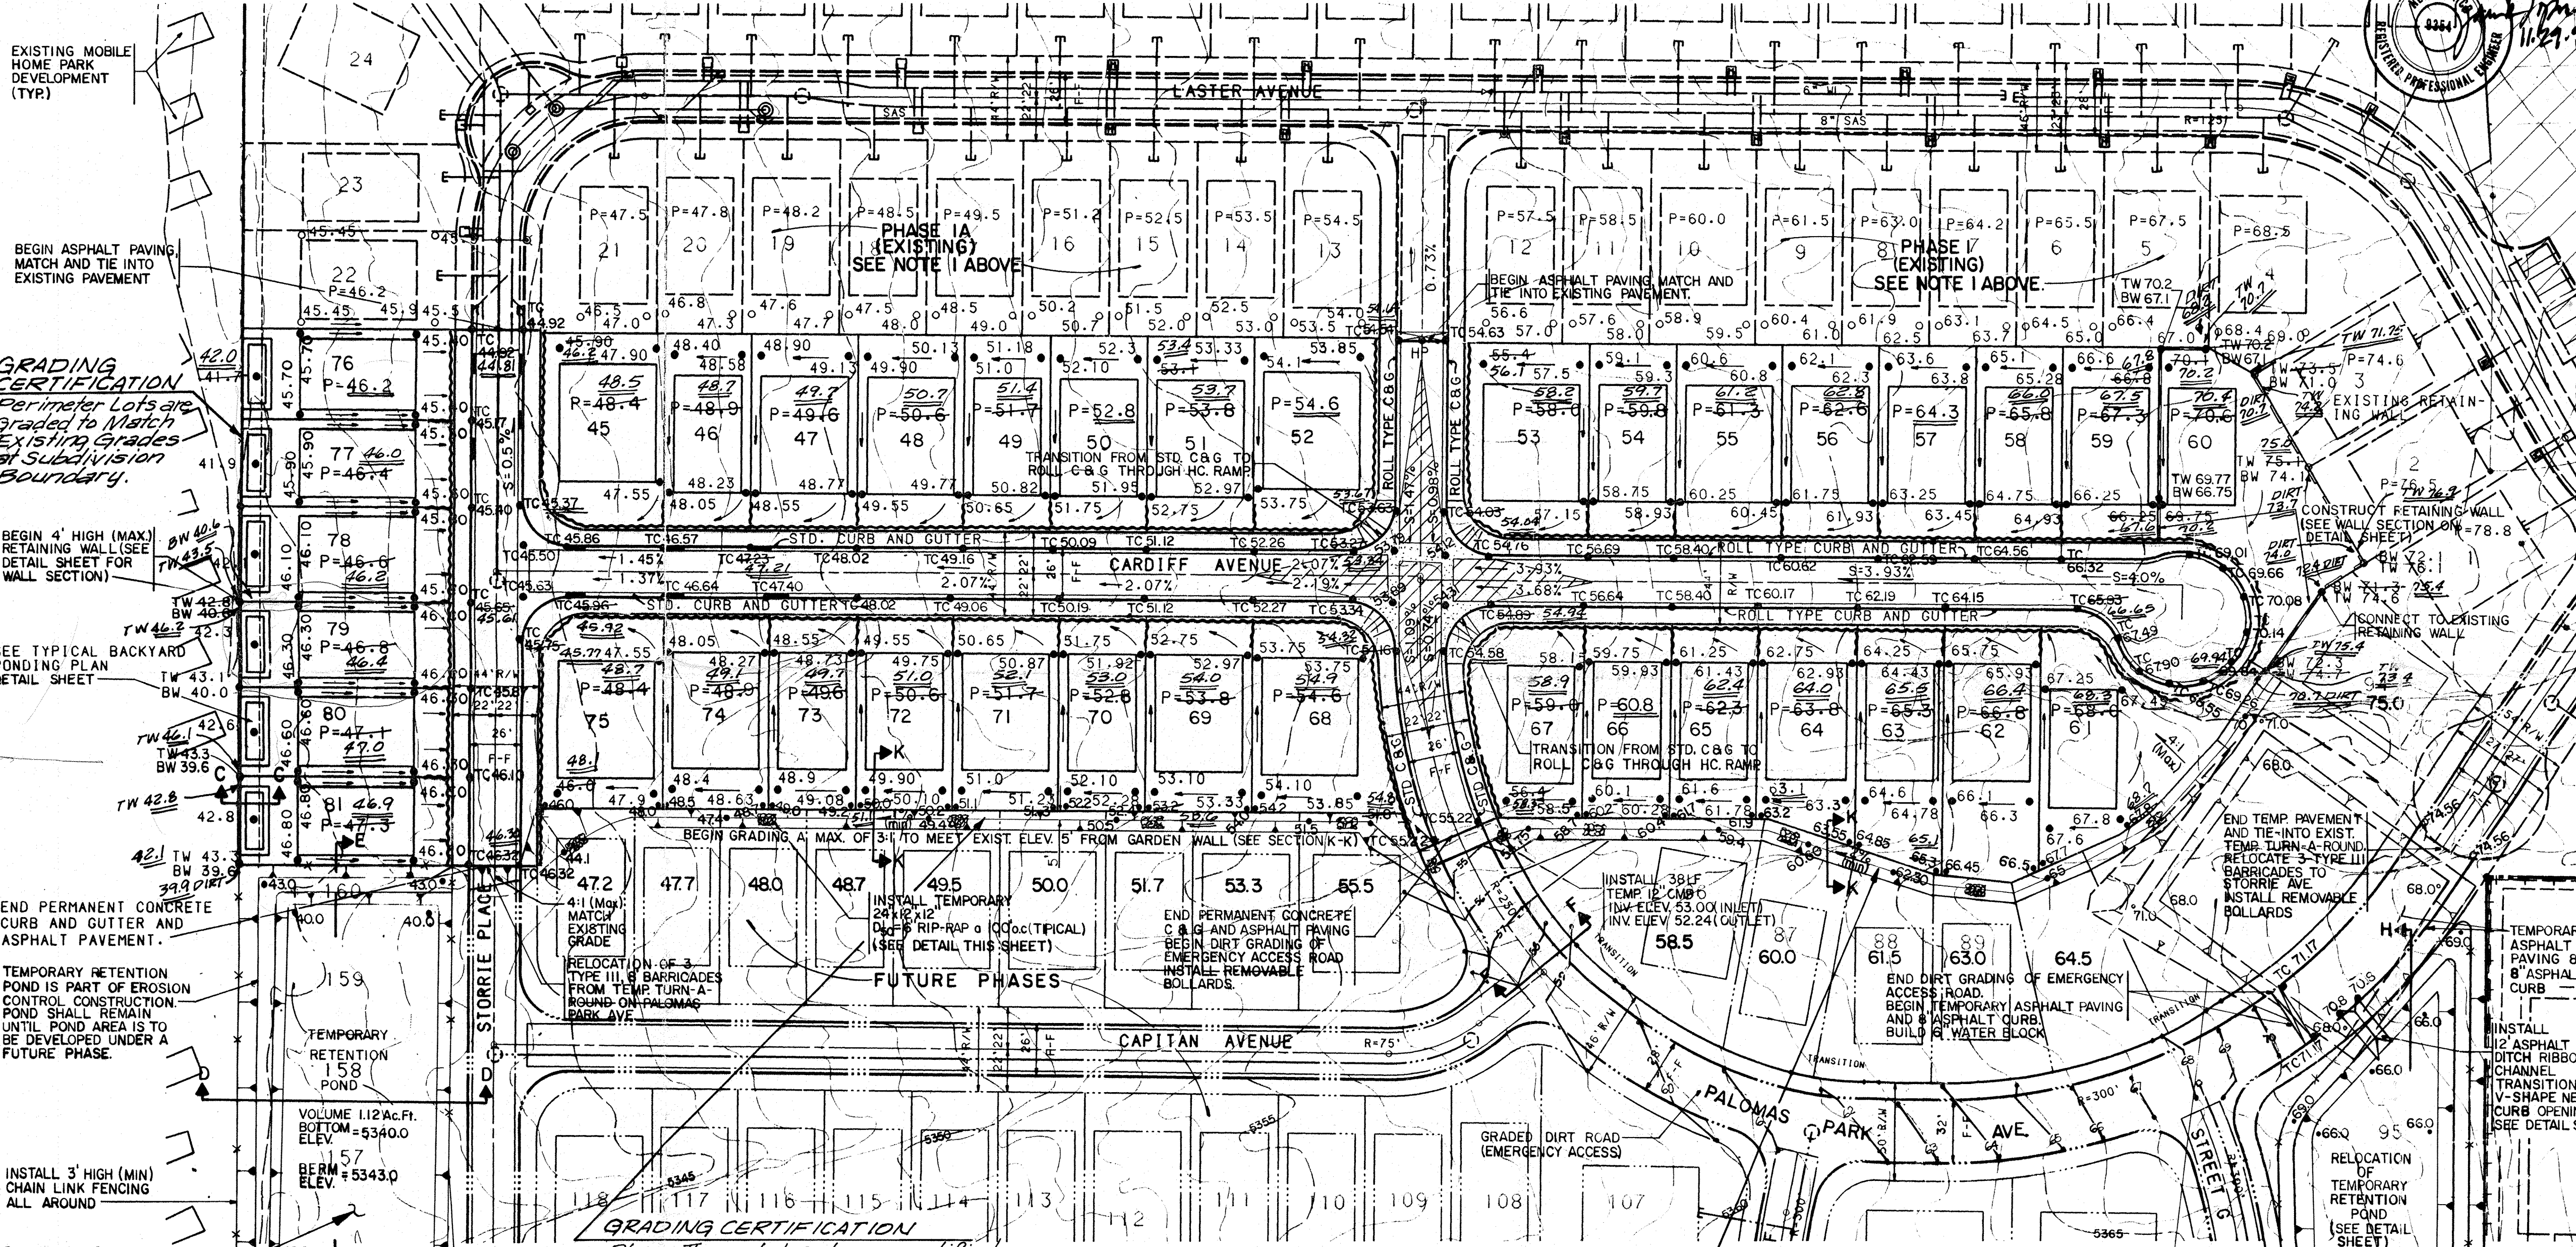

GRADING CERTIFICATION

Perimeter Lots are Graded to Match Existing Grades at Subdivision Boundary.

BEGIN 4' HIGH (MAX) RETAINING WALL (SEE DETAIL SHEET FOR WALL SECTION)

SEE TYPICAL BACKYARD PONDING PLAN DETAIL SHEET


END PERMANENT CONCRETE CURB AND GUTTER AND ASPHALT PAVEMENT.

TEMPORARY RETENTION POND IS PART OF EROSION CONTROL CONSTRUCTION. POND SHALL REMAIN UNTIL POND AREA IS TO BE DEVELOPED UNDER A FUTURE PHASE.

INSTALL 3' HIGH (MIN) CHAIN LINK FENCING ALL AROUND

GRADING CERTIFICATION

Phase II Pond has been modified to meet Phase III Grading Operations. See approved Phase III plan.

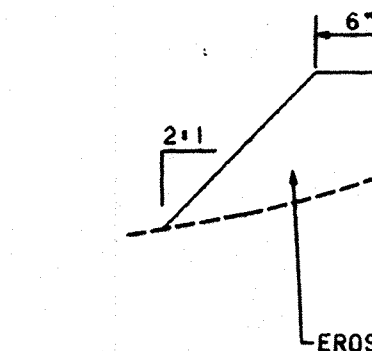

EROSION CONTROL PLAN

NO SCALE

A BERM WITH THE DIMENSIONS SHOWN SHALL BE MAINTAINED DURING CONSTRUCTION UNTIL COMPLETION OF INDIVIDUAL HOMES WITHIN THE PROJECT.

DRAINAGE PLAN

THIS PHASE 2 DRAINAGE PLAN CONFORMS TO THE OVERALL DRAINAGE PLAN OF THE ENTIRE SITE (SEE PALOMAS PARK SUBDIVISION DRAINAGE REPORT ON JUNE 1992 #D19-D18).

A PORTION OF PALOMAS PARK AVE. WILL BE DIRT GRADED SO AS TO PROVIDE AN EMERGENCY ACCESS RD. FOR PHASE 2.

THE RETENTION POND AT FUTURE LOTS 156 TO 160 IS TO BE CONSTRUCTED TO RETAIN RUNOFF FROM FUTURE PHASES.

THE RETENTION POND AT THE EAST SIDE CONSTRUCTED IN PHASE 1 SHALL BE RELOCATED SOUTH, BUT WILL SERVE SAME PURPOSE.

POND CALCULATIONS (WEST)

BASINS H, H-1, H-2, & L (SEE OVERALL GRADING PLAN)

TOTAL AREA OF EACH TREATMENT OF THE 4 BASINS COMBINED.

TREATMENT B 3.82 ACRES
TREATMENT C 7.65 ACRES
TOTAL AREA 10.94 ACRES

100 YEAR-6 HR STORM IN ZONE 3

EXCESS PRECIPITATION (E) =

$$0.92'' (3.82 + 1.29 + 7.65) = 1.18''$$
$$8.12 \text{ ACRES}$$


$$\text{RUNOFF VOLUME} = 1.66'' (8.12) = 1.07 \text{ AC-FT}$$

GRADING CERTIFICATION

Phase II swale has been modified to meet Phase III Grading Operations. See approved Phase III plan.

EXISTING RETENTION POND TO BE REGRADED. SEE THIS SHEET FOR NEW LOCATION. EXISTING POND AREA TO BE FILLED IN AND PROVIDE OF 95% COMPACTION FOR ASTM D-1557 MODIFIED.

BERM SHALL CONSIST OF 95% COMPACTION PER ASTM D-1557 MODIFIED

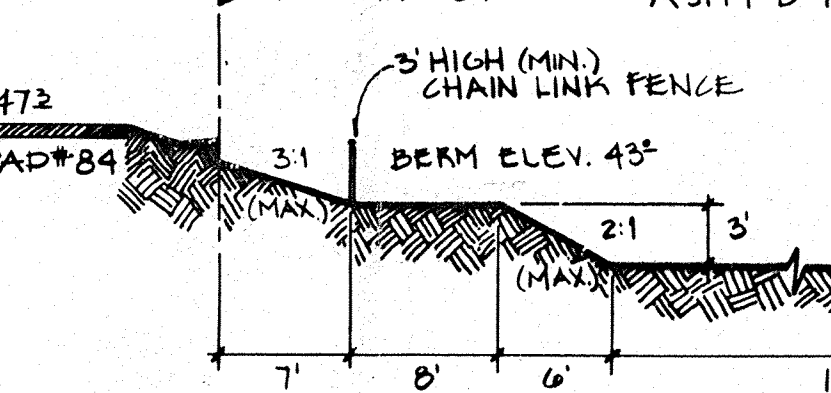

**SECTION E-E
N.T.S.**