



County of Bernalillo

State of New Mexico

2400 BROADWAY, S.E.
ALBUQUERQUE, NEW MEXICO 87102
PUBLIC WORKS (505) 848-1500

May 17, 1996

BOARD OF COUNTY COMMISSIONERS

ALBERT "AL" VALDEZ, CHAIRMAN
DISTRICT 2
KEN SANCHEZ, VICE CHAIR
DISTRICT 1
EUGENE M. GILBERT, MEMBER
DISTRICT 3
BARBARA J. SEWARD, MEMBER
DISTRICT 4
LES HOUSTON, MEMBER
DISTRICT 5
JUAN R. VIGIL, COUNTY MANAGER

DAVID K. ANDERSON, ASSESSOR
JUDY D. WOODWARD, CLERK
THOMAS J. MESCALL, PROBATE JUDGE
JOE BOWDICH, SHERIFF
H. R. FINE, TREASURER

Philip W. Clark, P.E.
Clark Consulting Engineers
19 Ryan Road
Edgewood, New Mexico 87015

RE: ENGINEER'S CERTIFICATION FOR LOT 1517 SANDIA HEIGHTS SOUTH
(D23/D43) (PWD 95-134) SUBMITTED FOR CERTIFICATE OF
OCCUPANCY APPROVAL, ENGINEER'S STAMP DATED 5/16/96.

Dear Mr. Clark:

Based on the information provided in the submittal of May 17, 1996, the Engineer's Certification for the above referenced Lot is acceptable for Certificate of Occupancy release.


If you should have any questions, or if I may be of further assistance to you, please call me at 768-2666.

Sincerely,

A handwritten signature in cursive script, reading "Susan Calongne".

Susan M. Calongne, P.E.
City/County Floodplain Administrator

c: Roger Paul, Bernalillo County Public Works Division
Kurt Browning, Albuquerque Metropolitan Arroyo Flood Control Authority
File

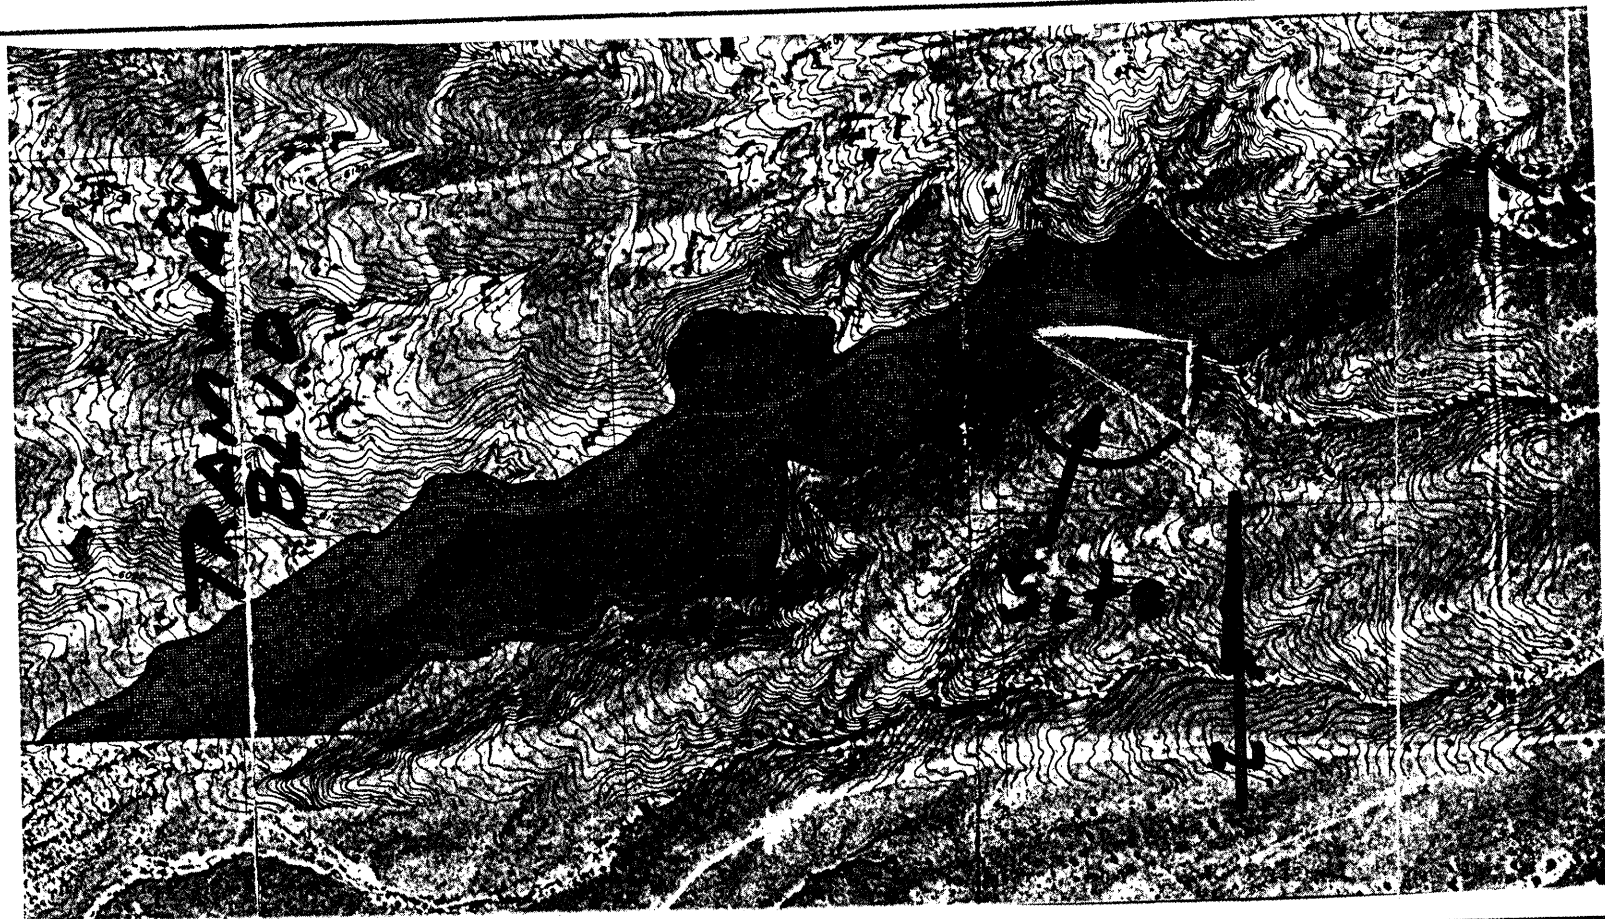

FEMA MAP, PANEL 11 @ 1"=500'

LEGEND

EXIST. SPOT ELEV. + 99.6

EXIST. CONTOUR — 08

NEW SPOT ELEV. 10.10

NEW CONTOUR — 10

NEW STRUCTURE

NEW CONCRETE

TOP OF GARDEN WALL
BOTTOM OF WALL @ GRADE
BOTTOM OF FOOTING

TGW21.8
BW07.5
BOF05.5

PROJECT INFORMATION

LEGAL DESCRIPTION:

LOT 1517, UNIT 15, SANDIA HEIGHTS SOUTH
BERNALILLO COUNTY, NEW MEXICO

PROJECT BENCHMARK

TOP OF REBAR AT THE SOUTHEAST PROPERTY CORNER, ELEVATION =
6223.40, AS TIED FROM ALBUQUERQUE CONTROL SURVEY


PROPERTY ADDRESS:

1517 EAGLE RIDGE TERRACE, NE, ALBUQUERQUE, NM 87122

TOPOGRAPHIC SURVEY:

PERFORMED UNDER THE DIRECT SUPERVISION OF PHILIP W. TURNER, P.S.
LICENSE # 10204, IN JULY, 1995.

SCALE: 1" = 20'

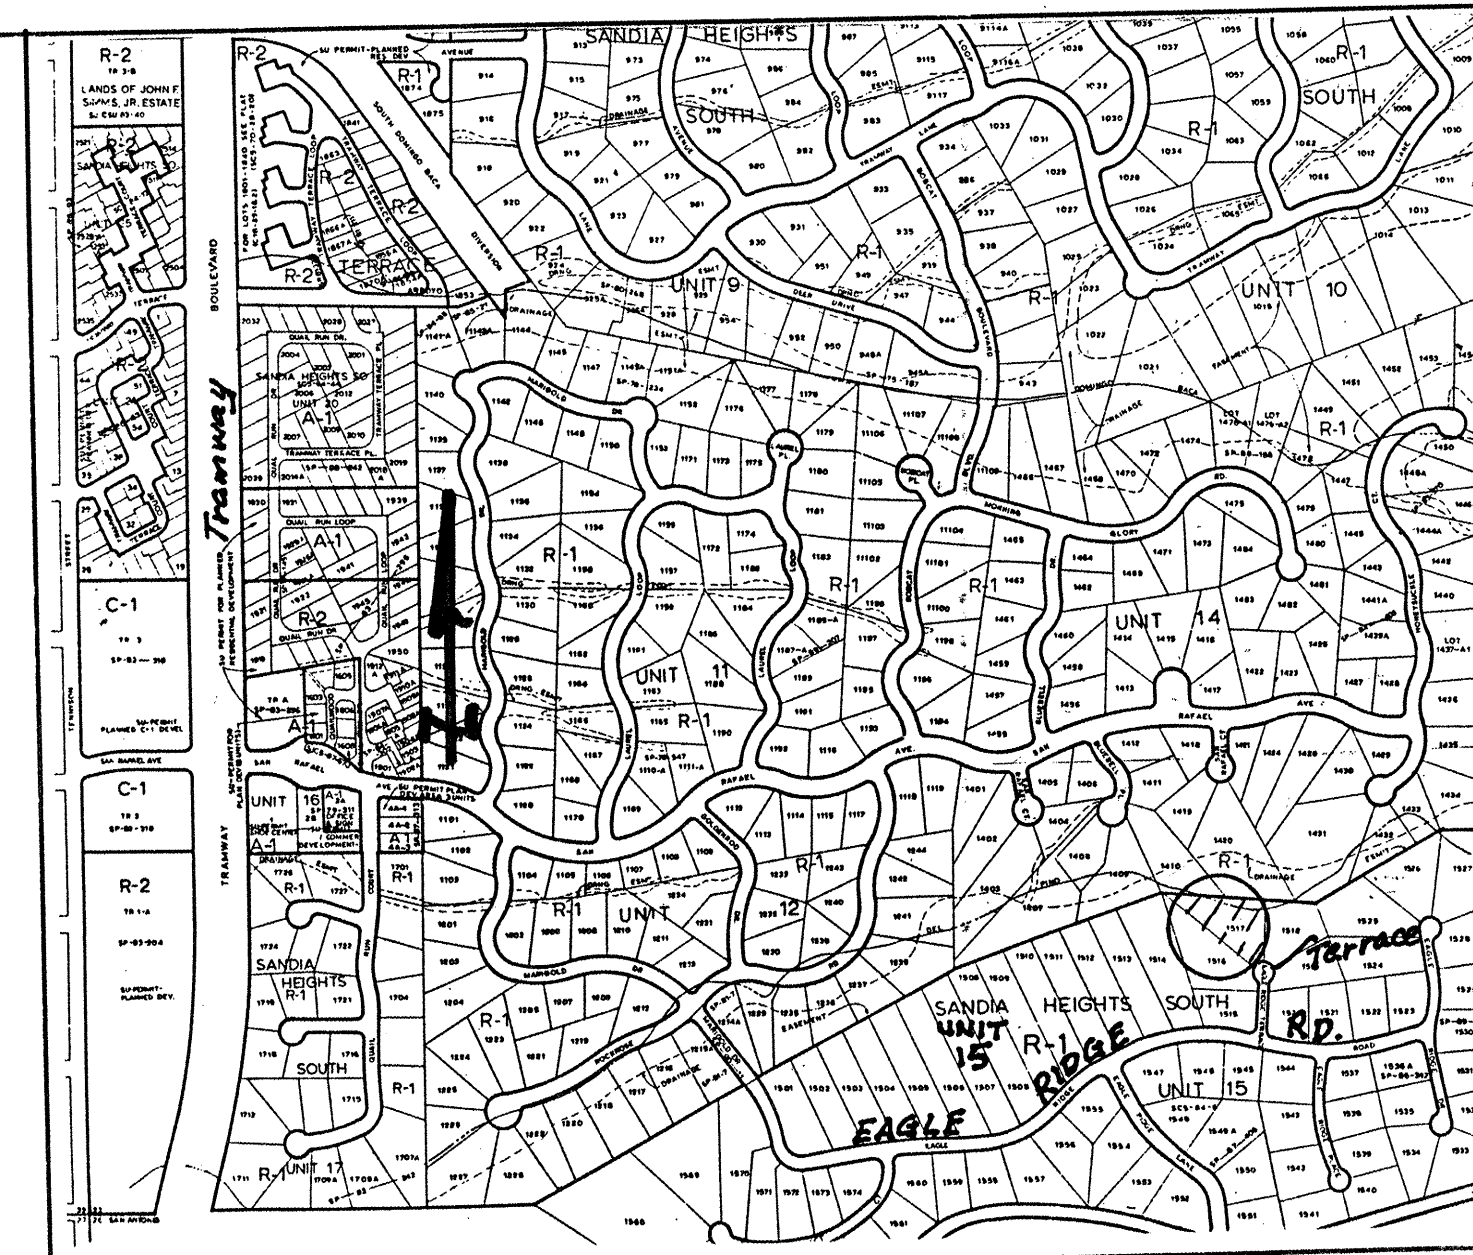

VICINITY MAP, ZONE D-23 @ 1"=750'

CALCULATIONS

I. DESIGN CRITERIA

HYDROLOGIC METHODS PER SECTION 22.2, HYDROLOGY, OF THE DEVELOPMENT PROCESS MANUAL (DPM), REVISED CITY OF ALBUQUERQUE AND ADOPTED BY THE COUNTY OF BERNALILLO.
JANUARY 1993, FOR THE CITY OF ALBUQUERQUE
DISCHARGE RATE: $Q = Q_{peak} \times AREA$ PEAK DISCHARGE RATES FOR SMALL WATERSHEDS
SOIL TYPE: 19, Emb SERIES, EMBUDO, A GRAVELLY FINE SANDY LOAM AS CLASSIFIED BY THE SOIL CONS. SERVICE
VOLUMETRIC DISCHARGE: $VOLUME = Weighted \times AREA$ TIME OF CONCENTRATION $TC = 10$ MINUTES
P100 = 2.9 INCHES, ZONE 4
DESIGN STORM: 100-year/6-hour, 10-year/6-hour WHERE $[] = 10$ year VALUES

II. EXISTING CONDITIONS

LOT AREA = 1.21 ACRES, WHERE EXCESS PRECIPITATION 'A' = 0.8 IN. [0.28]
PEAK DISCHARGE, $Q_{100} = 2.66$ CFS [1.05], WHERE UNIT PEAK DISCHARGE 'A' = 2.2 CFS/ACRE [0.87]
THEREFORE: $VOLUME_{100} = 3485$ C.F. [1230 C.F.]

III. DEVELOPED CONDITIONS

DETERMINE LAND TREATMENTS, PEAK DISCHARGE & WEIGHTED EXCESS PRECIPITATION

AREA	LAND TREATMENT	UNIT PEAK DISCHARGE	'E'
UNDEVELOPED,	A	2.20 [0.87]	0.8 [0.28]
LANDSCAPING,	B	2.92 [1.45]	1.08 [0.46]
GRAVEL & COMPACTED SOIL	C	3.71 [2.28]	1.46 [0.73]
ROOF/PAVEMENT,	D	5.25 [3.57]	2.64 [1.69]
0.13 AC			
1.21 ACRES			

Weighted = 1.07 IN. [0.46]
 $Q_{100} = 3.27$ CUBIC FEET PER SECOND (CFS) $Q_{10} = 1.6$ CFS; $VOL_{100} = 4700$ CUBIC FEET (CF), $VOL_{10} = 2021$ CF

IV. QUANTIFY UP-STREAM RUNOFF IMPACTING THE PROPERTY


① NORTH PORTION OF THE SUBJECT PROPERTY - ARROYO DE PINO
PURSUANT TO DISCUSSION WITH KURT BROWNING, DRAINAGE ENGINEER, ALBUQUERQUE METROPOLITAN ARROYO FLOOD CONTROL AUTHORITY: AS PER THE ON-GOING STUDY TO REVISE FEMA MAPPING BY RESOUC TECHNOLOGIES, INC. THE PINO ARROYO DESIGN DISCHARGE IS APPROXIMATELY 4500 CFS AT THIS LOCATION. THEREFORE USE 4500 CFS.

V. DETERMINE HYDRAULIC PROPERTIES OF ARROYO IMPACTING THE PROJECT EAST BOUNDARY ② MIDDLE OF SITE

WHERE: $N = 0.035$, WIDTH(BOTTOM) = 120' SLOPE = 4% SIDESLOPES 15:1, THEREFORE:
NORMAL DEPTH = 2.25 FEET PER MANNINGS EQUATION, $VEL_{100} = 12.8$ FEET PER SECOND, AREA = 350 S.F.
 $W_{TOP} = 188'$

$$F_r = Q / (A \cdot g \cdot W) = 1.66, \text{ THEREFORE SUPERCRITICAL, USE SEQUENT DEPTH ANALYSIS PER SEDIMENTATION EROSION DESIGN GUIDE, REF. EQ. 3.23 AND 3.24 PP. 3-20}$$
$$CWSEL_{SEQ} = CWSEL + 0.5(A/W) \{ (1 + F_r^2)^{1/2} - 3 \}$$
$$= 2.25 + 1.67 = 3.93 \text{ FEET}$$

THEREFORE COMPARING THE ABOVE COMPUTED DEPTH AND TOP WIDTH WITH EXISTING FEMA MAPPING THE DEDICATED EASEMENT APPEARS REASONABLE. NOTE THAT FEMA INDICATES A FLOODPLAIN WIDTH OF 210 FEET, WHICH WOULD REDUCE ACTUAL DEPTH OF FLOW SLIGHTLY.

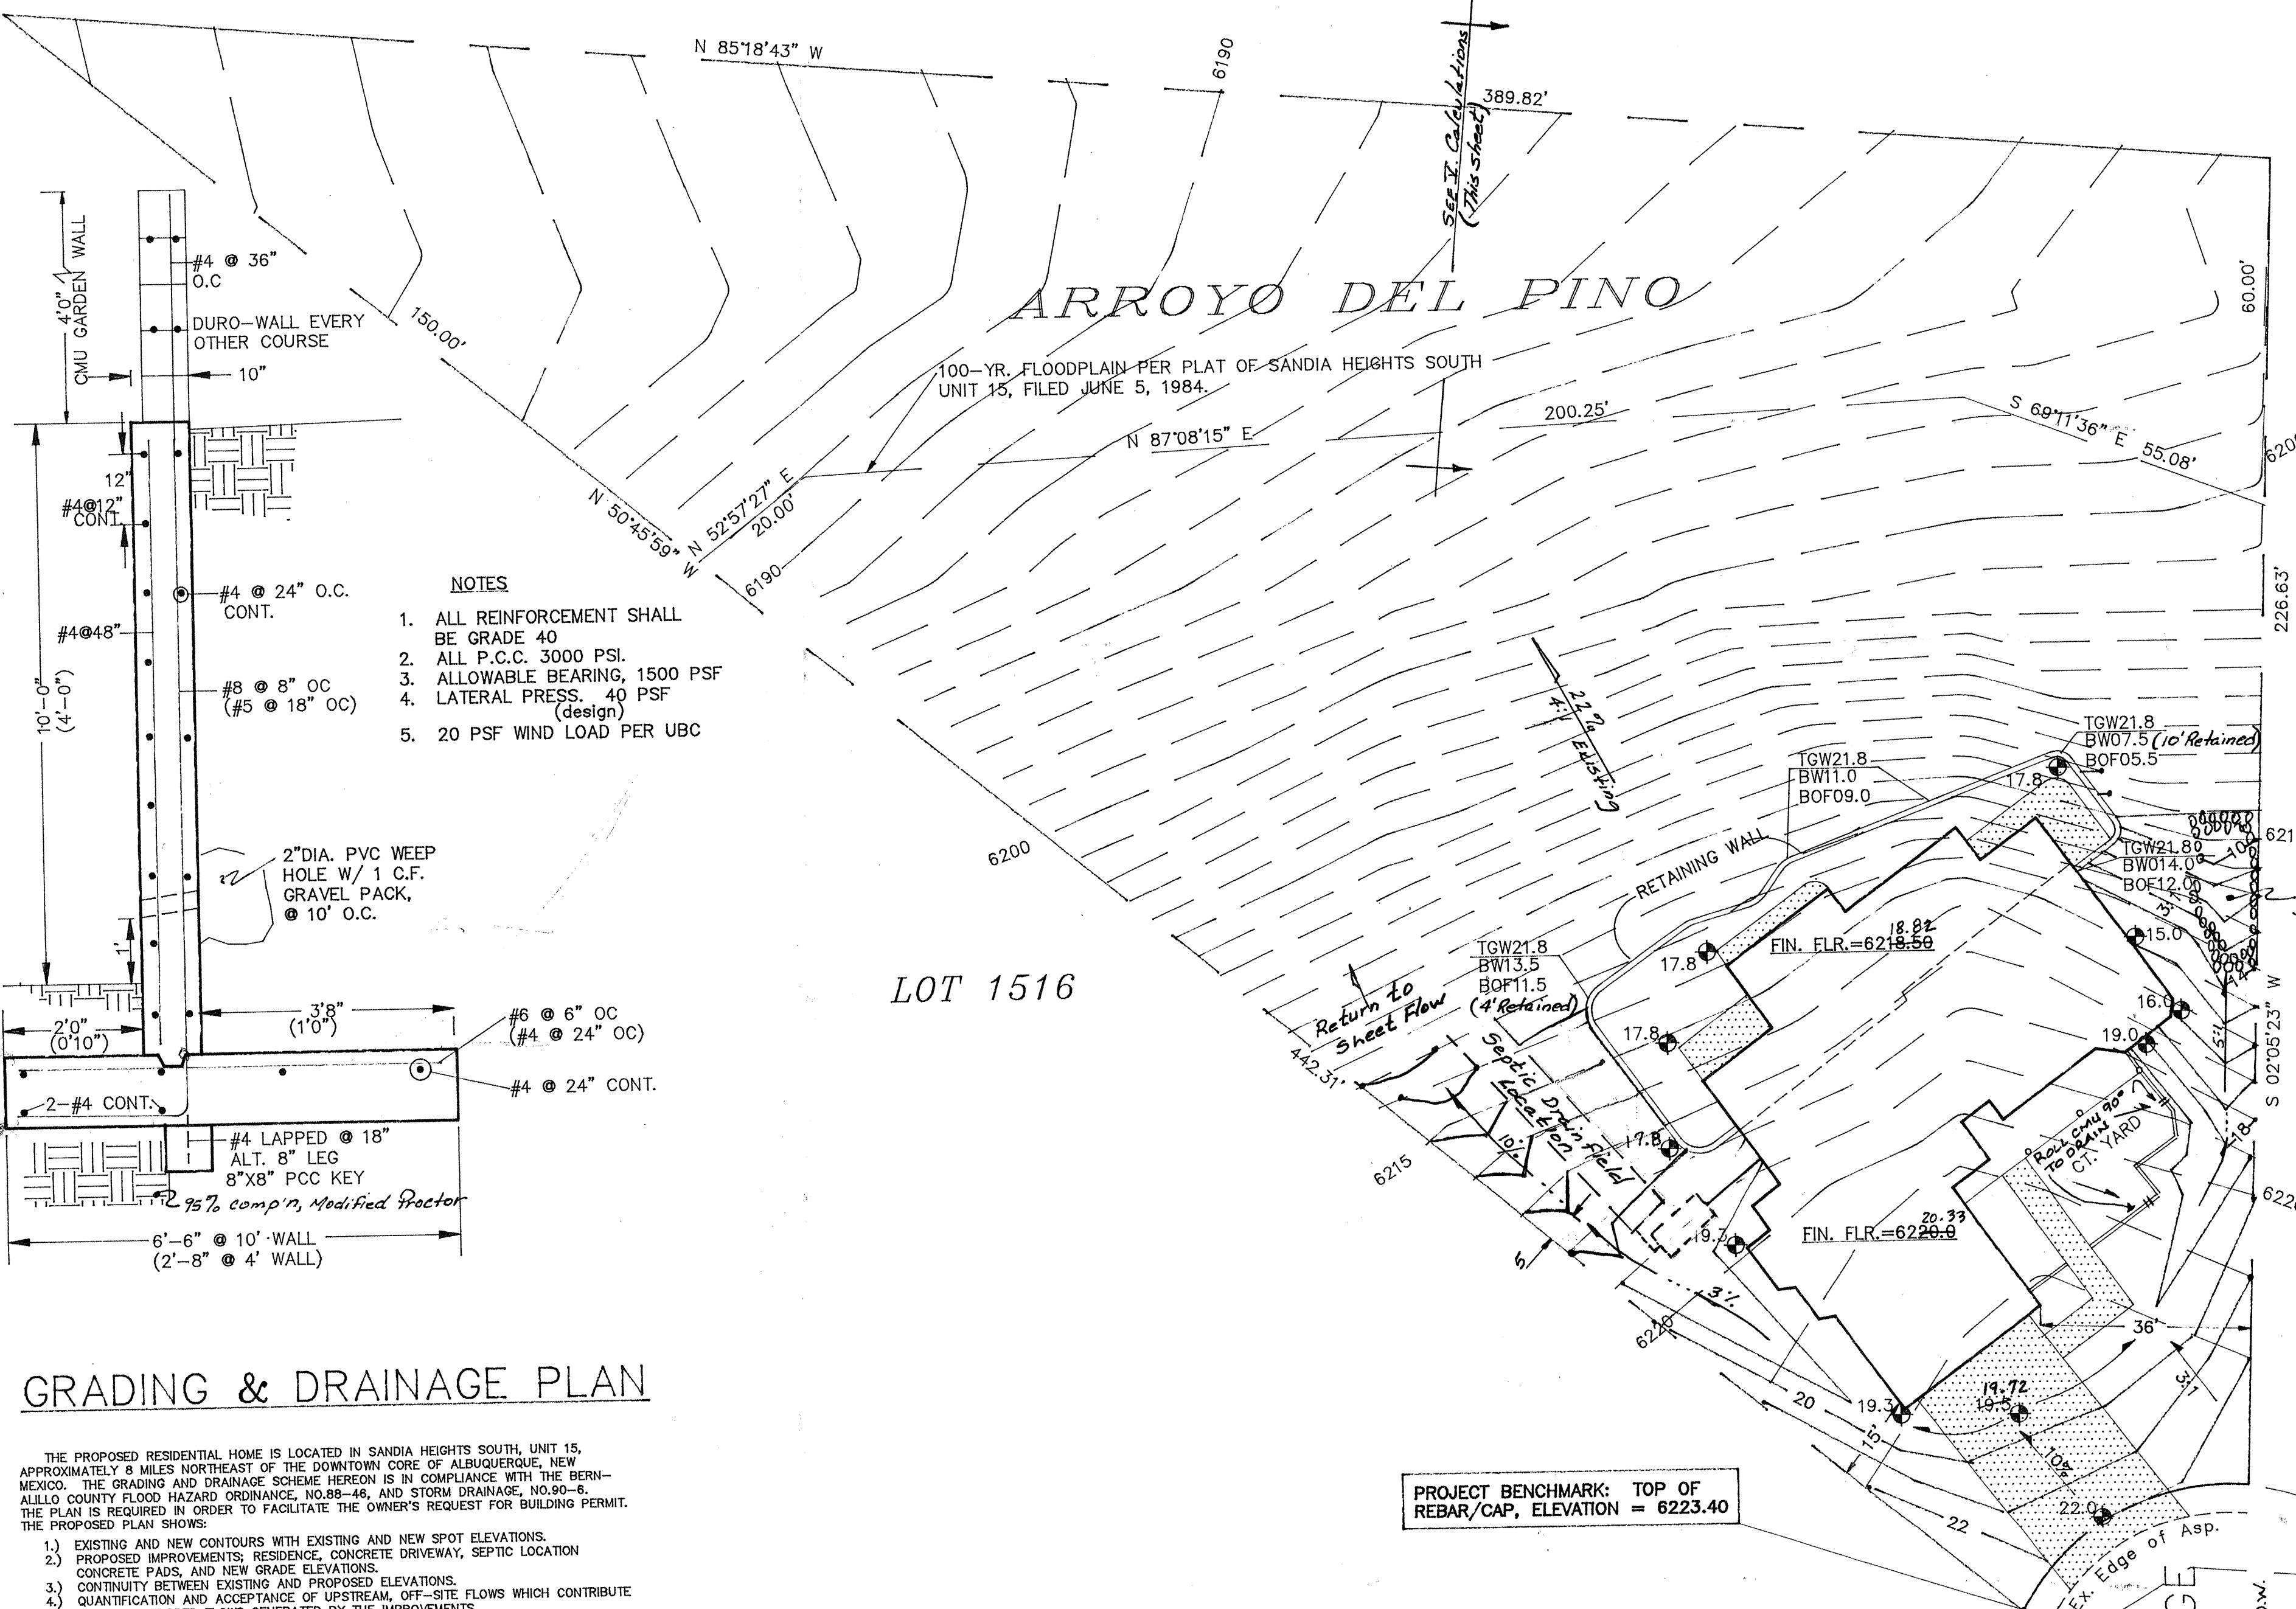

GRADING & DRAINAGE PLAN

THE PROPOSED RESIDENTIAL HOME IS LOCATED IN SANDIA HEIGHTS SOUTH, UNIT 15, APPROXIMATELY 8 MILES NORTHEAST OF THE DOWNTOWN CORE OF ALBUQUERQUE, NEW MEXICO. THE GRADING AND DRAINAGE SCHEME HEREON IS IN COMPLIANCE WITH THE BERNALILLO COUNTY FLOOD HAZARD ORDINANCE, NO.88-46, AND STORM DRAINAGE, NO.90-6. THE PLAN IS REQUIRED IN ORDER TO FACILITATE THE OWNER'S REQUEST FOR BUILDING PERMIT.

- 1) EXISTING AND NEW CONTOURS WITH EXISTING AND NEW SPOT ELEVATIONS.
- 2) PROPOSED IMPROVEMENTS: RESIDENCE, CONCRETE DRIVEWAY, SEPTIC LOCATION, CONCRETE PADS, AND NEW GRADE ELEVATIONS.
- 3) CONTINUITY BETWEEN EXISTING AND PROPOSED ELEVATIONS.
- 4) QUANTIFICATION AND ACCEPTANCE OF UPSTREAM, OFF-SITE FLOWS WHICH CONTRIBUTE TO THE DEVELOPED FLOWS GENERATED BY THE IMPROVEMENTS.

THE PURPOSE OF THE PLAN IS TO ESTABLISH CRITERIA FOR CONTROLLING STORM RUN-OFF GENERATED BY THE PROPOSED IMPROVEMENTS, ESSENTIALLY ALLOWING HISTORIC OFF-SITE AREAS TO DRAIN THROUGH THE PROPERTY AFTER DEVELOPMENT. THE PLAN DETERMINES THE RUN-OFF RESULTING FROM THE 100-YEAR/6-HOUR DURATION STORMS FOR BOTH THE EXISTING AND DEVELOPED CONDITIONS.


PRESENTLY, THE SITE IS BOUNDED ON THE EAST AND WEST BY DEVELOPED LOTS. PROPERTY IMMEDIATELY TO THE NORTH IS CURRENTLY DEVELOPED. EAGLE RIDGE TERRACE ON THE PROPERTY SOUTH FRONTAGE IS PRESENTLY A MAINTAINED AND IMPROVED COUNTY ROADWAY, SITUATED WITHIN A 40' RADIUS CUL-DE-SAC. THE SITE GENERALLY FALLS FROM THE SE TO NW AT AN AVERAGE OF 9 PERCENT. OFF-SITE DRAINAGE FLOWS ASSOCIATED WITH THE ARROYO DEL PINO ENTER THE SITE AT THE NORTHEAST PORTION OF THE PROPERTY. THESE OFF-SITE FLOWS ARE QUANTIFIED ON THE PLAN. THE LOT IS ENCOMBERED BY A DESIGNATED FEMA FLOOD PLAIN. SEE MAP, THIS SHEET.

HISTORICAL SITE RUN-OFF OUTFALL LOCATIONS WILL REMAIN UNCHANGED AND ALLOWED TO SHEET FLOW INTO THE PINO ARROYO AND CONVEYED OFF-SITE TO THE WEST. SINCE EAGLE RIDGE TERRACE IS IMPROVED NO GRADING IMPROVEMENTS ARE PROPOSED WITHIN THE RIGHT-OF-WAY. FREE DISCHARGE OF STORM RUN-OFF FROM THE SITE IS ACCEPTABLE SINCE THE PROJECT LAND USE INTENSITY IS APPROXIMATELY ONE (1) DWELLING UNIT PER ACRE, AND LOCATED WITHIN SANDIA HEIGHTS. HYDROLOGIC PROCEDURES AND CALCULATIONS ARE IN ACCORDANCE WITH SECTION 22.2, HYDROLOGY, OF THE DEVELOPMENT PROCESS MANUAL, VOLUME 2, DESIGN CRITERIA, REVISED JANUARY 1993, FOR THE CITY OF ALBUQUERQUE, NEW MEXICO, AND ADOPTED BY BERNALILLO COUNTY.

PROJECT BENCHMARK: TOP OF
REBAR/CAP, ELEVATION = 6223.40


I, PHILIP W. CLARK, A PROFESSIONAL ENGINEER LICENSED IN ACCORDANCE WITH THE LAWS OF THE STATE OF NEW MEXICO, DO HEREBY CERTIFY THAT I HAVE VISITED THE SITE SHOWN HEREON, AND THAT THE CONTOURS OF THE EXISTING GROUND CONDITIONS, AND DO FURTHER CERTIFY THAT NO EARTHWORK OF ANY KIND, NOR ANY DISTURBANCE OF THE EXISTING GROUND HAS OCCURRED ON THIS SITE SINCE THE CONTOURS WERE DETERMINED.

PHILIP W. CLARK

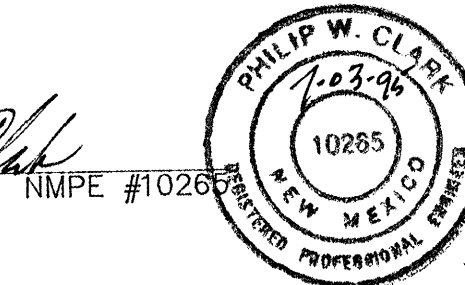

NMPE #10285

As-Constructed
Ref. Plan 95-134, D23/013/BP95-990
Grading & Fin. Flr. Elev. in Substantial
Compliance w/ Approved plan dated
7/16/95.

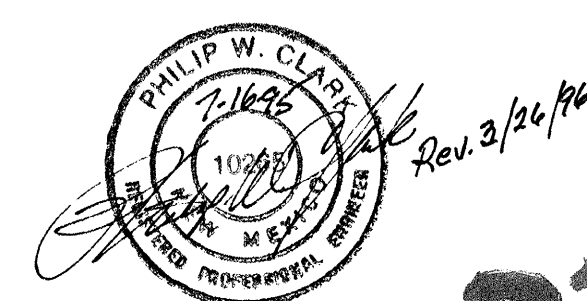

BP.95-990

Clark Consulting Engineers	
19 Ryan Road Edgewood, New Mexico 87015	
(505) 281-2444 FAX (505) 281-2444	
DATE	REVISION
3/26/96	Added
5/16/96	SEPTIC
	As-Built
DESIGNED BY: PVC	DRAWN BY: CCE
CHECKED BY: PVC	DATE: 7/14/95
JOB NO: JGREEN	
FILE NO: G&D	
SHEET NO: 1 of 1	