

CITY OF ALBUQUERQUE

Planning Department
Alan Varela, Interim Director



Mayor Timothy M. Keller

September 14, 2021

David Soule, PE
Rio Grande Engineering
1606 Central SE Suite 201
Albuquerque, NM 87106

**Re: Lot 7 Block 7 SAD 227
Volcano Cliffs Subdivision Unit 2
7911 Kibo St. NW
Grading and Drainage Plan
Engineers Stamp Date 3/12/2020 (E10D060)
Pad Certification Date 3/26/2020
CO Certification Dated: 9/13/2021**

PO Box 1293

Mr. Soule

Albuquerque

Based on the Certification received on 9/13/2021, the site is acceptable for release of Certificate of Occupancy by Hydrology.

NM 87103

If you have any questions, please contact me at 924-3986 or Rudy Rael at 924-3977.

Sincerely,

www.cabq.gov

Ernest Armijo, P.E.
Principal Engineer, Planning Dept.
Development Review Services



City of Albuquerque

Planning Department
Development & Building Services Division

DRAINAGE AND TRANSPORTATION INFORMATION SHEET (REV 6/2018)

Project Title: 7911 KIBO **Building Permit #:** _____ **Hydrology File #:** E10D060
DRB#: _____ **EPC#:** _____ **Work Order#:** _____
Legal Description: LOT 7 , BLOCK 7 VOLCANO CLIFFS UNIT 2
City Address: 7911 KIBO

Applicant: Phil Herrera **Contact:** _____
Address: _____
Phone#: _____ **Fax#:** _____ **E-mail:** _____

Other Contact: RIO GRANDE ENGINEERING **Contact:** DAVID SOULE
Address: PO BOX 93924 ALB NM 87199
Phone#: 505.321.9099 **Fax#:** 505.872.0999 **E-mail:** david@riograndeengineering.com

TYPE OF DEVELOPMENT: _____ PLAT ☒ RESIDENCE _____ DRB SITE _____ ADMIN SITE

Check all that Apply:

DEPARTMENT:

☒ HYDROLOGY/ DRAINAGE
_____ TRAFFIC/ TRANSPORTATION

TYPE OF SUBMITTAL:

☒ ENGINEER/ARCHITECT CERTIFICATION
_____ PAD CERTIFICATION
_____ CONCEPTUAL G & D PLAN
_____ GRADING PLAN
_____ DRAINAGE REPORT
_____ DRAINAGE MASTER PLAN
_____ FLOODPLAIN DEVELOPMENT PERMIT APPLIC
_____ ELEVATION CERTIFICATE
_____ CLOMR/LOMR
_____ TRAFFIC CIRCULATION LAYOUT (TCL)
_____ TRAFFIC IMPACT STUDY (TIS)
_____ STREET LIGHT LAYOUT
_____ OTHER (SPECIFY) _____
_____ PRE-DESIGN MEETING?

IS THIS A RESUBMITTAL?: ☒ Yes _____ No

TYPE OF APPROVAL/ACCEPTANCE SOUGHT:

_____ BUILDING PERMIT APPROVAL
☒ CERTIFICATE OF OCCUPANCY
_____ PRELIMINARY PLAT APPROVAL
_____ SITE PLAN FOR SUB'D APPROVAL
_____ SITE PLAN FOR BLDG. PERMIT APPROVAL
_____ FINAL PLAT APPROVAL
_____ SIA/ RELEASE OF FINANCIAL GUARANTEE
_____ FOUNDATION PERMIT APPROVAL
_____ GRADING PERMIT APPROVAL
_____ SO-19 APPROVAL
_____ PAVING PERMIT APPROVAL
_____ GRADING/ PAD CERTIFICATION
_____ WORK ORDER APPROVAL
_____ CLOMR/LOMR
_____ FLOODPLAIN DEVELOPMENT PERMIT
_____ OTHER (SPECIFY) _____

DATE SUBMITTED: _____ **By:** _____

COA STAFF:

ELECTRONIC SUBMITTAL RECEIVED: _____

FEE PAID: _____

Weighted E Method

Basin	Area (sq ft)	Area (acres)	Treatment A % (acres)	Treatment B % (acres)	Treatment C % (acres)	Treatment D % (acres)	Weighted E (ac-ft)	Volume (ac-ft)	Flow cfs	24 hour Volume (ac-ft)
ALLOWED	18212.00	0.348	0%	0	24% 0.084	40% 0.139	38% 0.126	1.268	0.037	1.12
PROPOSED	18212.00	0.348	0%	0	10% 0.035	30% 0.104	60% 0.210	1.248	0.045	1.29
COMPARISON								0.008		0.011

Equations:

Weighted E = $E_a A_a + E_b A_b + E_c A_c + E_d A_d$ / (Total Area)

Volume = Weighted E * Total Area

Flow = $Q_a A_a + Q_b A_b + Q_c A_c + Q_d A_d$

Where for 100-year, 6-hour storm zone 1

$E_a = 0.44$ $Q_a = 1.28$
 $E_b = 0.67$ $Q_b = 2.03$
 $E_c = 0.99$ $Q_c = 2.87$
 $E_d = 1.97$ $Q_d = 4.37$

ONSITE Conditions

FIRST FLUSH WATER QUALITY VOLUME

	REQUIRED (CF)	PROVIDED (CF)
WATER QUALITY	0	502
FLOOD CONTROL	495	502


Narrative

This site is within the SAD 228 Master Drainage plan boundaries. The site is to maintain existing patterns and drain as much as possible to the adjacent roadway to the south per the master drainage plan. The site exceeds the SAD 227 developed conditions assumptions, there for shall retain the excess flow of 495 cf. We are ponding the water harvest volume generated by the site there is not measurable upland flow. This plan is in conformance to the master drainage plan.

I David Soule, NMPE 14522, of the firm Rio Grande Engineering, hereby certify that this project has been graded and will drain in substantial compliance with and in accordance with the design intend of the approved plan dated 3/12/20. The record information edited on the original design document has performed by me or under my direct supervision and is true and correct to the best of my knowledge and belief. The as-built survey was provided by THOMAS PATRICK NMPS 12651. The certification is submitted in support of a request for PERMANENT CERTIFICATE OF OCCUPANCY. The record information presented heron is not necessarily complete and intended only to verify substantial compliance of the grading and drainage aspects of this project. Those relying on this record document are advised to obtain independent verification of its accuracy before using it for any other purpose



9/13/21

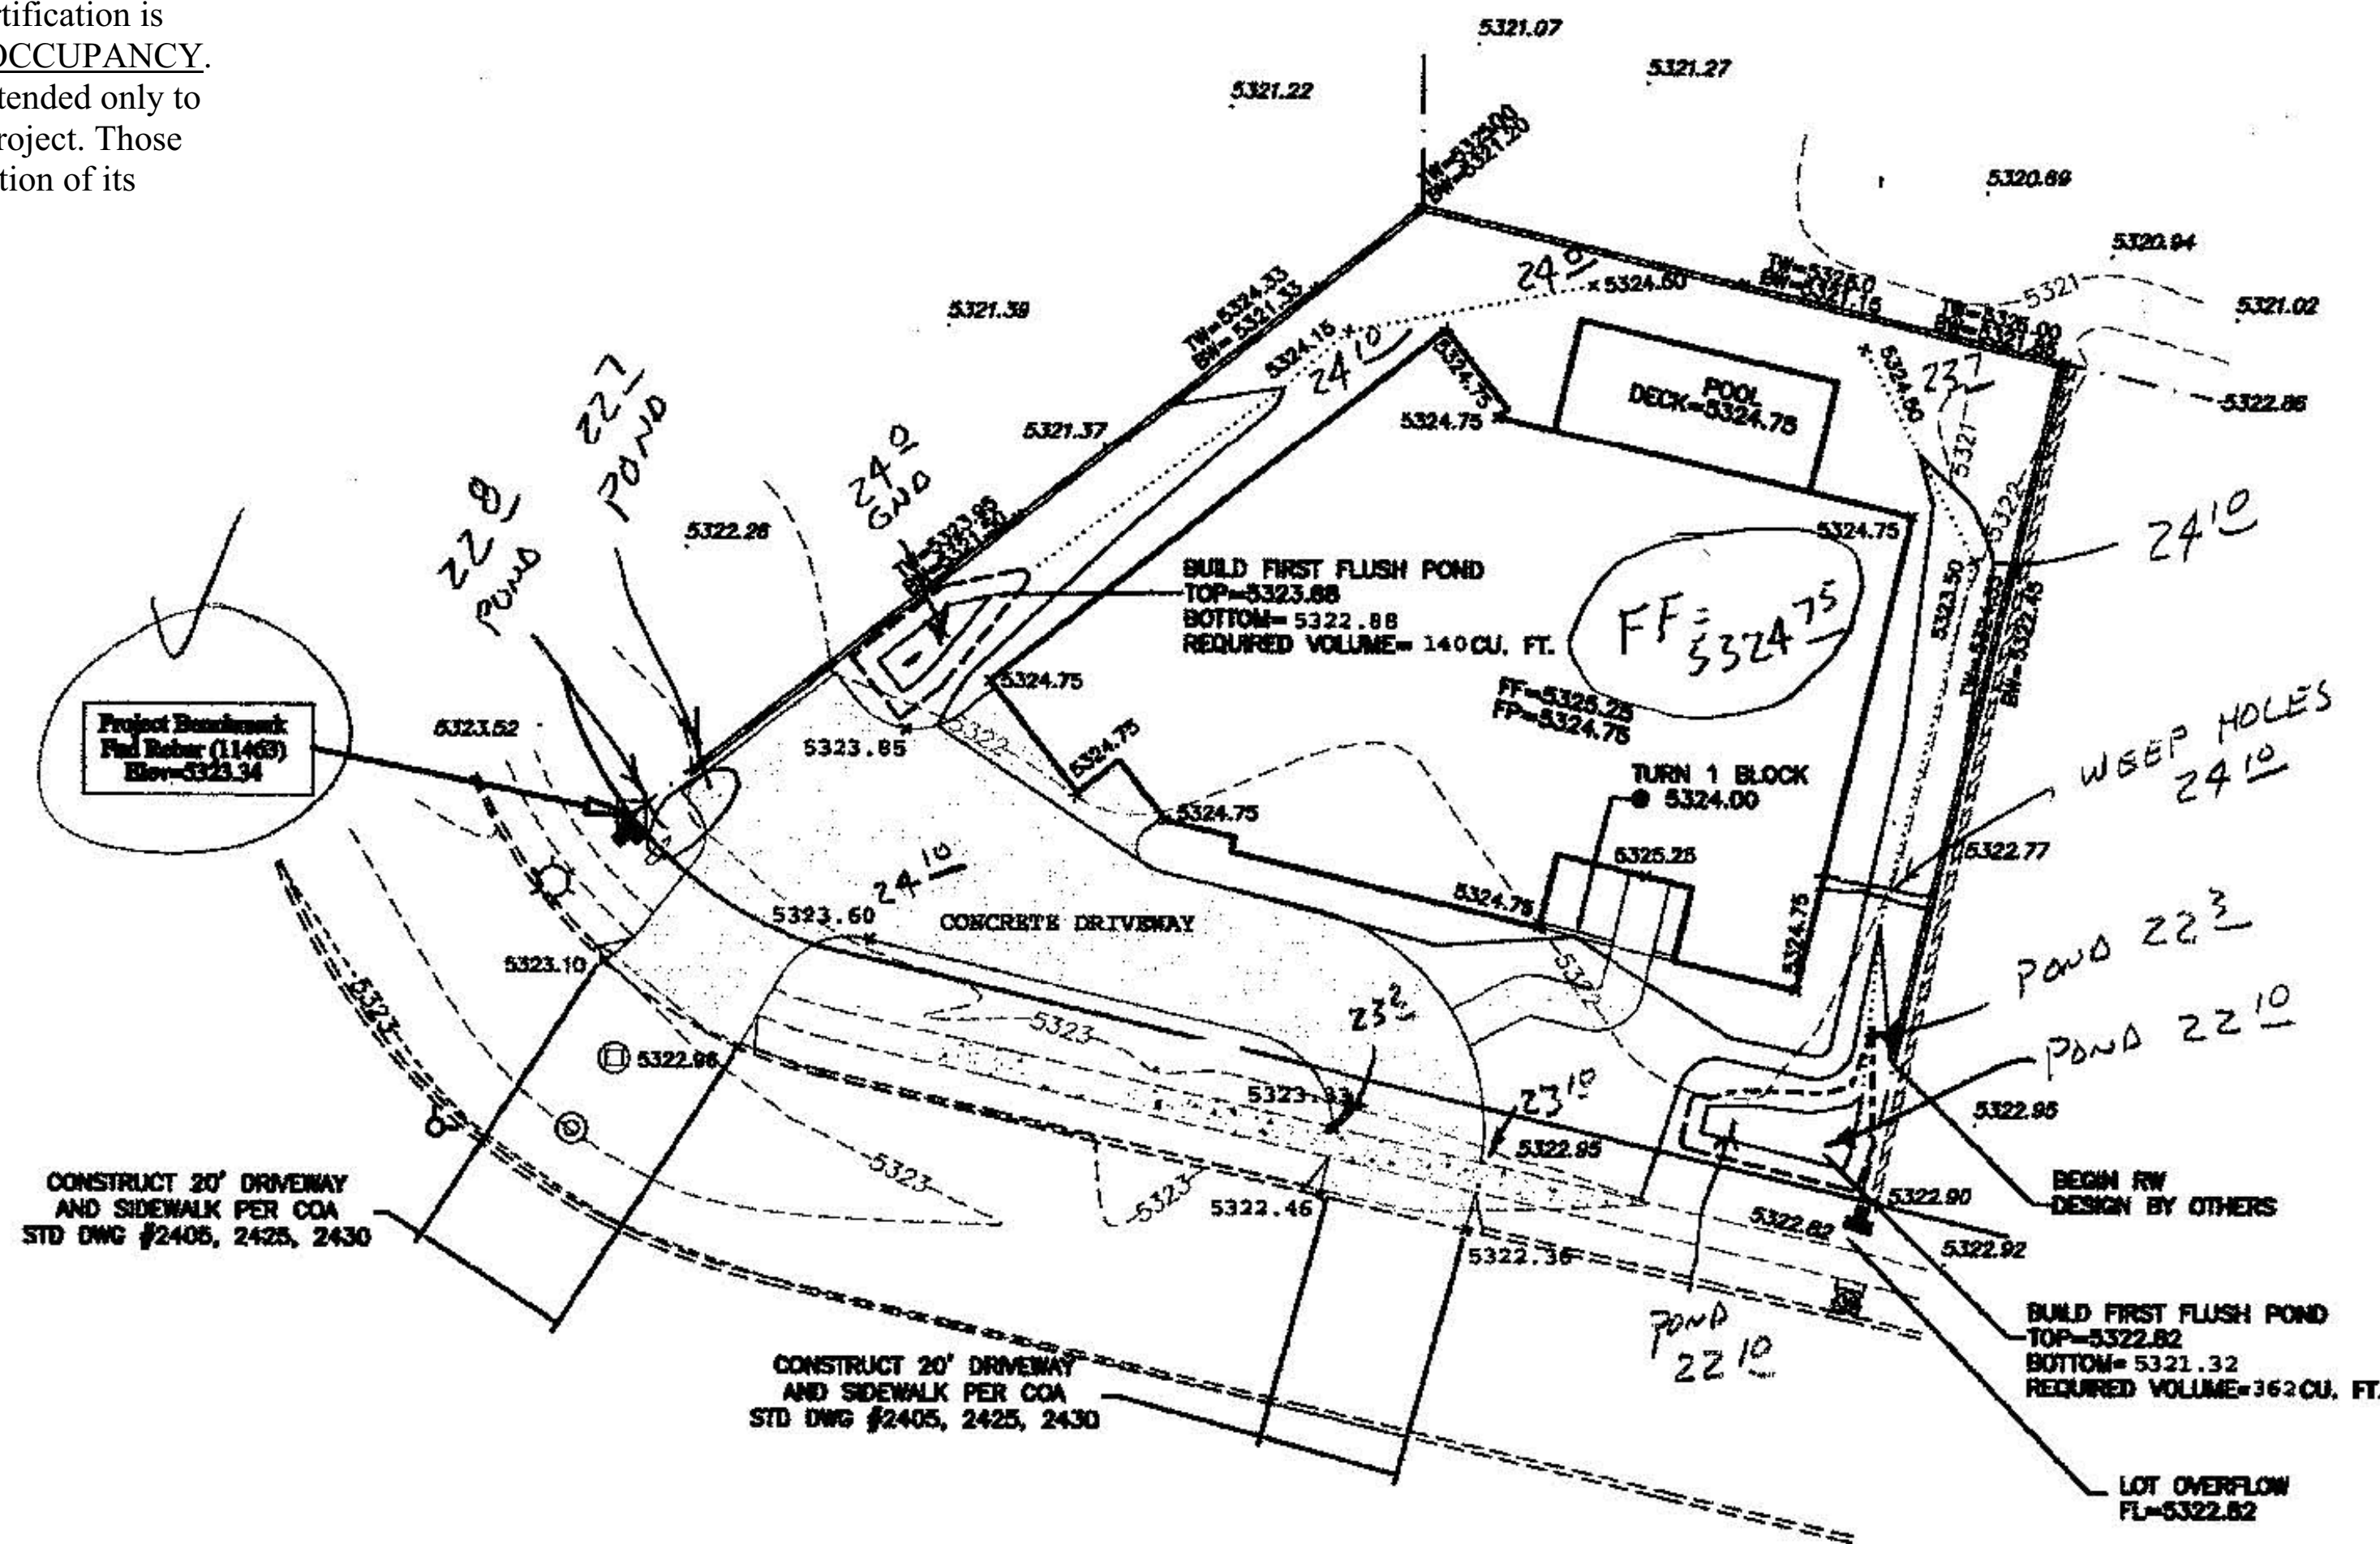

AS-BUILT ELEVATIONS TAKEN
 BY BFC LAYOUT SERVICES
 ON 9/9/2021
Chad Blum

CAUTION:
 EXISTING UTILITIES ARE NOT SHOWN.
 IT SHALL BE THE SOLE RESPONSIBILITY
 OF THE CONTRACTOR TO CONDUCT ALL
 NECESSARY FIELD INVESTIGATIONS PRIOR
 TO ANY EXCAVATION TO DETERMINE THE
 ACTUAL LOCATION OF UTILITIES & OTHER
 IMPROVEMENTS.


I, DAVID SOULE HAVE PERSONALLY INSPECTED THE SITE. I HEREBY
 CERTIFY THE PAD HAS BEEN CONSTRUCTED SUCH THAT IT IS IN
 SUBSTANTIAL CONFORMANCE TO THE APPROVED GRADING PLAN DATED 3/12/20




3/26/20

EROSION CONTROL NOTES:

1. CONTRACTOR IS RESPONSIBLE FOR OBTAINING A TOPSOIL DISTURBANCE PERMIT PRIOR TO BEGINNING WORK.
2. CONTRACTOR IS RESPONSIBLE FOR MAINTAINING RUN-OFF ON SITE DURING CONSTRUCTION.
3. CONTRACTOR IS RESPONSIBLE FOR CLEANING ALL SEDIMENT THAT GETS INTO EXISTING RIGHT-OF-WAY.
4. REPAIR OF DAMAGED FACILITIES AND CLEANUP OF SEDIMENT ACCUMULATIONS ON ADJACENT PROPERTIES AND IN PUBLIC FACILITIES IS THE RESPONSIBILITY OF THE CONTRACTOR.
5. ALL EXPOSED EARTH SURFACES MUST BE PROTECTED FROM WIND AND WATER EROSION PRIOR TO FINAL ACCEPTANCE OF ANY PROJECT.

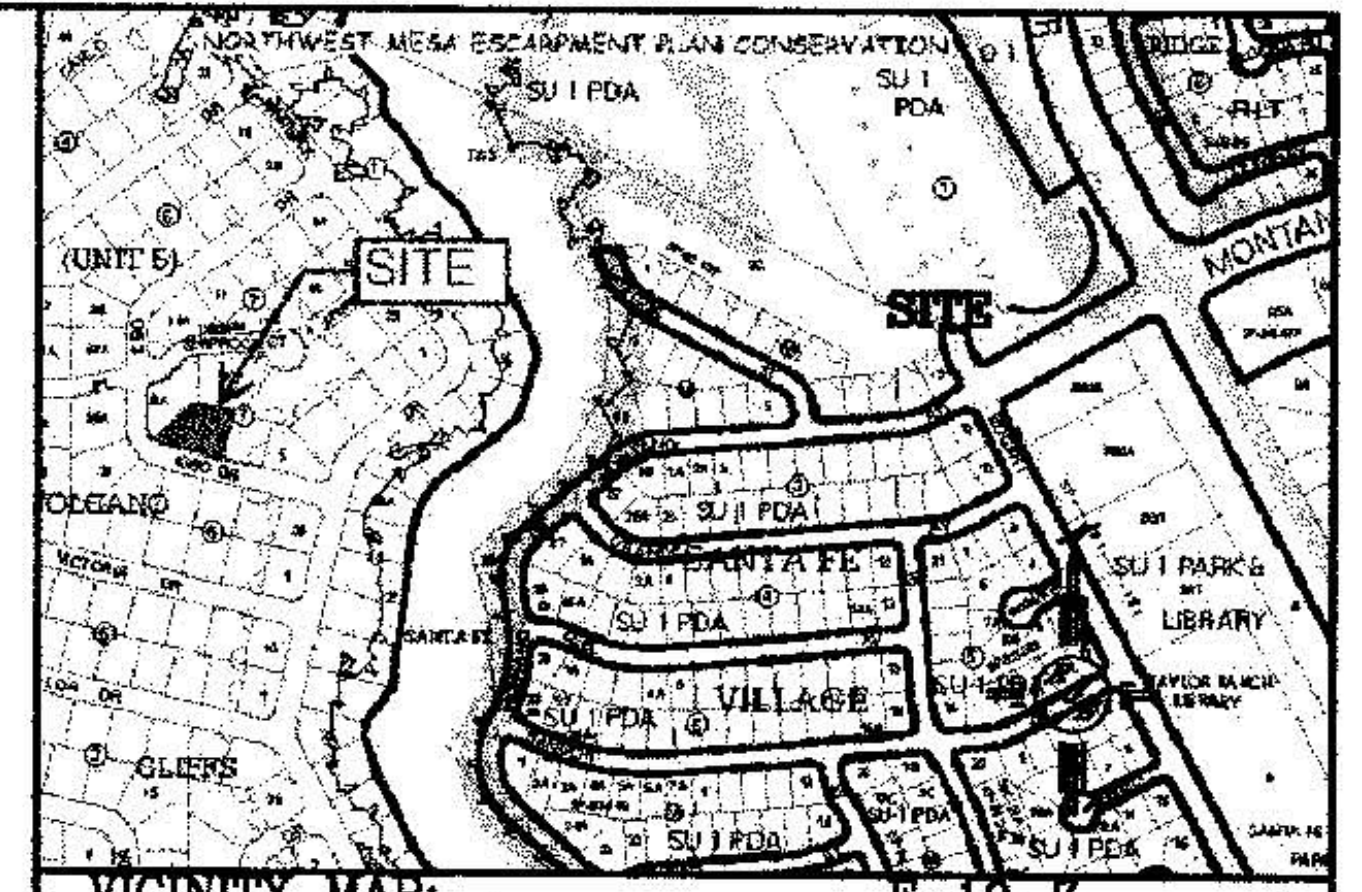

VICINITY MAP:

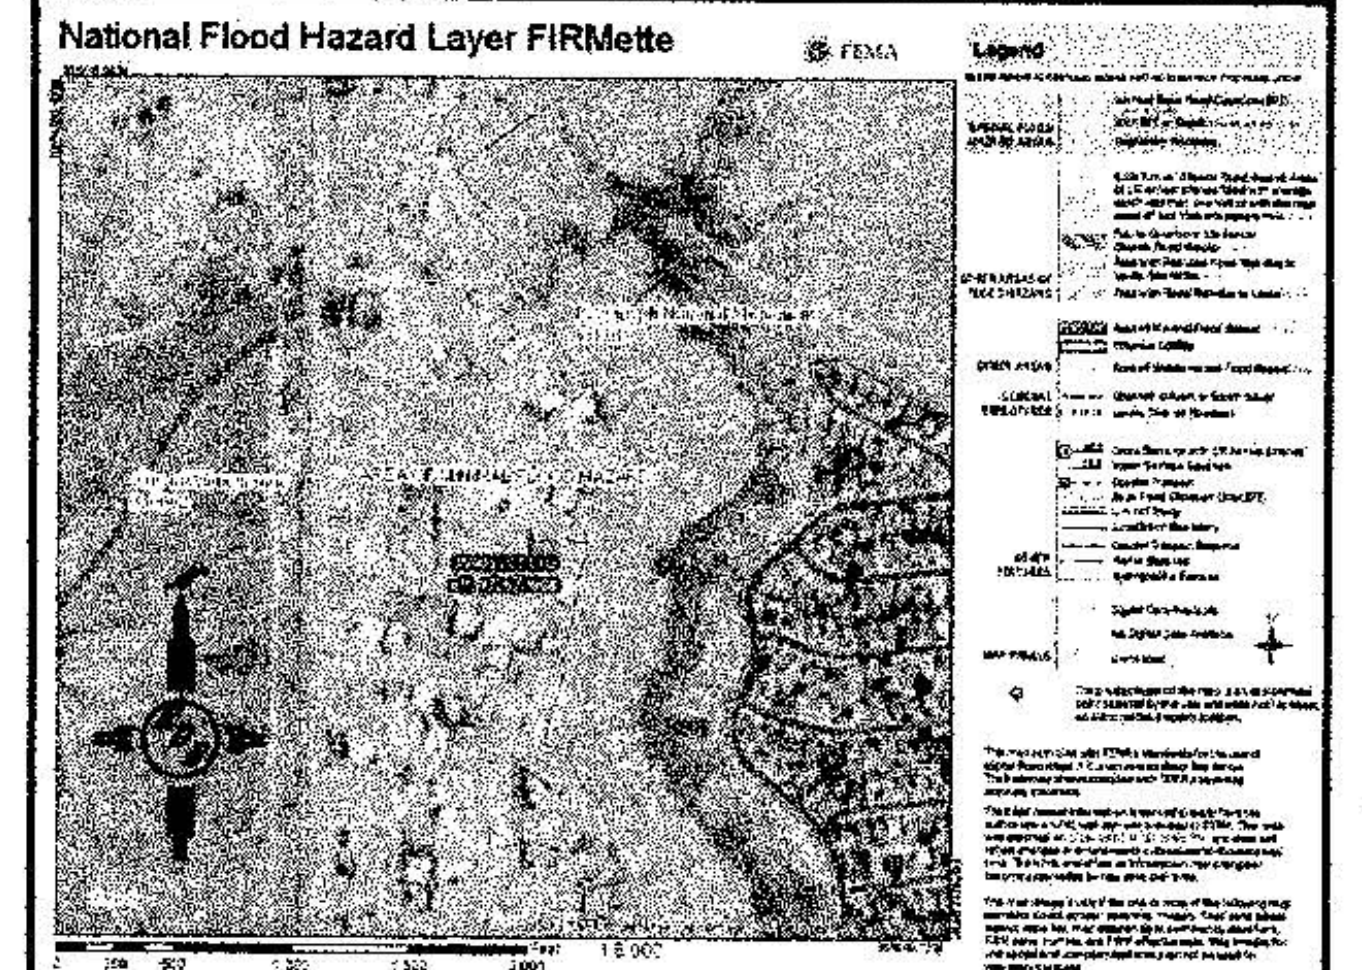

FIRM MAP:

LEGAL DESCRIPTION:


Lot 7, Block 7, Volcano CREE Subdivision Unit 2

NOTES:

1. ALL SPOT ELEVATIONS REPRESENT FLOWLINE ELEVATION UNLESS OTHERWISE NOTED.
2. ALL SLOPES SHALL BE 3:1 MAX. AND GRAVEL OR NATIVE SEEDING PRIOR TO CO.

LEGEND

---	EXISTING CONTOUR
----	EXISTING INDEX CONTOUR
----	PROPOSED CONTOUR
----	PROPOSED INDEX CONTOUR
---	SLOPE TIE
•	EXISTING SPOT ELEVATION
•	PROPOSED SPOT ELEVATION
---	BOUNDARY
---	CENTERLINE
---	RIGHT-OF-WAY
=====	EXISTING CURB AND GUTTER
=====	PROPOSED CMU SCREEN WALL (12" MAX. RETAINAGE)
=====	PROPOSED RETAINING WALL-DESIGN BY OTHERS

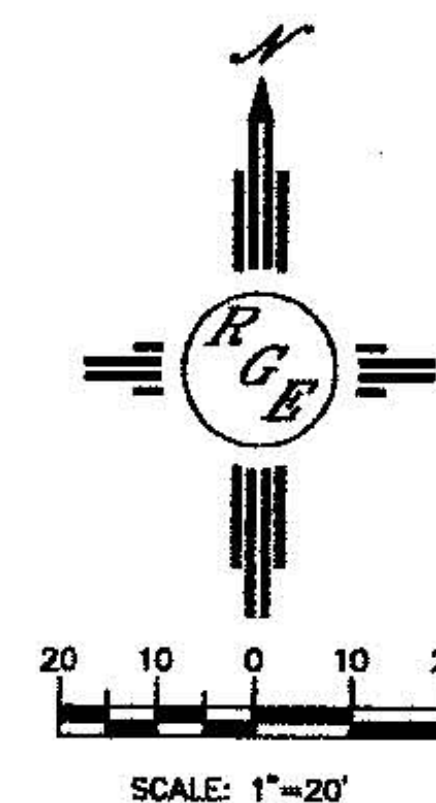

ENGINEER'S SEAL	7911 KIBO	DRAWN BY WCMJ
DAVID SOULE NMPE 14522 NEW MEXICO	GRADING AND DRAINAGE PLAN	DATE 3-12-20
3/12/20	Rio Grande Engineering 1600 CENTRAL AVENUE SE SUITE 201 ALBUQUERQUE, NM 87106 (505) 871-0980	2109027-10001-3-20-18
DAVID SOULE P.E. #14522		SHEET #
		JOB # 2109027