

CITY OF ALBUQUERQUE

Planning Department
Alan Varela, Interim Director



Mayor Timothy M. Keller

August 9, 2022

David Soule, P.E.
Rio Grande Engineering
PO Box 93924
Albuquerque, New Mexico 87199

**Re: Lot 1 Block 8 SAD 227 Unit 5
7924 Victoria NW
Grading and Drainage Plan
Engineers Stamp Date 7/30/2021 (E10D105)
CO Certification Dated: 7/1/2022**

PO Box 1293

Mr. Soule

Albuquerque

Based on the Certification received on 8/8/2022, the site is acceptable for release of Certificate of Occupancy by Hydrology.

NM 87103

Sincerely,

www.cabq.gov

Shahab Biazar, P.E.
City Engineer, Planning
Development Review Services

RR/SB
C: File E10D105



City of Albuquerque

Planning Department
Development & Building Services Division

DRAINAGE AND TRANSPORTATION INFORMATION SHEET (REV 6/2018)

Project Title: 7924 Victoria NW **Building Permit #:** _____ **Hydrology File #:** _____
DRB#: _____ **EPC#:** _____ **Work Order#:** _____
Legal Description: LOT 16 BLOCK 5 VOLCANO CLIFFS UNIT 2
City Address: 7924 Victoria NW

Applicant: DR HORTON **Contact:** _____
Address: _____
Phone#: _____ **Fax#:** _____ **E-mail:** _____

Other Contact: RIO GRANDE ENGINEERING **Contact:** DAVID SOULE
Address: PO BOX 93924 ALB NM 87199
Phone#: 505.321.9099 **Fax#:** 505.872.0999 **E-mail:** david@riograndeengineering.com

TYPE OF DEVELOPMENT: _____ PLAT ☒ RESIDENCE _____ DRB SITE _____ ADMIN SITE

Check all that Apply:

DEPARTMENT:
☒ HYDROLOGY/ DRAINAGE
_____ TRAFFIC/ TRANSPORTATION

TYPE OF SUBMITTAL:
☒ ENGINEER/ARCHITECT CERTIFICATION
_____ PAD CERTIFICATION
_____ CONCEPTUAL G & D PLAN
_____ GRADING PLAN
_____ DRAINAGE REPORT
_____ DRAINAGE MASTER PLAN
_____ FLOODPLAIN DEVELOPMENT PERMIT APPLIC
_____ ELEVATION CERTIFICATE
_____ CLOMR/LOMR
_____ TRAFFIC CIRCULATION LAYOUT (TCL)
_____ TRAFFIC IMPACT STUDY (TIS)
_____ STREET LIGHT LAYOUT
_____ OTHER (SPECIFY) _____
_____ PRE-DESIGN MEETING?

IS THIS A RESUBMITTAL?: ☒ Yes _____ No

TYPE OF APPROVAL/ACCEPTANCE SOUGHT:

_____ BUILDING PERMIT APPROVAL
☒ CERTIFICATE OF OCCUPANCY
_____ PRELIMINARY PLAT APPROVAL
_____ SITE PLAN FOR SUB'D APPROVAL
_____ SITE PLAN FOR BLDG. PERMIT APPROVAL
_____ FINAL PLAT APPROVAL
_____ SIA/ RELEASE OF FINANCIAL GUARANTEE
_____ FOUNDATION PERMIT APPROVAL
_____ GRADING PERMIT APPROVAL
_____ SO-19 APPROVAL
_____ PAVING PERMIT APPROVAL
_____ GRADING/ PAD CERTIFICATION
_____ WORK ORDER APPROVAL
_____ CLOMR/LOMR
_____ FLOODPLAIN DEVELOPMENT PERMIT
_____ OTHER (SPECIFY) _____

DATE SUBMITTED: _____ **By:** _____

COA STAFF:

ELECTRONIC SUBMITTAL RECEIVED: _____

FEE PAID: _____

Weighted E Method

Basin	Area (sf)	Area (acres)	Treatment A %	Treatment B (acres)	Treatment C (acres)	Treatment D (acres)	100-Year, 6-hr.			24 hour Volume (ac-ft)
							Weighted E (ac-ft)	Volume (ac-ft)	Flow cfs	
ALLOWED PROPOSED	11525.00	0.265	0%	0	20% 0.053	46% 0.1217	34% 0.090	1.259	0.028	0.85
REAR SUB BASIN COMPARISON	2664.00	0.061	0%	0	20% 0.053	39% 0.1032	41% 0.108	1.328	0.029	0.59
					30% 0.018	70% 0.0428	0% 0.000	0.894	0.005	0.16
								0.002		-0.002

Equations:

Weighted E = Ea*Aa + Eb*Ab + Ec*Ac + Ed*Ad / (Total Area)

Volume = Weighted D * Total Area

Flow = Qa * Aa + Qb * Ab + Qc * Ac + Qd * Ad

Where for 100-year, 6-hour storm- zone 1

Ea= 0.44
Eb= 0.67
Ec= 0.99
Ed= 1.97

Qa= 1.29
Qb= 2.03
Qc= 2.87
Qd= 4.37

ONSITE Conditions
DRAINAGE SUMMARY



	REQUIRED (CF)	PROVIDED (CF)
WATER QUALITY	0	814
FLOOD CONTROL(ENTIRELOT)	66	814
FLOOD CONTROL(REARONLY)	198	814
Narrative		

This site is within the SAD 227 Master Drainage plan boundaries. The site is to maintain existing patterns and drain to the roadway to the north per the master drainage plan. The site does exceed the SAD 228 developed conditions assumptions, therefore ponding of 66 cfs is required. Due to existing rear grades being lower than street the rear yard will retain the entire 198 cf generated. existing wall appears to prevent cross lot drainage, any flow from the upland north is allowed to enter and pass across site to west. This plan is in conformance to the master drainage plan

I David Soule, NMPE 14522, of the firm Rio Grande Engineering, hereby certify that this project has been graded and will drain in substantial compliance with and in accordance with the design intend of the approved plan dated 7/30/21. The record information edited on the original design document has performed by me or under my direct supervision and is true and correct to the best of my knowledge and belief. The as-built survey was provided by THOMAS PATRICK NMPS 12651. The certification is submitted in support of a request for PERMANENT CERTIFICATE OF OCCUPANCY. The record information presented heron is not necessarily complete and intended only to verify substantial compliance of the grading and drainage aspects of this project. Those relying on this record document are advised to obtain independent verification of its accuracy before using it for any other purpose





7/1/22

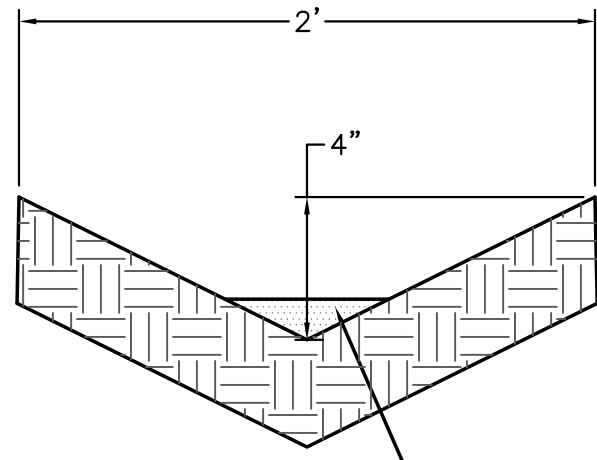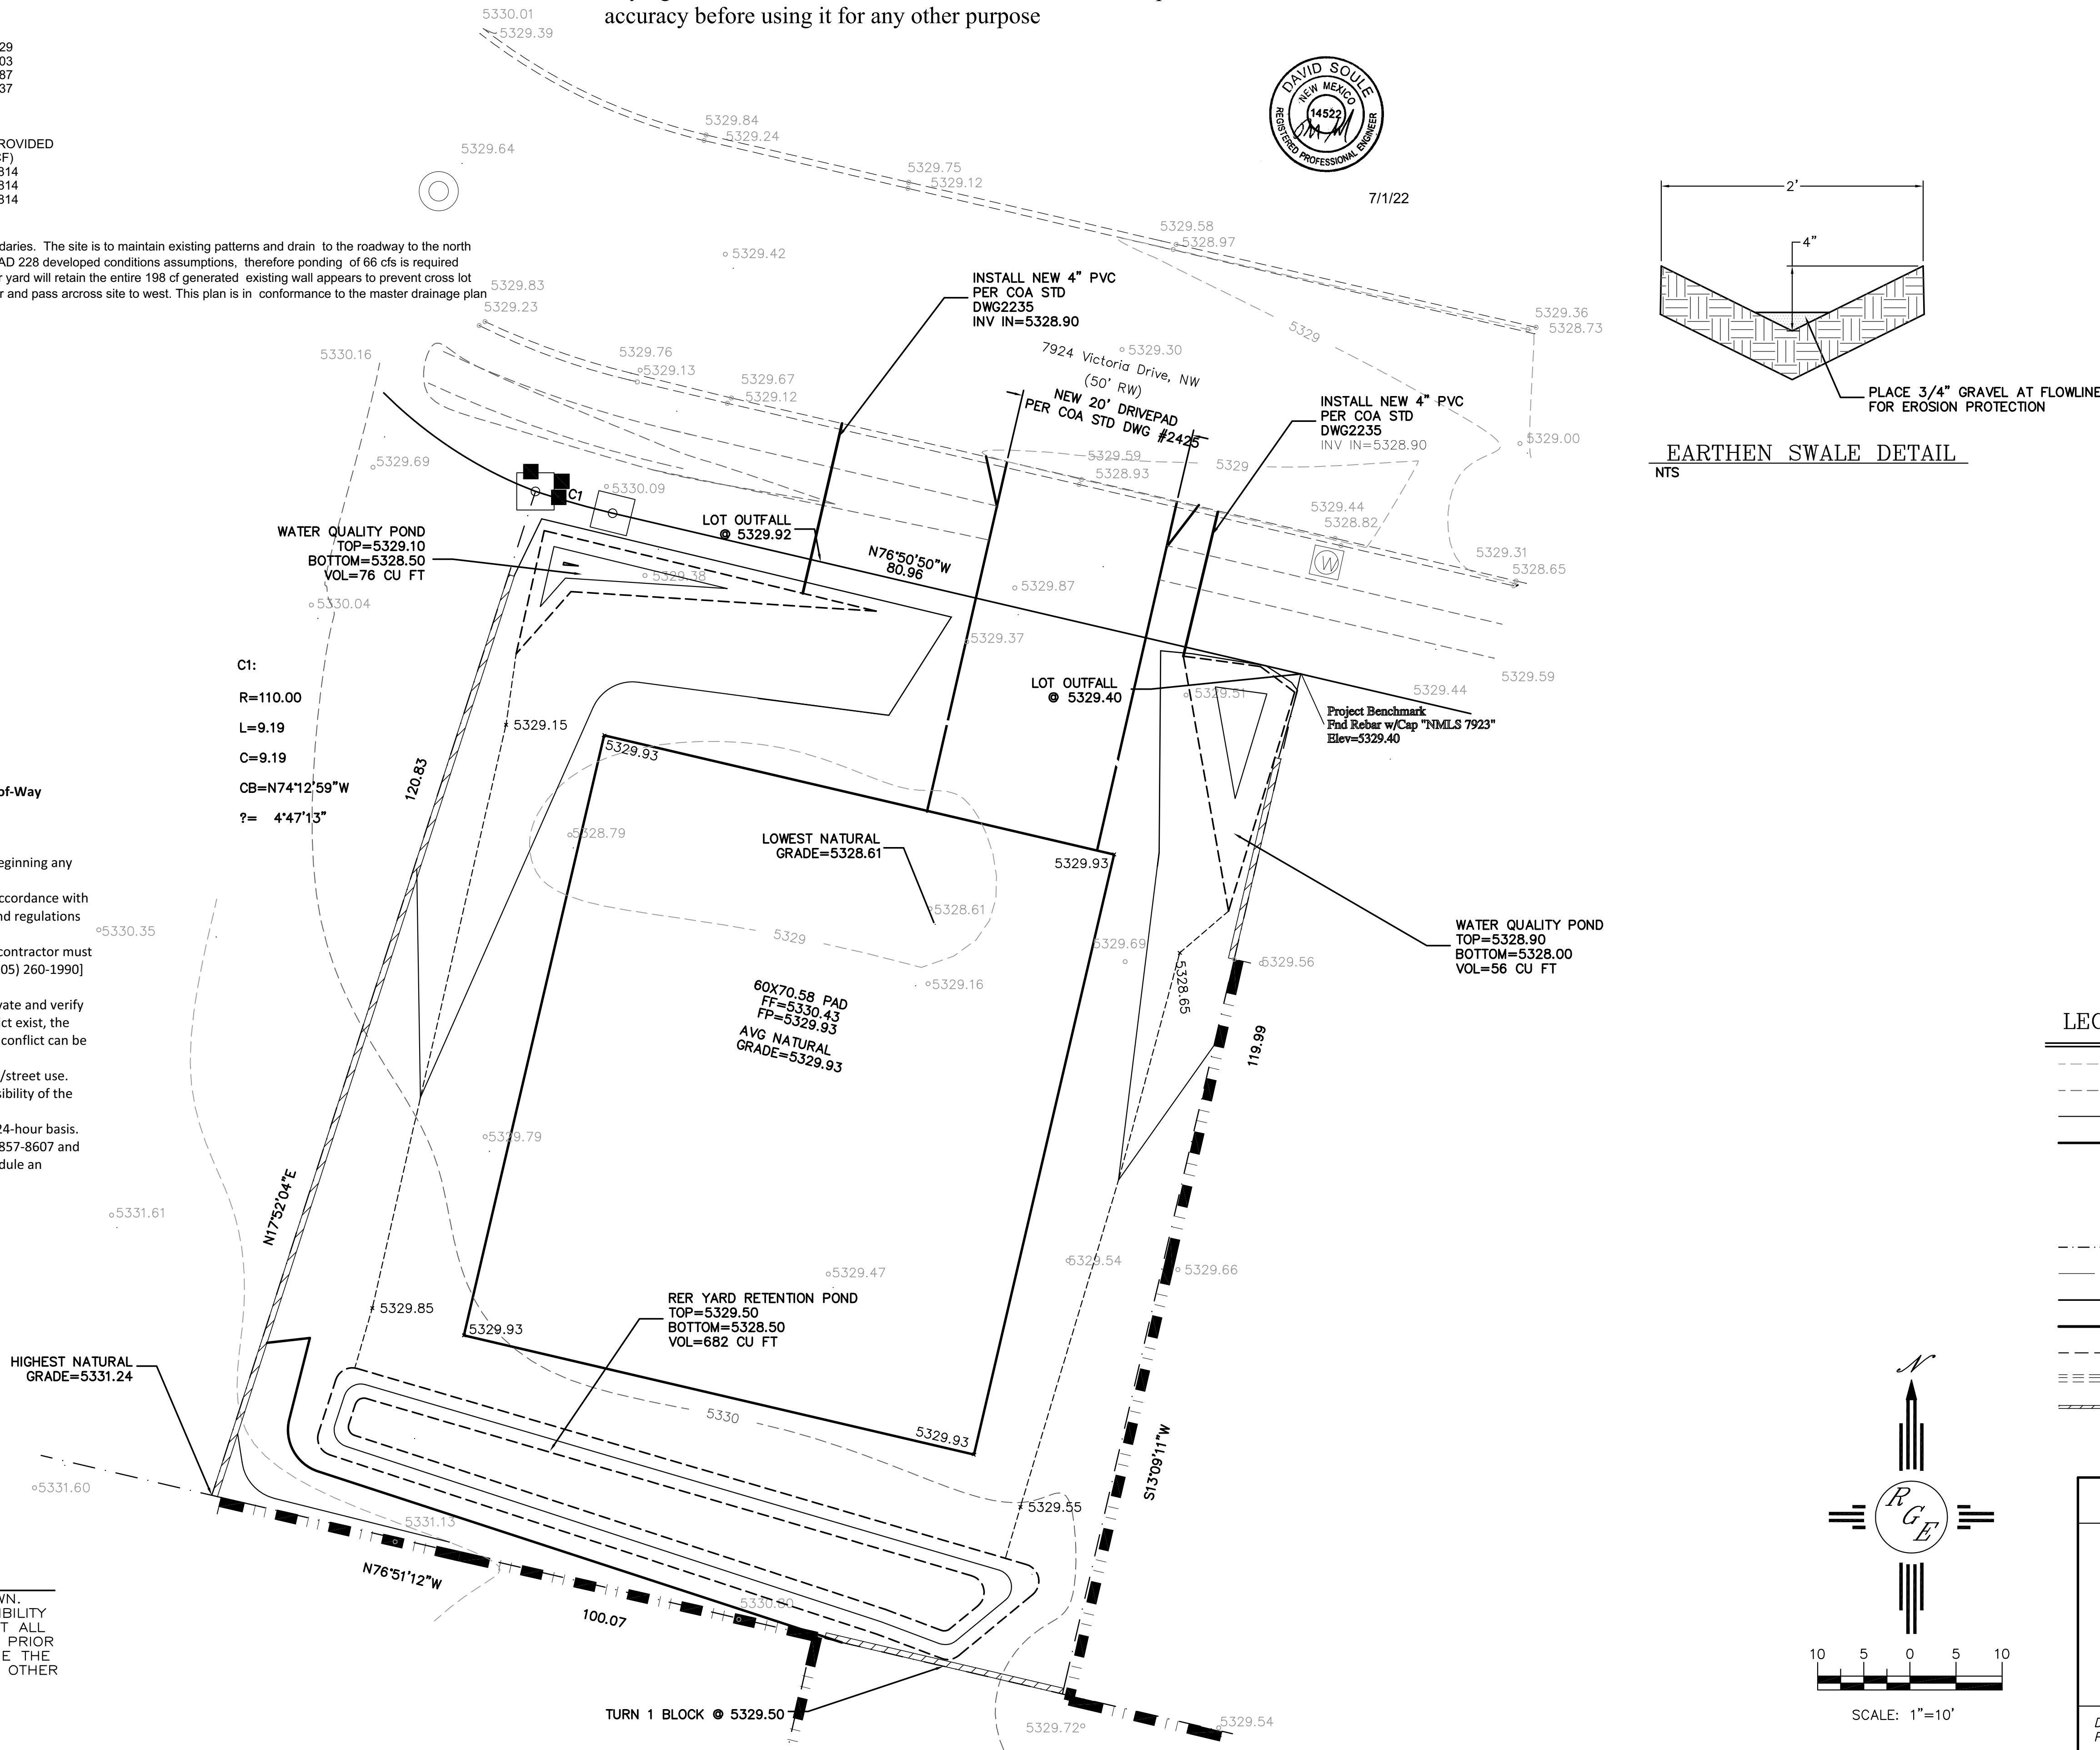

EARTHEN SWALE DETAIL

NTS

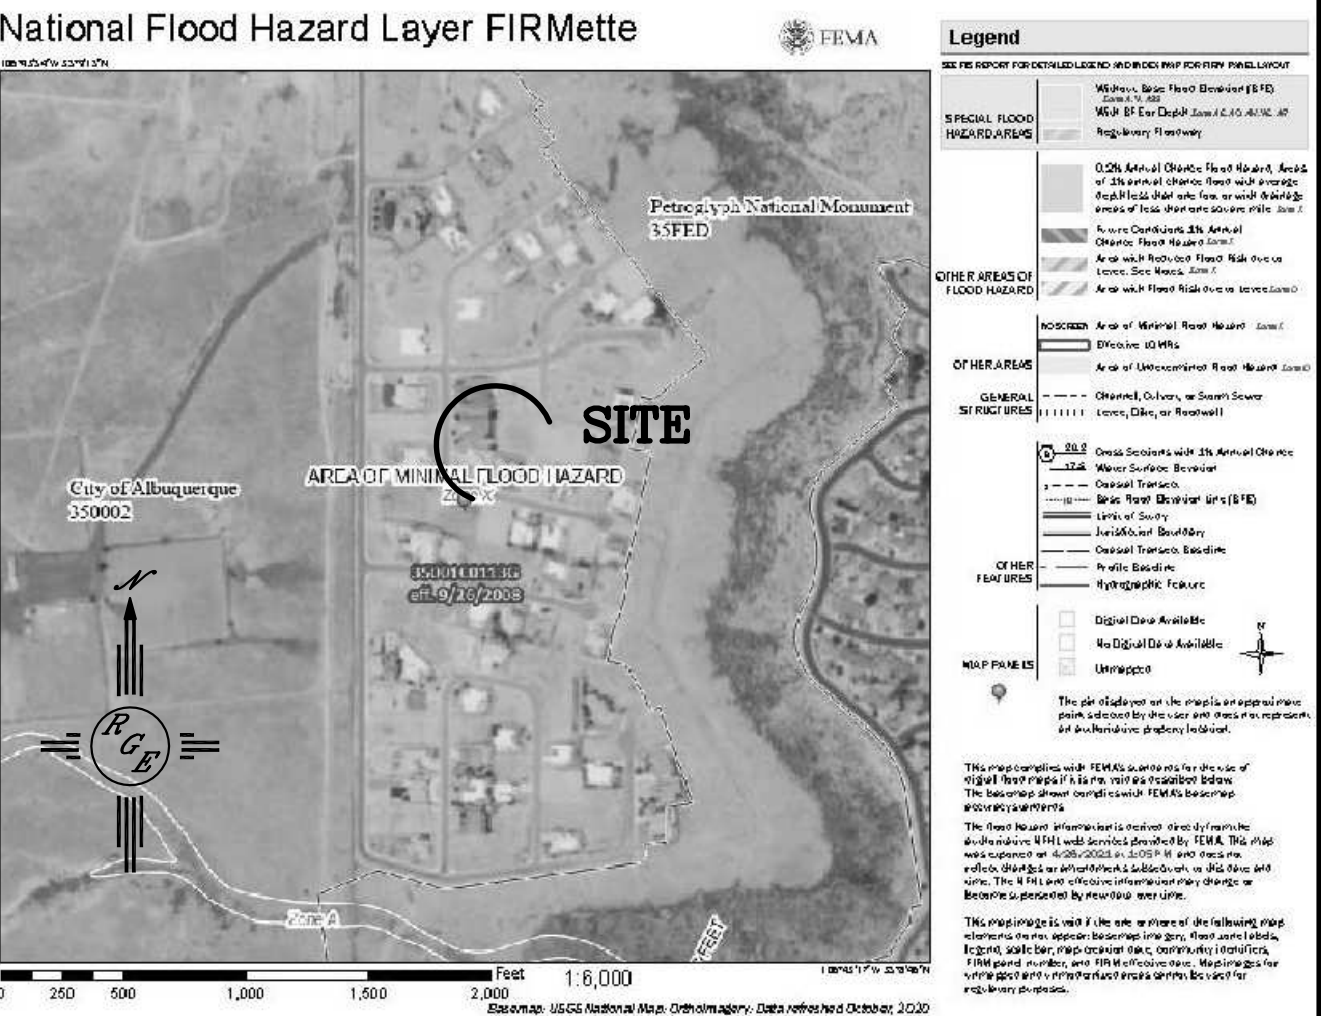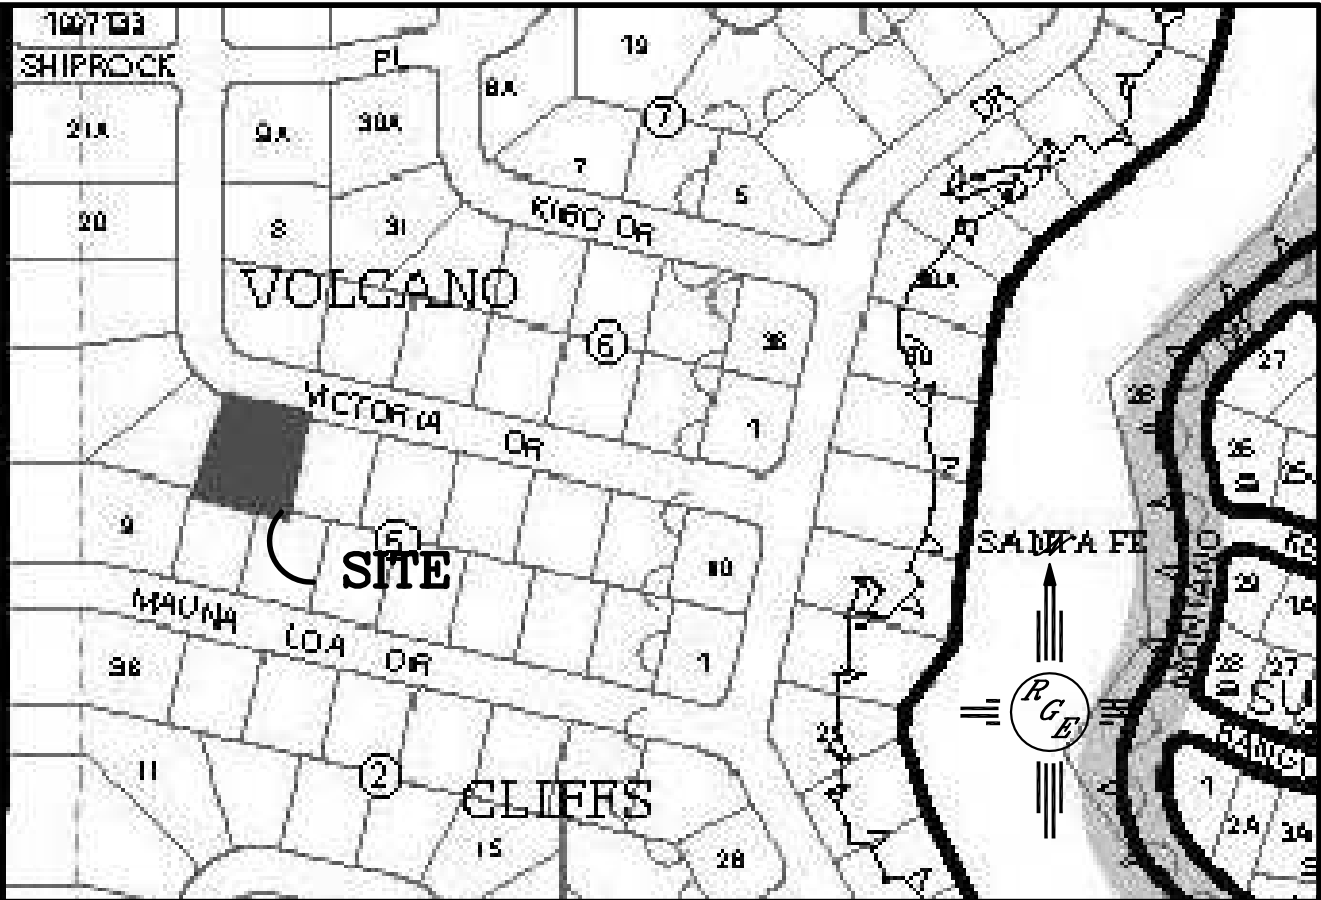

LEGAL DESCRIPTION:


Lot 16, Block 5, Volcano Cliffs Subdivision, Unit 2

NOTES:

- ALL SPOT ELEVATIONS REPRESENT FLOWLINE ELEVATION UNLESS OTHERWISE NOTED.
- ALL SLOPES SHALL BE 3:1 MAX. AND GRAVEL OR NATIVE SEEDING PRIOR TO CO.

LEGEND

---	EXISTING CONTOUR
- - - -	EXISTING INDEX CONTOUR
---	PROPOSED CONTOUR
---	PROPOSED INDEX CONTOUR
---	SLOPE TIE
+	EXISTING SPOT ELEVATION
+	PROPOSED SPOT ELEVATION
---	LOT LINE
---	CENTERLINE
---	RIGHT-OF-WAY
---	PROPOSED 4" PVC SD
---	GRAVEL LINED SWALE
---	EXISTING CURB AND GUTTER
---	PROPOSED CMU RETAINING WALL-DESIGN BY OTHERS 18" MAX RETAINAGE

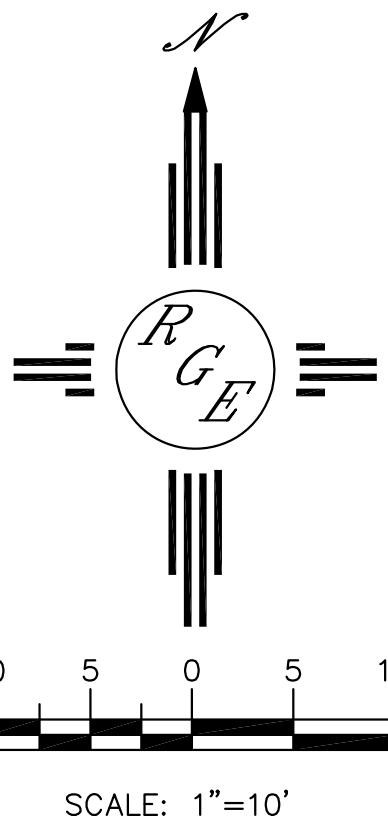

REV. 05/01/2019

CAUTION:

EXISTING UTILITIES ARE NOT SHOWN. IT SHALL BE THE SOLE RESPONSIBILITY OF THE CONTRACTOR TO CONDUCT ALL NECESSARY FIELD INVESTIGATIONS PRIOR TO ANY EXCAVATION TO DETERMINE THE ACTUAL LOCATION OF UTILITIES & OTHER IMPROVEMENTS.

ENGINEER'S SEAL 7/30/21 DAVID SOULE P.E. #14522	7924 VICTORIA	DRAWN BY: WCVJ
	GRADING AND DRAINAGE PLAN	DATE: 4-27-21
 Rio Grande Engineering 1606 CENTRAL AVENUE SE SUITE 201 ALBUQUERQUE, NM 87106 (505) 872-0999		210210044-LAYOUT-4-27-21
		SHEET #
		JOB # 21021044