



CITY OF ALBUQUERQUE
BUILDING SAFETY DIVISION
600 2ND STREET N.W.
ALBUQUERQUE, N.M. 87102
OFFICE 505-924-3964 FAX 505-924-3967

PLAN REVIEW APPLICATION (For information purposes only)

PERMIT # 2022-01657
ADDITIONAL PERMIT #S _____

APPLICANT TO PROVIDE ALL INFORMATION BELOW:

CONSTRUCTION ADDRESS: 5620 KIMBERLITE DR NW 87120

REISSUE FROM MASTER PLAN # _____

CITY PROJECT # _____

LEGAL DESCRIPTION:

WITHIN 1000' OF FORMER LANDFILL ☐ YES ☒ NO

LOT # _____ BLOCK # _____
SUBDIVISION _____
TRACT _____ PARCEL _____ UNIT _____
UPC # _____
ZONE _____ ZONE ATLAS PAGE _____

OWNER:
NAME JOSE & MARIA NUNEZ
ADDRESS PO BOX 65415 ABQ, NM
ZIP 87193 PHONE 505-385-8818

TYPE OF APPLICATION:

☐ COMMERCIAL ☐ RESIDENTIAL
☐ NEW BUILDING ☐ TENANT IMPROVEMENT
☐ SHELL ONLY ☐ SWIMMING POOL
☐ ADDITION ☒ GARDEN WALL, FENCE, RETAINING WALL
☐ REMODEL ☐ FOUNDATION FOR MODULAR BUILDING
☐ REPAIR ☐ FOUNDATION FOR MOVED BUILDING
☐ FOUNDATION ONLY ☐ OTHER

OWNERSHIP: ☐ PRIVATE ☐ PUBLIC

CONSTRUCTION DATA: (THIS PROJECT ONLY)

OF STORIES _____
SQUARE FOOTAGE: _____
HEATED _____
GARAGE _____
CARPORT, PORCH _____
OR PATIO COVER _____
TOTAL SQ. FT. 230

VALUATION OF WORK \$ 15,000

OF PHASES _____ (MUST BE APPROVED AT SUBMITTAL)

OCCUPANT LOAD _____ (FOR COMMERCIAL PROJECTS ONLY)

OCCUPANCY GROUP: _____ CONSTRUCTION TYPE: _____

OF APT. OR MOTEL UNITS _____ # OF BUILDINGS _____

DESCRIPTION OF WORK:

4' Retaining w/ 6' H10H
2' Retaining w/ 6' H10H

ARCHITECT / ENGINEER / DESIGNER:

NAME PON MONTAÑA DESIGNS
ADDRESS _____
ZIP _____ PHONE _____


CONTRACTOR:

NAME JUAN URIOSTE (Datore Custom Homes)
ADDRESS 9316 CAMPIA SUNSET ST NW
ZIP 87114 PHONE 505-385-8818
NM STATE LICENSE # 403620
LICENSE CLASSIFICATION GB2
NM STATE CRS # 03-538930-00-3
ABQ. BUSINESS REG. # FA BA-2022-002463

SIGNATURE _____

DATE 1/25/22

Minimum 10' Between Buildings

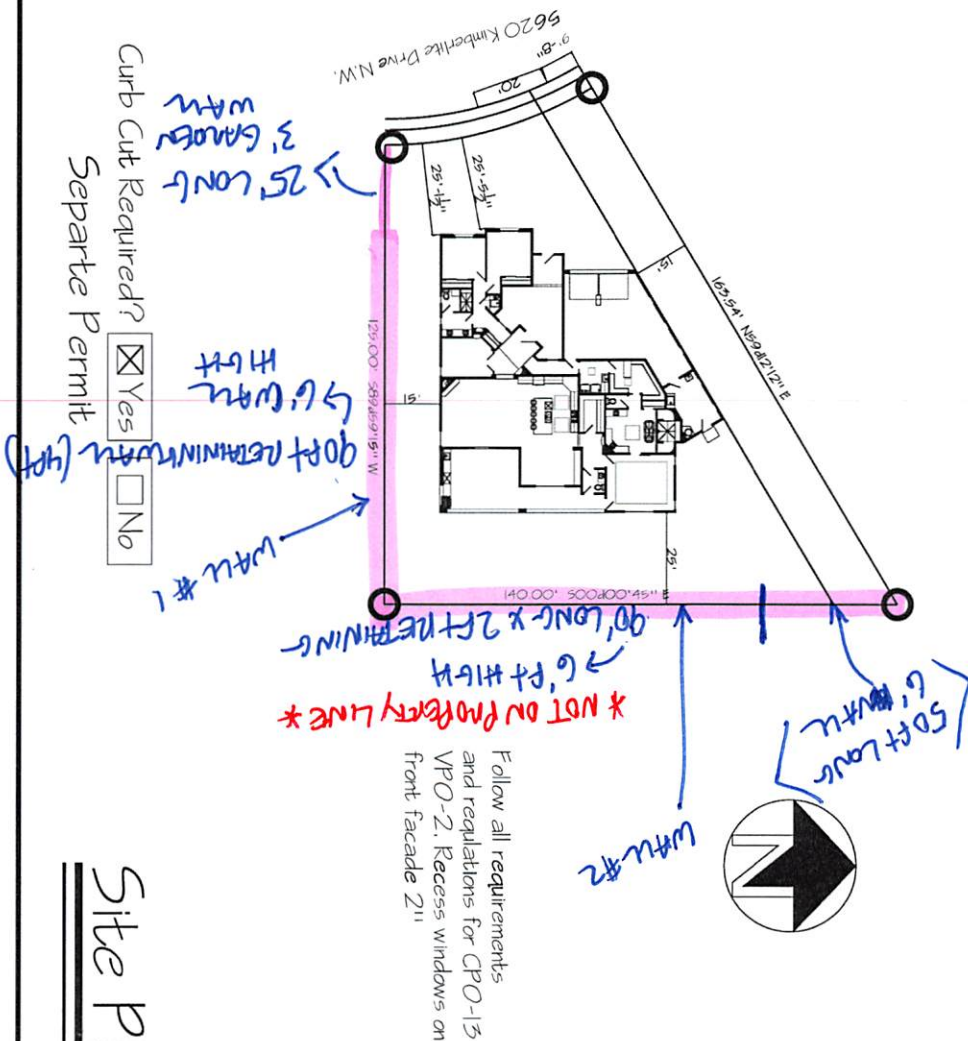

Follow all requirements and regulations for CPO-13 VPO-2. Recess windows on front facade 2"



Legal Description	Lot	Dist	Suburban	Curly

Site Plan

Scale 1/16" = 1'

First Payment Outdated By:
1. E. Mortgage
2.
3.

Sheet

Office Sheets

Nunez Custom Home
Albuquerque New Mexico



August 17, 2021
Site Plan

RM Design Incorporated
Residential Design and Drafting Services Fax 823-6487
8724 Alameda Park Drive N.E., Suite G Albuquerque
(505) 823-6474 Cell. (505) 823-6777

RANDALL

Structural Engineering

SHEET NO. 2 DATE 3 Nov 2021
 JOB NAME NUNEZ CUSTOM HOME
 SUBJECT 5620 KIMBERLITE DR NW 8712
 CLIENT JUAN VRIOSTE

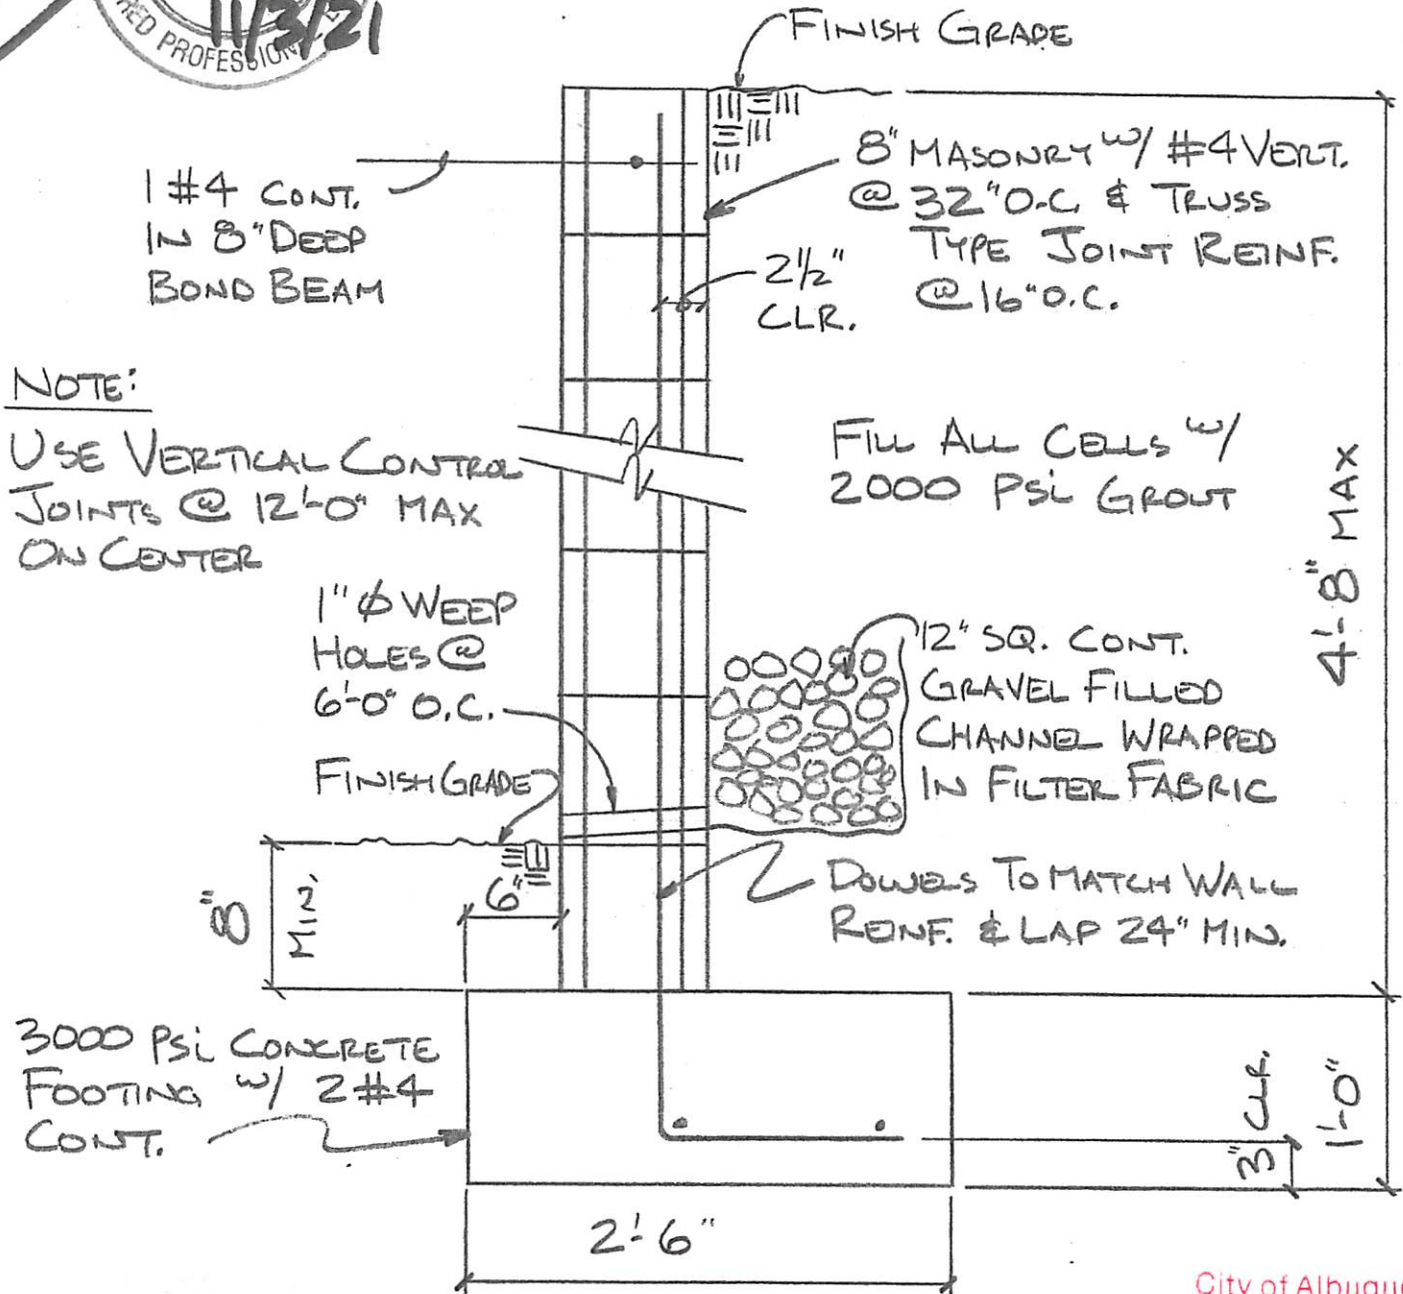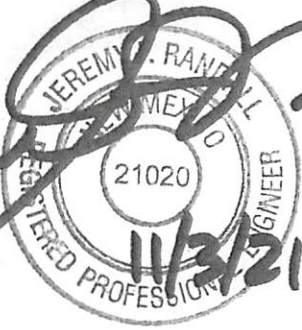

City of Albuquerque
Building Safety

JAN 25 / 22

I.B.C.
Plan Check Section

2 4'-8" MAX RETAINING WALL

SCALE: 1" = 1'-0"

RANDALL

Structural Engineering

SHEET NO. 1 DATE 3 Nov 2021
JOB NAME NUNEZ CUSTOM HOME
SUBJECT 5620 KIMBERLITE DR NW 87124
CLIENT JUAN URIOSTE



Fill All Cells w/
2000 PSI GROUT

1#4 CONT. IN 8" DEEP
BOND BEAM —

NOTE:

USE VERTICAL CONTROL
JOINTS @ 12'-0" MAX
ON CENTER

1" ϕ WEEP
HOLES @
6'-0" O.C.

FINISH GRADE

6" OR 8" MASONRY w/
TRUSS TYPE JOINT REINF.
@ 16" O.C.

12" SQ. CONT.
GRAVEL FILLED
CHANNEL WRAPPED
W/ FILTER FABRIC

#4 Dowels @ 48" O.C.
(CENTERED)

3000 PSI CONCRETE
FOOTING w/ (1) #4
CONT.

ALT
BEND

14"

City of Albuquerque
Building Safety

JAN 25 1922

I.B.C.
Plan Check Section

1) 2'-8" MAX RETAINING WALL

SCALE: 1" = 1'-0"