# CITY OF ALBUQUERQUE

Planning Department Alan Varela, Director



Mayor Timothy M. Keller

June 1, 2023

David Soule, P.E. Rio Grande Engineering PO Box 93924 Albuquerque, New Mexico 87199

Re: Lot 7 Block 3 SAD 227 Volcano Cliffs Subdivision Unit 2 5619 Kimberlite NW Grading and Drainage Plan Engineers Stamp Date 7/13/2022 (E10D119) Pad Certification Date: 8/18/2022 CO Certification Dated: 5/9/2023

PO Box 1293	Mr. Soule:
	Based on the Certification received on 5/28/2023, the site is acceptable for release of Certificate of Occupancy by Hydrology.
Albuquerque	If you have any questions, please contact me at 924-3986 or Rudy Rael at 924-3977.
NM 87103	Sincerely,
INIVI 87103	- Char

www.cabq.gov Tiequan Chen, P.E. Principal Engineer, Hydrology Planning Department, Development Review Services

> RR/TC File: E10D119

	Planning Depa	querque rtment Services Division			
	Ç	TION INFORMATI	ON SHE	ET (REV 6/2018)	
5619 kimberlite Project Title: DR NW	Building Permit	#:	Hydrolo	ogy File #:	
DRB#:Legal Description: LOT 7 , BLOCK 3 City Address: 5619kimberlite DR N	VOLCANO C	CLIFFS UNIT 2			
Applicant:					
Address:					
Phone#:	Fax#:	· · · · · · · · · · · · · · · · · · ·	E-mail: _		
Other Contact: RIO GRANDE ENGINE	ERING		Contact:	DAVID SOULE	
Address: PO BOX 93924 ALB NM 8	37199				
Phone#: 505.321.9099	Fax#:	.0999	E-mail: <sup>da</sup>	avid@riograndeengin	eering.com
TYPE OF DEVELOPMENT: PLAT					
Check all that Apply:					
DEPARTMENT: X HYDROLOGY/ DRAINAGE TRAFFIC/ TRANSPORTATION		<b>TYPE OF APPROVA</b> BUILDING PERM _XCERTIFICATE O	MIT APPR	OVAL	
<b>X</b> ENGINEER/ARCHITECT CERTIFICATION		PRELIMINARY	PLAT API	PROVAL	
PAD CERTIFICATION		SITE PLAN FOR			
CONCEPTUAL G & D PLAN		SITE PLAN FOR			
GRADING PLAN DRAINAGE REPORT		FINAL PLAT AF	PPROVAL	,	
DRAINAGE MASTER PLAN	•	SIA/ RELEASE (	OF FINAN	CIAL GUARANTEE	
FLOODPLAIN DEVELOPMENT PERMIT AI	PPLIC	FOUNDATION P			
ELEVATION CERTIFICATE		GRADING PERM	MIT APPR	OVAL	
CLOMR/LOMR		SO-19 APPROVA	AL		
TRAFFIC CIRCULATION LAYOUT (TCL)		PAVING PERMI	T APPRO	VAL	
TRAFFIC IMPACT STUDY (TIS)		GRADING/ PAD	CERTIFI	CATION	
STREET LIGHT LAYOUT		WORK ORDER A	PPROVAL	,	
OTHER (SPECIFY)		CLOMR/LOMR			
PRE-DESIGN MEETING?		FLOODPLAIN D			
IS THIS A RESUBMITTAL?: X Yes No		OTHER (SPECIF	FY)		
DATE SUBMITTED:	By:				
COA STAFF:	ELECTRONIC SUB	MITTAL RECEIVED:			
	FEE PAID:				

Weighted E Method														
100-Year, 6-hr. 24 hour									24 hour					
Basin	Area	Area	Treat	ment A	Treat	ment B	Treat	ment C	Treatr	ment D	Weighted E	Volume	Flow	Volume
	(sf)	(acres)	%	(acres)	%	(acres)	%	(acres)	%	(acres)	(ac-ft)	(ac-ft)	cfs	(ac-ft)
ALLOWED	12600.00	0.289	0%	0	20%	0.058	46%	0.1331	34%	0.098	1.259	0.030	0.93	0.034
FRONT	12600.00	0.289	0%	0	20%	0.058	36%	0.1041	44%	0.127	1.357	0.033	0.97	0.038

### Equations:

Weighted E = Ea\*Aa + Eb\*Ab + Ec\*Ac + Ed\*Ad / (Total Area)

Volume = Weighted D \* Total Area

Flow = Qa \* Aa + Qb \* Ab + Qc \* Ac + Qd \* Ad


Where for 100-year, 6-hou	r storm- zone 1	
	Ea= 0.44 Eb= 0.67 Ec= 0.99 Ed= 1.97	Qa= 1.29 Qb= 2.03 Qc= 2.87 Qd= 4.37
ONSITE Conditons DRAINAGE SUMMARY	REQUIRED	PROVI


	REQUIRED (CF)	PROVIDED (CF)
FLOOD CONTROL	151	870


Narrative

\_\_\_\_\_

This site is within the SAD 227 Master Drainage plan boundaries. The site is to maintain existing patterns and drain to the adjacent open space property to the east per the master drainage plan. The site does exceed the SAD 227 developed conditions assumptions, therefore ponding is required. Due to the site being within the height restriction area, ponds and drainage pipes are proposed to minimize elevation of the building drain to the street and the rear yard fills aand overflows to the openspace. Upland flow does not impact the property.

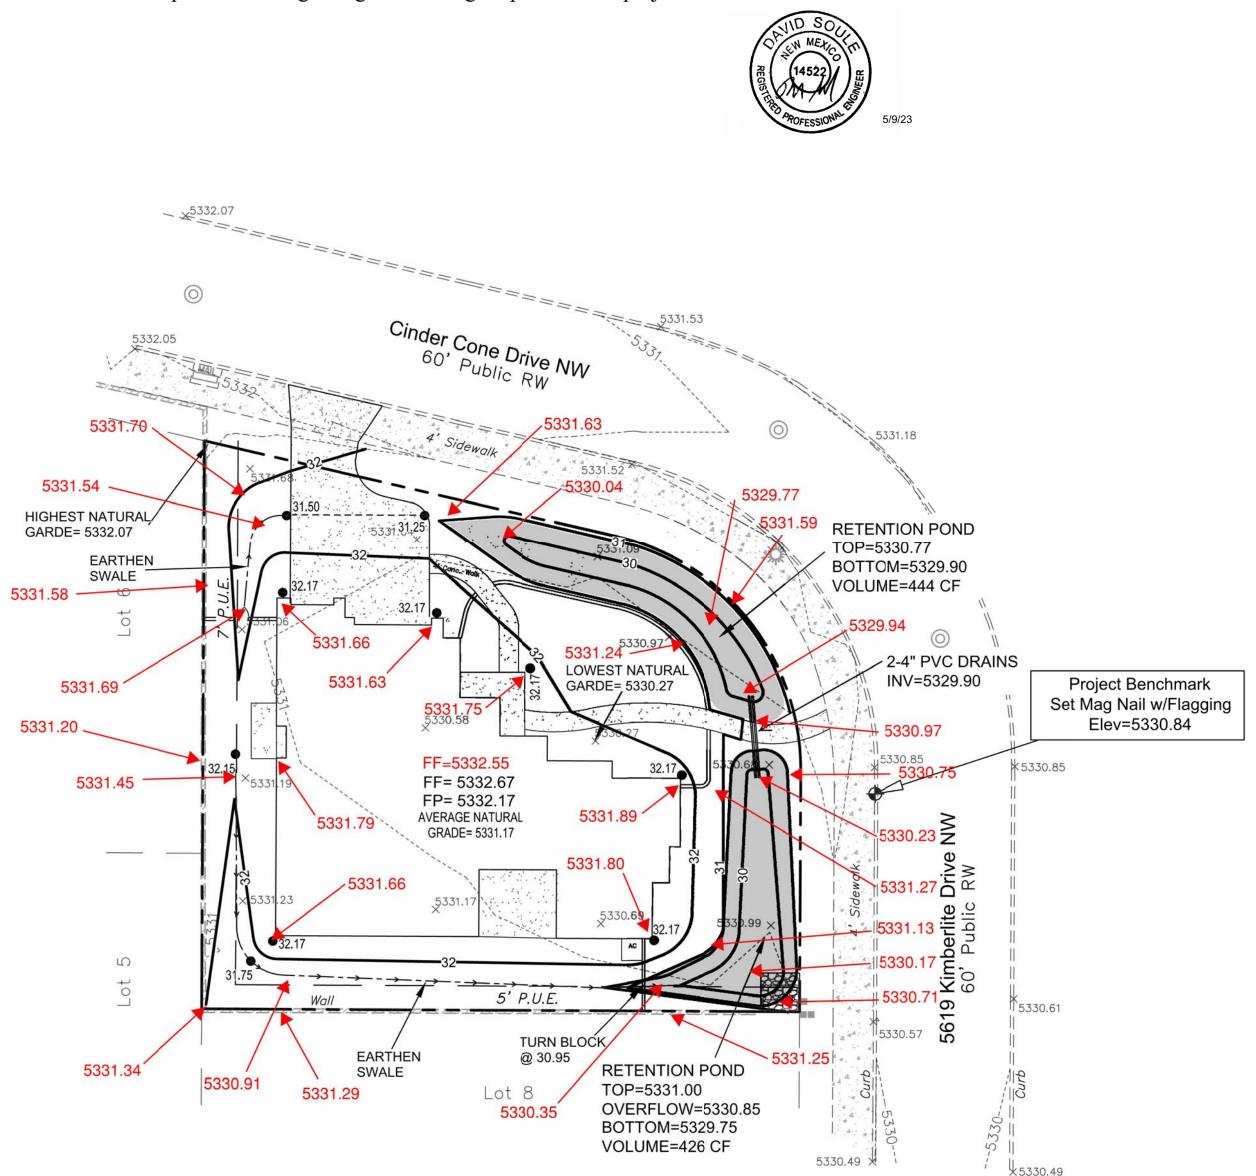

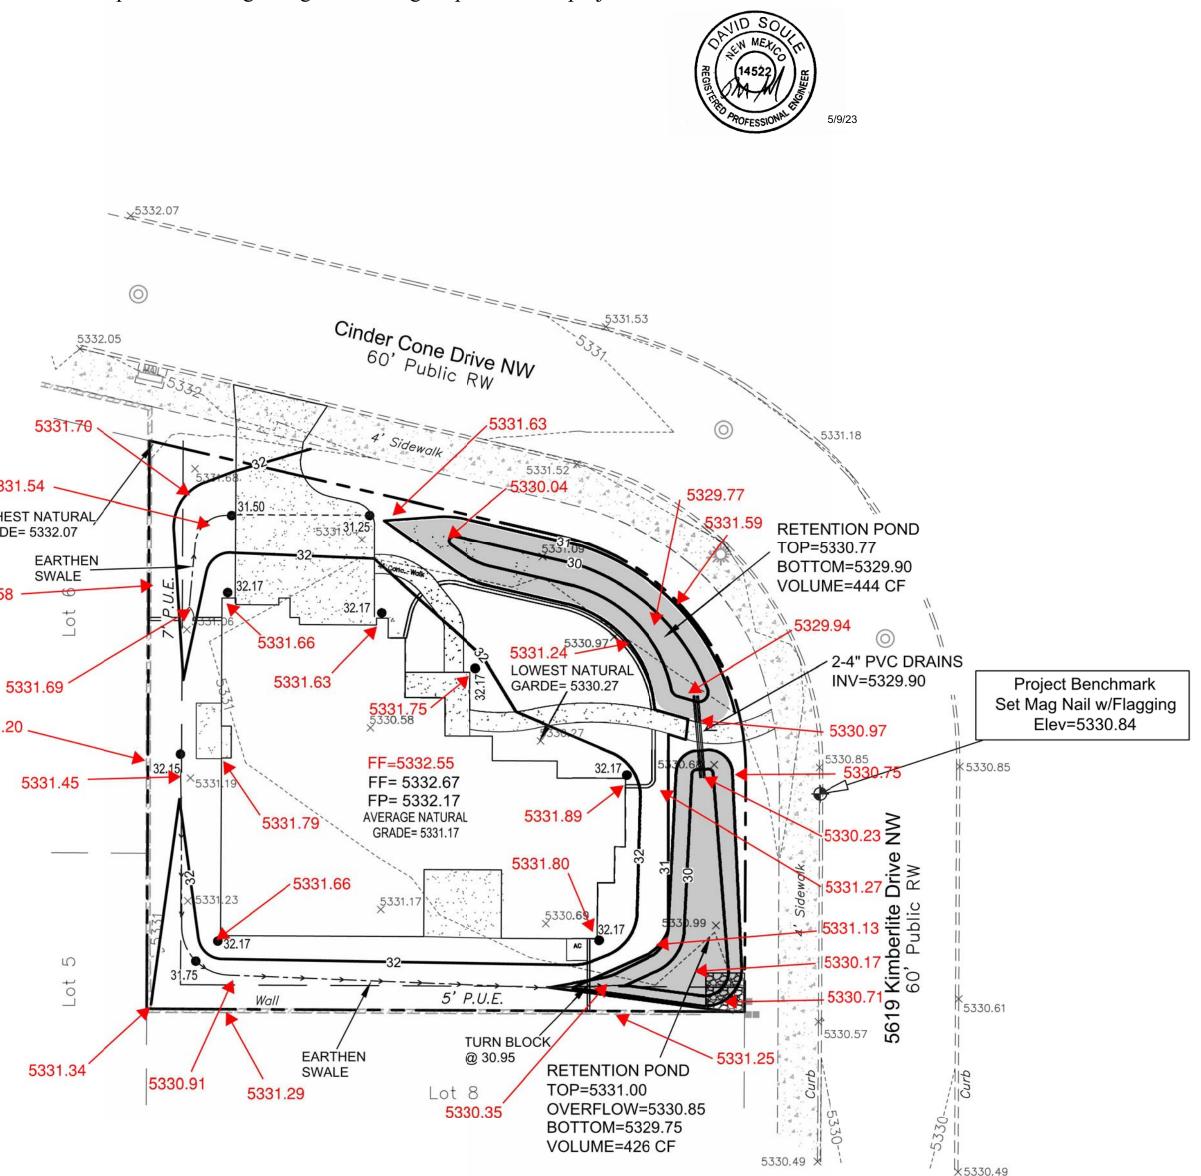

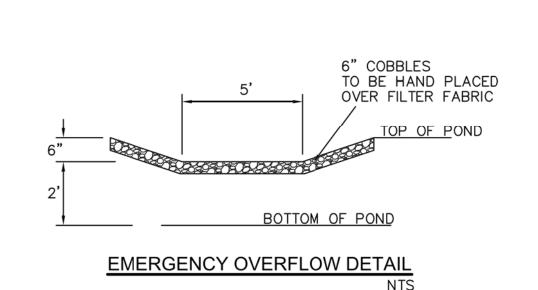

CONSTRUCT ALL SWALES AND EROSION PROTECTION

(SHOWN HATCHED) BELOW ADJACENT GRADE TO ENDSURE

RUNOFF CAN BE CAPTURED AND CONVEYED PROPERLY.

2'

4" 

EARTHEN SWALE

NTS

\_\_\_\_\_

PLACE 2" LAYER OF

GRAVEL AT FLOW LINE

**CAUTION:** 

EXISTING UTILITIES ARE NOT SHOWN. IT SHALL BE THE SOLE RESPONSIBILITY OF THE CONTRACTOR TO CONDUCT ALL NECESSARY FIELD INVESTIGATIONS PRIOR TO ANY EXCAVATION TO DETERMINE THE ACTUAL LOCATION OF UTILITIES & OTHER IMPROVEMENTS.

### I, DAVID SOULE HAVE PERSONALLY INPECTED THE SITE. I HEREBY CERTIFY THE PAD HAS BEEN CONSTRUCTED SUCH THAT IT IS IN SUBSTANTIAL CONFORMANCE TO THE APPROVED GRADING PLAN DATED 7/13/22


### 1. CONTRACTOR IS RESPONSIBLE FOR OBTAINING A TOPSOIL DISTURBANCE PERMIT PRIOR TO BEGINNING WORK.

2. CONTRACTOR IS RESPONSIBLE FOR MAINTAINING RUN-OFF ON SITE DURING CONSTRUCTION.

3. CONTRACTOR IS RESPONSIBLE FOR CLEANING ALL SEDIMENT THAT GETS INTO EXISTING RIGHT-OF-WAY.

4. REPAIR OF DAMAGED FACILITIES AND CLEANUP OF SEDIMENT ACCUMULATIONS ON ADJACENT PROPERTIES AND IN PUBLIC FACILITIES IS THE RESPONSIBILITY OF THE CONTRACTOR.


5. ALL EXPOSED EARTH SURFACES MUST BE PROTECTED FROM WIND AND WATER EROSION PRIOR TO FINAL ACCEPTANCE OF ANY PROJECT.

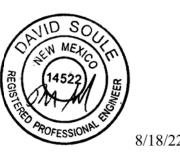

I David Soule, NMPE 14522, of the firm Rio Grande Engineering, hereby certify that this project has been graded and will drain in substantial compliance with and in accordance with the design intend of the approved plan dated 7/13/22 . The certification is submitted in support of a request for <u>CERTIFICATE OR OCCUPANCY</u>. The record information presented heron is not necessarily complete and intended only to verify substantial compliance of the grading and drainage aspects of this project.

	"AS-BUILT"
	ROFESSIONAL
	PROFESSIONAL SUPERIOR STATE OF
Lash	Think ASO E. DOM MUTUT
0	5/4/2023 DATE

## **EROSION CONTROL NOTES:**

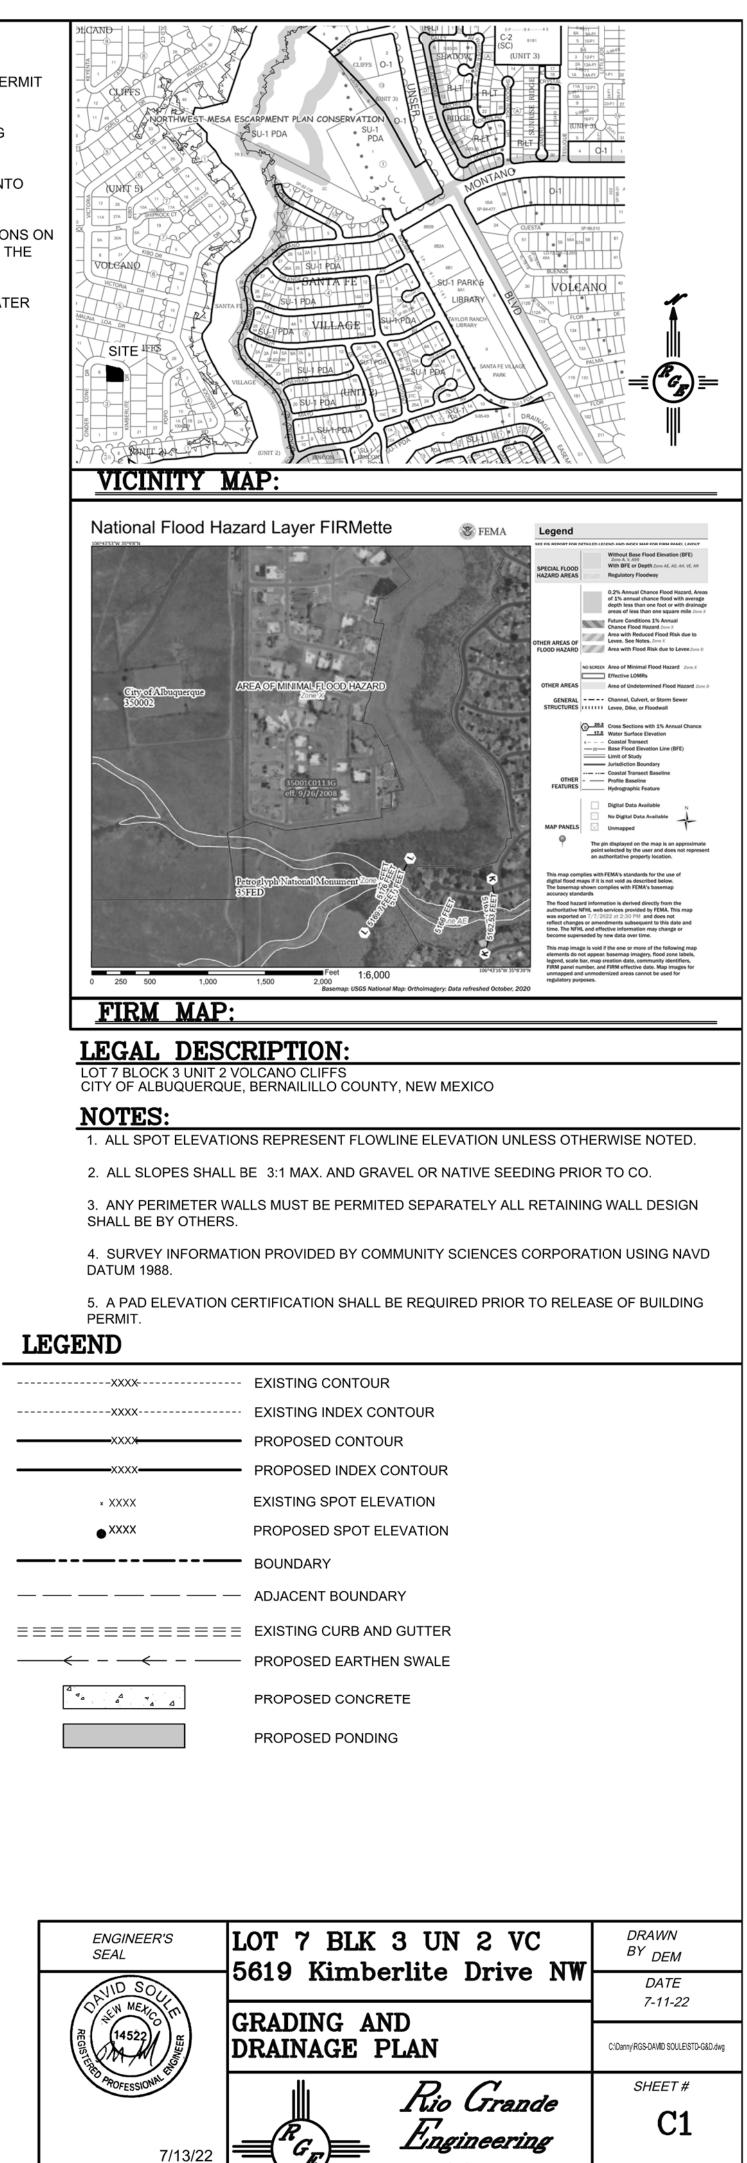

PO BOX 93924 ALBUQUERQUE, NM 87199

(505) 321-9099

JOB #

= = GE/ SCALE: 1"=10'

DAVID SOULE

P.E. #14522