

DRAINAGE INFORMATION SHEET

PROJECT TITLE: LDS Church Site ZONE ATLAS/DRNG. FILE #: E-11/D23A
 DRB #: _____ EPC #: _____ WORK ORDER #: _____
 LEGAL DESCRIPTION: Lot 8, Blk. 2 Unit 3 Volcano Cliffs Subdivision
 CITY ADDRESS: ~~Bear Claw Dr. NW~~ 6009 Kachina NW
 ENGINEERING FIRM: Wilson and Company CONTACT: Kristine Susco
 ADDRESS: 4775 Indian School Road NE 87110 PHONE: (505)254-4059
 OWNER: Taylor Ranch Church of LDS CONTACT: Max Ivy
 ADDRESS: 6009 Kachina Dr. NW 87120 PHONE: (505)298-9706
 ARCHITECT: Thomas E. Robson CONTACT: Thomas Robson
 ADDRESS: 5905 Marble NE PHONE: (505)266-9013
 SURVEYOR: _____ CONTACT: _____
 ADDRESS: _____ PHONE: _____
 CONTRACTOR: _____ CONTACT: _____
 ADDRESS: _____ PHONE: _____

TYPE OF SUBMITTAL:

____ DRAINAGE REPORT
 ____ DRAINAGE PLAN
 ____ CONCEPTUAL GRADING & DRAINAGE PLAN
 ____ GRADING PLAN
 ____ EROSION CONTROL PLAN
☒ ENGINEER'S CERTIFICATION
 ____ OTHER _____

PRE-DESIGN MEETING:

____ YES
 ____ NO
 ____ COPY PROVIDED


*Gave 30 day
Temp CO.*

CHECK TYPE OF APPROVAL SOUGHT:

____ SKETCH PLAT APPROVAL
 ____ PRELIMINARY PLAT APPROVAL
 ____ S. DEV. PLAN FOR SUB'D. APPROVAL
 ____ S. DEV. PLAN FOR BLDG. PERMIT APPROVAL
 ____ SECTOR PLAN APPROVAL
 ____ FINAL PLAT APPROVAL
 ____ FOUNDATION PERMIT APPROVAL
 ____ BUILDING PERMIT APPROVAL
☒ CERTIFICATE OF OCCUPANCY APPROVAL
 ____ GRADING PERMIT APPROVAL
 ____ PAVING PERMIT APPROVAL
 ____ S.A.D. DRAINAGE REPORT
 ____ DRAINAGE REQUIREMENTS
 ____ OTHER _____ (SPECIFY)

DATE SUBMITTED: 6-26-96
 BY: Kristine Susco

JUL - 2 1996

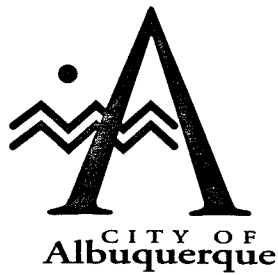

July 10, 1996

Martin J. Chávez, Mayor

Daniel S. Aguirre
Wilson & Company
4775 Indian School Rd. NE
Albuquerque, NM 87110

RE: ENGINEER CERTIFICATION FOR LDS CHURCH SITE (E11-D23A)
CERTIFICATION STATEMENT DATED 6/25/96.

Dear Mr. Aguirre:

Based on the information provided on your July 2, 1996 submittal, Engineer Certification for the above referenced site is acceptable.

If I can be of further assistance, please feel free to contact me at 768-2667.

Sincerely,

Bernie J. Montoya, CE
Engineering Associate

BJM/dl

c: Andrew Garcia
File

Good for You. Albuquerque!



Drainage Report
LDS Church Parking Lot Site

Site Location and Description

The site is located at the NE corner of Bear Claw Drive NW and Cochiti Drive NW. The site is currently undeveloped. The proposed development consists of a paved parking lot with curb and gutter.

Methodology

The Development Process Manual, Volume 2, Design Criteria for the City of Albuquerque was followed to calculate peak runoff for the site. The method used to determine the runoff for the site basins is designated Part A in the revised section 22.2. Using the 100-year frequency 6-hour rainfall volume as the design storm, the charts and formulas in Part A were followed. The site is located in Zone 1 as determined from Figure A, and the peak discharge was determined using Table 9.

Existing Conditions

The site has one basin. The project site has been uncompacted by human activity and is cross sloped at approximately 1% from the northeast corner of the lot to the southeast corner of the property. The following calculations show the peak discharge and volume for the 100-year 6-hour event.

HYDROLOGY CALCULATIONS: EXISTING CONDITIONS

Basin	Land Treatment	Zone	Area (Acres)	Peak Discharge (cfs/acre)	Runoff Q (cfs)	E _w (in)	V (ac-ft)
1	A	1	0.59	1.29	0.76	0.44	0.022

Proposed Conditions:


Proposed conditions include paving and installation of curb and gutter to create a parking lot. The parking area, to be entered from the north and adjacent parking lot and church site, is intended to enlarge the current parking capacity. The site is divided into four basins. Basin A slopes to the north and discharges into an existing swale which then discharges into San Ildefonso Drive NW (E11/D23). Basin B slopes to the southwest corner of the site and free discharges into Bear Claw Drive NW through a concrete rundown and sidewalk culvert. Basin C slopes to the southeast and free discharges into Bear Claw Drive NW through a concrete rundown and sidewalk culvert. Both sidewalk culverts are to be constructed in SAD221. Basin D will sheet flow to Cochiti Drive NW.

HYDROLOGY CALCULATIONS: PROPOSED CONDITIONS


Basin	Land Treatment	Zone	Area (Acres)	Peak Discharge (cfs/acre)	Runoff Q (cfs)	E _w (in)	V (ac-ft)
A	D	1	0.11	4.37	0.48	1.97	0.023
B	D	1	0.03	2.03	0.06	1.85	0.061
C	D	1	0.29	4.37	1.27	1.97	0.045
D	D	1	0.12	4.37	0.52	1.97	0.003
			0.05	2.03	0.10	0.67	
SUB TOTAL			0.60		2.43		0.132

Conclusion:


Based on these calculations, the site will discharge an additional 0.48 cfs into an existing basin which then discharges into San Ildefonso Drive NW with a total Q of 6.1 cfs. Basins B and C will discharge, through two 12" sidewalk culverts, a total Q of 1.9 cfs into Bear Claw Drive NW. Basin D will sheet flow to Cochiti Drive NW with a Q of 0.10 cfs. This drainage plan is in accordance with the Drainage Master Plan identified in SAD221.

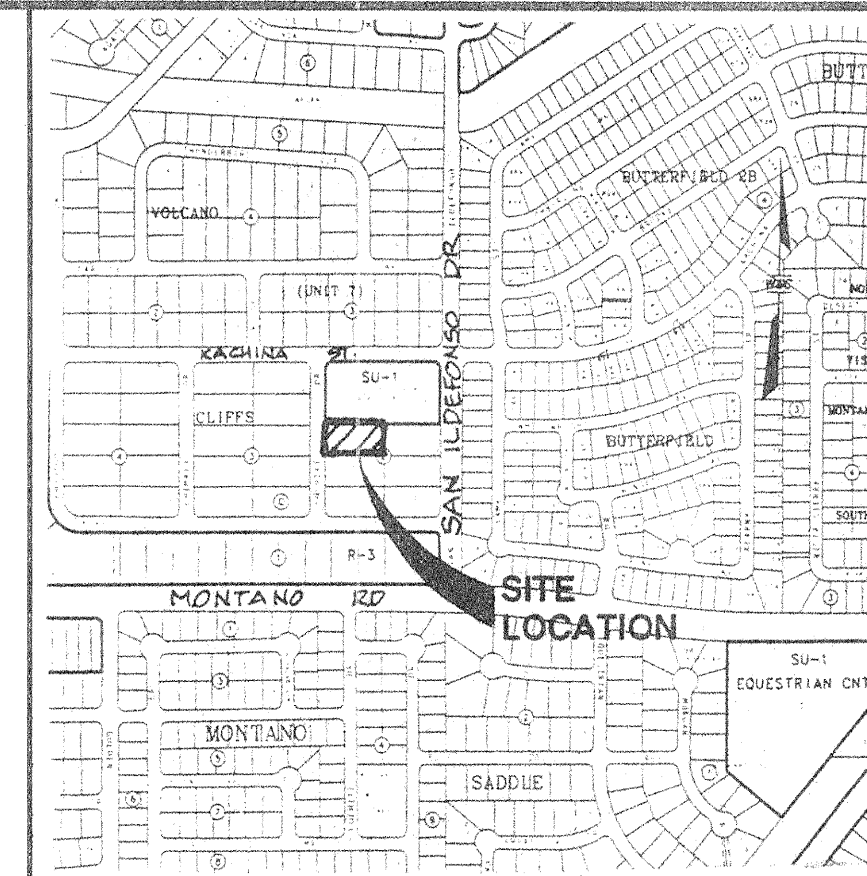

LOCATION MAP
ZONE ATLAS MAP NO. E-11

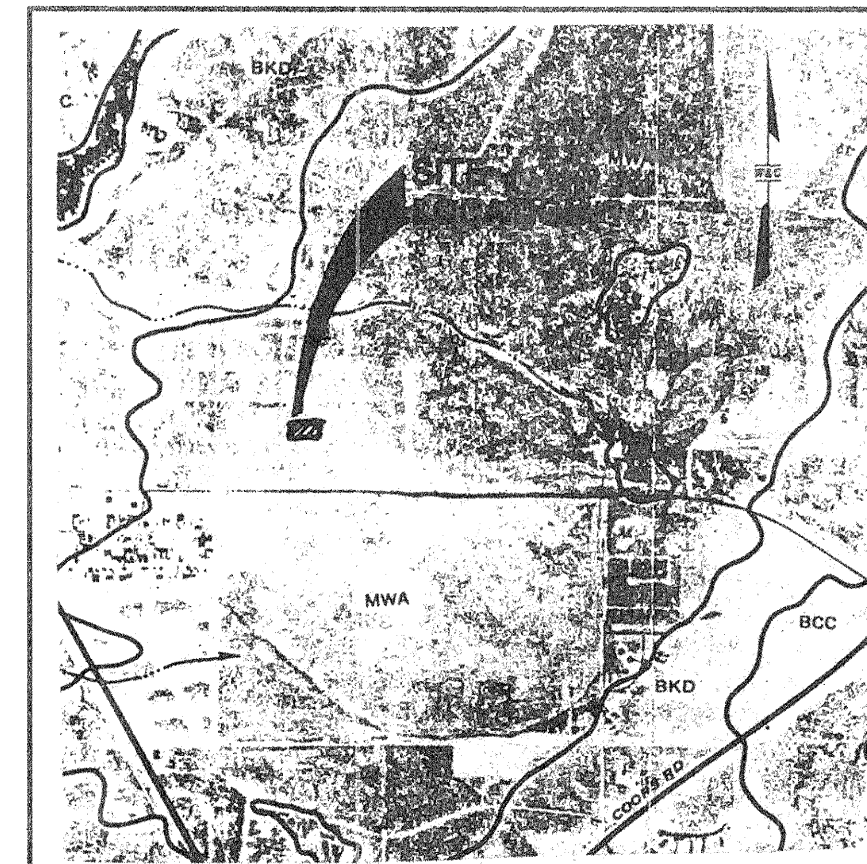

SOILS MAP
REFERENCE: SCS BERNALILLO COUNTY SOIL SURVEY SHEET NO. 20

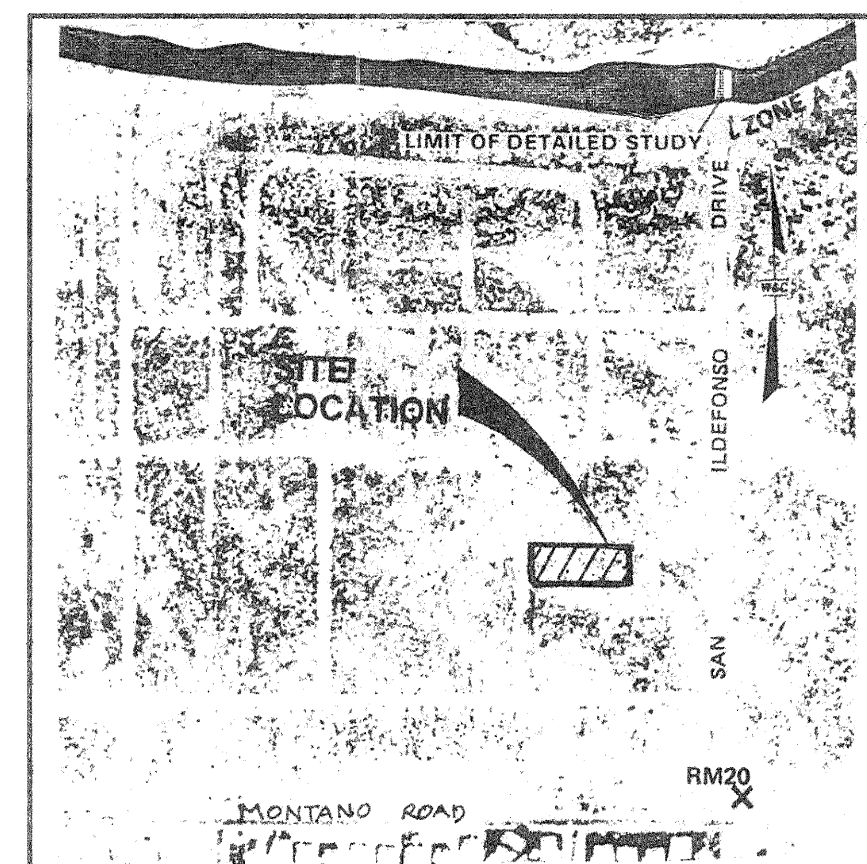

FLOOD INSURANCE MAP
REFERENCE: FLOOD INSURANCE STUDY PANEL 14

LEGAL DESCRIPTION


LOT 8 BLOCK 2 UNIT 3 VOLCANO CLIFFS SUBDIVISION

BENCH MARK

A CHISELED SQUARE " " ON TOP OF CURB AT ESE CURB RETURN OF THE INTERSECTION OF MONTANO RD. AND EQUESTRIAN DR. ELEVATION = 5120.02 (ACS)

LEGEND

- EXISTING INTERMEDIATE CONTOUR
- EXISTING INDEX CONTOUR
- PROPOSED INTERMEDIATE CONTOUR
- PROPOSED INDEX CONTOUR
- EXISTING SPOT ELEVATION
- PROPOSED SPOT ELEVATION
- BASIN DESIGNATION
- BASIN BOUNDARY
- EXISTING FLOWLINE
- PROPOSED FLOWLINE
- AS BUILT ELEVATIONS

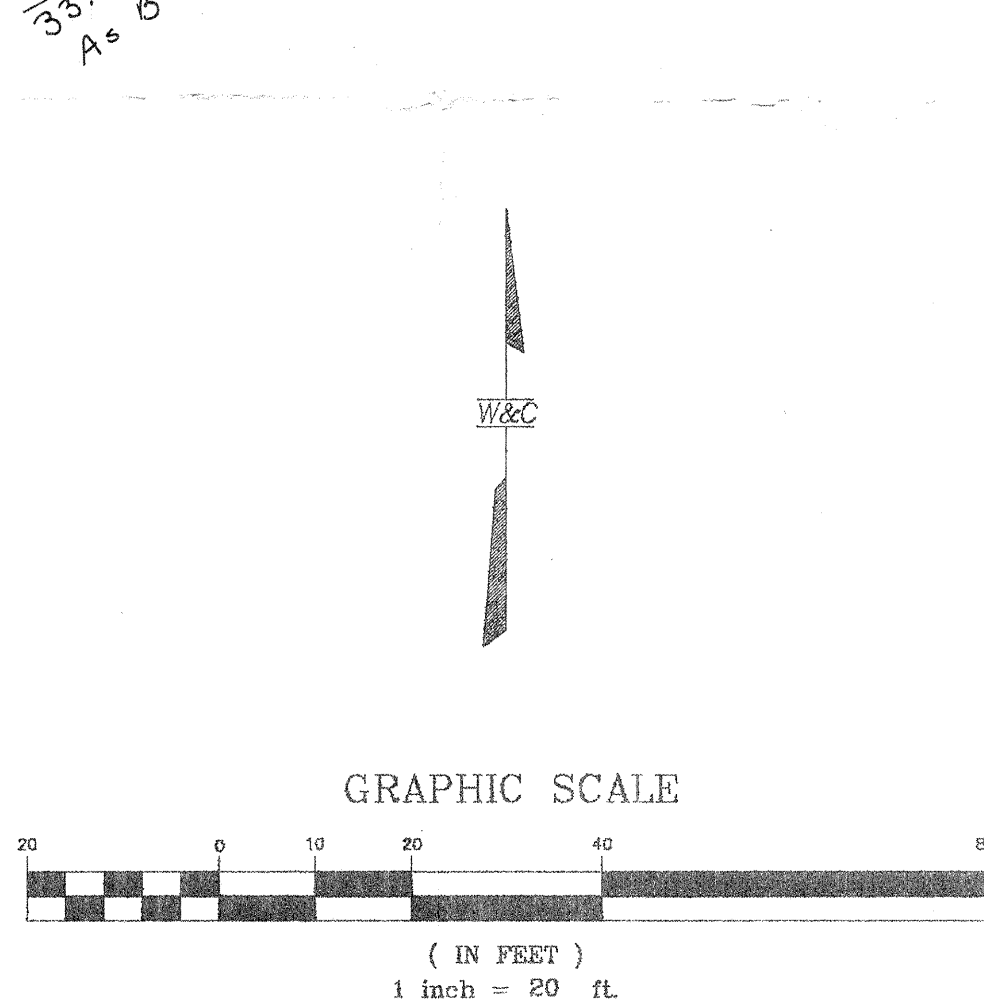

ENGINEER'S CERTIFICATION

I, DANIEL S. AGUIRRE, DO HEREBY CERTIFY THAT THE AS-BUILT INFORMATION HEREON IS IN SUBSTANTIAL COMPLIANCE WITH THE APPROVED DRAINAGE PLAN.

APPROVED FOR ROUGH GRADING ±1'

APPROVED FOR ROUGH GRADING ±1'
DATE 3-15-95

LDS CHURCH SITE

GRADING AND DRAINAGE PLAN

DESIGN K.I.S.	DRAWN K.I.S.	DATE FEBRUARY 1995
FILE NO. 95404		SHEET NO. 1 OF 1

WILSON & COMPANY

4775 INDIAN SCHOOL ROAD N.E.
SUITE 200
ALBUQUERQUE, NEW MEXICO 87110
(505) 254-4000