


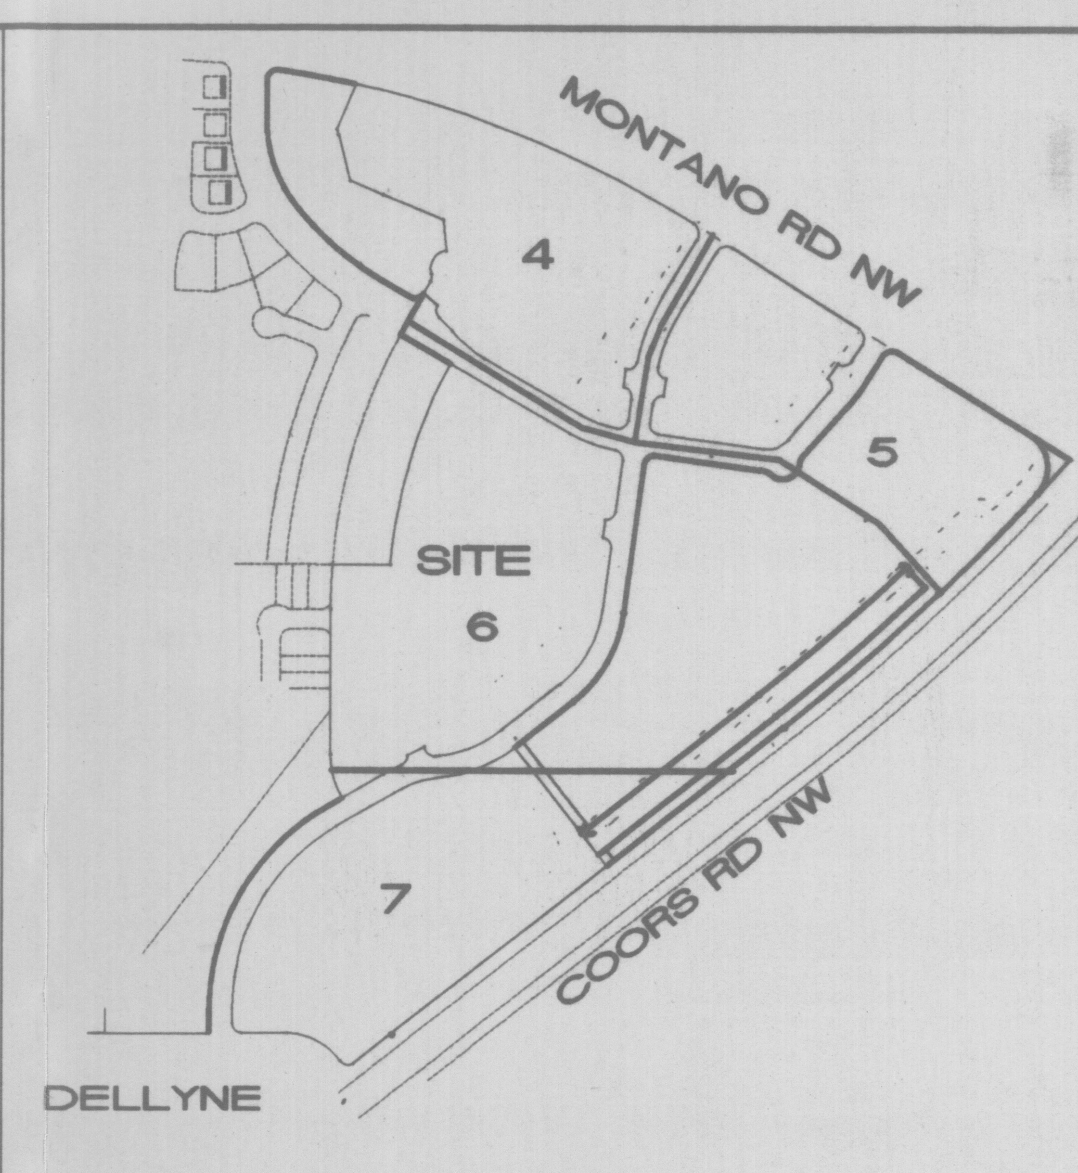

SURVEY INFORMATION		BENCH MARKS		AS-BUILT INFORMATION	
NO.	DATE	BY	END OF THE MEDIAN IN COORS RD NW NORTH OF MONTANO RD NW	CONTRACTOR	DATE
1	2/93	W. PETTIT	ELEVATION = 5006.41	INSPECTOR'S FIELD VERIFICATION BY	DATE
ENGINEER'S SEAL		MICRO-FILM INFORMATION		RECORDED BY	DATE

REVISIONS		DESIGN	
NO.	DATE	REMARKS	BY
1	7-13-94	7-13-94	
2	8-16-94	8-16-94	

ENGINEER'S CERTIFICATION
I, SCOTT M. MCGEE, LICENSED UNDER THE LAWS OF THE STATE OF NEW MEXICO, DO HEREBY CERTIFY THAT THE MASS GRADING SHOWN HEREON, WITH AS-BUILT ELEVATIONS, WAS COMPLETED IN SUBSTANTIAL COMPLIANCE WITH THE APPROVED GRADES AS FIELD VERIFIED BY ALDRICH LAND SURVEYING (NMLS NO. 7719 DURING MAY 1995) IN ACCORDANCE WITH THE NEW MEXICO ENGINEERING AND SURVEYING ACT, SECTION 61-23-1 THROUGH 61-23-32 NMSD (1978). ADDITIONAL SUBDIVISION GRADING HAS BEEN PERFORMED ON TRACT B (AS PER CITY PROJECT NO. 4918.91) APPROVED 3/24/95. PRIVATE RETAINING & PERIMETER WALLS WERE NOT REQUIRED ON THE APPROVED GRADING PLAN. A 2' FT-WIDE PRIVATE DRAINAGE CHANNEL HAS BEEN CONSTRUCTED AS SHOWN TO CARRY FLOW FROM OFFSITE TRACT B-2 TO LA COLONIA DRIVE (FUTURE STREET, BUILT AS PART OF CITY PROJECT NO. 4918.91).

SCOTT M. MCGEE, NMPE NO. 10519

CITY OF ALBUQUERQUE PUBLIC WORKS DEPARTMENT ENGINEERING GROUP					
TITLE: TRACT R-1, TAYLOR RANCH GRADING & DRAINAGE PLAN					
APPROVALS	ENGINEER	DATE	APPROVALS	ENGINEER	DATE
DRC CHAIRMAN	APPROVED	9-12-94	WATER	APPROVED	
TRANSPORTATION	APPROVED	8-01-94	WASTE WATER	APPROVED	
HYDROLOGY	APPROVED	8-16-94			
PROJECT NO.	4918.90	MAP NO.	E-12	SHEET	6 OF 23