




2020 Isaacson & Arfman, Inc.  
All design, calculations, and  
concepts are owned by and  
remain the property of Isaacson &  
Arfman, Inc. and no part thereof  
shall be utilized by any person,  
firm or corporation for any  
purpose whatsoever except with  
the written permission of  
Isaacson & Arfman, Inc.

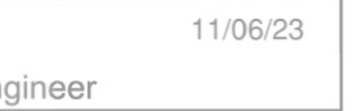

# 410 CAMINO ESPAÑOL

————— 80 —————	PROPOSED 1.0' CONTOUR
- - - - - 81.5' - - - - -	PROPOSED 0.5' CONTOUR
⬤ 82.56	PROPOSED SPOT ELEVATION
—————→	SURFACE FLOW DIRECTION
PG = 4982.2	PAD ELEVATION

CG-101

