


LEGEND

5360	NEW CONTOUR GRADE	EXISTING TOP OF CURB ELEVATION
5341	EXISTING CONTOUR GRADE	EXISTING FLOWLINE ELEVATION
5342	DRAINAGE FLOW DIRECTION	NEW DIRT GRADE ELEVATION
5343	NEW TOP OF CURB ELEVATION	FLOWLINE SHALE ELEVATION
5344	NEW FLOWLINE OF CURB ELEVATION	NEW TOP OF WALL ELEVATION
5345	NEW TOP OF ASPHALT ELEVATION	NEW BOTTOM OF WALL ELEVATION
5346	NEW TOP OF SIDEWALK ELEVATION	NEW ROOF DRAIN
5347	DRAINAGE SHALE	

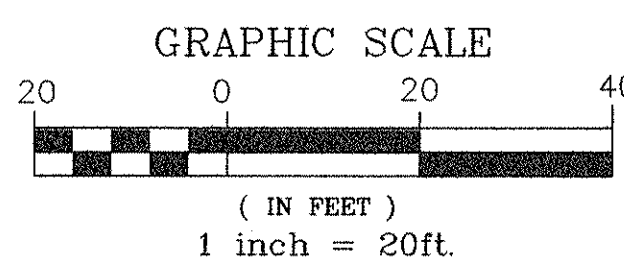

UTILITY NOTE

IF ANY UTILITY LINES, PIPELINES, OR UNDERGROUND UTILITY LINES ARE SHOWN ON THE DRAWING, THEY ARE SHOWN IN APPROXIMATE MANNER ONLY. UTILITY LINES MAY EXIST WHERE NONE ARE SHOWN. IF ANY SUCH EXISTING LINES ARE SHOWN, THE LOCATION IS BASED UPON INFORMATION PROVIDED BY THE UTILITY OR PIPELINE COMPANY, THE OWNER, OR BY OTHERS. THE INFORMATION MAY BE INCOMPLETE, OR MAY BE OBSOLETE BY THE TIME CONSTRUCTION COMMENCES.

THE ENGINEER HAS UNDERTAKEN NO FIELD VERIFICATION OF THE LOCATION, DEPTH, SIZE OR TYPE OF EXISTING ABOVE AN UNDERGROUND UTILITIES, OR EXISTING PIPELINES. THE ENGINEER MAKES NO REPRESENTATION PERTAINING THERETO, AND ASSUMES NO RESPONSIBILITY OR LIABILITY THEREFOR. THE CONTRACTOR SHALL INFORM HIMSELF OF THE LOCATION OF ANY EXISTING ABOVE AND UNDERGROUND UTILITIES, AND EXISTING PIPELINES, IN AND NEAR THE AREA OF THE WORK, IN ADVANCE OF AND DURING EXCAVATION WORK. THE CONTRACTOR IS FULLY RESPONSIBLE FOR ANY AND ALL DAMAGE CAUSED BY HIS FAILURE TO LOCATE, IDENTIFY AND PRESERVE ANY AND ALL EXISTING ABOVE AND UNDERGROUND UTILITIES, AND EXISTING PIPELINES. THE CONTRACT SHALL COMPLY WITH STATE STATUTES PERTAINING TO THE LOCATION OF THESE LINES IN PLANNING AND CONDUCTING EXCAVATION WORK.


I, GILBERT ALDAZ, NMPE 10848, OF THE FIRM APPLIED ENGINEERING & SURVEYING, INC., HEREBY CERTIFY THAT THIS PROJECT HAS BEEN GRADED AND WILL DRAIN IN SUBSTANTIAL COMPLIANCE WITH AND IN ACCORDANCE WITH THE DESIGN INTENT OF THE APPROVED PLAN DATED JANUARY 4, 2012. THE RECORD INFORMATION EDITED ONTO THE ORIGINAL DESIGN DOCUMENT HAS BEEN OBTAINED BY RUSS P. HUGG, NMPS 9750, OF THE FIRM SURV. TEK, INC. I FURTHER CERTIFY THAT I HAVE PERSONALLY VISITED THE PROJECT SITE ON SEPTEMBER 7, 2012 AND HAVE DETERMINED BY VISUAL INSPECTION THAT THE SURVEY DATA PROVIDED IS REPRESENTATIVE OF ACTUAL SITE CONDITIONS AND IS TRUE AND CORRECT TO THE BEST OF MY KNOWLEDGE AND BELIEF. THIS CERTIFICATION IS SUBMITTED IN SUPPORT OF A REQUEST FOR CERTIFICATION OF OCCUPANCY.

DESCRIBE ANY EXCEPTIONS AND/OR QUALIFICATIONS HERE IN A SEPARATE PARAGRAPH NON NOTED.

DESCRIBE ANY DEFICIENCIES AND/OR REQUIRED CORRECTIONS HERE IN A SEPARATE PARAGRAPH. ALL DEFICIENCIES NOTED ON CITY LETTER DATED AUGUST 29, 2012 BY CURTIS CHERNE, P.E. HAVE BEEN ADDRESSED.

THE RECORD INFORMATION PRESENTED HEREON IS NOT NECESSARILY COMPLETE AND INTENDED ONLY TO VERIFY SUBSTANTIAL COMPLIANCE OF THE GRADING AND DRAINAGE ASPECTS OF THIS PROJECT. THOSE RELYING ON THIS RECORD DOCUMENT ARE ADVISED TO OBTAIN INDEPENDENT VERIFICATION OF ITS ACCURACY BEFORE USING IT FOR ANY OTHER PURPOSES.

GILBERT ALDAZ, NMPE 10848
DATE 09-10-12

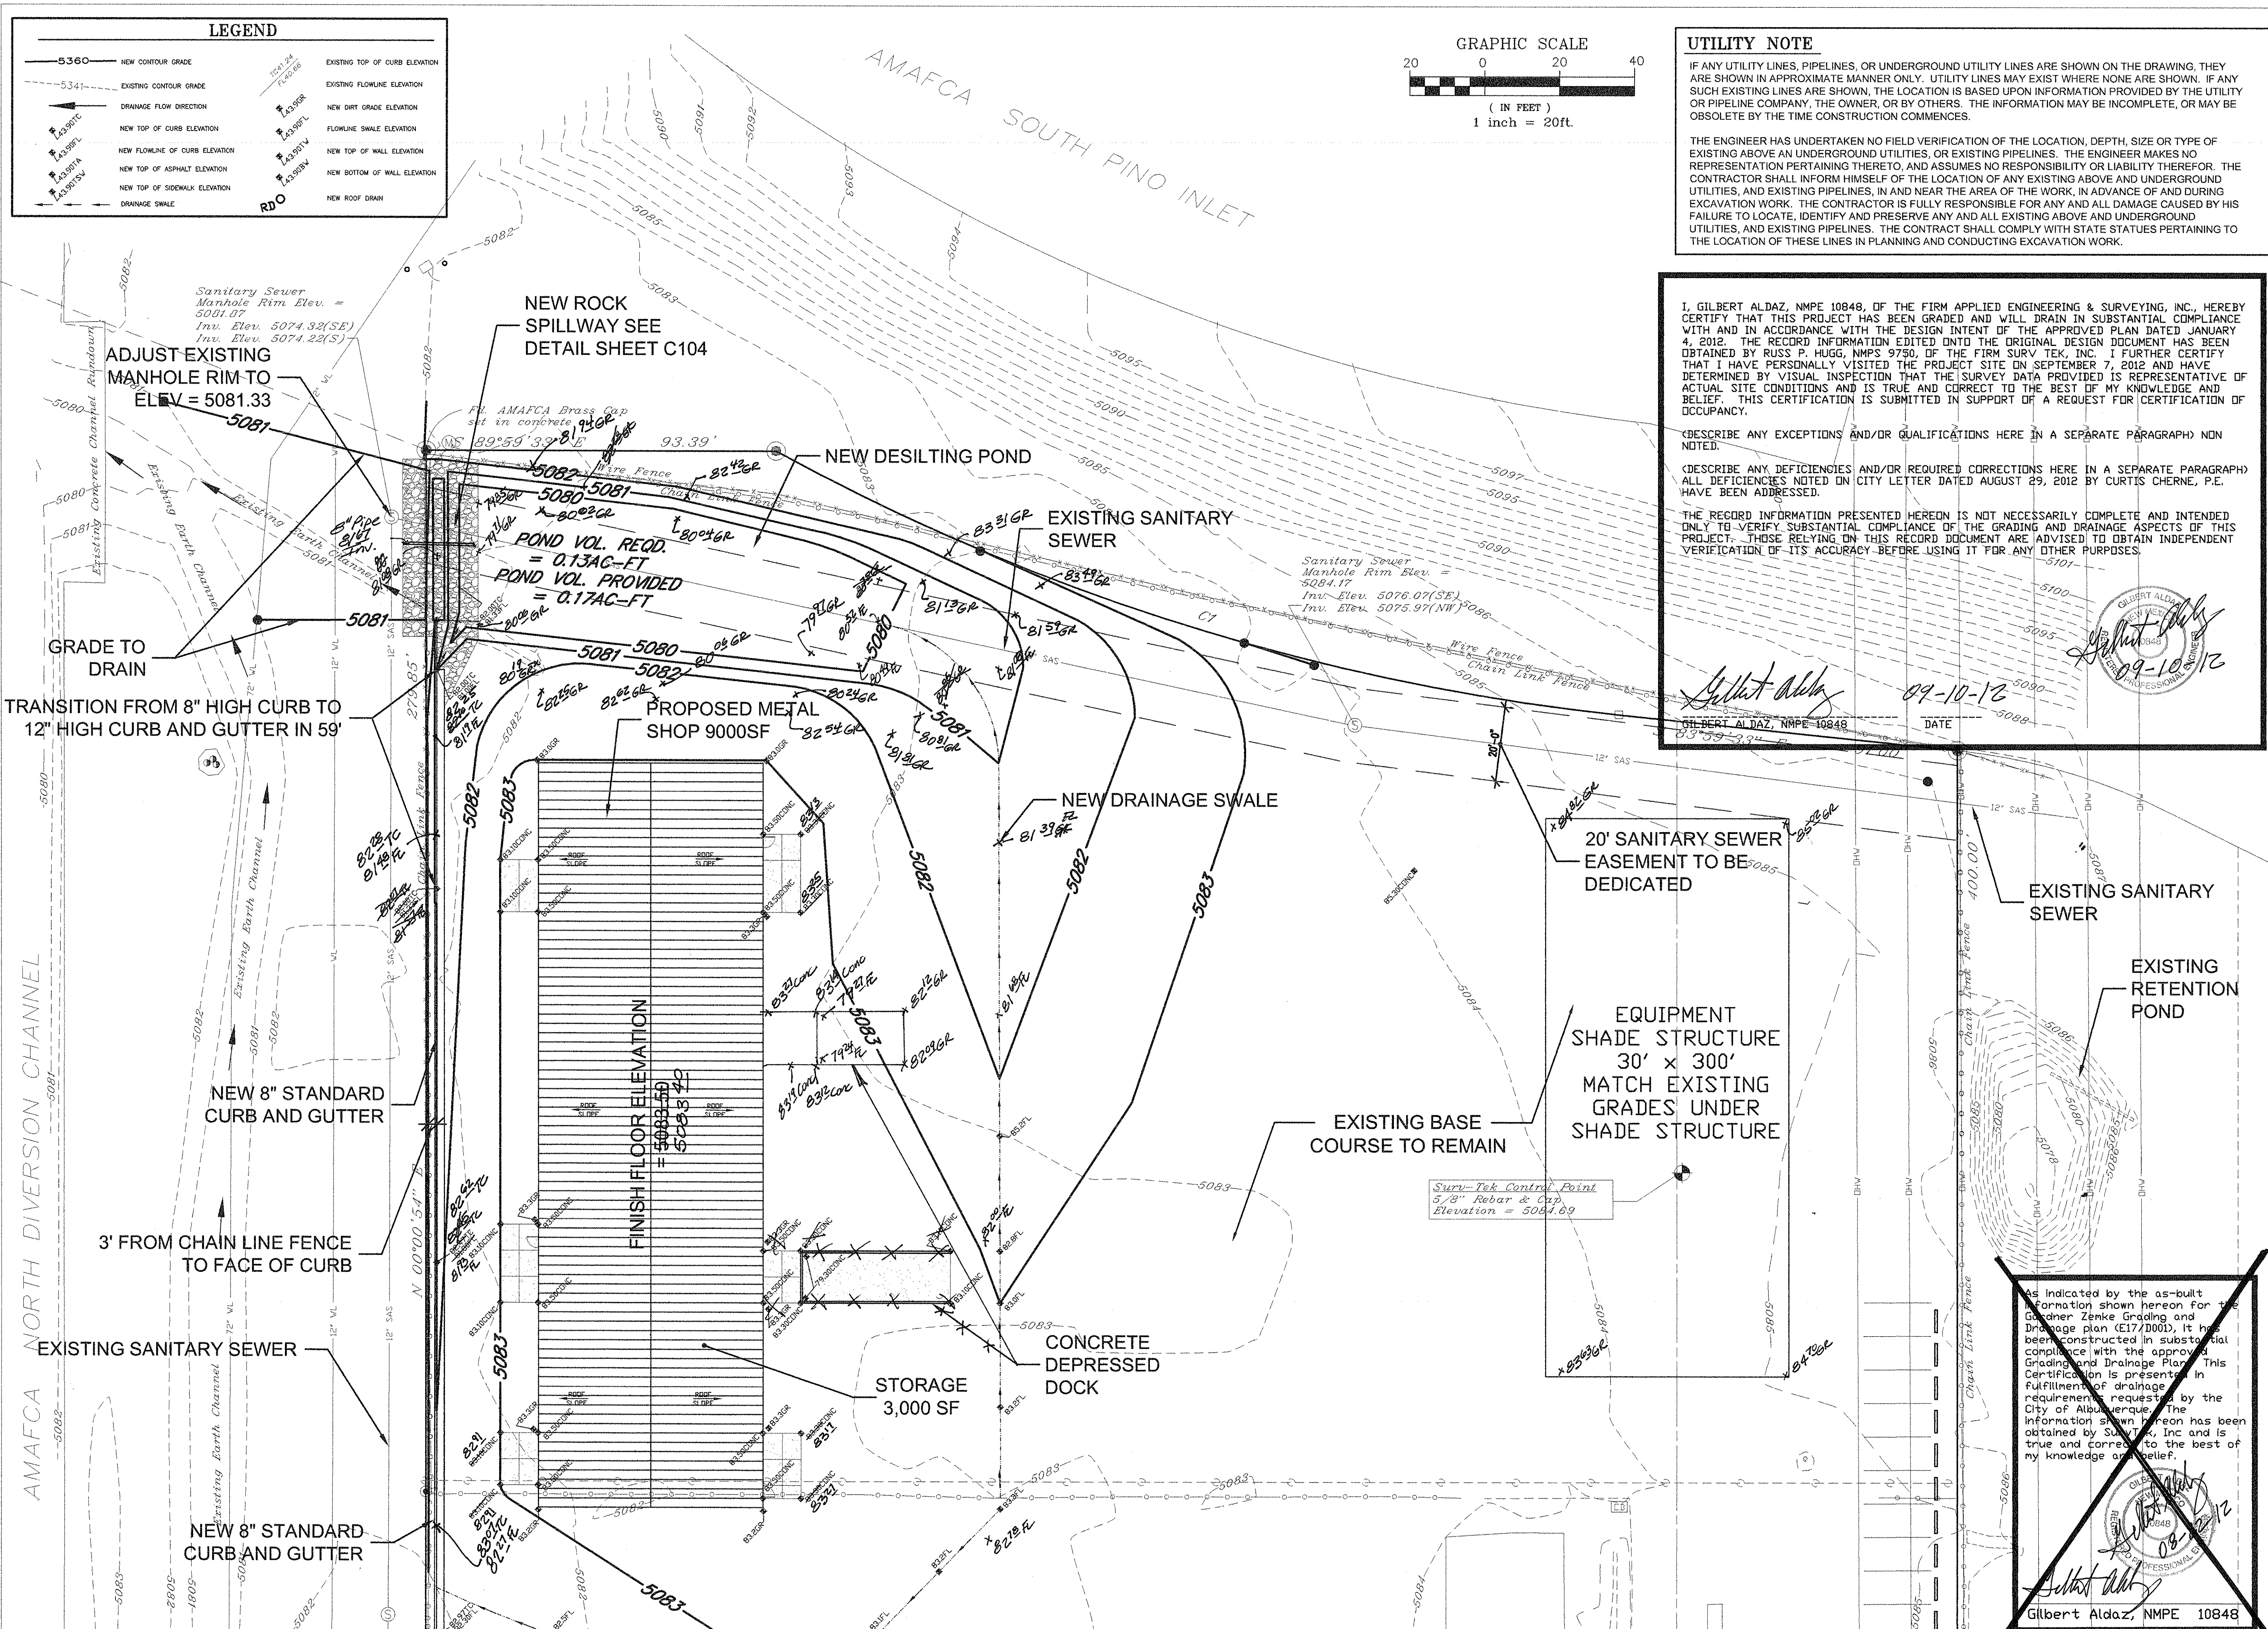

GRADING PLAN - NORTH HALF

SCALE: 1" = 20'



CLAUDIO VIGIL ARCHITECTS


1801 Rio Grande Boulevard, N.W.
Albuquerque, New Mexico
Phone: (505) 842-1113
Fax: (505) 842-1330

OWNERSHIP OF INSTRUMENTS OF SERVICE
All design concepts, details, specifications, plans, computer files, field data, notes and other documents and instruments prepared by Claudio Vigil Architects, P.C. as instruments of service shall remain the property of Claudio Vigil Architects, P.C. Claudio Vigil Architects, P.C. shall retain all common law, statutory and other reserved rights, including the copyright thereto.

CONSULTANTS

APPLIED ENGINEERING AND SURVEYING, INC.
CIVIL ENGINEERING, LAND PLANNING AND SURVEYING

PROFESSIONAL SEAL

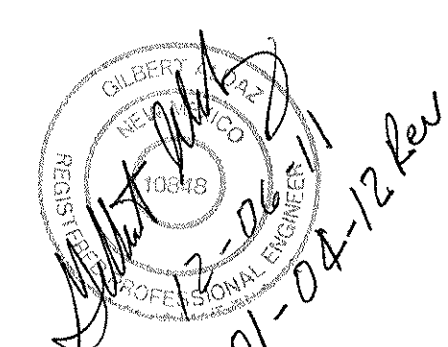

Gardner Zemke
Electrical and Mechanical Contractors

ADDITIONS & RENOVATIONS

6821 ACADEMY PARKWAY WEST
ALBUQUERQUE, NM 87109

MARK	DATE	DESCRIPTION

PROJECT NUMBER: 09255
DRAWING FILE:
CHECK BY:
COPYRIGHT: CLAUDIO VIGIL ARCHITECTS 2010
DATE: NOVEMBER 1, 2010

SHEET TITLE
GRADING & DRAINAGE PLAN - NORTH HALF

SHEET NUMBER
C102