

City of Albuquerque

P.O. BOX 1293 ALBUQUERQUE, NEW MEXICO 87103

August 31, 1994

R.G. Lee, Jr., P.E. Lee Engineering 8225 Connecticut NE Albuquerque, N.M. 87110

RE: ENGINEER'S CERTIFICATION FOR TAYLOR MARINE (E-17/D6)
RECEIVED AUGUST 25, 1994 FOR CERTIFICATE OF OCCUPANCY APPROVAL
ENGINEER'S STAMP DATED 8/23/94

Dear Mr. Lee:

Based on the information included in the submittal referenced above, City Hydrology accepts the Engineer's Certification and approves a Certificate of Occupancy for Taylor Marine at 6001 Pan American NE.

If I can be of further assistance, You may contact me at 768-2727.


Sincerely,

John P. Curtin, P.E.

Civil Engineer/Hydrology

xc: Andrew Garcia

WPHYD/8097/JPC

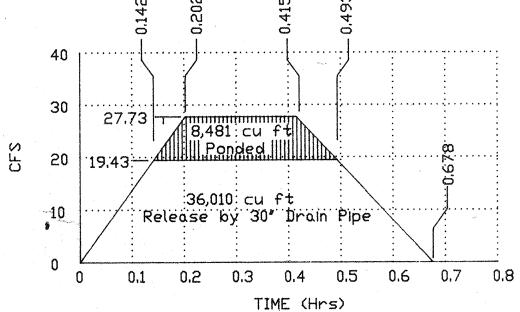

D. POND VOLUME CALCULATONS (Average End Area Method)

Contour	Surface Area	Average Area	Volume cu ft
5170.10	10,985		
5170	10,265	10,625	1,063
5169	4,444	7,354	7,354
5168.62	6.2	2,225	845
TOTAL POND VOLUME			9262

9262 > 8481 CFS

Erosion control measures:

THE CONTRACTOR SHALL BE HELD RESPONSIBLE FOR MANAGEMENT OF STORM RUNOFF DURING CONSTRUCTION; HE SHALL INSURE THAT THE FOLLOWING MEASURES ARE TAKEN: ADJACENT PROPERTY SHALL BE PROTECTED AT ALL TIMES BY CONSTRUCTION OF BERMS, DIKES, SWALES, PONDS AND OTHER LEAVE THE SITE AND ENTERING ADJACENT PROPERTY

ADJACENT PUBLIC RIGHT--OF-WAYS SHALL BE PROTECTED AT ALL TIMES FROM STORM WATER RUNOFF FROM THE SITE. NO SEDIMENT BEARING WATER SHALL BE PERMITTED TO ENTER THE PUBLIC

- THE CONTRACTOR SHALL IMMEDIATELY AND THOROUGHLY REMOVE ANY

-EXISTING CHAINLINK FENCE

73.00 TW

SINCE THE BEGINNING OF THE PREVIOUS DEVELOPMENT THIS SITE WAS THEN REPLATED INTO TWO PARCELS. THE NEW DEVELOPMENT CONSISTS OF THREE (3) NEW WAREHOUSES AND OFFICE COMPLEX. THE INTENT OF THE NEW DEVELOPMENT IS TO DUPLICATE THE DRAINAGE SCHEME OF THE ORIGINAL PLAN. ALL GENERATED AND OFF-SITE RUNOFF ACCEPTED WILL BE DRAINED TO THE REAR OF THE LOT AND DISCHARGED INTO THE BEAR CANYON ARROYO VIA THE EXISTING DRAINAGE SYSTEM. THE NEW DEVELOPMENT DOES LIE AT THE BOTTOM OF THIS WATERSHED WHICH DRAINS INTO THE BEAR CANYON ARROYO, THEREFORE FREE DISCHARGE FROM THIS SITE IS RECOMMENDED AND WILL HAVE NOMINAL ADVERSE IMPACT ON DOWNSTREAM


STORM DRAIN CAPACITY

STORM DRAIN INLET CAPACITY: Q = Ca/2gh

30" CMP STORM DRAIN CAPACITY: Using Manning's Equation

30" CMP FLOWING FULL WILL CARRY 19.43.

C. REQUIRED PONDING (Using Drain Pipe Capacity)

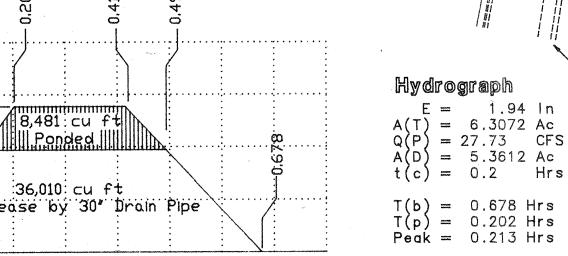

Contour	Surface Area	Average Area	Volume cu ft
5170.10	10,985		
5170	10,265	10,625	1,063
5169	4,444	7,354	7,354
5168.62	6.2	2,225	845
TOTAL PO	9262		

MAXIMUM WATER SURFACE ELEVATION(WSEL) = 5170.10(MSL)

TEMPORARY GRADING AS REQUIRED TO PREVENT STORM RUNOFF TO

OR ALL SEDIMENT WITHIN THE PUBLIC STREETS THAT HAVE BEEN

ERODED FROM THE SITE AND DEPOSITED THERE. S 86°48\21"

ASPHAL1

76.50 TCF ASPHALT

CONCRETE DOCK

73.2 TW/FL

RETAINING WALL

WAREHOUSE FINISHED FLOOR 5174.0

GRA VEL · RETAINING WALL 76.40 TC 75.90 TA MATCH EXISTING ASPHAL

EXISTING 30" CMP DRAIN PIPE IN A 15' PRIVATE DRAINAGE EASEMENT

TO BEAR CANYON ARROYO GENERAL NOTES:

TWO (2) WORKING DAYS PRIOR TO ANY EXCAVATION CONTRACTOR MUST CONTACT LINE LOCATING SERVICE AT 765-1234 FOR LOCATION OF EXISTING UTILITIES.

PRIOR TO CONSTRUCTION , THE CONTRACTOR SHALL EXCAVATE AND VERIFY THE HORIZONTAL AND VERTICAL LOCATIONS OF ALL POTENTIAL OBSTRUCTIONS. SHOULD A CONFLICT EXIST, THE CONTRACTOR SHALL NOTIFY THE ENGINEER SO THAT THE CONFLICT CAN BE RESOLVED WITH A MINIMUM AMOUNT OF DELAY.

ALL WORK ON THIS PROJECT SHALL BE PERFORMED IN ACCORDANCE WITH APPLICABLE FEDERAL, STATE AND LOCAL LAWS, RULES, AND REGULATIONS CONCERNING CONSTRUCTION SAFETY AND HEALTH. ALL CONSTRUCTION WITHIN CITY RIGHT-OF-WAY SHALL BE

PERFORMED IN ACCORDANCE WITH APPLICABLE CITY OF ALBUQUERQUE STANDARDS AND PROCEDURES. REMOVE BEEHIVE GRATE AND FRAME AND INSTALL TRAFFIC BEARING GRATE PER MANUFACTURES SPECIFICATIONS.

Symbol Legend

ASPHALT.

5102---EXISTING CONTOUR AS BUILT SPOT ELEVATION PROPOSED SPOT ELEVATION PROPERTY LINE page and the second section of the secti EASEMENT LINE and along the time that the constant was able to the test and the time that along the time FLOW DIRECTION EXISTING SPOT ELEVATION

DOWN SPOUT (NO TO SCALE)

GRADING & DRAINAGE PLAN SCALE: 1"=40.0' N

DRAINAGE CALCULATION

A. SECTION 22.2, HYDROLOGY OF THE DEVELOPMENT PROCESS MANUAL, VOLUME 2, DESIGN CRITERIA FOR THE CITY OF ALBUQUERQUE, NEW MEXICO IN COOPERATION WITH

BERNALILLO COUNTY, NEW MEXICO AND THE ALBUQUERQUE METROPOLITAN ARROYO FLOOD CONTROL AUTHORITY. B. FLOODWAY, FLOOD BOUNDARY AND FLOODWAY MAP, CITY OF ALBUQUERQUE, NEW MEXICO, PANEL 16 OF 50.

C. ZONE ATLAS PAGE E-17-Z.

II GENERAL INFORMATION: A. SITE LIES IN ZONE TWO(2) (SEE REF. A, PAGE A-1) B. 100 YEAR, 6 HOUR RAINFALL CRITERIA C. TIME OF CONCENTRATION, To; To = 0.2 hr(12 MINUTES).

ON-SITE FLOW CALCULATIONS

- OFF-SITE FLOW

LIMITS

III IMPERVIOUSNESS: TREATMENT TYPES OF SURFACES SQ.FT ACRES SQ.FT ACRES UNDEVELOPED 0.0000 0.0000 LANDSCAPING 0.0000 22200 0.5096 COMPACTED/VACANT 221743 8450 0.1940 5.0905 200 191293 4.3915 0.0046

TOTAL AREA (TA) 221943

IV PEAK DISCHARGE 100 YEAR (REF. A, TABLE A-9): TREATMENT TYPES OF EXISTING SURFACES CFS/Ac UNDEVELOPED 1.59 LANDSCAPING 2.28 2.28 COMPACTED/VACANT 3.14 15.98 3.14 0.61 4.70 4.70 IMPERVIOUS 0.02 20.64 PEAK DISCHARGE FROM SITE 16.01 CFS 22.41 CFS

5.0951

221943 5.0951

PEAK DISCHARGE 10 YEAR (REF. A, TABLE A-9): TREATMENT TYPES OF EXISTING SURFACES Qp(10) CFS/Ac CFS/Ac UNDEVELOPED LANDSCAPING 0.95 0.00 COMPACTED/VACANT 8.70 IMPERVIOUS 3.14 0.01 3.14 13.79 PEAK DISCHARGE FROM SITE 8.72 CFS 14.61 CFS VI WEIGHTED "E" 100 YEAR, 6 HR. (REF. A, TABLE A-8): TYPES OF EXISTING

TREATMENT **SURFACES** ExA/TA ExA/TA UNDEVELOPED 0.00 0.53 ANDSCAPING 0.78 0.00 0.78 0.08 1.13 1.13 COMPACTED/VACANT 0.04 IMPERVIOUS 0.00 2.12 1.83 WEIGHTED "E" FACTOR 1.13 IN 1.95 IN

VI. VII VOLUME 100 YEAR, V(360) (REF. A, TABLE A-8): EXISTING

1.13 x 5.0951/12 0.48 AC. FT. 20916.13 CU.FT $1.95 \times 5.0951/12$ 0.83 AC. FT. 36033.81 CU.FT

OFF-SITE FLOW CALCULATIONS

VIII IMPERVIOUSNESS: TREATMENT TYPES OF EXISTING SQ.FT ACRES SURFACES SQ.FT ACRES UNDEVELOPED 0.0000 0.0000 0 LANDSCAPING 0.0000 0.0000 COMPACTED/VACANT 10560 0.2424 10560 0.2424 IMPERVIOUS 42240 0.9697 42240 0.9697 52800 52800 1.2121 TOTAL AREA (TA) 1.2121

IX PEAK DISCHARGE 100 YEAR (REF. A, TABLE A-9): TYPES OF EXISTING TREATMENT PROPOSED CFS/Ac Qp(100) SURFACES CFS/Ac Qp(100) UNDEVELOPED 1.59 1.59 0.00 LANDSCAPING 2.28 0.00 2.28 0.00 COMPACTED/VACANT 0.76 0.76 3.14 3.14 4.70 4.56 4.70 4.56 IMPERVIOUS PEAK DISCHARGE FROM SITE 5.32 CFS 5.32 CFS

X PEAK DISCHARGE 10 YEAR (REF. A, TABLE A-9): TYPES OF EXISTING TREATMENT SURFACES CFS/Ac Qp(10) CFS/Ac Qp(10) UNDEVELOPED 0.38 LANDSCAPING 0.00 0.95 0.95 COMPACTED/VACANT 1.71 0.41 0.41 3.04 IMPERVIOUS 3.14 3.14 PEAK DISCHARGE FROM SITE 3.46 CFS 3.46 CFS XI WEIGHTED "E" 100 YEAR, 6 HR. (REF. A, TABLE A-8): TYPES OF EXISTING TREATMENT SURFACES ExA/TA ExA/TA 0.53 0.00

0.78

1.13

2.12

0.19 AC. FT.

0.19 AC. FT.

8456.80 CU.FT

8456.80 CU.FT

EXTENDED CURB UNDEVELOPED 70.10 TG LANDSCAPING COMPACTED/VACANT IMPERVIOUS EXIST CURB WEIGHTED "E" FACTOR & GUTTER XII VOLUME 100 YEAR, V(360) (REF. A, TABLE A-8): EXISTING 1.92 x 1.2121/12

SECTION A-A

NOT TO SCALE

XIII PEAK DISCHARGE SUMMARY 100 YR - 6 HR: ON-SITE OFF-SITE TOTAL 27.73 CFS 5.32

 $1.92 \times 1.2121/12$

XIV VOLUME SUMMARY 100 YR - 6 HR ON-SITE OFF-SITE TOTAL 360334 8457 44,491 CU FT

LEGAL DESCRIPTION

PARCEL A-1 ALBUQUERQUE INDUSTRIAL PARK ALBUQUERQUE, BERNALILLO COUNTY NEW MEXICO.

BENCH-MARK INFORMATION

0.00

0.23

1.70

1.92 IN

0.78

1.13

2.12

0.00

0.23


1.70

1.92 IN

TEMPORARY BENCH-MARK BEING THE TOP OF CURB SPRAY PAINTED ORANGE (B TBM) BEARS ELEVATION 5171.80 MSL, REFERENCE TO CITY BENCH-MARK STA 1-25-17. LOCATED SOUTH OF THIS PROPERTY ON THE WEST SIDE OF THE FRONTAGE ROAD BEARS ELEVATION 5171.1(MSL).

ABBREVIATION LEGEND

TOP OF CONC Pad(APRON) - TCA TOP OF CURB TOP OF ASPHALT - TA FLOW LINE - FL TOP OF WALL - *TA*

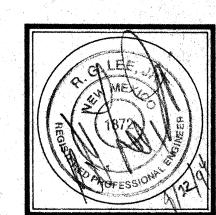

ob Number 9314

Date OCTOBER 15, 1993

Revised

JANUARY 28, 1994

AIN.

ADIN

100 100 ER and SSO

H 0 A R MEXIC MEW