
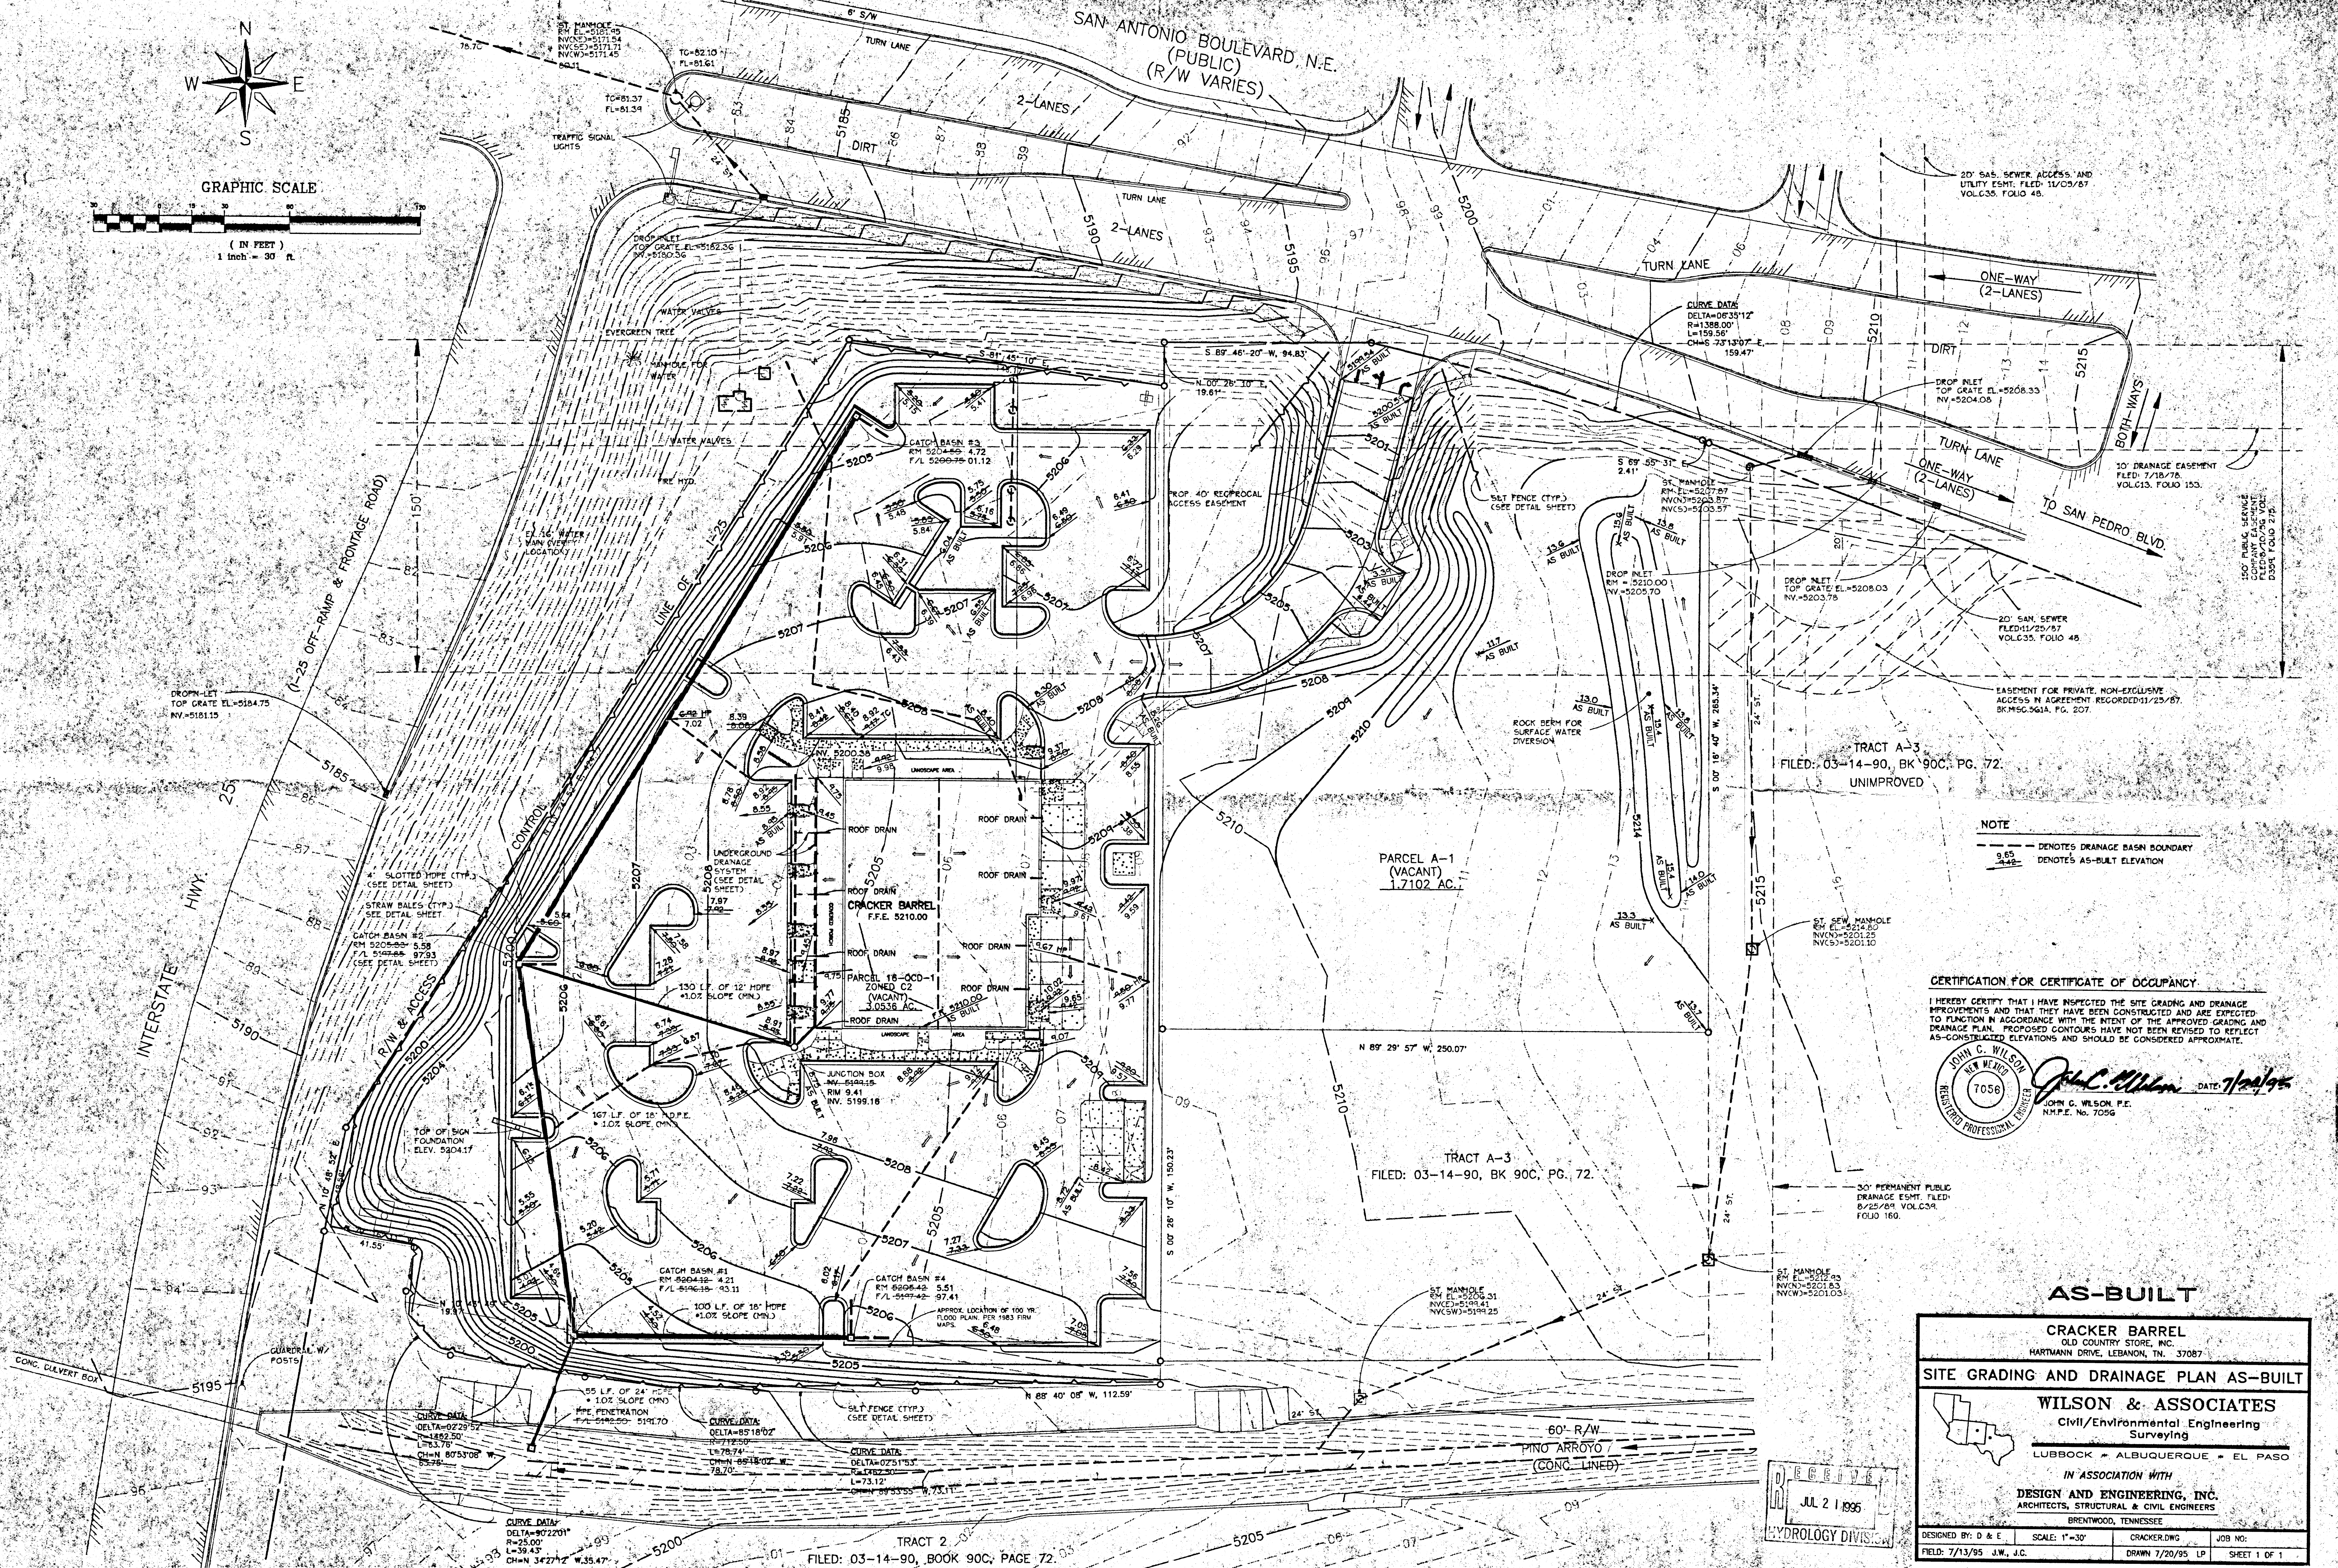


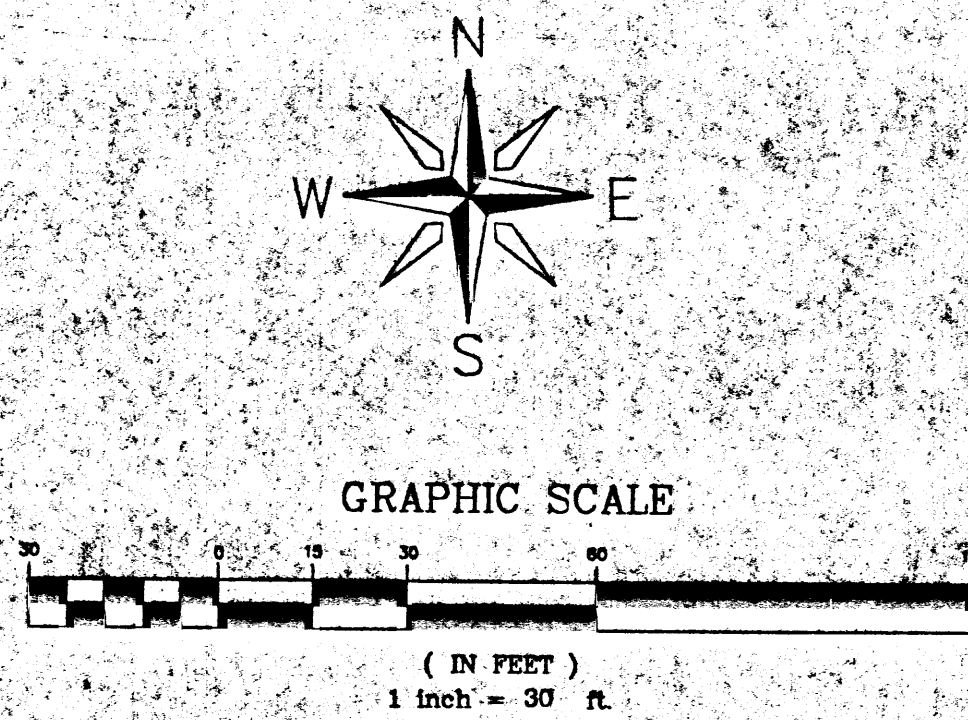


NOTE
--- DENOTES DRAINAGE BASIN BOUNDARY
9.65
4.42
--- DENOTES AS-BUILT ELEVATION

CERTIFICATION FOR CERTIFICATE OF OCCUPANCY
I HEREBY CERTIFY THAT I HAVE INSPECTED THE SITE GRADING AND DRAINAGE IMPROVEMENTS AND THAT THEY HAVE BEEN CONSTRUCTED AND ARE EXPECTED TO FUNCTION IN ACCORDANCE WITH THE INTENT OF THE APPROVED GRADING AND DRAINAGE PLAN. PROPOSED CONTOURS HAVE NOT BEEN REVISED TO REFLECT AS-CONSTRUCTED ELEVATIONS AND SHOULD BE CONSIDERED APPROXIMATE.

JOHN C. WILSON
NEW MEXICO
7056
REGISTERED PROFESSIONAL ENGINEER
JOHN C. WILSON, P.E.
N.M.P.E. No. 7056
DATE: 7/12/95

AS-BUILT

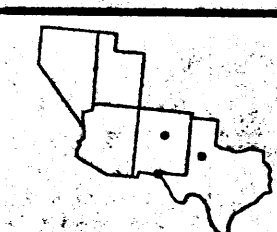

WILSON & ASSOCIATES
Civil/Environmental Engineering
Surveying
LUBBOCK • ALBUQUERQUE • EL PASO

CRACKER BARREL
OLD COUNTRY STORE, INC.
HARTMANN DRIVE, LEBANON, TN. 37087


SITE GRADING AND DRAINAGE PLAN AS-BUILT

IN ASSOCIATION WITH
DESIGN AND ENGINEERING, INC.
ARCHITECTS, STRUCTURAL & CIVIL ENGINEERS
BRENTWOOD, TENNESSEE

DESIGNED BY: D & E	SCALE: 1"=30'	CRACKER.DWG	JOB NO:
FIELD: 7/13/95 J.W., J.C.		DRAWN 7/20/95 LP	SHEET 1 OF 1


RECEIVED
JUL 21 1995
HYDROLOGY DIVISION

6' MH
to Street
to Shell
to duct
to joint in MH

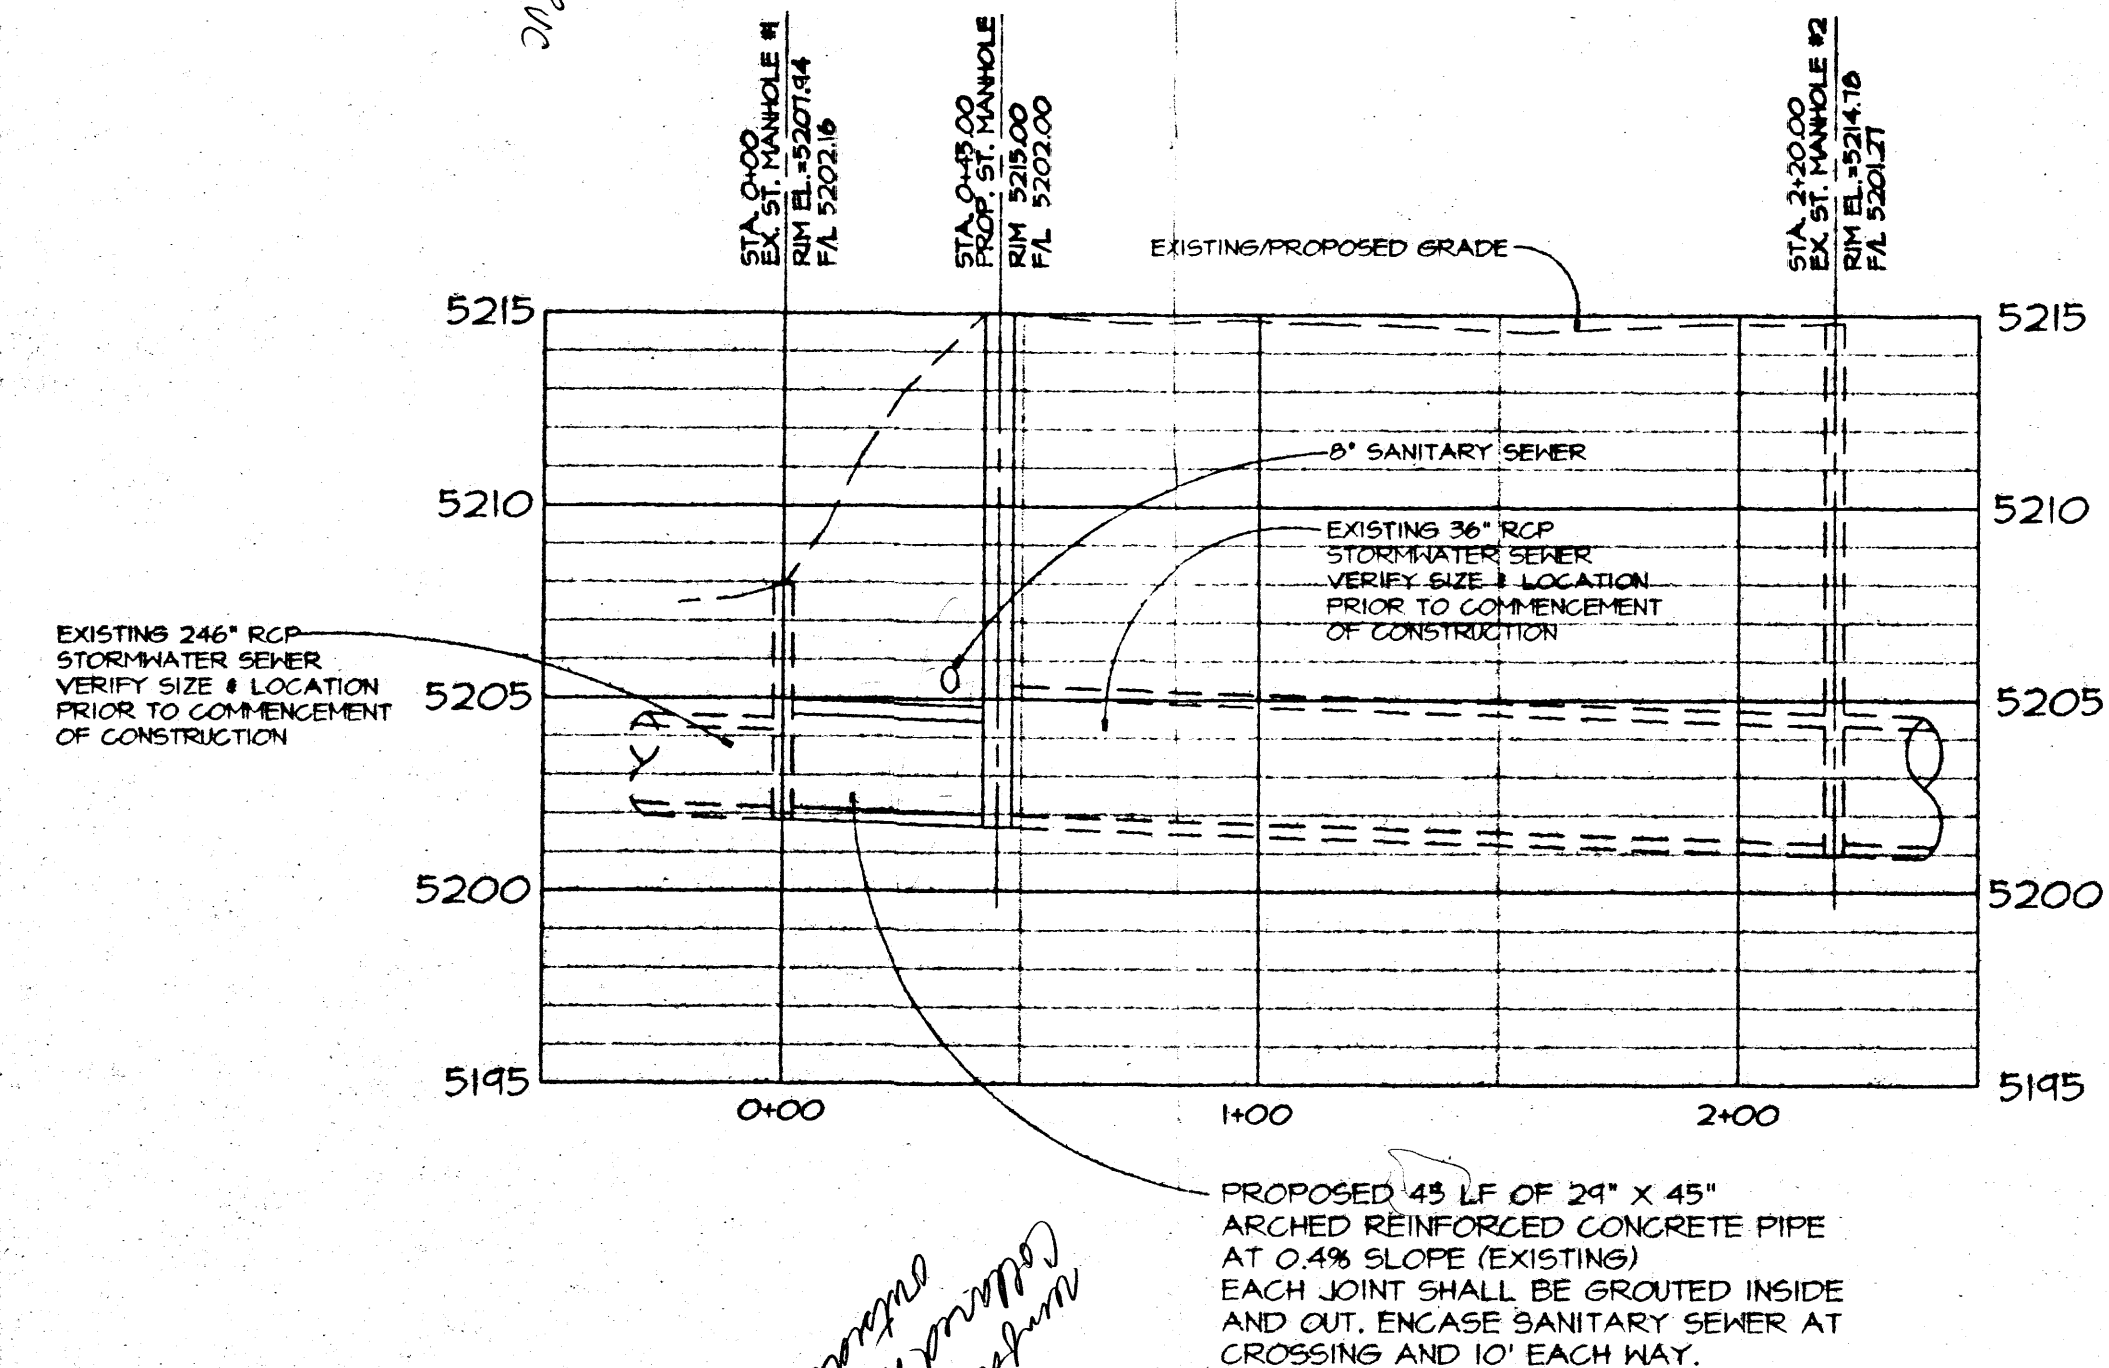

PROPOSED STORMWATER PROFILE

SCALE 1" = 40' H & 1" = 5' V

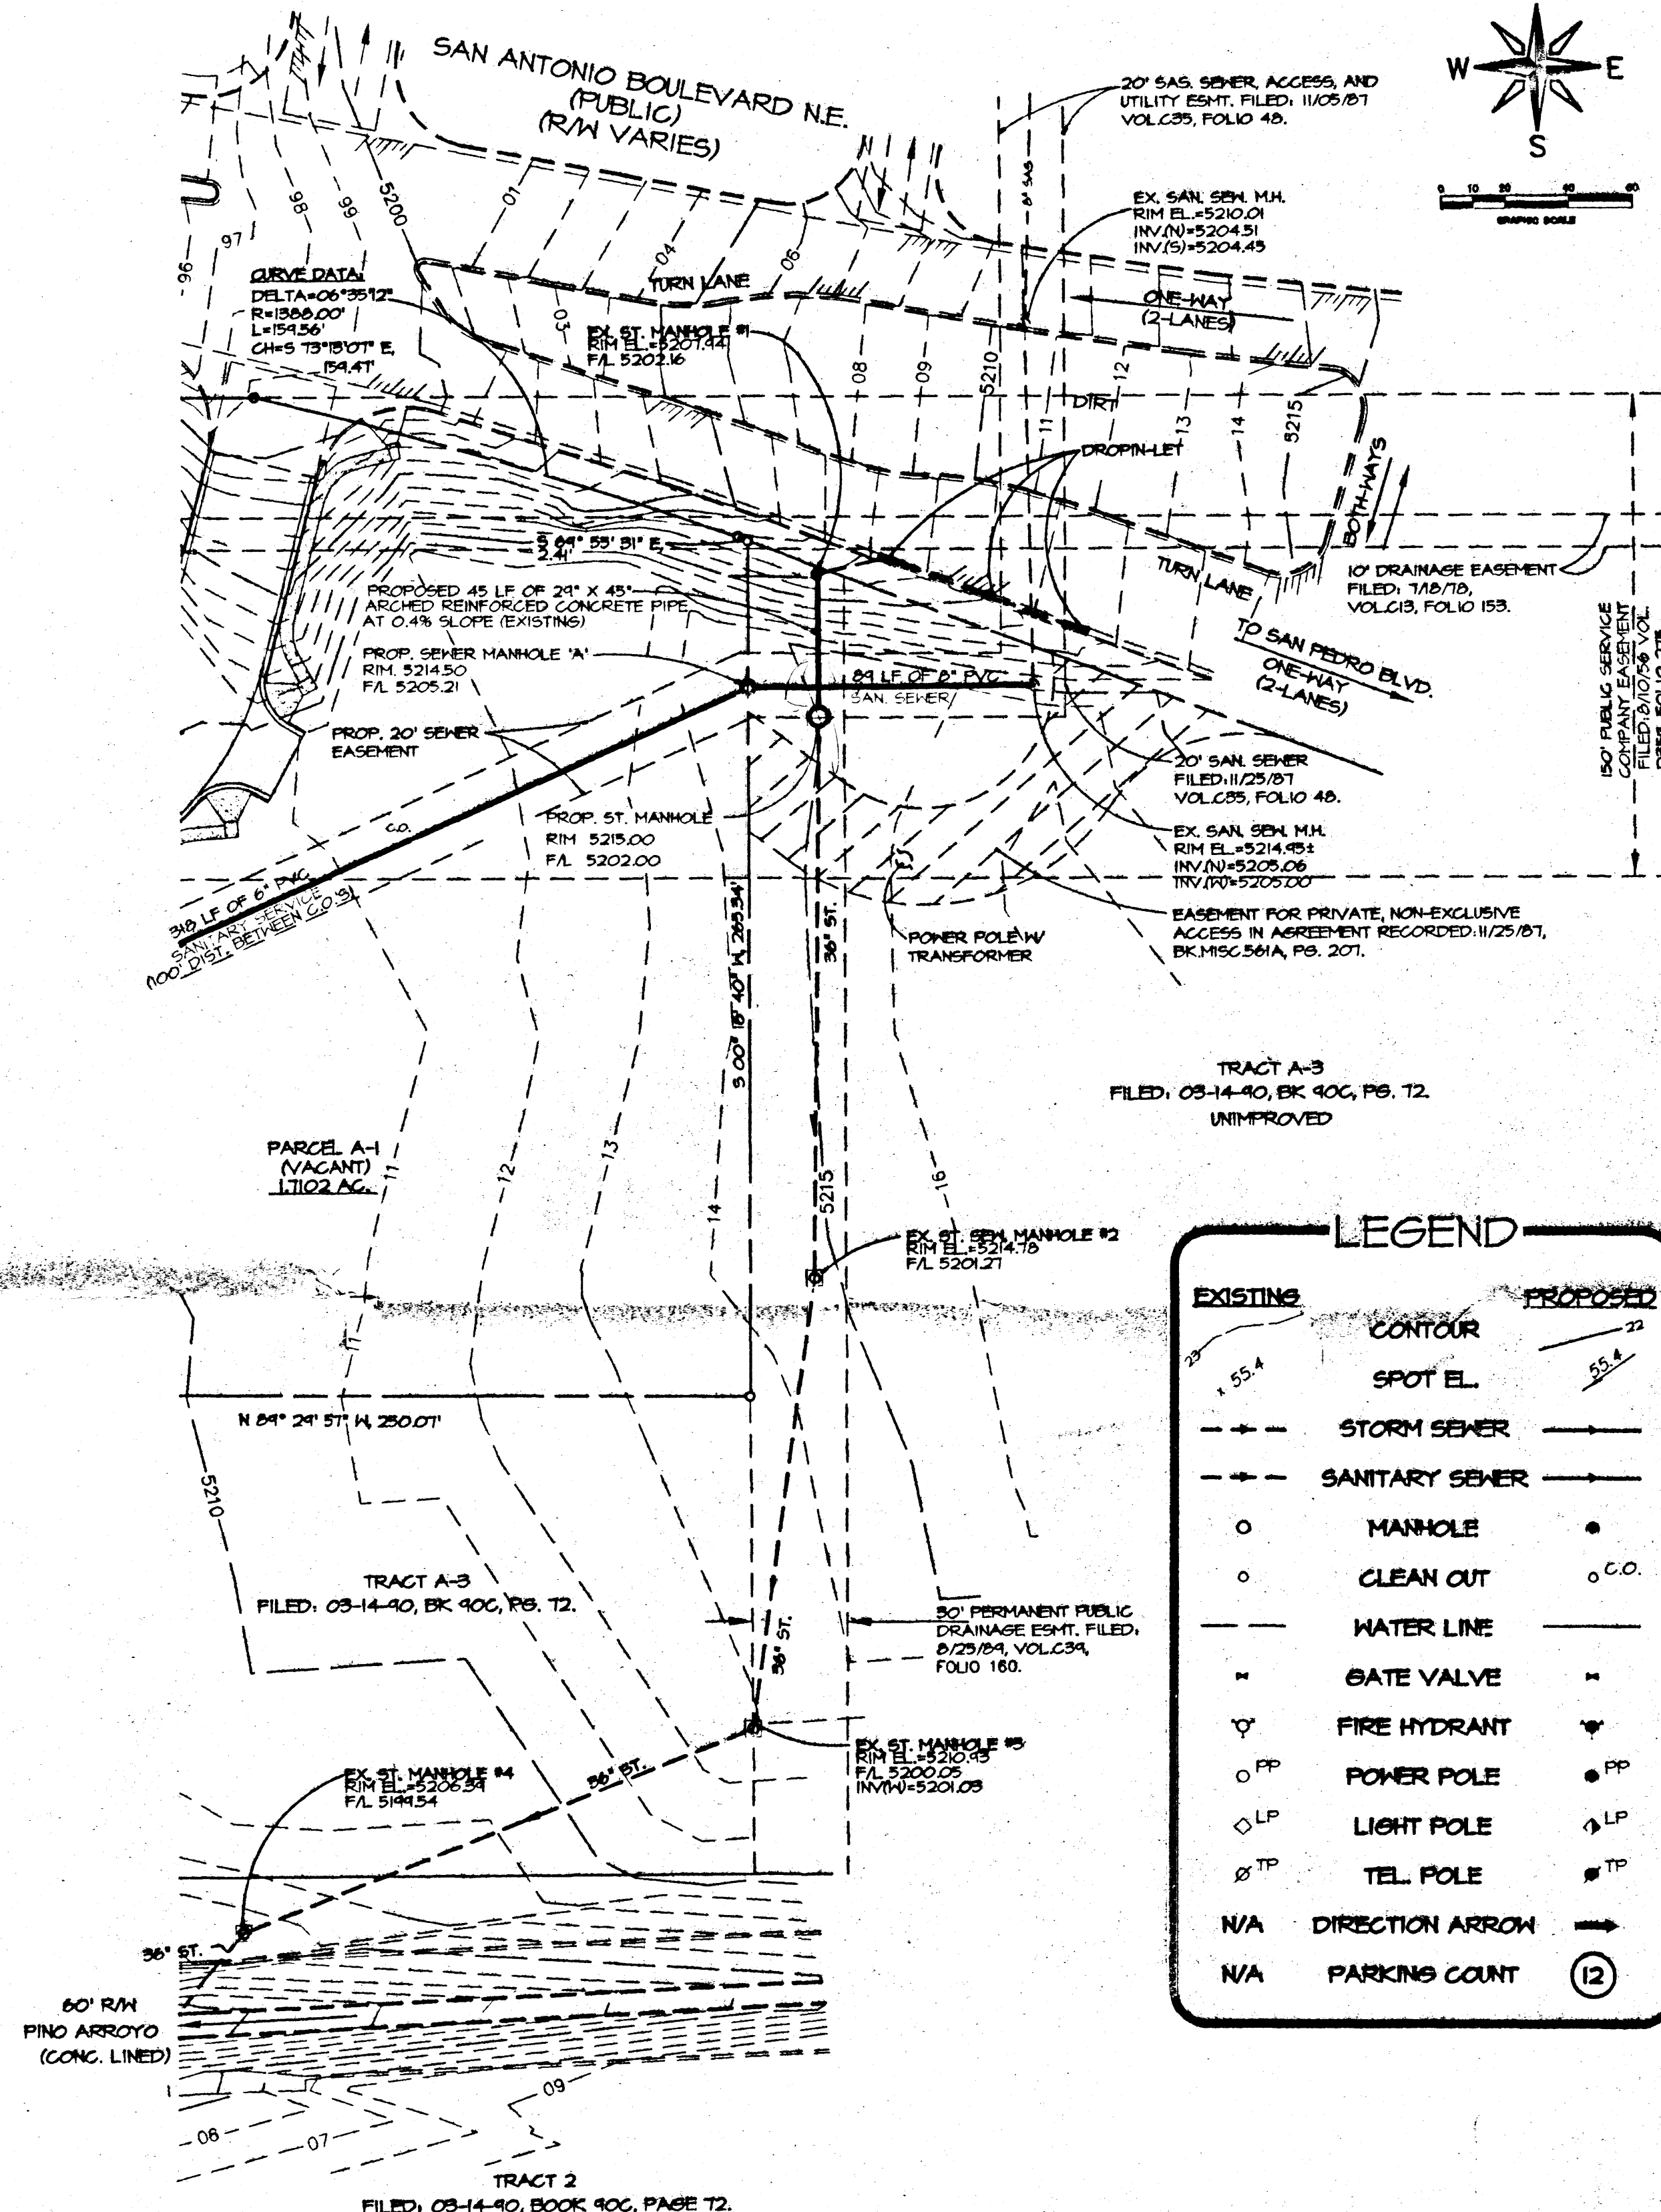

LEGEND	
EXISTING	PROPOSED
CONTOUR	CONTOUR
SPOT EL.	SPOT EL.
STORM SEWER	STORM SEWER
SANITARY SEWER	SANITARY SEWER
MANHOLE	MANHOLE
CLEAN OUT	CLEAN OUT
WATER LINE	WATER LINE
GATE VALVE	GATE VALVE
FIRE HYDRANT	FIRE HYDRANT
POWER POLE	POWER POLE
LIGHT POLE	LIGHT POLE
TEL. POLE	TEL. POLE
DIRECTION ARROW	DIRECTION ARROW
PARKING COUNT	PARKING COUNT

DETAILS AS PROVIDED BY THE CITY OF ALBUQUERQUE
STANDARD SPECIFICATIONS FOR PUBLIC WORKS
CONSTRUCTION, 1986 EDITION, AS AMENDED THROUGH UPDATE #5
THE FOLLOWING DETAILS APPLY:
DWS. 2231-CONNECTION TO EX. STORM INLET
DWS. 2102-SEWER MANHOLE FOR STORMWATER (6")

PROPOSED STORMWATER PLAN

SCALE 1" = 40'

E 18 VICINITY MAP																									
1. ALL UTILITIES AND UTILITY SERVICE LINES SHALL BE INSTALLED PRIOR TO PAVING. 2. BACKFILL COMPACTION SHALL BE ACCORDING TO THE SPECIFIED STREET TYPE. 3. TACK COAT REQUIREMENTS SHALL BE DETERMINED BY THE CITY ENGINEER. 4. SIDEWALKS AND WHEELCHAIR RAMPS WITHIN THE CURB RETURN SHALL BE CONSTRUCTED WHEREVER A NEW CURB RETURN IS CONSTRUCTED. 5. IF CURB IS DEEPER FOR A DRIVEWAY, THE DRIVEWAY SHALL BE CONSTRUCTED PRIOR TO ACCEPTANCE OF CURB AND GUTTER. 6. ALL SLOPE DRAINAGE FACILITIES SHALL BE COMPLETED PRIOR TO FINAL ACCEPTANCE. 7. THE CONTRACTOR SHALL BE RESPONSIBLE FOR TIMING AND COORDINATION OF WATER SAUTOFF. AT LEAST FIVE (5) WORKING DAYS PRIOR TO CONSTRUCTION, CONTRACTOR SHALL CONTACT THE WATER SYSTEMS DIVISION, 287-8000, TO INITIATE PRELAYERING OF NON-PRESSURIZED CONNECTION IN ORDER TO COMPLETE THIS CONNECTION.																									
GENERAL NOTES 1. THREE (3) WORKING DAYS PRIOR TO BEGINNING CONSTRUCTION, THE CONTRACTOR SHALL SUBMIT TO CONSTRUCTION COORDINATION DIVISION A DETAILED CONSTRUCTION SCHEDULE. TWO (2) WORKING DAYS PRIOR TO CONSTRUCTION, THE CONTRACTOR SHALL OBTAIN A DRAINAGE PERMIT FROM THE CONSTRUCTION COORDINATION DIVISION. THE PERMIT SHALL BE OBTAINED PRIOR TO ANY CONSTRUCTION ACTS PRIOR TO OCCUPANCY OF THE STANDARD SPECIFICATIONS. 2. ALL STREET STRIPS, ALTERNATE OR DESTROYED SHALL BE REPLACED IN KIND BY CONTRACTOR TO LOCATION AND IN KIND AS EXISTING OR AS INDICATED BY THE PLANS. 3. THE CONTRACTOR SHALL NOT DISTURB PERMANENT SURVEY MONUMENTS WITHIN THE CONVEYANCE OF THE PROJECT. ANY MONUMENTS THAT ARE DISTURBED WITHOUT PERMISSION, REPLACEMENT SHALL BE DONE BY CITY SURVEY SECTION. WHEN A CHANGE IS MADE IN THE FINISHED ELEVATIONS OF THE PAVEMENT IN ANY ROADWAY IN WHICH A PERMANENT SURVEY MONUMENT IS LOCATED, CONTRACTOR SHALL, AT HIS OWN EXPENSE, ADJUST THE MONUMENT COVER TO THE NEW GRADE UNLESS OTHERWISE SPECIFIED REFER TO SECTION 4.4 OF THE GENERAL CONDITIONS OF THE STANDARD SPECIFICATIONS.																									
NOTICE TO CONTRACTORS 1. ALL PUBLIC UTILITY AND ROAD WORK DETAILED ON THESE PLANS TO BE PERFORMED UNDER CONTRACT SHALL, EXCEPT AS OTHERWISE STATED OR PROVIDED FOR HEREON, BE CONSTRUCTED IN ACCORDANCE WITH THE CITY OF ALBUQUERQUE STANDARD SPECIFICATIONS FOR PUBLIC WORKS CONSTRUCTION, 1986 EDITION UPDATE #5. 2. TWO (2) WORKING DAYS PRIOR TO ANY EXCAVATION, THE CONTRACTOR SHALL COMPLY WITH THE CITY OF ALBUQUERQUE STANDARD SPECIFICATIONS FOR PUBLIC WORKS CONSTRUCTION, 1986 EDITION UPDATE #5, FOR LOCATION OF EXISTING UTILITIES. 3. PRIOR TO CONSTRUCTION, THE CONTRACTOR SHALL EXCAVATE AND VERIFY THE HORIZONTAL AND VERTICAL LOCATIONS OF ALL EXISTING UTILITIES AND LOCATIONS OF CONNECTION TO EXISTING UTILITIES. SHOULD A CONFLICT EXIST, THE CONTRACTOR SHALL NOTIFY THE ENGINEER IMMEDIATELY SO THAT THE CONFLICT CAN BE RESOLVED WITH A MINIMUM AMOUNT OF DELAY.																									
CITY OF ALBUQUERQUE PUBLIC WORKS DEPARTMENT ENGINEERING GROUP TITLE: CRACKER BARREL OLD COUNTRY STORE STORMWATER PLAN & PROFILE <table><tr><td>APPROVALS</td><td>ENGINEER</td><td>DATE</td><td>APPROVALS</td><td>ENGINEER</td><td>DATE</td></tr><tr><td>DRC CHAIR</td><td></td><td></td><td>LIQUID WASTE</td><td></td><td></td></tr><tr><td>TRANS. DEV.</td><td></td><td></td><td></td><td></td><td></td></tr><tr><td>HYDROLOGY</td><td></td><td></td><td>WATER</td><td></td><td></td></tr></table> DRAWING NO. 5213.90 MAP NO. E18 SHEET 4 OF 4		APPROVALS	ENGINEER	DATE	APPROVALS	ENGINEER	DATE	DRC CHAIR			LIQUID WASTE			TRANS. DEV.						HYDROLOGY			WATER		
APPROVALS	ENGINEER	DATE	APPROVALS	ENGINEER	DATE																				
DRC CHAIR			LIQUID WASTE																						
TRANS. DEV.																									
HYDROLOGY			WATER																						
AS BUILT INFORMATION <table><tr><td>CONTRACTOR</td><td>DATE</td></tr><tr><td>WORK</td><td>DATE</td></tr><tr><td>INSPECTED BY</td><td>DATE</td></tr><tr><td>FIELD AS BUILT BY</td><td>DATE</td></tr><tr><td>REVISIONS</td><td>DATE</td></tr><tr><td>CORRECTED BY</td><td>DATE</td></tr><tr><td>RECORDED BY</td><td>DATE</td></tr></table>		CONTRACTOR	DATE	WORK	DATE	INSPECTED BY	DATE	FIELD AS BUILT BY	DATE	REVISIONS	DATE	CORRECTED BY	DATE	RECORDED BY	DATE										
CONTRACTOR	DATE																								
WORK	DATE																								
INSPECTED BY	DATE																								
FIELD AS BUILT BY	DATE																								
REVISIONS	DATE																								
CORRECTED BY	DATE																								
RECORDED BY	DATE																								
BENCH MARKS <table><tr><td>TOP OF CONC. POST</td><td>STATIONED</td><td>DATE</td></tr><tr><td>ELEV. 5196.73 (MSJ)</td><td></td><td></td></tr></table>		TOP OF CONC. POST	STATIONED	DATE	ELEV. 5196.73 (MSJ)																				
TOP OF CONC. POST	STATIONED	DATE																							
ELEV. 5196.73 (MSJ)																									
FIELD NOTES <table><tr><td>NO.</td><td>BY</td><td>DATE</td></tr><tr><td></td><td></td><td></td></tr></table>		NO.	BY	DATE																					
NO.	BY	DATE																							
ENGINEER'S SEAL																									
REVISIONS <table><tr><td>NO.</td><td>DATE</td><td>REMARKS</td></tr><tr><td></td><td></td><td></td></tr></table>		NO.	DATE	REMARKS																					
NO.	DATE	REMARKS																							
DESIGNED BY: HKW DRAWN BY: HKW CHECKED BY: JAC DATE 4-10-95 DATE 4-10-95 DATE 4-11-95																									