


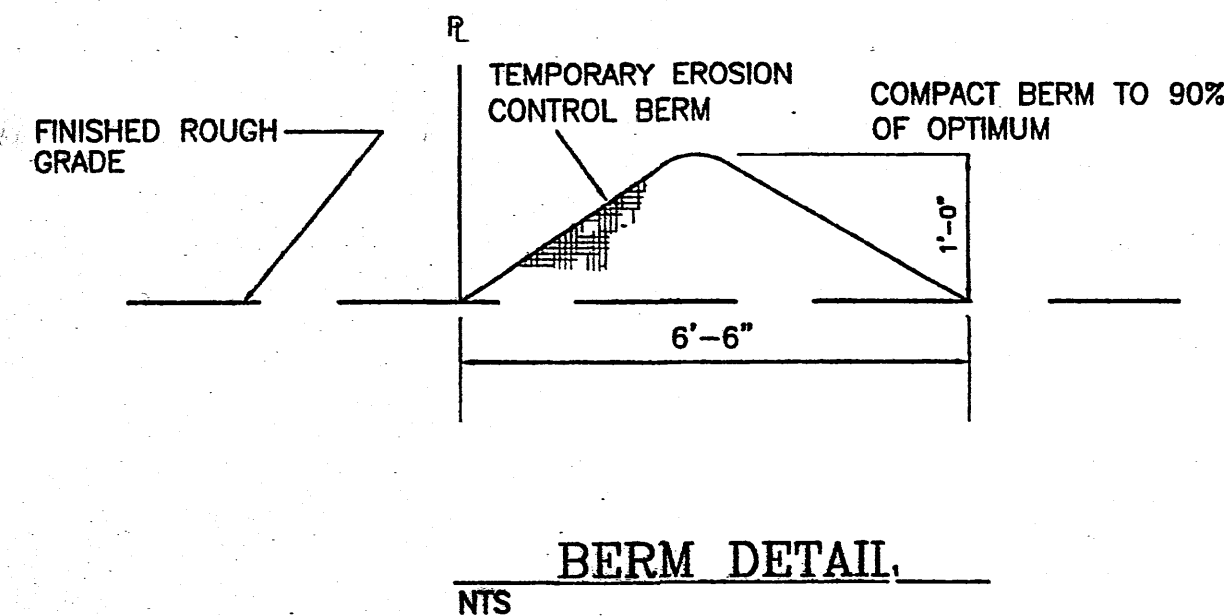

-
- EXISTING CURB & GUTTER
- PROPOSED CURB & GUTTER
- BOUNDARY LINE
- PROPOSED SIDEWALK
- PROPOSED PERIMETER WALL
- PROPOSED RETAINING WALL
- 5411
- EXISTING CONTOUR
- 5410
- EXISTING INDEX CONTOUR
- SLOPE TIE
- 5048.25
- PROPOSED SPOT ELEVATION
- 5048.25
- EXISTING SPOT ELEVATION
- CENTERLINE
- RIGHT-OF-WAY
- LOT LINES


NOTES:

1. ALL SPOT ELEVATIONS REPRESENT FLOWLINE ELEVATION UNLESS OTHERWISE NOTED.
2. ALL CURB AND GUTTER TO BE STANDARD PER COA STD DWG #2415A UNLESS OTHERWISE NOTED.
3. ALL DRIVEWAYS ENTRANCES SHALL BE PER COA STD DWG #2425.
4. ALL VALLEY GUTTERS SHALL BE COA STD DWG #2420.
5. ALL AREAS WITH SLOPES GREATER THAN 3:1 SHALL BE TREATED W/ LANDSCAPING TO ARMOUR AGAINST EROSION. 6" COBBLES MINIMUM.


EROSION CONTROL NOTES:

1. CONTRACTOR IS RESPONSIBLE FOR OBTAINING A TOPSOIL DISTURBANCE PERMIT PRIOR TO BEGINNING WORK.
2. CONTRACTOR IS RESPONSIBLE FOR MAINTAINING RUN-OFF ON SITE DURING CONSTRUCTION.
3. CONTRACTOR IS RESPONSIBLE FOR CLEANING ALL SEDIMENT THAT GETS INTO EXISTING RIGHT-OF-WAY.
4. REPAIR OF DAMAGED FACILITIES AND CLEANUP OF SEDIMENT ACCUMULATIONS ON ADJACENT PROPERTIES AND IN PUBLIC FACILITIES IS THE RESPONSIBILITY OF THE CONTRACTOR.
5. ALL EXPOSED EARTH SURFACES MUST BE PROTECTED FROM WIND AND WATER EROSION PRIOR TO FINAL (CITY) ACCEPTANCE OF ANY PROJECT.

I, David Soule, NMPE 14522, of the firm Rio Grande Engineering, hereby certify that this project has been graded and will drain in substantial compliance with the provisions of the 2010 Arizona ASCE 7-03 Minimum Design Requirements and in accordance with the design intent of the approved plan dated 2/23/10. The record information edited on the original design document has been performed by me or under my direct supervision and is true and correct to the best of my knowledge and belief. The as-built survey was provided by Lenore Armijo LSN# 15511. The certification is submitted in support of a request for Certificate of Occupancy and Release of Financial Guarantee. The record information presented herein is not necessarily complete and intended only to verify substantial compliance of the grading and drainage aspects of this project. Those relying on this record document are advised to obtain independent verification of its accuracy before using it for any other purpose.

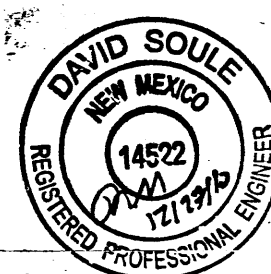

CAUTION:
EXISTING UTILITIES ARE NOT SHOWN.
IT SHALL BE THE SOLE RESPONSIBILITY
OF THE CONTRACTOR TO CONDUCT ALL
NECESSARY FIELD INVESTIGATIONS PRIOR
TO ANY EXCAVATION TO DETERMINE THE
ACTUAL LOCATION OF UTILITIES & OTHER
IMPROVEMENTS.

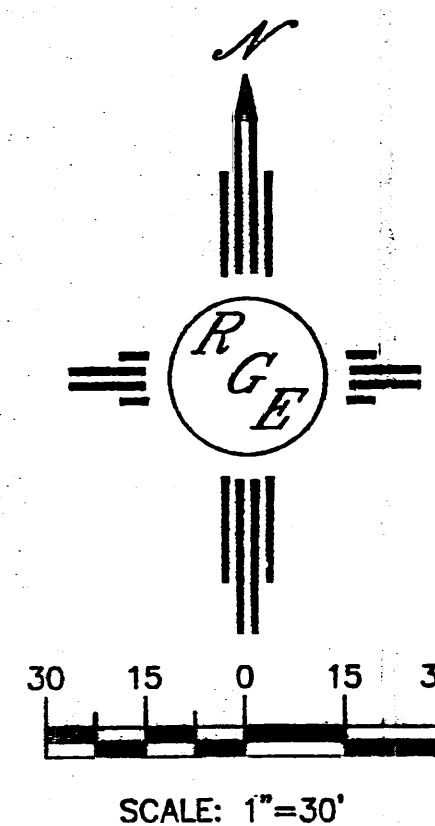

ROUGH GRADING APPROVAL

DATE _____

**ENGINE
SEAL**

**SAN ANTONIO
SELF STORAGE**

DRAWN
BY WCW/I

DATE
8-20-09

GRADING AND DRAINAGE PLAN

3-20-09

SHEET #

of 8

JOB #
2015



Rio Grande
Engineering

1606 CENTRAL AVENUE SE
SUITE 201
ALBUQUERQUE, NM 87106
(505) 872-0999

