


VICINITY MAP
SCALE: 1" = 750'

E-19

LEGAL DESCRIPTION

TRACT C-1-C-1-A, ACADEMY ACRES, UNIT 17

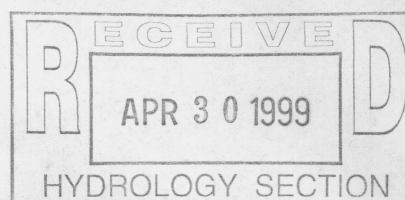

PROJECT BENCHMARK

A.C.S. 1 3/4" ALUMINUM DISK STAMPED "ACS BM, 12-E19" EPOXIED TO THE TOP OF THE CONCRETE CURB, AT THE WEST NORTHWEST CURB RETURN OF THE INTERSECTION OF WYOMING BLVD. N.E. AND SAN ANTONIO DR. N.E. ELEVATION = 5404.28' (M.S.L.D.)

T.B.M.

FOUND " + " CHISELED ON TOP OF CURB @ NE CORNER OF SITE
ELEVATION = 5378.21' (M.S.L.D.)

LEGEND

TC	TOP OF CURB
FL	FLOWLINE
TCO	TOP OF CONCRETE
TSW	TOP OF SIDEWALK
TA	TOP OF ASPHALT
EA	EDGE OF ASPHALT
TW	TOP OF WALL
BW	BOTTOM OF WALL
W.M.	WATER METER
P.P.	POWER POLE
W.V.	WATER VALVE
F.H.	FIRE HYDRANT
C.O.	CLEANOUT
SAS	SANITARY SEWER LINE
E	POWER LINE
T	TELEPHONE LINE
L.P.	LIGHT POLE
G.M.	GAS METER
G.P.	GUARD POST
W.C.	WHEELCHAIR
CONC.	CONCRETE
S/W	SIDEWALK
○	SMALL TREE
○	BOULDER
70	EXISTING SPOT ELEVATION
70	EXISTING CONTOURS
70	EXISTING FLOWLINE
72.50	PROPOSED SPOT ELEVATION
70	PROPOSED CONTOUR
...	PROPOSED FLOWLINE
▨	PROPOSED CONCRETE
▨	PROPOSED ASPHALT
→	ROOF DRAINAGE

AS-BUILT LEGEND

- 74.15.40 AS-BUILT SPOT ELEVATION
- 73.4 AS-BUILT SPOT ELEVATION
- 74.15 ✓ AS-BUILT = AS DESIGNED ELEVATION

CONCEPTUAL DRAINAGE PLAN
The following items concerning the Brake Masters San Antonio Drainage Plan are contained hereon:

- Vicinity Map
- Grading Plan
- Calculations

As shown by the Vicinity Map, the site is located on the south side of San Antonio Drive N.E. just west of its intersection with San Antonio Place N.E. The site lies within the Wyoming Commercial Complex. The Pino Arroyo lies to the south of the site. The Pino Arroyo is currently fully improved as a City of Albuquerque public drainage channel. The site outfalls to that existing drainage facility.

As shown by Panel 141 of 825 of the National Flood Insurance Program Flood Insurance Rate Maps published by F.E.M.A. for the City of Albuquerque, New Mexico dated September 20, 1996, this site does not lie within a designated flood hazard zone. A flood hazard zone is identified within the Pino Arroyo. The flood maps indicate that the 100-year flood is "confined to channel". Due to the proximity of the site to the Pino Arroyo, and the status of that channel, the free discharge of runoff from this site is appropriate. Furthermore, it is consistent with the previously approved Master Drainage Plan for this site (Hydrology File NO. E19/D25C). The downstream concrete runoff was improved and upgraded as part of the Zip Lube project (E19/D25C3). The downstream improvements therefore satisfy the requirements of the previously approved plans.

The Grading Plan shows: 1) existing and proposed grades indicated by spot elevations and contours at 1' intervals, 2) the limit and character of the existing improvements, 3) the limit and character of the proposed improvements, and 4) continually between existing and proposed grades. As shown by this plan, a Brake Masters store is proposed within Tract C-1-C-1-A, Academy Acres, Unit 17. At present, this portion of the site slopes from northeast to southwest. This trend of drainage will be maintained through the development of this site. The runoff generated by the proposed improvements will be discharged onto the existing paving which slopes in a westerly direction and eventually discharges to an existing concrete runoff referenced above. No detention ponding is required. The Calculations which appear hereon analyze both the existing and developed conditions for the 100-year, 6-hour rainfall event. The Procedure for 40-acre and Smaller Basins, as set forth in the Revision of Section 22.2, Hydrology of the Development Process Manual, Volume 2, Design Criteria, dated January, 1993, has been used to quantify the peak rate of discharge and volume of runoff generated. As shown by these calculations, a minor increase of 330 cf in runoff volume and 0.1 cfs in the peak discharge rate is anticipated due to the proposed development.

CALCULATIONS

Site Characteristics

- Precipitation Zone = 3
- $P_{6,100} = P_{360} = 2.60$
- Total Area (A_T) = 22,300 sf/0.51 ac
- Existing Land Treatment

Treatment	Area (sf/ac)	%
C	11,910/0.27	53.4
D	10,390/0.24	46.6

- Developed Land Treatment

Treatment	Area (sf/ac)	%
B	3,480/0.08	15.6
C	3,400/0.08	15.2
D	15,420/0.35	69.2

Existing Condition

- Volume

$$E_w = (E_{A^A} + E_{B^B} + E_{C^C} + E_{D^D}) / A_T$$

$$E_w = [(1.29)(0.27) + (2.36)(0.24)] / 0.51 = 1.79 \text{ in}$$

$$V_{100} = (E_w / 12) A_T$$

$$V_{100} = (1.79 / 12) 0.51 = 0.0762 \text{ ac.ft.} / 3,320.0 \text{ cf}$$

- Peak Discharge

$$Q_p = Q_{PA^A} + Q_{PB^B} + Q_{PC^C} + Q_{PD^D}$$

$$Q_p = Q_{100} = (3.45)(0.27) + (5.02)(0.24) = 2.1 \text{ cfs}$$

Developed Condition

- Volume

$$E_w = (E_{A^A} + E_{B^B} + E_{C^C} + E_{D^D}) / A_T$$

$$E_w = [(0.92)(0.08) + (1.29)(0.08) + (2.36)(0.35)] / 0.51 = 1.97 \text{ in}$$

$$V_{100} = (E_w / 12) A_T$$

$$V_{100} = (1.97 / 12) 0.51 = 0.0837 \text{ ac.ft.} / 3,650 \text{ cf}$$



- Peak Discharge

$$Q_p = Q_{PA^A} + Q_{PB^B} + Q_{PC^C} + Q_{PD^D}$$

$$Q_p = Q_{100} = (2.60)(0.08) + (3.45)(0.08) + (5.02)(0.35) = 2.2 \text{ cfs}$$

Comparison

- $\Delta V_{100} = 3,650 - 3,320 = 330 \text{ cf (increase)}$
- $\Delta Q_{100} = 2.2 - 2.1 = 0.1 \text{ cfs (increase)}$

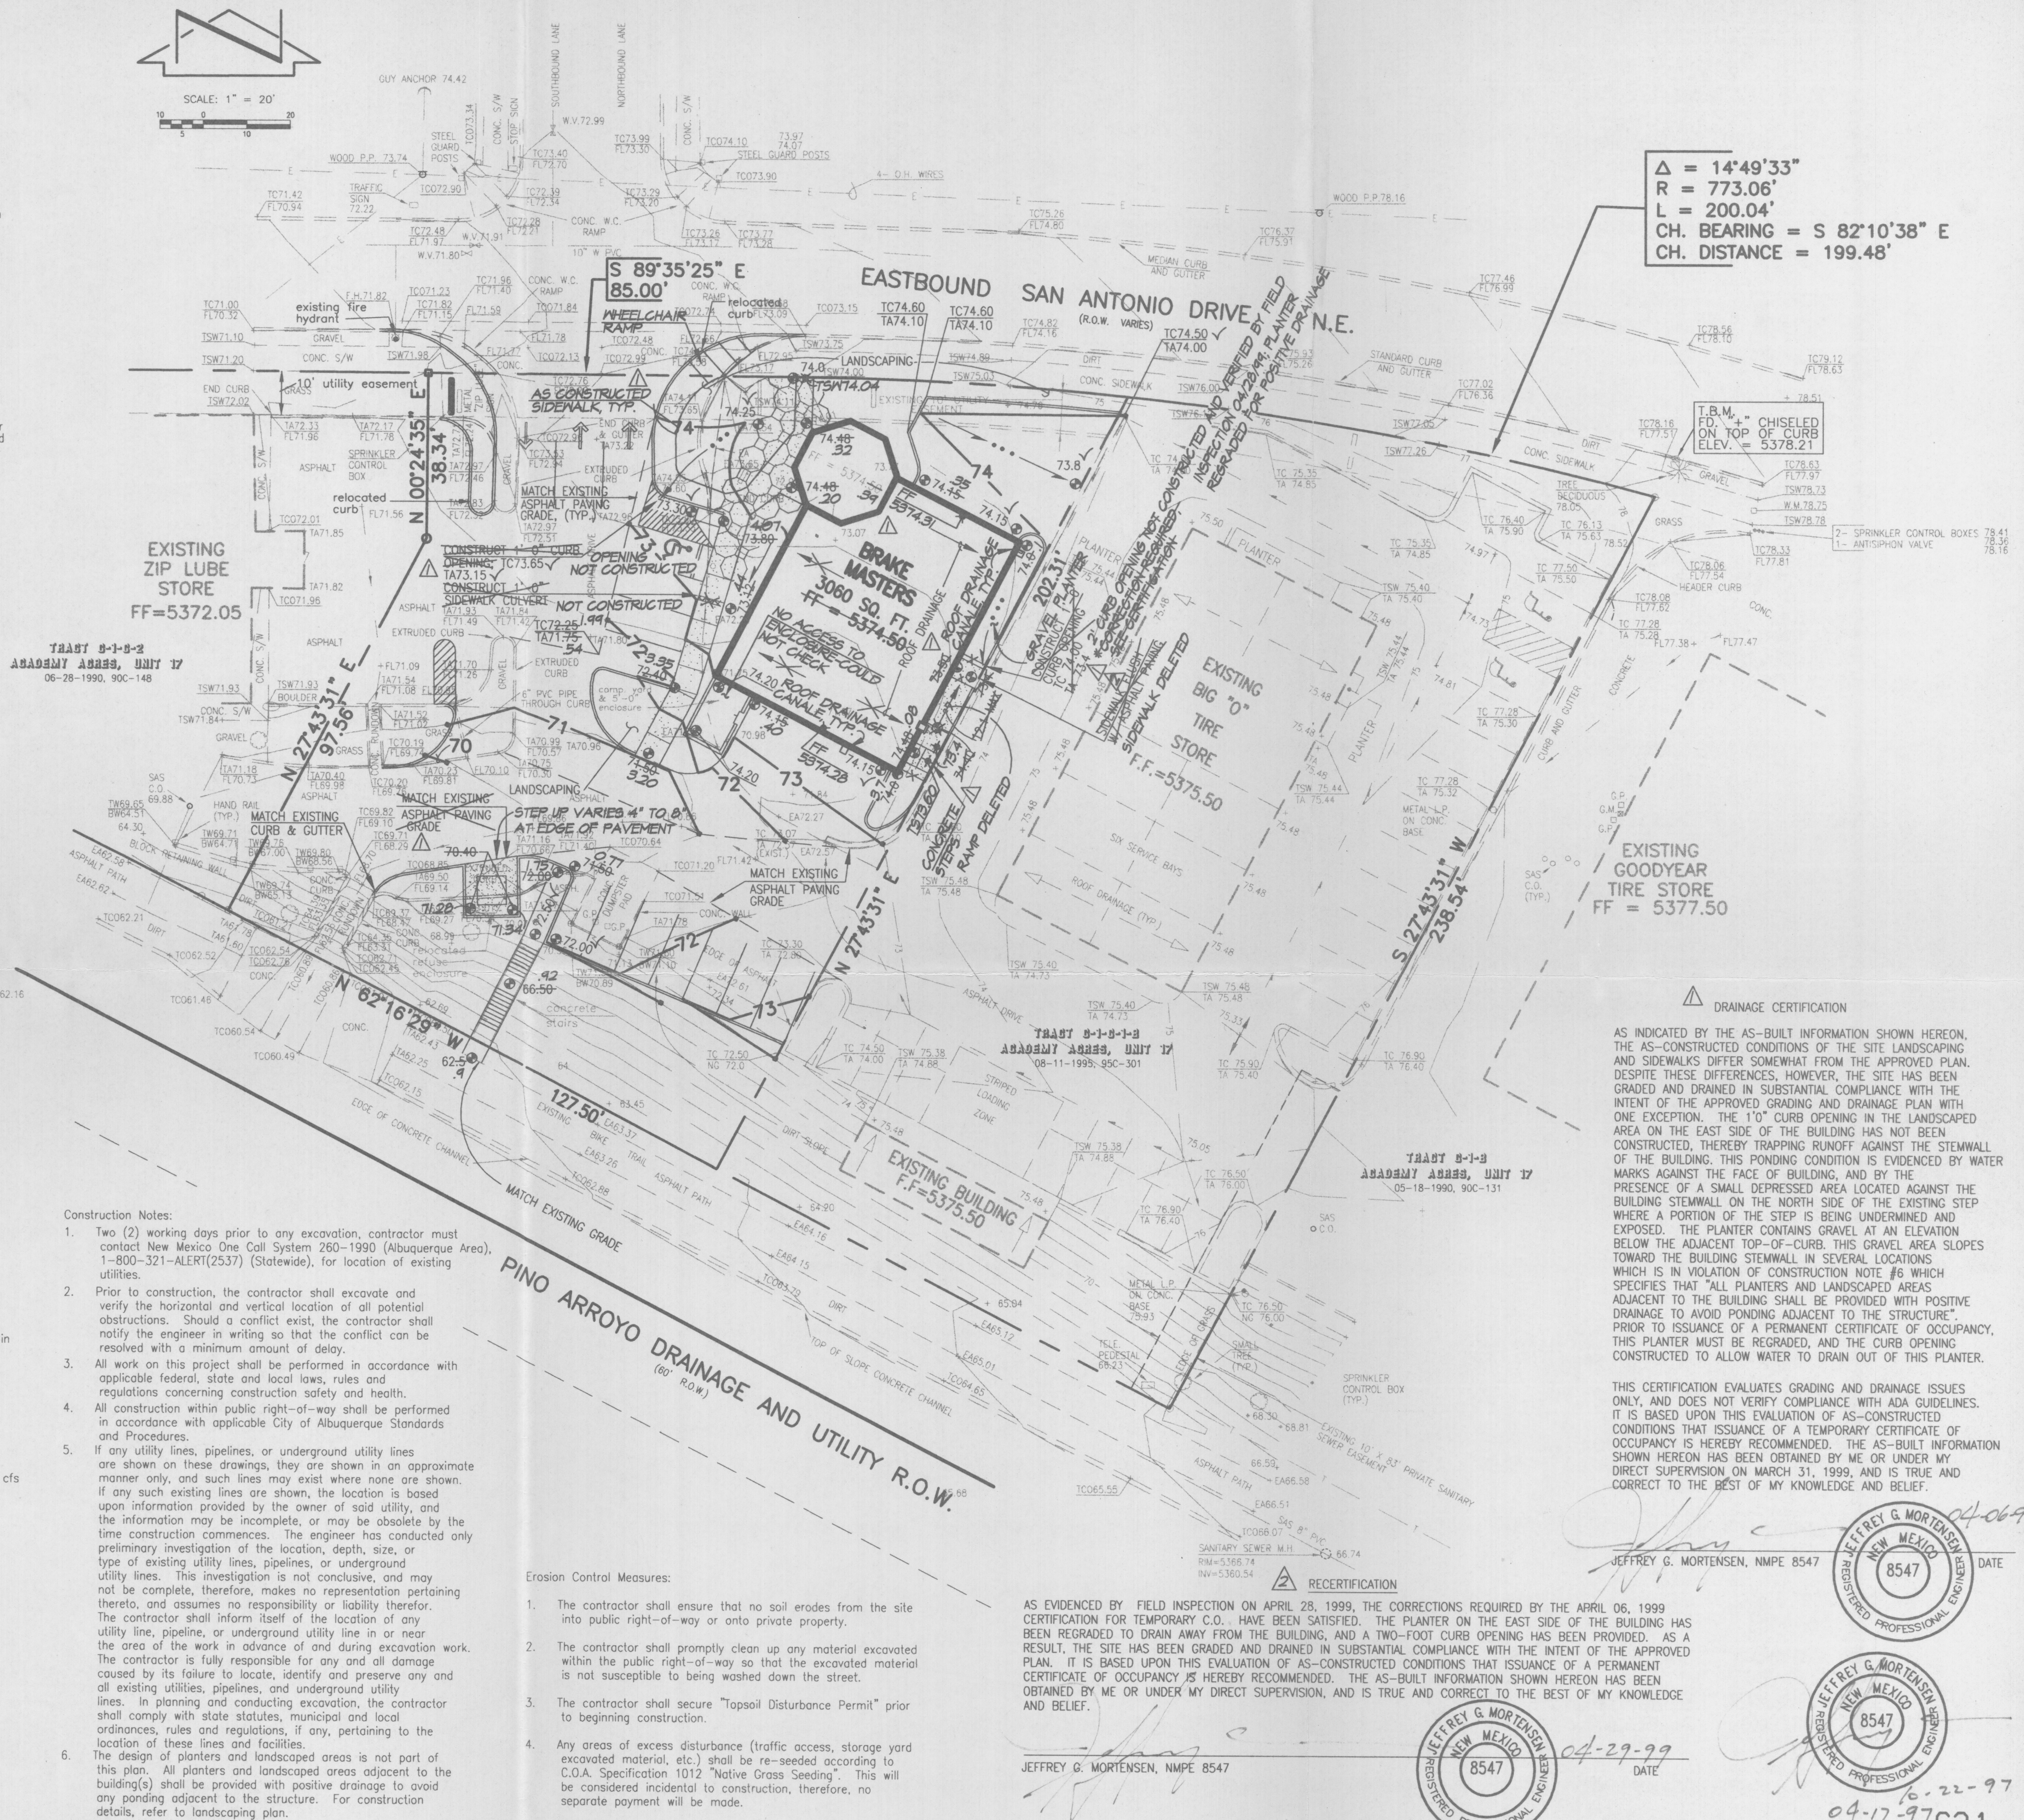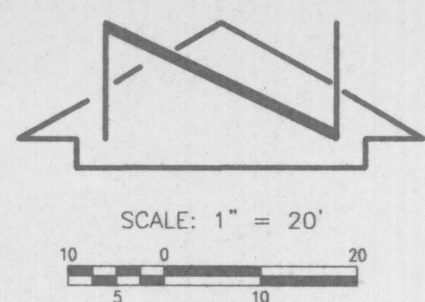



$\Delta = 14'49'33''$
 $R = 773.06'$
 $L = 200.04'$
CH. BEARING = S 82°10'38" E
CH. DISTANCE = 199.48'

DRAINAGE CERTIFICATION

AS INDICATED BY THE AS-BUILT INFORMATION SHOWN HEREON, THE AS-CONSTRUCTED CONDITIONS OF THE SITE LANDSCAPING AND SIDEWALKS DIFFER SOMEWHAT FROM THE APPROVED PLAN. DESPITE THESE DIFFERENCES, HOWEVER, THE SITE HAS BEEN GRADED AND DRAINED IN SUBSTANTIAL COMPLIANCE WITH THE INTENT OF THE APPROVED GRADING AND DRAINAGE PLAN WITH ONE EXCEPTION. THE 10" CURB OPENING IN THE LANDSCAPED AREA ON THE EAST SIDE OF THE BUILDING HAS NOT BEEN CONSTRUCTED, THEREBY TRAPPING RUNOFF AGAINST THE STEMMALL OF THE BUILDING. THIS PONDING CONDITION IS EVIDENCED BY WATER MARKS AGAINST THE FACE OF BUILDING, AND BY THE PRESENCE OF A SMALL DEPRESSED AREA LOCATED AGAINST THE BUILDING STEMMALL ON THE NORTH SIDE OF THE EXISTING STEP WHERE A PORTION OF THE STEP IS BEING UNDERMINED AND EXPOSED. THE PLANTER CONTAINS GRAVEL AT AN ELEVATION BELOW THE ADJACENT TOP-OF-CURB. THIS GRAVEL AREA SLOPES TOWARD THE BUILDING STEMMALL IN SEVERAL LOCATIONS WHICH IS IN VIOLATION OF CONSTRUCTION NOTE #6 WHICH SPECIFIES THAT "ALL PLANTERS AND LANDSCAPED AREAS ADJACENT TO THE BUILDING SHALL BE PROVIDED WITH POSITIVE DRAINAGE TO AVOID PONDING ADJACENT TO THE STRUCTURE". PRIOR TO ISSUANCE OF A PERMANENT CERTIFICATE OF OCCUPANCY, THIS PLANTER MUST BE REGRADED, AND THE CURB OPENING CONSTRUCTED TO ALLOW WATER TO DRAIN OUT OF THIS PLANTER.


THIS CERTIFICATION EVALUATES GRADING AND DRAINAGE ISSUES ONLY, AND DOES NOT VERIFY COMPLIANCE WITH ADA GUIDELINES. IT IS BASED UPON THIS EVALUATION OF AS-CONSTRUCTED CONDITIONS THAT ISSUANCE OF A TEMPORARY CERTIFICATE OF OCCUPANCY IS HEREBY RECOMMENDED. THE AS-BUILT INFORMATION SHOWN HEREON HAS BEEN OBTAINED BY ME OR UNDER MY DIRECT SUPERVISION ON MARCH 31, 1999, AND IS TRUE AND CORRECT TO THE BEST OF MY KNOWLEDGE AND BELIEF.

JEFFREY G. MORTENSEN, NMPE 8547
DATE: 04-06-99

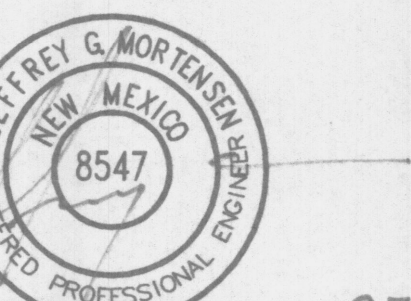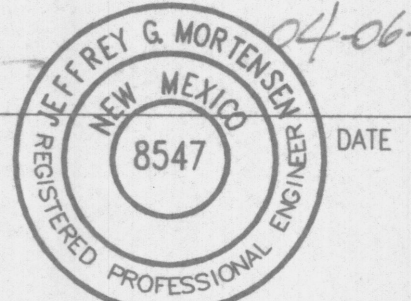

AS EVIDENCED BY FIELD INSPECTION ON APRIL 28, 1999, THE CORRECTIONS REQUIRED BY THE APRIL 06, 1999 CERTIFICATION FOR TEMPORARY C.O. HAVE BEEN SATISFIED. THE PLANTER ON THE EAST SIDE OF THE BUILDING HAS BEEN REGRADED TO DRAIN AWAY FROM THE BUILDING, AND A TWO-FOOT CURB OPENING HAS BEEN PROVIDED. AS A RESULT, THE SITE HAS BEEN GRADED AND DRAINED IN SUBSTANTIAL COMPLIANCE WITH THE INTENT OF THE APPROVED PLAN. IT IS BASED UPON THIS EVALUATION OF AS-CONSTRUCTED CONDITIONS THAT ISSUANCE OF A PERMANENT CERTIFICATE OF OCCUPANCY IS HEREBY RECOMMENDED. THE AS-BUILT INFORMATION SHOWN HEREON HAS BEEN OBTAINED BY ME OR UNDER MY DIRECT SUPERVISION, AND IS TRUE AND CORRECT TO THE BEST OF MY KNOWLEDGE AND BELIEF.

JEFFREY G. MORTENSEN, NMPE 8547
DATE: 04-29-99

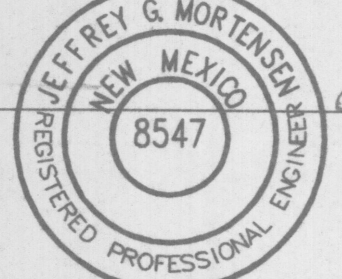

GRADING AND DRAINAGE PLAN BRAKE MASTERS - SAN ANTONIO WYOMING COMMERCIAL COMPLEX

DESIGNED BY	J.G.M.	NO.	DATE	BY	REVISIONS	JOB NO.
DRAWN BY	J.M.A.	1	04/99	G.M.	AS-BUILT AND CERTIFY FOR TEMPORARY C.O.	960084
APPROVED BY	J.G.M.	2	04/99	G.M.	RECERTIFY FOR PERMANENT C.O.	03-1997
						04-1999
						SHEET 1 OF 1



JEFF MORTENSEN & ASSOCIATES, INC.
6010-B MIDWAY PARK BLVD. N.E.
ALBUQUERQUE, NM 87109
ENGINEERS & SURVEYORS (505) 345-4250