



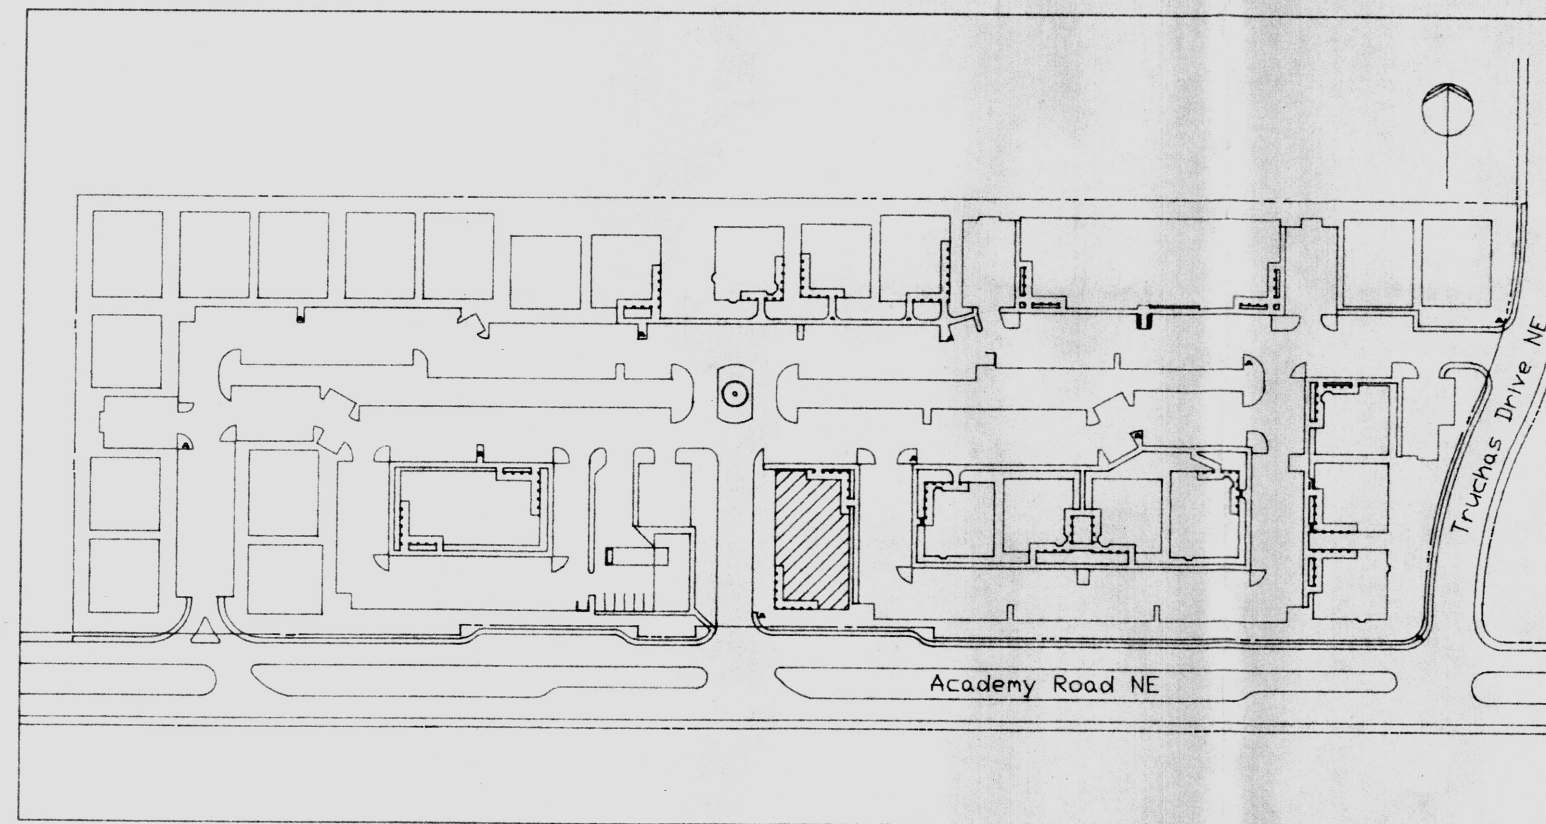


A SITE KEY


NTS

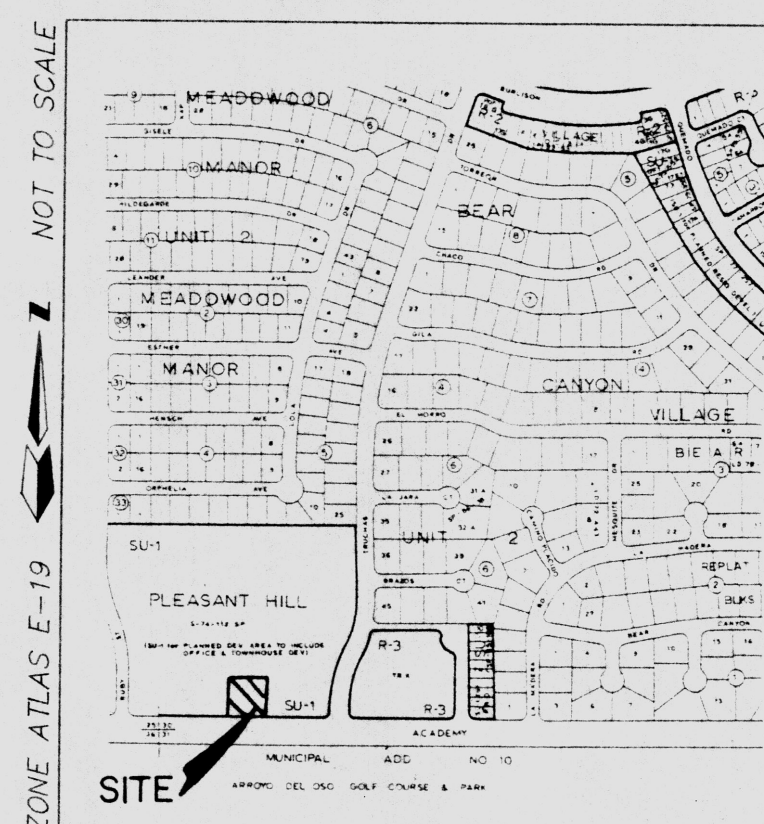

C VICINITY MAP

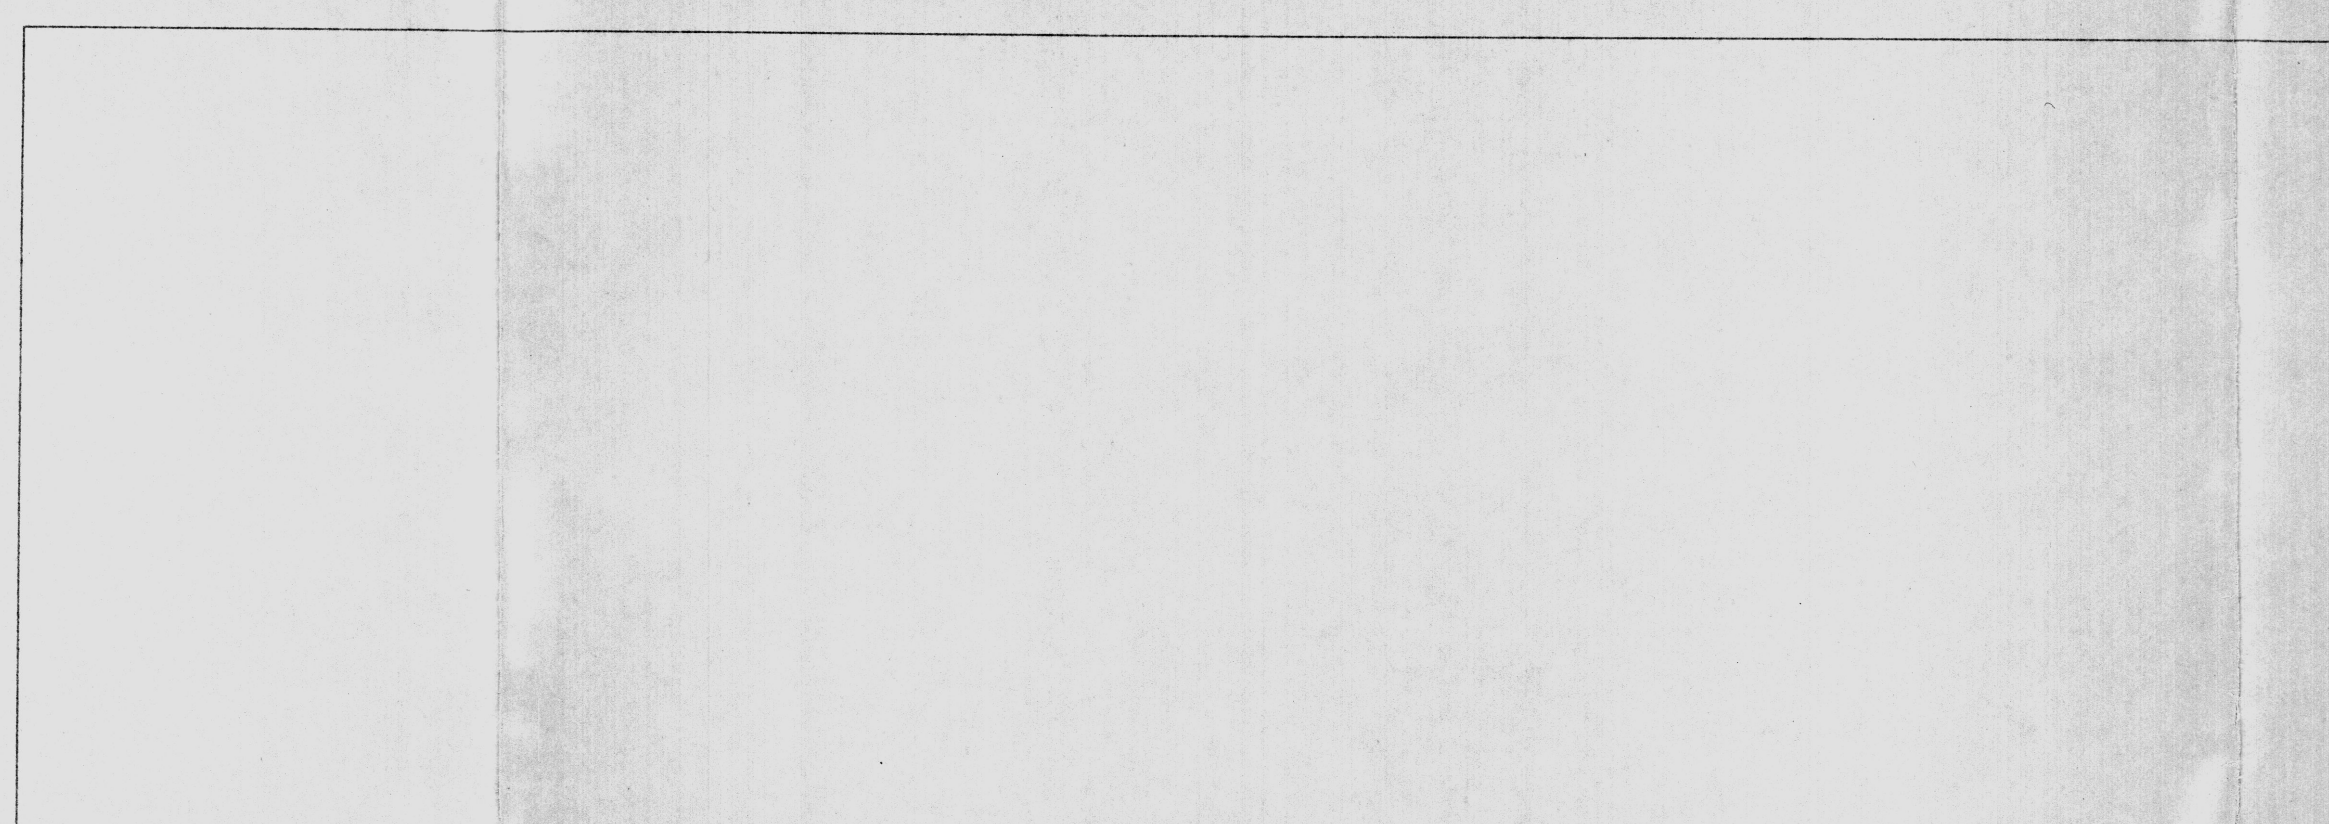

D

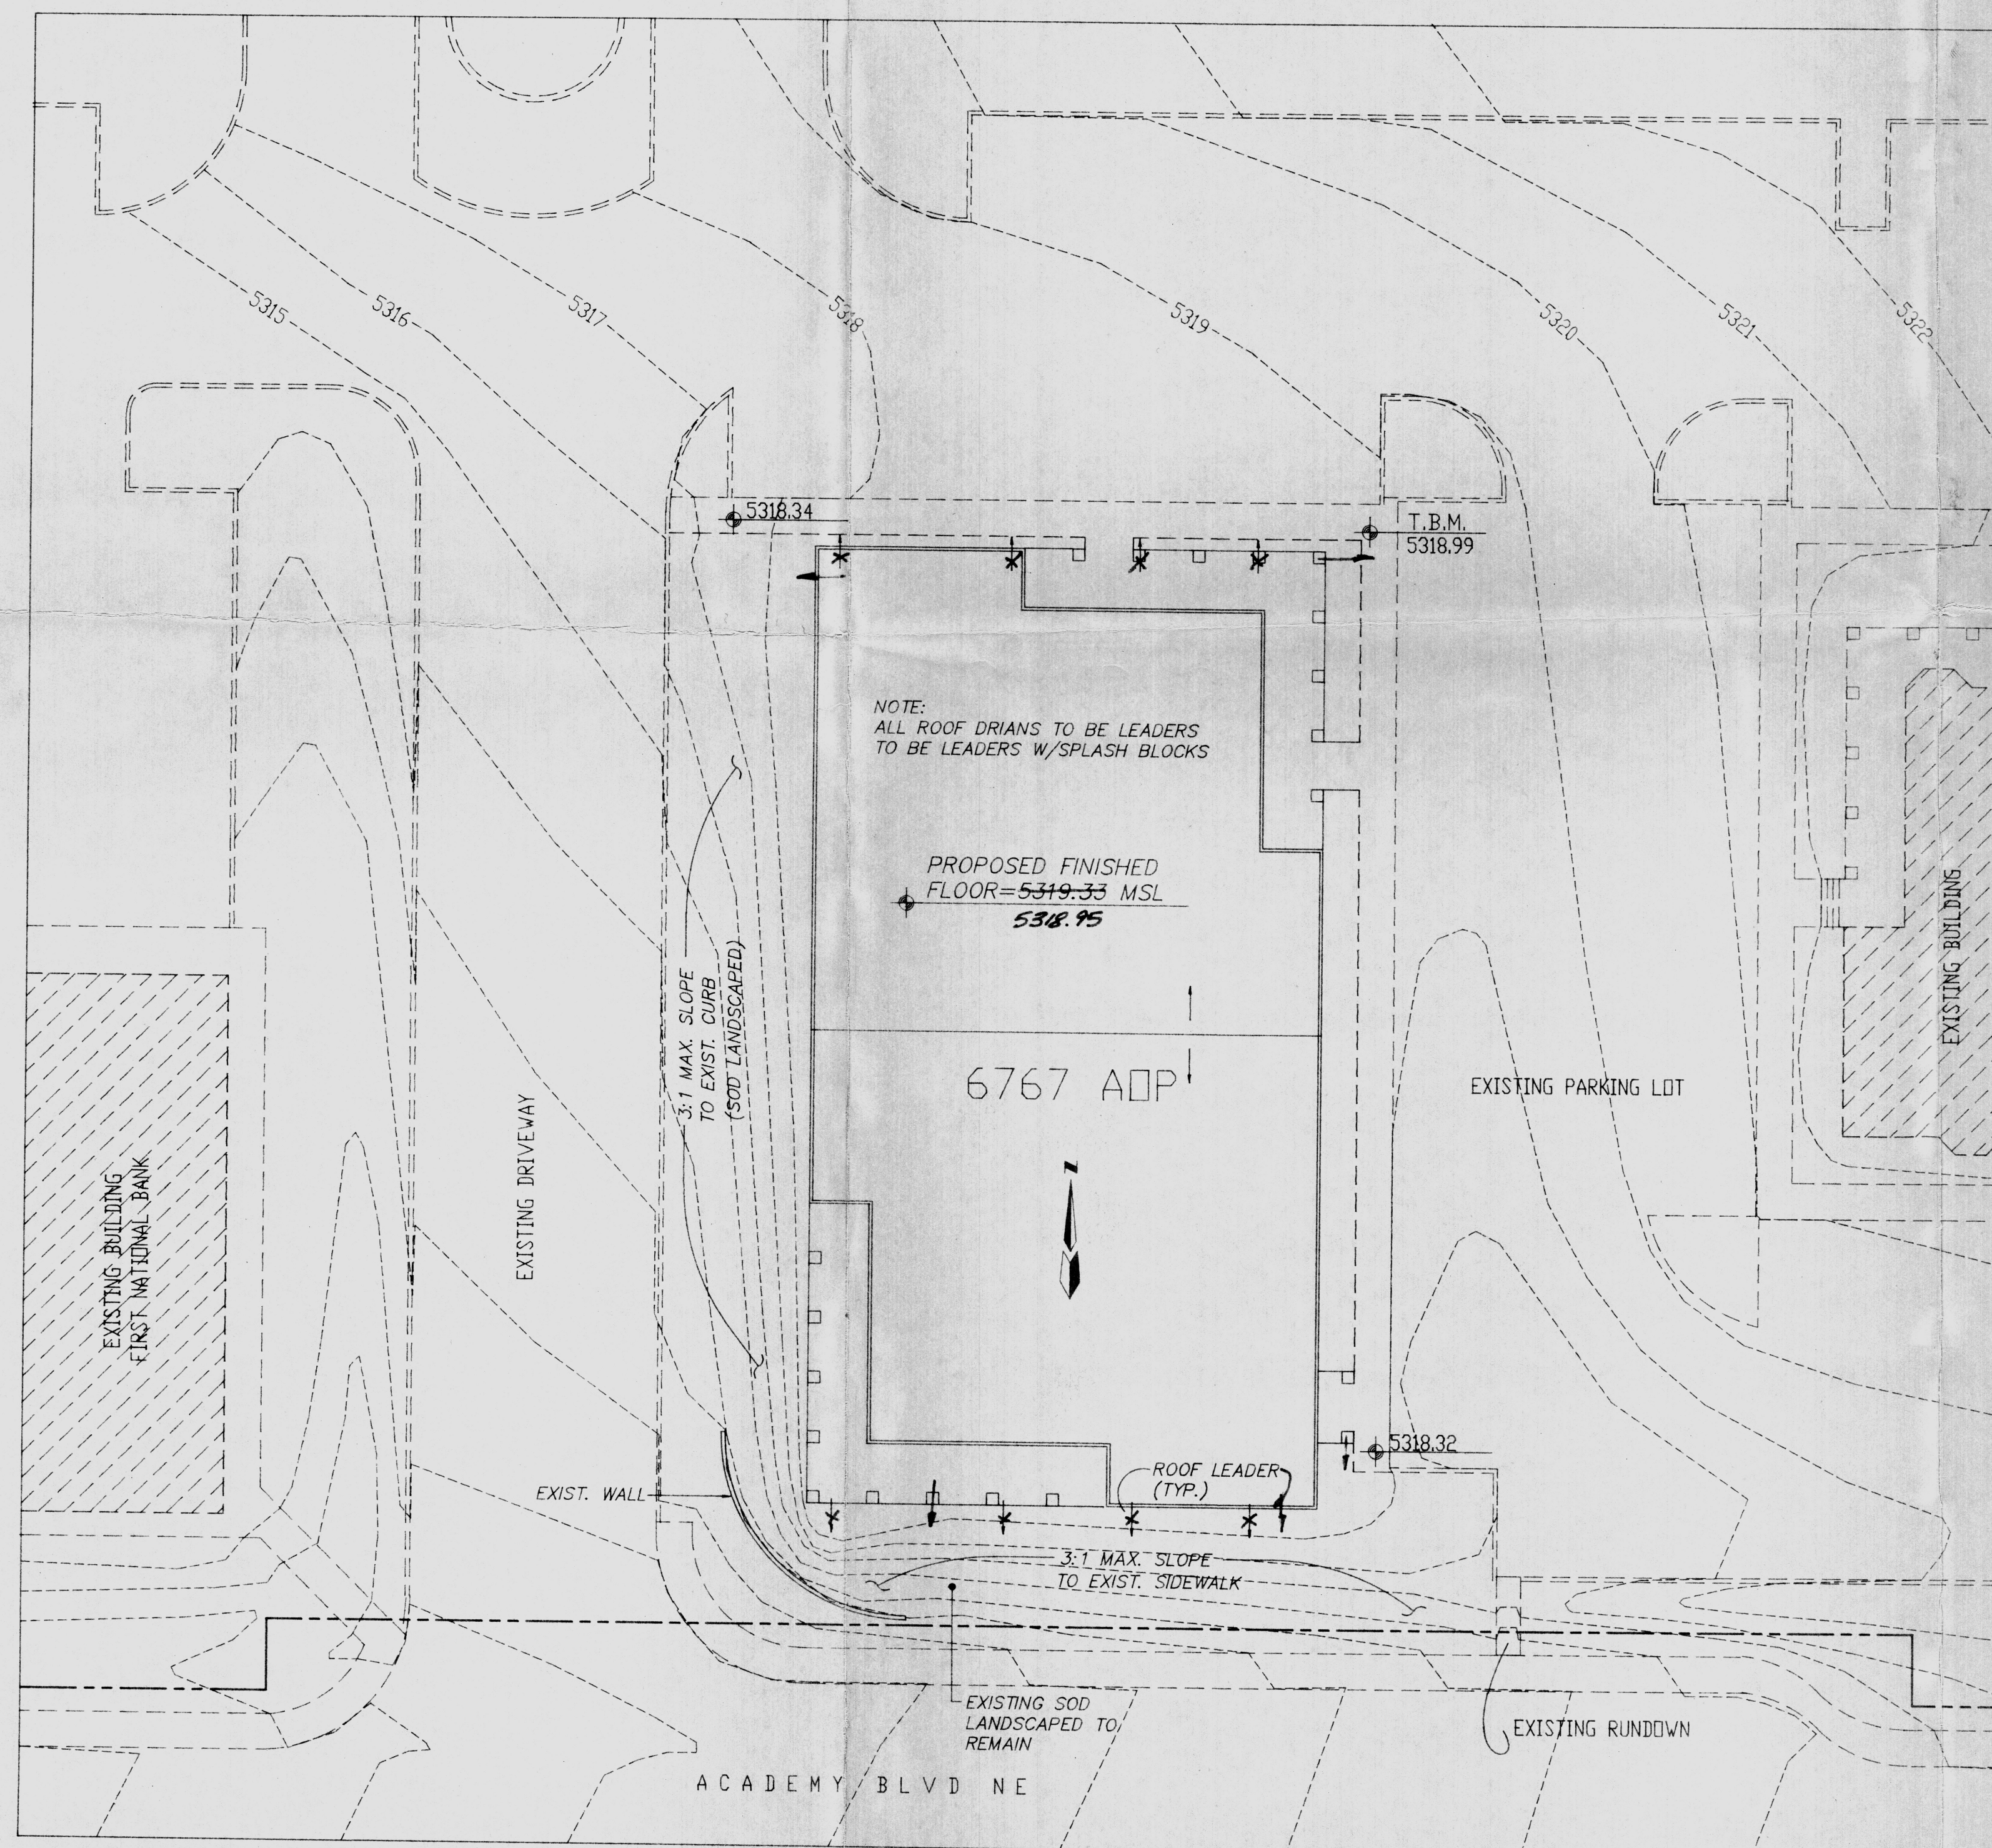

W SITE GRADING PLAN

SCALE: 1" = 20'

1. No off-site flows enter this site.
2. Site does not lie in the 100-year flood plain.
3. See architectural site plan for all dimensions.
4. Contour interval = 1'
5. Master Grading & Drainage Plan by DMJM (E19/D17). Free discharge per that plan.
6. Contractor shall construct temporary 2' high earthen berm along west end of project for sediment control and to prevent uncontrolled discharge from site during construction.
7. Roof drain locations are approximate: See architectural drawings for exact locations.

I hereby certify that the information contained on this drawing has been revised in accordance with information furnished by the Contractor. The Hines Corporation, and by the Surveyor, D. Mark Goodwin & Associates, and reflects the construction as actually accomplished. This plan as constructed is in close compliance with the Approved Plan.

Mark Goodwin, NMPE 8948

3/14/93

M NOTES

LEGAL DESCRIPTION

6767 ACADEMY - A PORTION OF TRACT "A", ACADEMY ACRES, T & H UNIT

T.B.M.

TOP OF SIDEWALK NEAR THE NE CORNER OF BUILDING 6767 AS ON THE DRAWING. ELEVATION=5318.99 PAINTED ORANGE & MARKED T.B.M.

ACS BENCHMARK


AN ACS BRASS TABLET STAMPED "1-F19A-1978" SET ON TOP OF A CONCRETE POST FLUSH WITH THE GROUND AT THE INTERSECTION OF ACADEMY ROAD AND TRUCHAS DRIVE NE. THE STATION IS 70' WEST OF CL OF TRUCHAS IN THE WESTERLY MEDIAN, ±13.6'. ELEVATION = 5328.52

- LEGEND**
- 5319--- EXISTING CONTOUR
 - PROPERTY LINE
 - ===== EXISTING CURB & GUTTER
 - ROOF DRAIN OR FLOW DIRECTION
 - MSL MEAN SEA LEVEL
 - EXISTING BUILDING

dmg D. MARK GOODWIN & ASSOCIATES, P.A.
CONSULTING ENGINEERS & SURVEYORS
P.O. BOX 90606
ALBUQUERQUE, NEW MEXICO 87199
(505) 828-2200



Z LEGAL & NOTES

PROJECT 9218

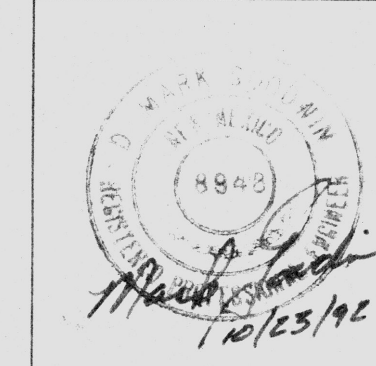

SLNB ARCHITECTS, INC.
1620 Central Avenue Southeast
Albuquerque NM 87106
(505) 247-1529

6767 ADP: METRO 100

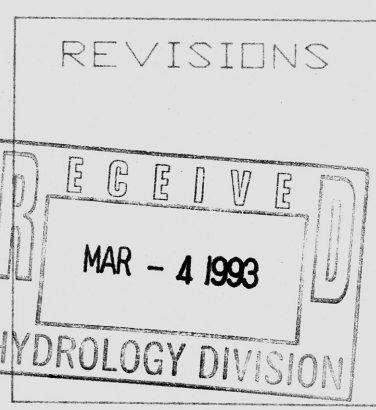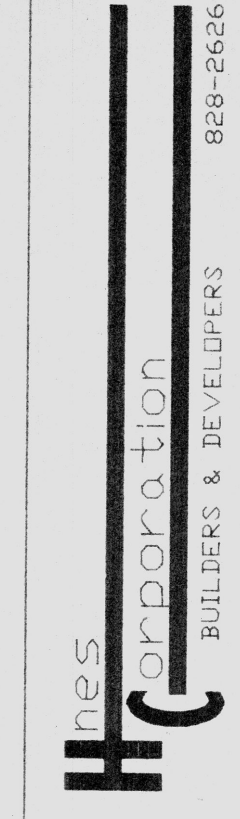

05 OCT 92

SHEET
C1
OF 11