


High Desert
Tract 8B
ZONED SU-2 HD/C-1

USERNAME: CDP\CS9186A11.PAD\GRADING-3.GRF

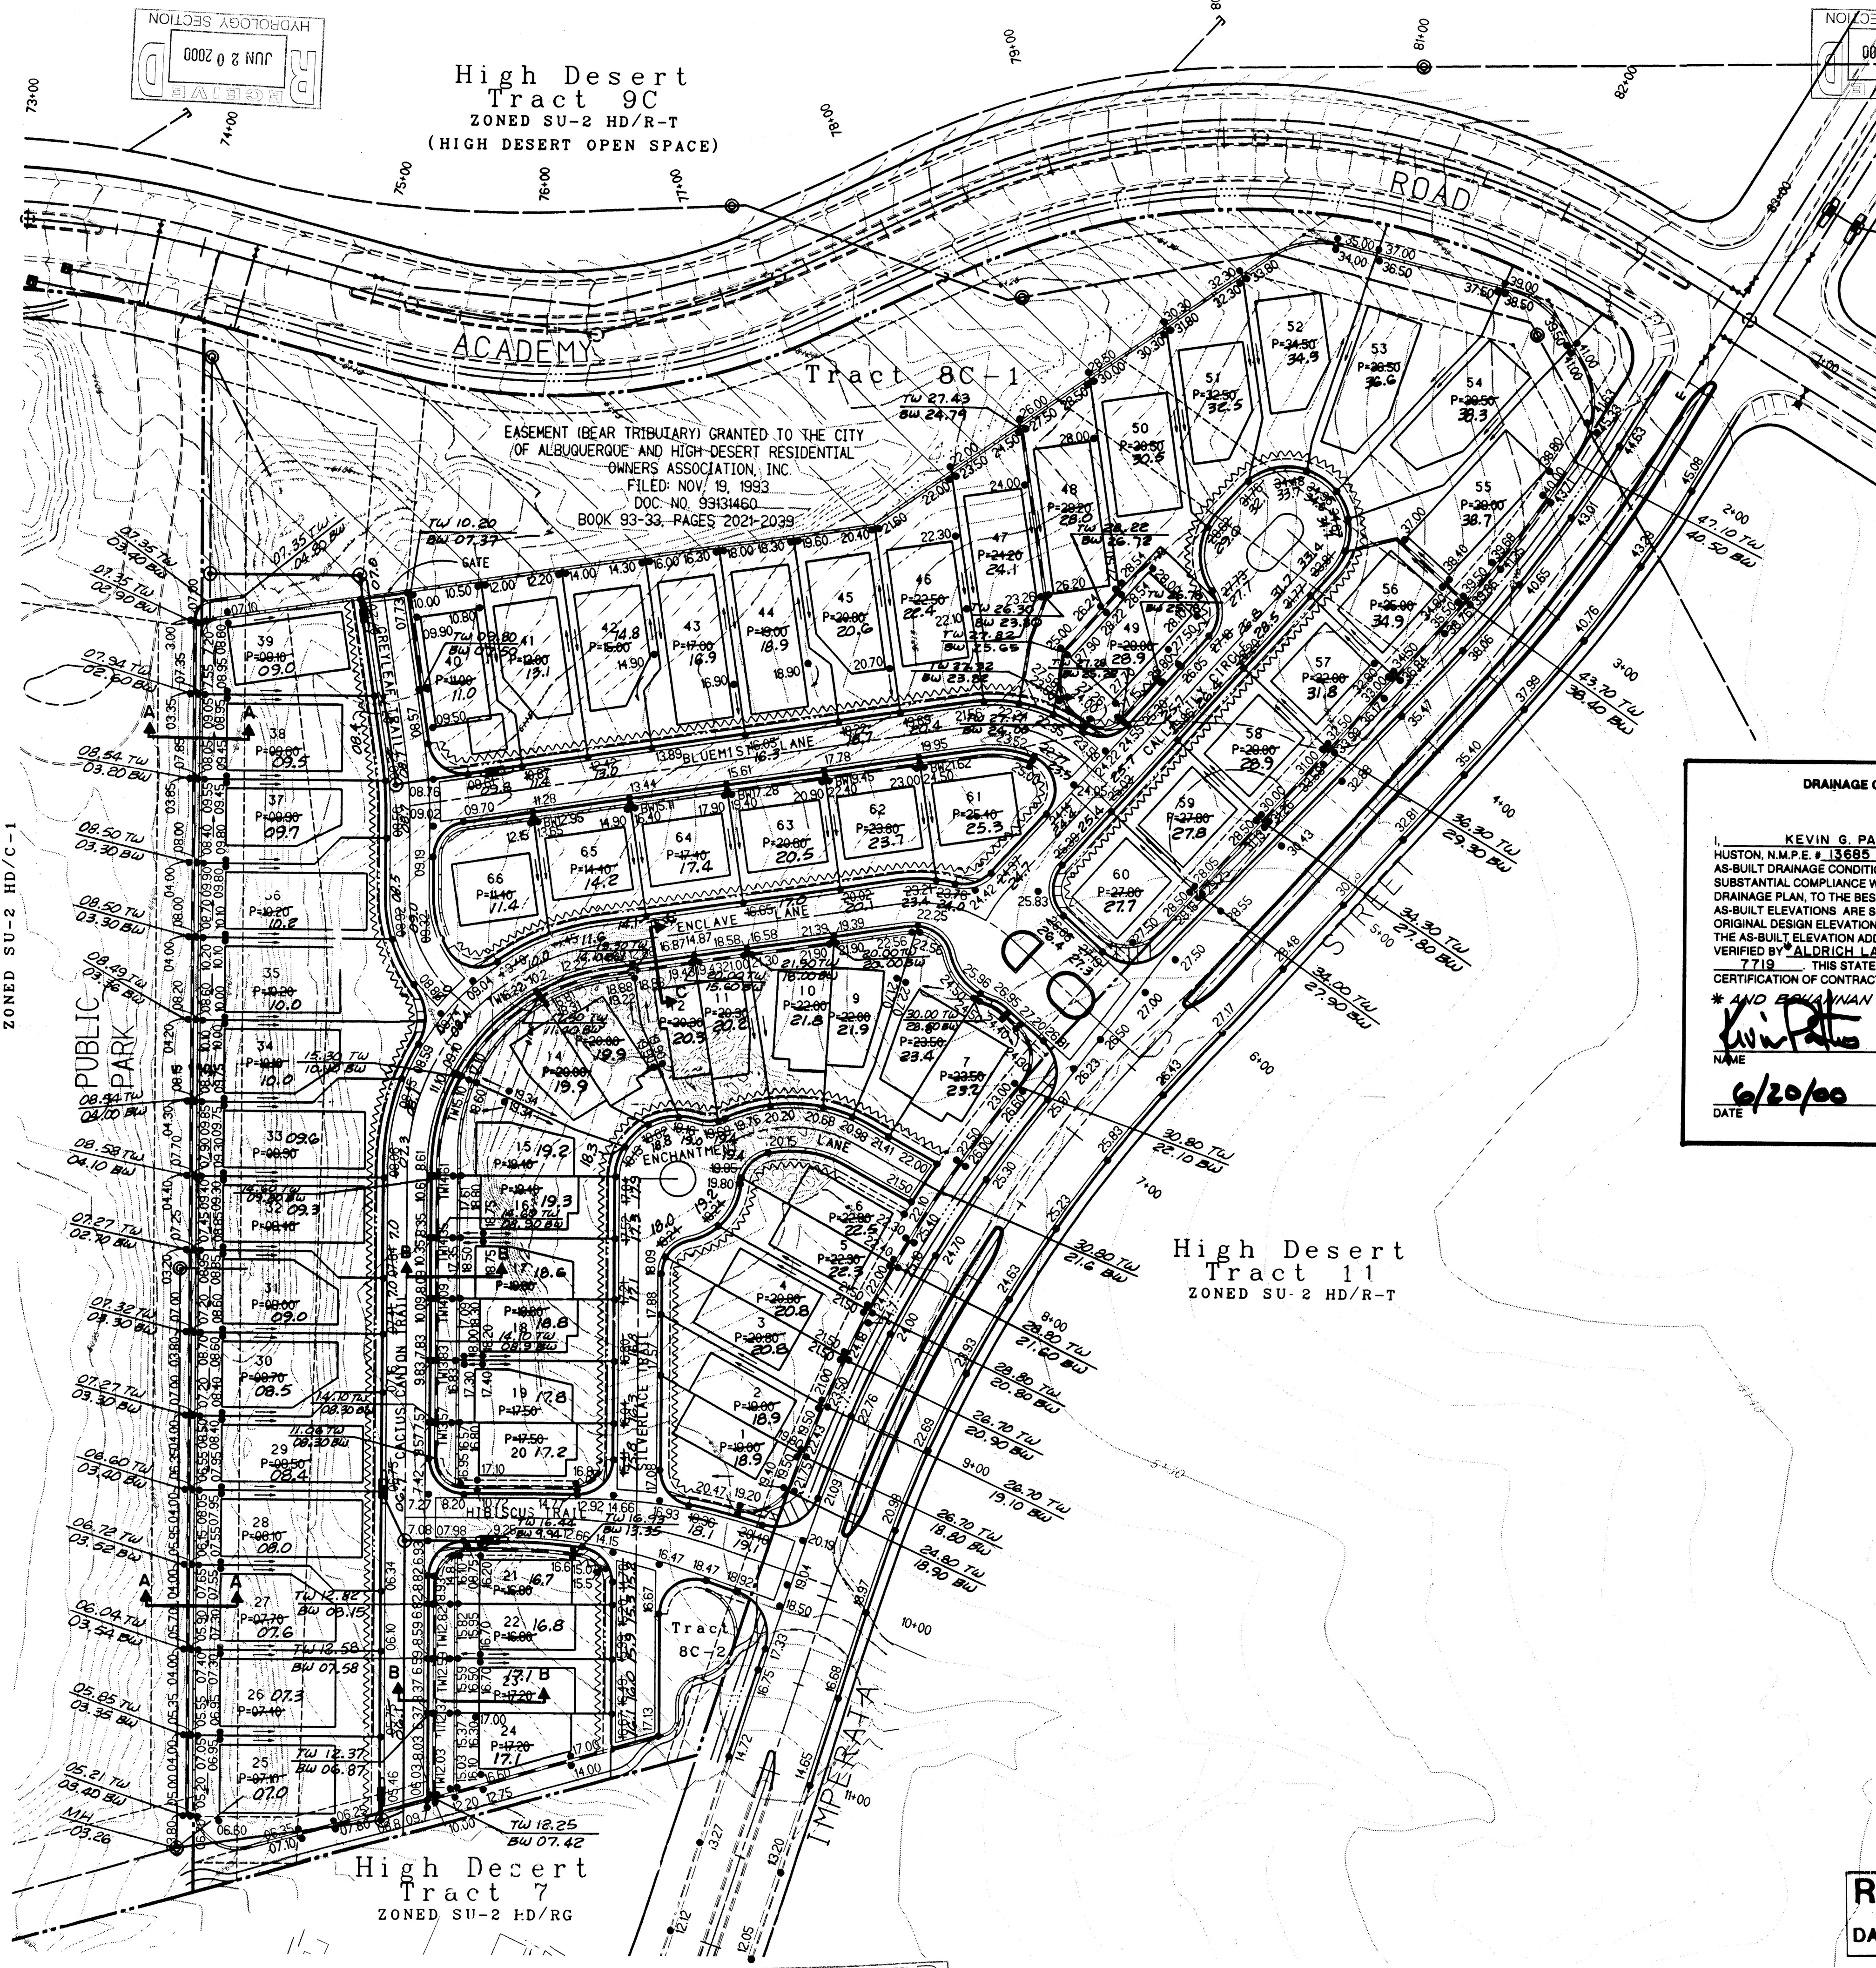

DRAINAGE CERTIFICATION

I, **KEVIN G. PATTON** OF BOHANNAN HUSTON, N.M.P.E. # 13685, HEREBY CERTIFY THAT THE AS-BUILT DRAINAGE CONDITIONS OF THE SITE ARE IN SUBSTANTIAL COMPLIANCE WITH THE APPROVED GRADING AND DRAINAGE PLAN, TO THE BEST OF MY KNOWLEDGE AND BELIEF. AS-BUILT ELEVATIONS ARE SHOWN ON THE PLAN WHERE THE ORIGINAL DESIGN ELEVATION HAS BEEN CROSSED OUT AND THE AS-BUILT ELEVATION ADDED. AS-BUILT ELEVATIONS WERE VERIFIED BY ALDRICH LAND SURVEYING, INC. L.S. # 7719. THIS STATEMENT DOES NOT REPRESENT CERTIFICATION OF CONTRACTOR'S METHODS OR MATERIALS.

* AND BOHANNAN HUSTON

NAME *Kevin Patton*

DATE *6/20/00*

DATE





EROSION CONTROL PLAN

NO SCALE

A BERM WITH THE DIMENSIONS SHOWN SHALL BE MAINTAINED DURING CONSTRUCTION UNTIL COMPLETION OF INDIVIDUAL HOMES WITHIN THE PROJECT.

LEGEND

PROJECT BOUNDARY	---
EXISTING CONTOUR	---
EXISTING SPOT ELEVATION	o 25.5
PROPOSED SPOT ELEVATION	• 36.6
DIRECTION OF FLOW	S=2.564%
BASIN BOUNDARY	---
SUB-BASIN BOUNDARY	---
PROPOSED RETAINING WALL	---
PROPOSED GARDEN WALL	---
EXISTING STORM DRAIN LINE	SD
EXISTING STORM DRAIN MANHOLE	o
EXISTING STORM DRAIN INLET	o
PROPOSED STORM DRAIN LINE	SD
PROPOSED STORM DRAIN MANHOLE	o
PROPOSED STORM DRAIN INLET	o
TOE OF SLOPE	---
EROSION CONTROL BERM	---
SILT FENCE	---

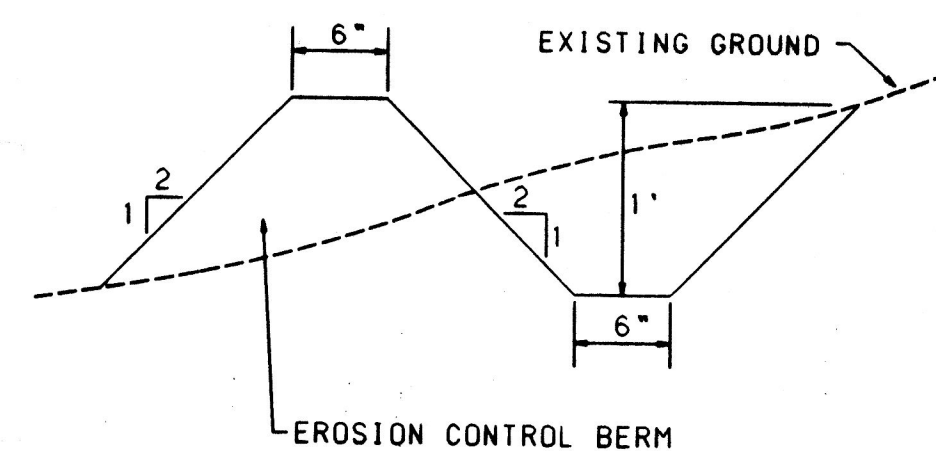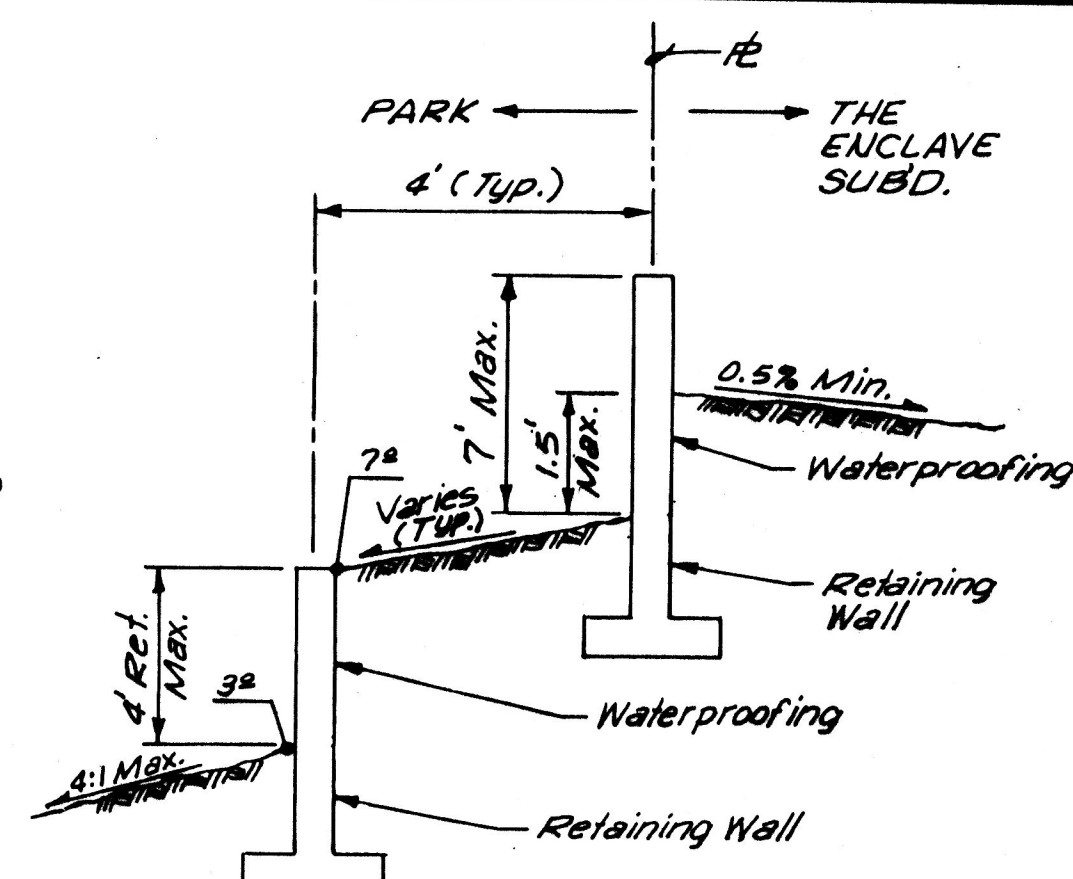

SECTION "A-A"
NOT TO SCALE

BOHANNAN-HUSTON INC. ENGINEERS • PLANNERS • PHOTOGRAMMETRISTS • SURVEYORS • LANDSCAPE ARCHITECTS ALBUQUERQUE LAS CRUCES SANTA FE	
CITY OF ALBUQUERQUE PUBLIC WORKS DEPARTMENT ENGINEERING DEVELOPMENT GROUP	
THE ENCLAVE AT HIGH DESERT TRACT 8C REVISED GRADING PLAN	
DESIGN REVIEW COMMITTEE	CITY ENGINEER APPROVAL
DATE: <i>12-8-99</i>	DATE: <i>12-8-99</i>
CITY PROJECT NO. 607091	ZONE MAP NO. E-23
DATE: <i>12-8-99</i>	DATE: <i>12-8-99</i>
CHECKED BY: <i>KGP</i>	CHECKED BY: <i>KGP</i>

RECORD DRAWING
DATE: *12-8-99*

Approved
@DRB


NO.	DATE	REMARKS	BY
1		DESIGN	
2		REVISIONS	
3		DESIGN	
4		REVISIONS	
JUN 20 2000
HYDROLOGY SECTION


BH1 JOB NO. C96: A208

COPYRIGHT BOHANNAN-HUSTON, INC. 1999


JUN 20 2000
HYDROLOGY SECTION

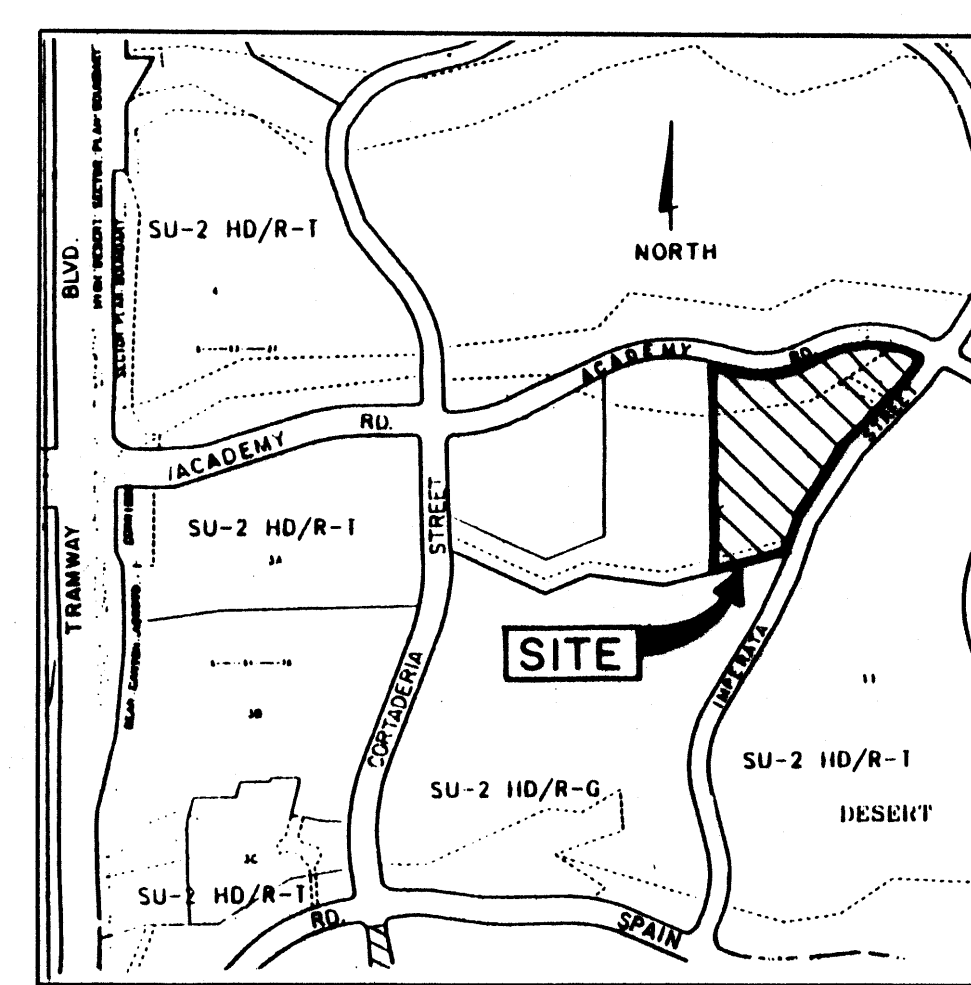


LOCATION MAP
ZONE ATLAS MAP NO. E-23
NO SCALE

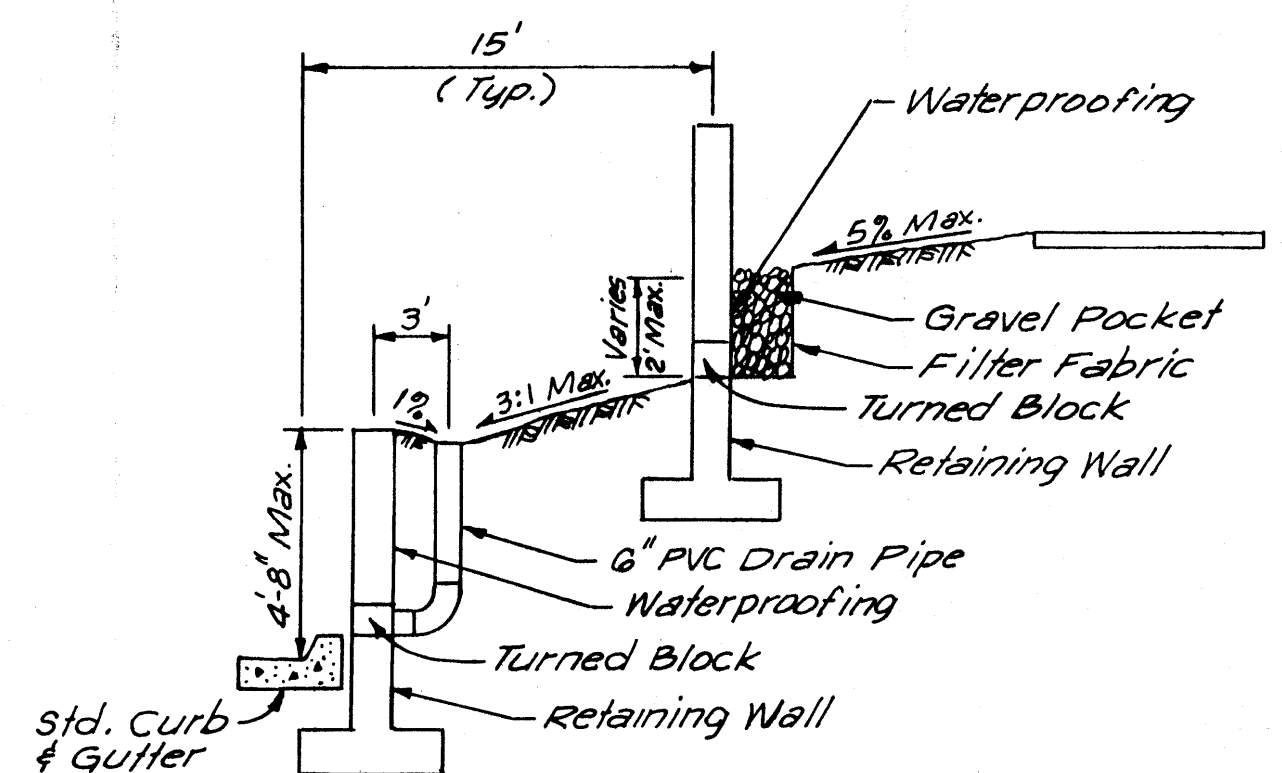

SECTION "B-B"
NOT TO SCALE

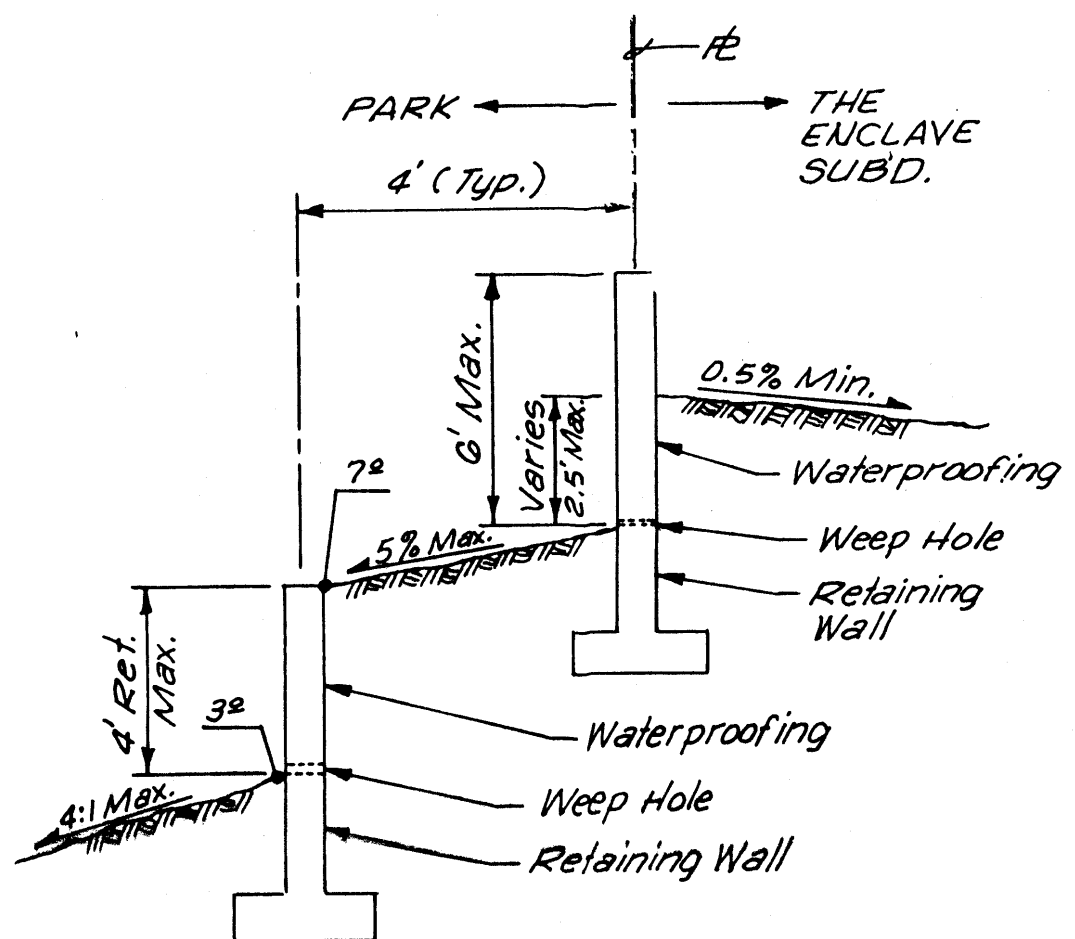

SECTION "A-A"
NOT TO SCALE

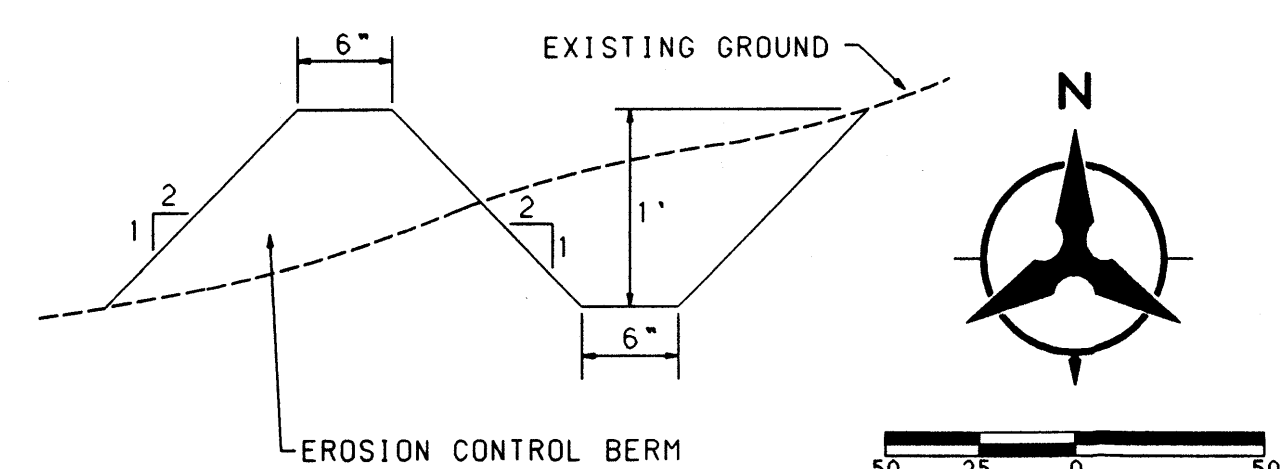

EROSION CONTROL PLAN
NO SCALE

A BERM WITH THE DIMENSIONS SHOWN SHALL BE MAINTAINED DURING CONSTRUCTION UNTIL COMPLETION OF INDIVIDUAL HOMES WITHIN THE PROJECT.

LEGEND	
PROJECT BOUNDARY	---
EXISTING CONTOUR	o 25.5
EXISTING SPOT ELEVATION	o 36.6
PROPOSED SPOT ELEVATION	• 36.6
DIRECTION OF FLOW	S=2.564%
BASIN BOUNDARY	---
SUB-BASIN BOUNDARY	---
PROPOSED 2.5" FILLED CMU WALL	---
EXISTING GARDEN WALL	---
EXISTING STORM DRAIN LINE	SD
EXISTING STORM DRAIN MANHOLE	o
EXISTING STORM DRAIN INLET	o
PROPOSED STORM DRAIN LINE	SD
PROPOSED STORM DRAIN MANHOLE	o
PROPOSED STORM DRAIN INLET	o
TOE OF SLOPE	---
EROSION CONTROL BERM	---
SILT FENCE	---

APPROVED FOR ROUGH GRADING (± 1')

John Clayton 12-22-78
HYDROLOGY ENGINEER DATE

BOHANNAN-HUSTON INC.
ENGINEERS • PLANNERS • PHOTOGRAMMETRISTS • SURVEYORS • LANDSCAPE ARCHITECTS
ALBUQUERQUE LAS CRUCES SANTA FE

CITY OF ALBUQUERQUE
PUBLIC WORKS DEPARTMENT
ENGINEERING DEVELOPMENT GROUP

HIGH DESERT
TRACT 8C
OVERALL GRADING PLAN

DESIGN REVIEW COMMITTEE	CITY ENGINEER APPROVAL	MO/DAY/YR	MO/DAY/YR

CITY PROJECT NO.	ZONE MAP NO.	SHEET	OF
	E-23	1	3

COPYRIGHT BOHANNAN-HUSTON, INC. 1998
DATE: SEPTEMBER, 1998

