
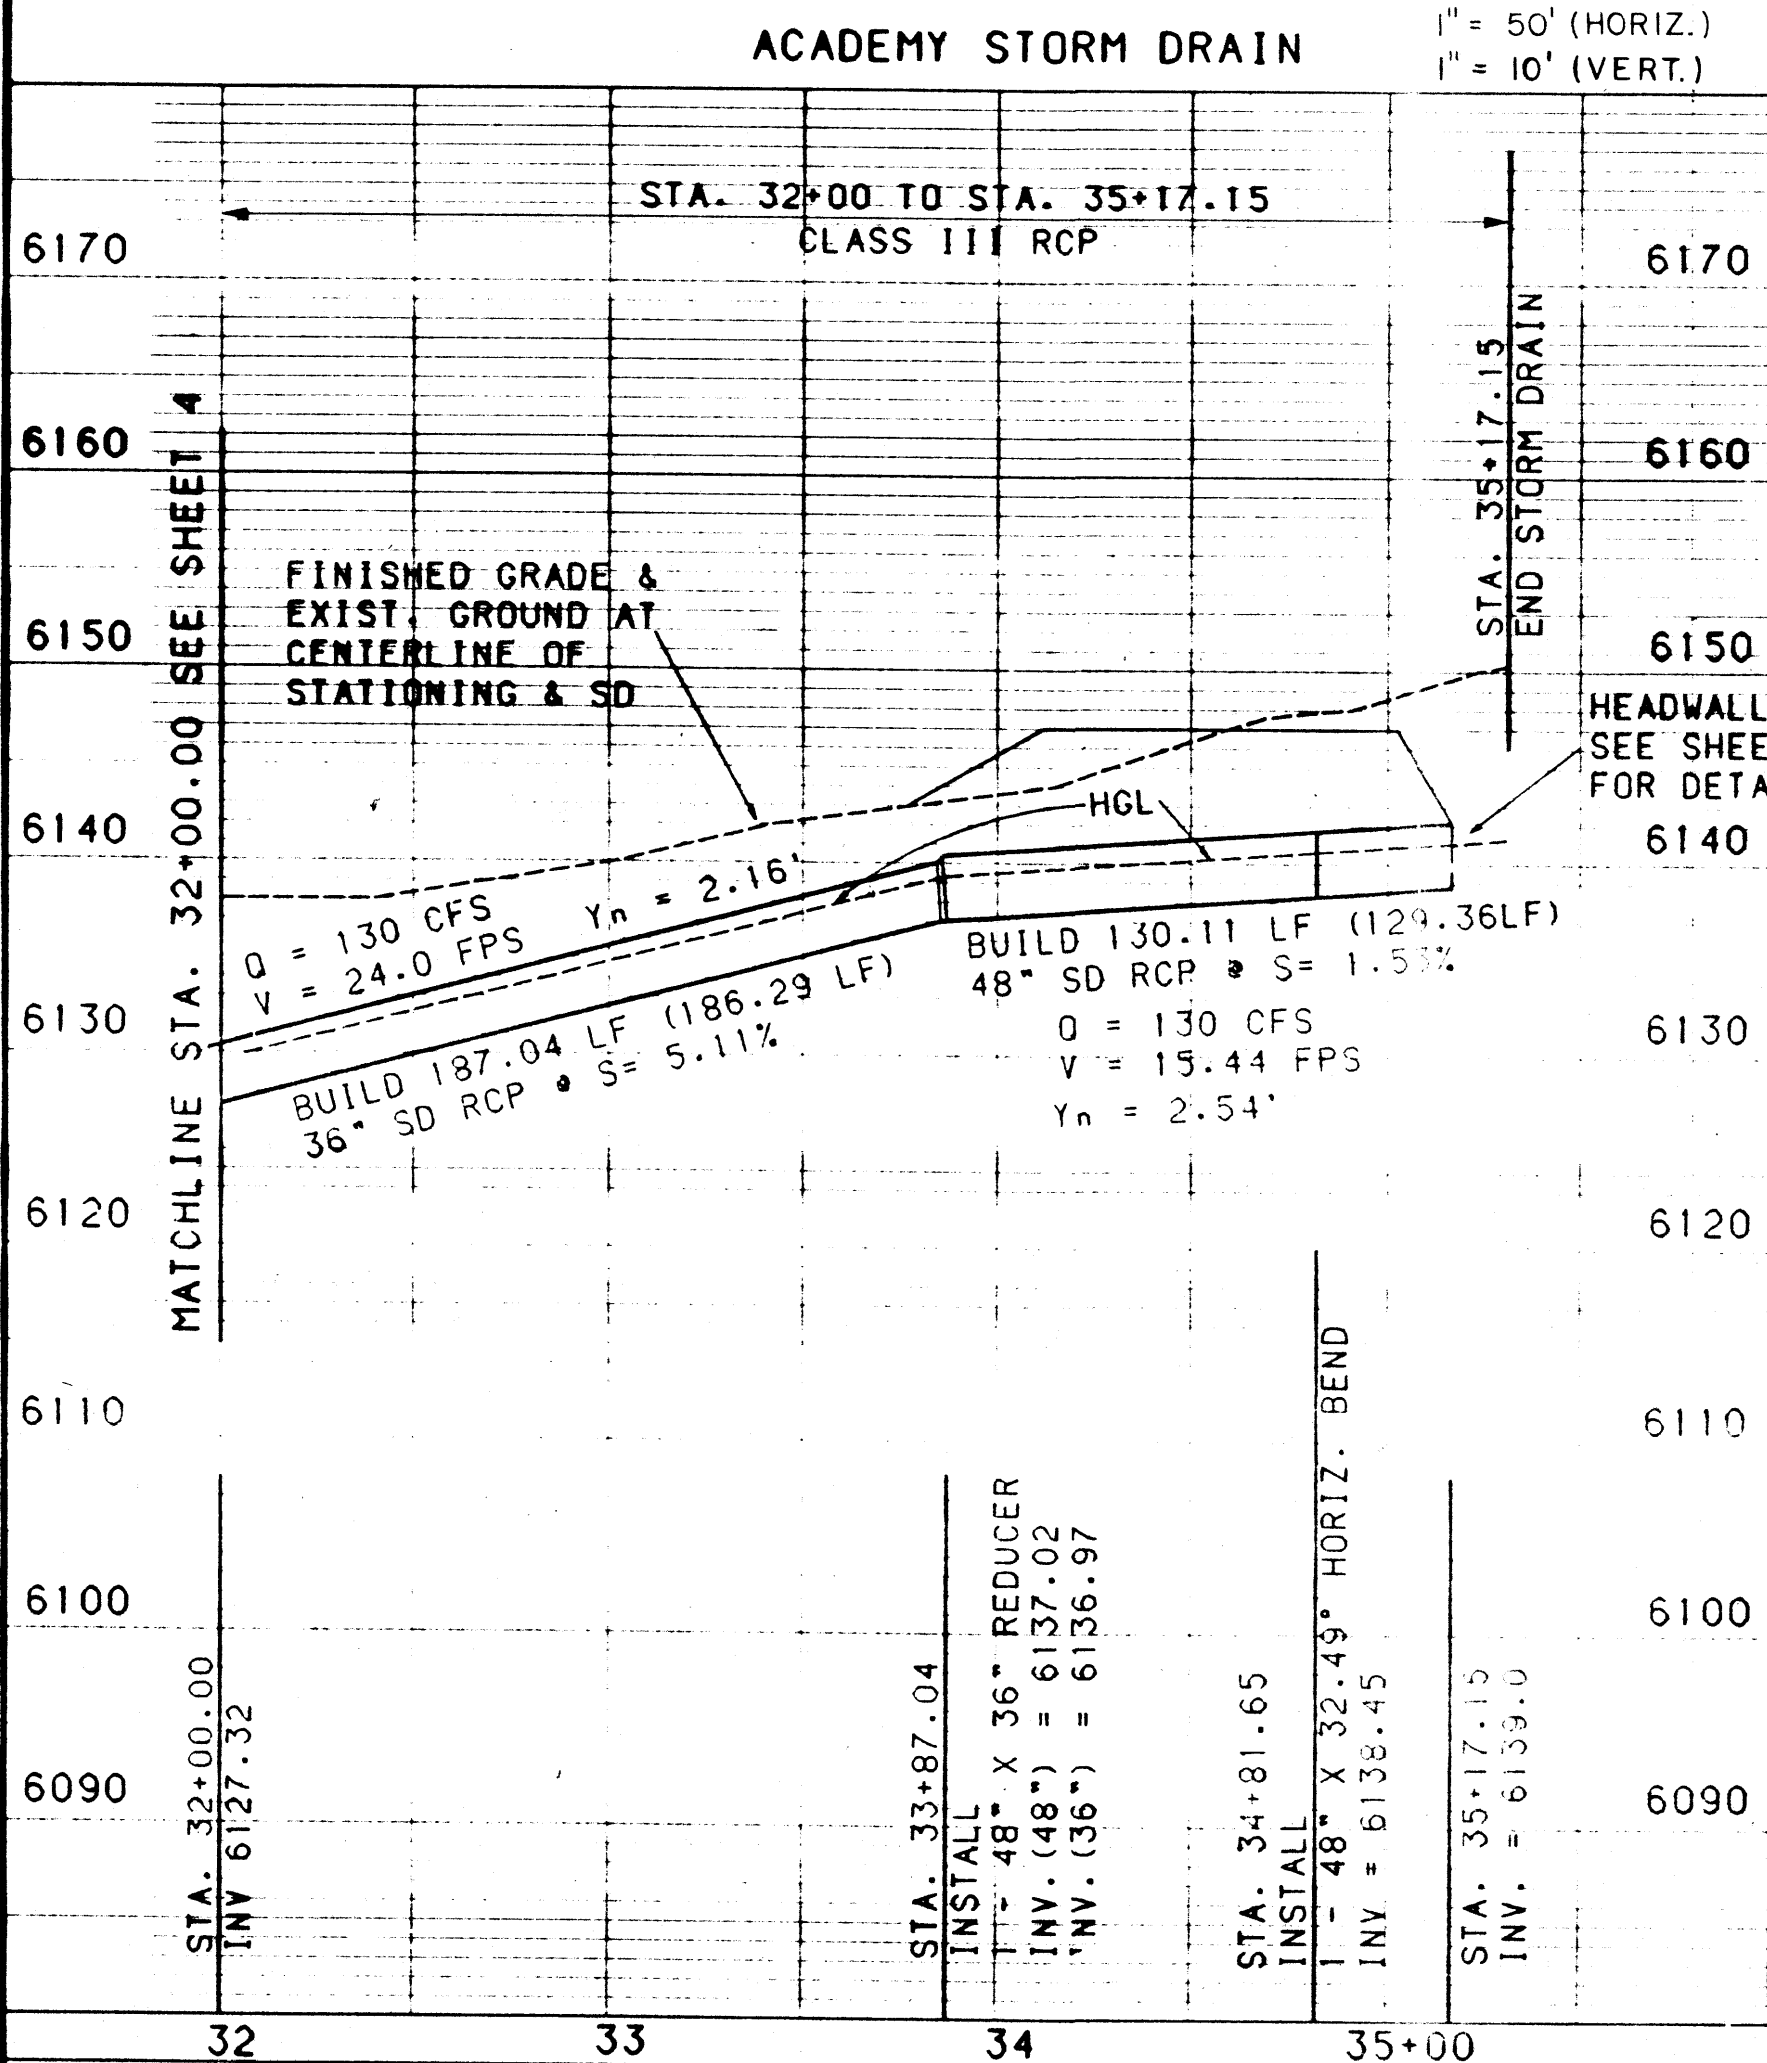


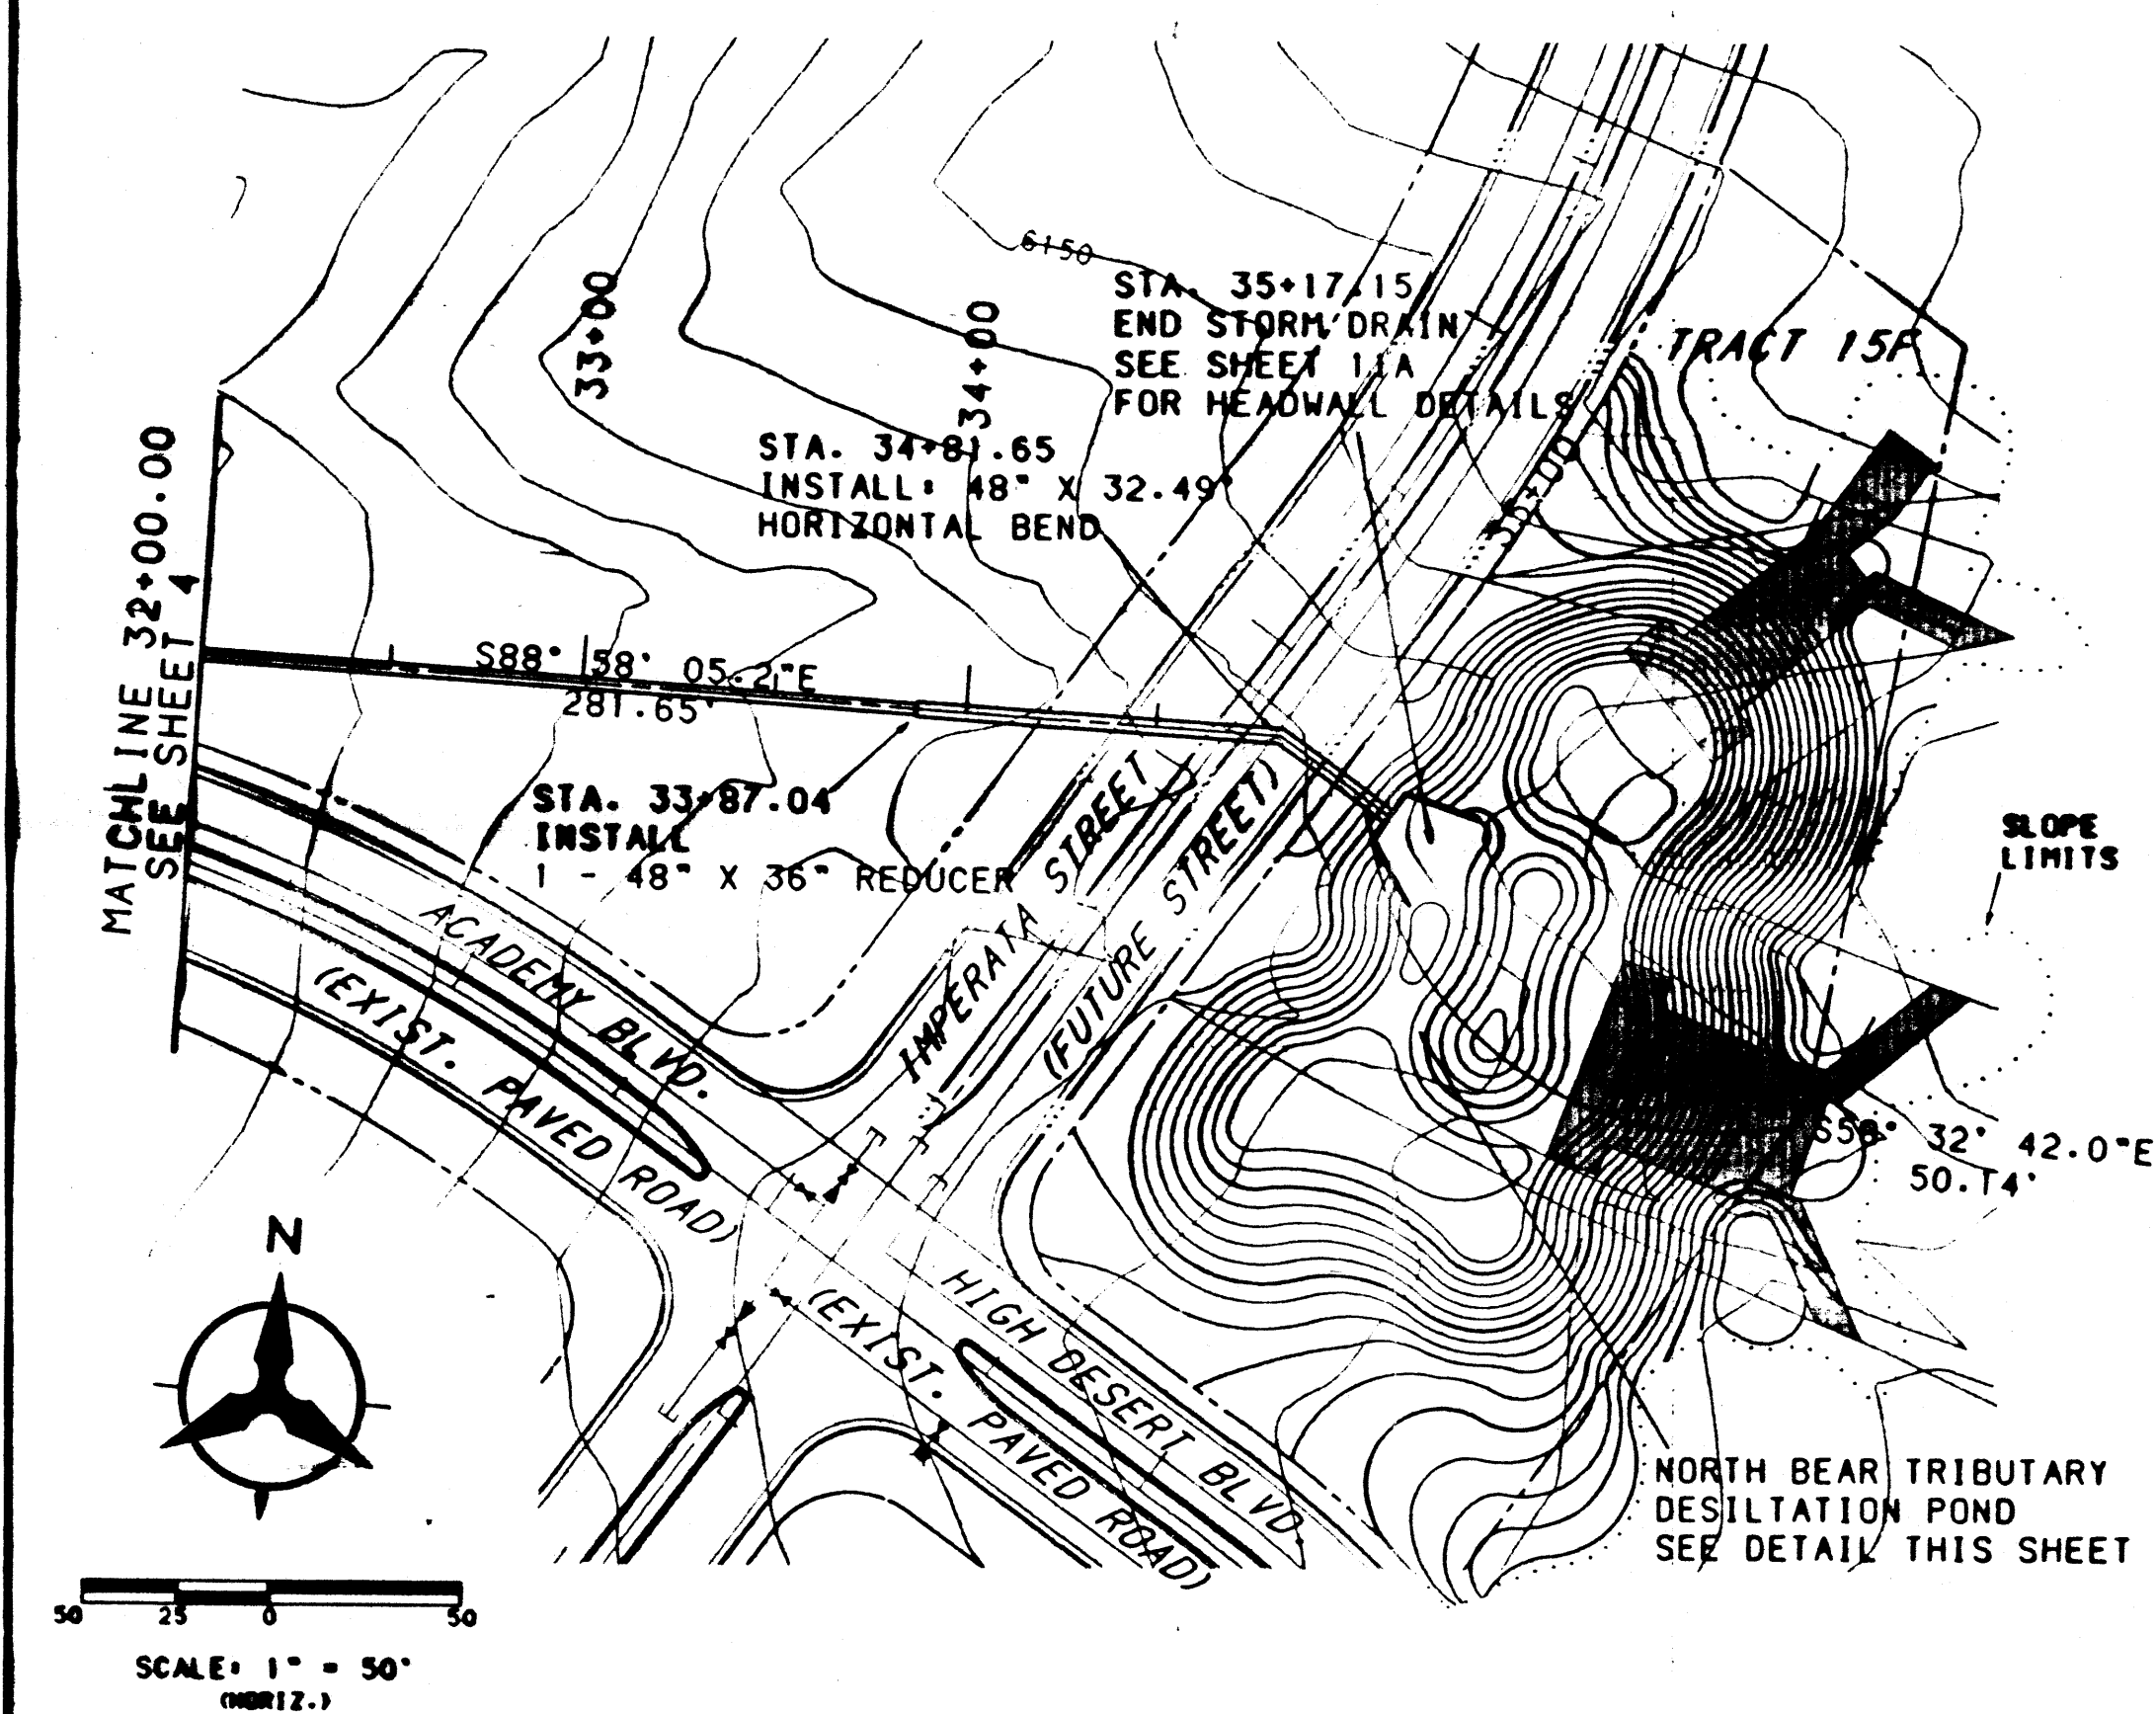

STA. 1+00 IMPERATA ST. =
STA. 1+00 HIGH DESERT ST. =
STA. 33+75.48 - 145.79 RT
ACADEMY STORM DRAIN

DRAINAGE CERTIFICATION

AS-BUILT ELEVATIONS ARE SHOWN ON THE PLAN IN LOCATIONS WHERE THE ORIGINAL DESIGN ELEVATION HAS BEEN CROSSED OUT AND THE NEW ELEVATION IS LISTED, OR BY AN "X" ELEVATIONS PROVIDED BY BOHANNAN-HUSTON, INC.

NOTES:

I, JAMES R. TOPMILLER, OF BOHANNAN-HUSTON, INC., A REGISTERED PROFESSIONAL ENGINEER IN THE STATE OF NEW MEXICO, DO HEREBY CERTIFY THAT THE EXISTING AND PROPOSED DRAINAGE CONDITIONS OF THIS SITE ARE IN SUBSTANTIAL COMPLIANCE WITH PREVIOUSLY APPROVED PLANS, TO THE BEST OF MY KNOWLEDGE AND BELIEF.


JAMES R. TOPMILLER, P.E.
N.M.E.E. No. 935

DATE: 1/12/96

BOHANNAN-HUSTON, INC.
REGISTERED PROFESSIONAL ENGINEER
1996

DRAINAGE CERTIFICATION NOTES:

1. The drainage certification survey was done approximately six (6) months after the construction of the desiltation ponds. The ponds have been in operation for one rainy season in this time period. As such, some of the pond bottom elevations exceed design elevations. These differences are deemed consistent with one year's (one rainy season) of silt.

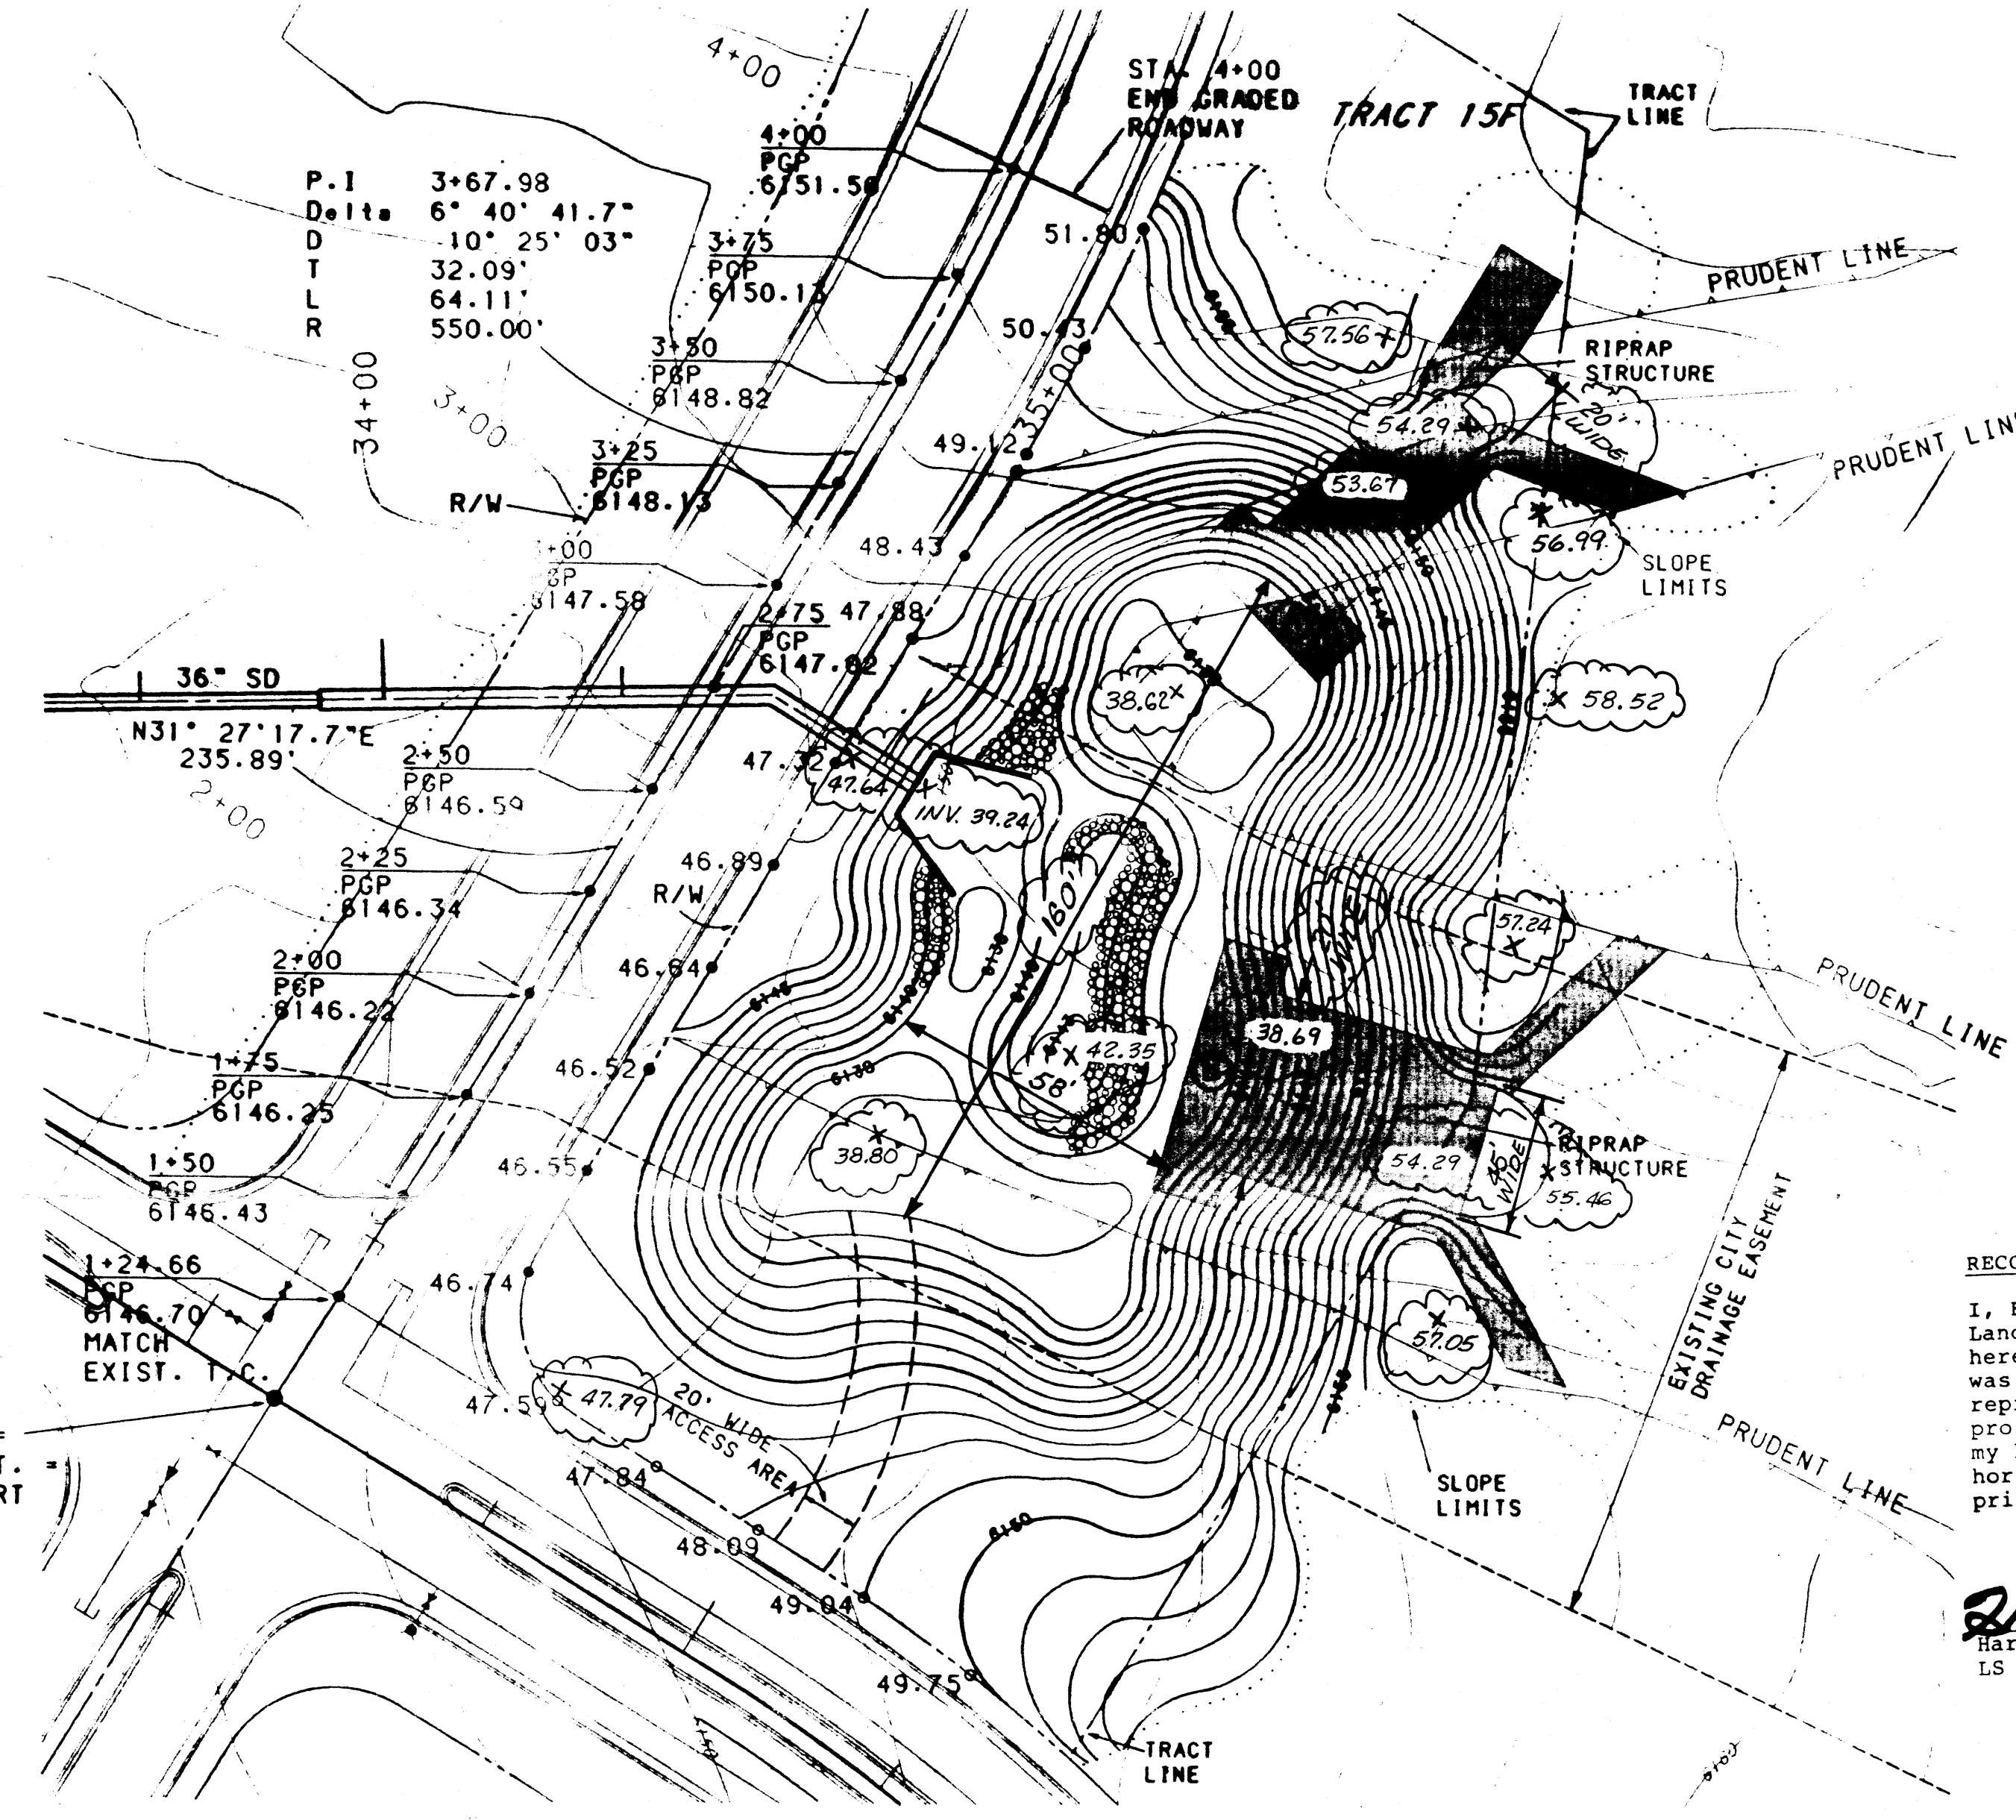

**NORTH BEAR TRIBUTARY
ARROYO DESILTATION POND**

SCALE 1" = 30'

- STRUCTURE NO. 1**
BUILD 12' WIDE TRAPEZOIDAL
RIPRAP LINED RUNDOWN SEE
SHEETS 8A AND 8B FOR DETAILS
- STRUCTURE NO. 2**
BUILD 27' WIDE TRAPEZOIDAL
RIPRAP LINED RUNDOWN SEE
SHEETS 8A AND 8B FOR DETAILS

NOTE:

BOULDERS SHALL BE PLACED IN ACCORDANCE WITH THE PLANS AND PLAN QUANTITIES AND DIRECTED BY THE PROJECT MANAGER. BOULDERS SHALL BE A MINIMUM OF 6" DIA. AND SHALL BE PLACED IN LAYERS FROM 1.5' TO 2.0' THICK.

- LIMITS OF WIRE TIED RIPRAP.
- SLOPE LIMITS
- PROPOSED ELEVATION
- EXISTING ELEVATION
- PRUDENT LINE
- BOULDERS
- AS-BUILT ELEVATION

QUANTITIES	
ITEM DESCRIPTION	QUANTITIES
DUMPED BOULDERS	10000
WIRE TIED RIPRAP	32500
GRAVEL FILTER	10800


1 2 3 4 5 6 7 8 9 10 11 12 13 14 15
26-78097-95 STA 1

- NOTES**
1. ALL STORM DRAIN SHALL BE CLASS III RCP, UNLESS OTHERWISE NOTED ON THE PLANS.
 2. ANY ADDITIONAL GRADING REQUIRED TO MATCH PROPOSED STREET GRADES SHALL BE INCIDENTAL TO PAVING ITEMS.
 3. CONTRACTOR SHALL PARK EQUIPMENT AND VEHICLES AS NOT TO INTERFERE WITH NORMAL ACTIVITIES OF RESIDENTS OR OTHER CONTRACTORS ON SITE.
 4. ANY DAMAGE TO THE EXISTING FACILITIES (CURB AND GUTTER, PAVEMENT, CONDUITS, LANDSCAPING, UTILITY LINES, ETC.) DURING CONSTRUCTION SHALL BE REPLACED AT THE CONTRACTOR'S EXPENSE.
 5. REMOVAL OF THE EXISTING CURB AND GUTTER SHALL BE AS PER COA STD. DWG. 2415 (SAMCUT ONLY).
 6. THE CONTRACTOR SHALL FIELD VERIFY ALL EXISTING UTILITY LOCATIONS AND NOTIFY THE ENGINEER IMMEDIATELY OF ANY DISCREPANCIES.
 7. ALL WORK DETAILED ON THESE PLANS TO BE PERFORMED UNDER CONTRACT SHALL, EXCEPT AS OTHERWISE STATED OR PROVIDED FOR HEREON, BE CONSTRUCTED IN ACCORDANCE WITH THE CITY OF ALBUQUERQUE STANDARD SPECIFICATIONS FOR PUBLIC WORKS CONSTRUCTION, 1986 EDITION, AS AMENDED WITH UPDATE #4.
 8. STORM DRAIN BUILD NOTE DISTANCES ARE FROM MM TO MM, WYE OR IN LINE VPI. DISTANCES IN PARENTHESIS DENOTE IN TO OUT DISTANCES BETWEEN MM'S WYES OR MATCHLINES. NO DISTANCE DIMENSIONS ARE TO BENDS, UNLESS OTHERWISE NOTED. SLOPES ARE CALCULATED FROM IN TO OUT INVERTS AND DISTANCES.
 9. CENTERLINE BEARING DISTANCES ARE FROM BEND TO BEND OR BEND TO MATCHLINE UNLESS OTHERWISE NOTED.
 10. ALL WYES SHALL BE 45° WYES UNLESS OTHERWISE NOTED ON PLANS.

RECORD DRAWING

I, Harvey P. Phillips, Registered Professional Land Surveyor in the State of New Mexico, do hereby certify that this "as-built" information was obtained by me or under my supervision and represents the "as-built" conditions of this project, and is true and correct to the best of my knowledge and belief. All vertical and horizontal dimensions should be field verified prior to use on future projects.

Harvey P. Phillips
LS No. 4767

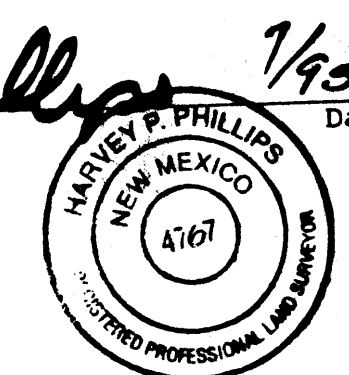

CITY OF ALBUQUERQUE PUBLIC WORKS DEPARTMENT ENGINEERING			
HIGH DESERT SUBDIVISION PHASE 1-B-1 STORM DRAIN PLAN & PROFILE ACADEMY STA. 32+00 TO 35+17.15			
APPROVALS	ENGINEER	DATE	APPROVALS
DR. CHAIRMAN	2-23-95	2-23-95	WATER
TRANSPORTATION	2-10-95	2-10-95	WASTE WATER
HYDROLOGY	2-3-95	2-3-95	
DRAWING NO. 4809.95		MAP NO. E-23	
SHEET 5A		OF 11	

