

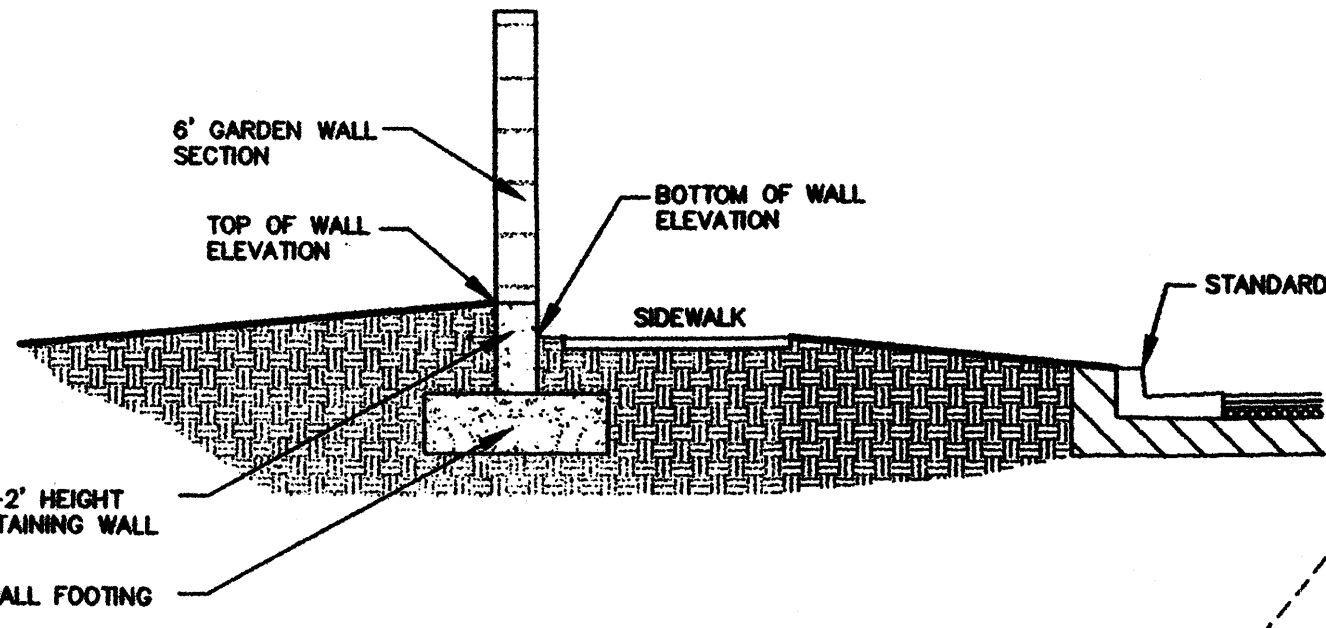


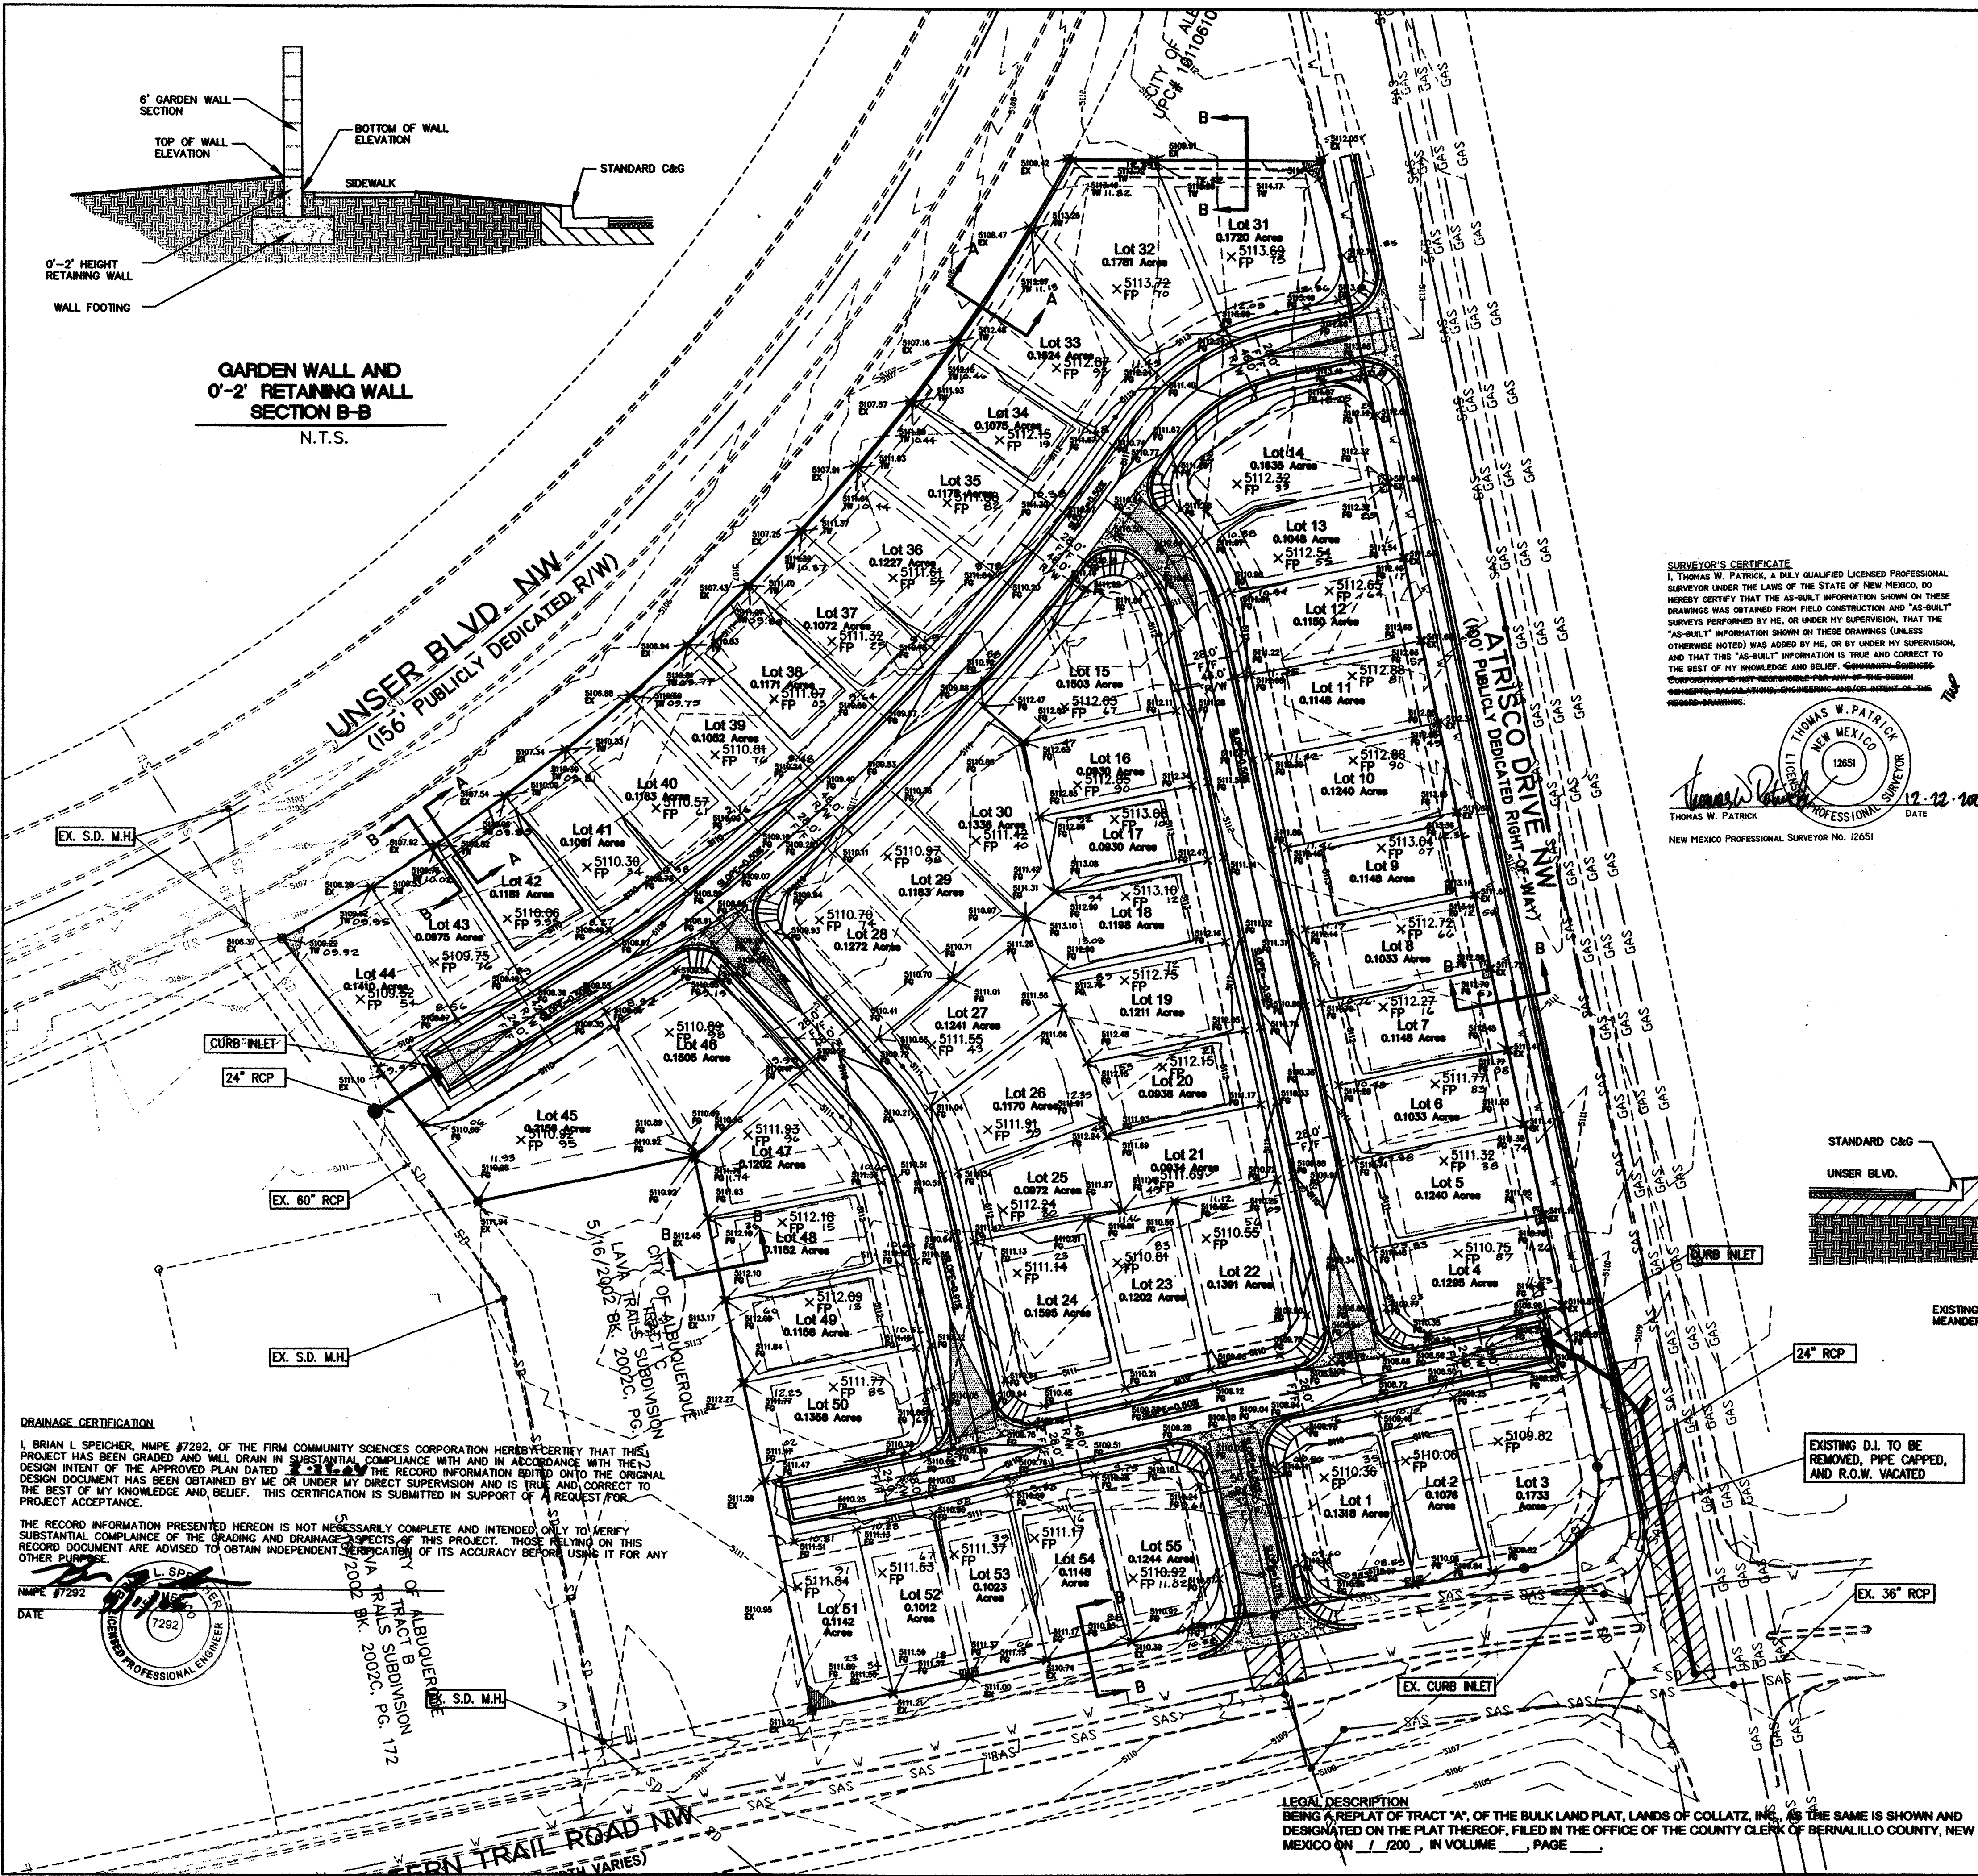


GARDEN WALL AND 0'-2' RETAINING WALL SECTION B-B
N.T.S.

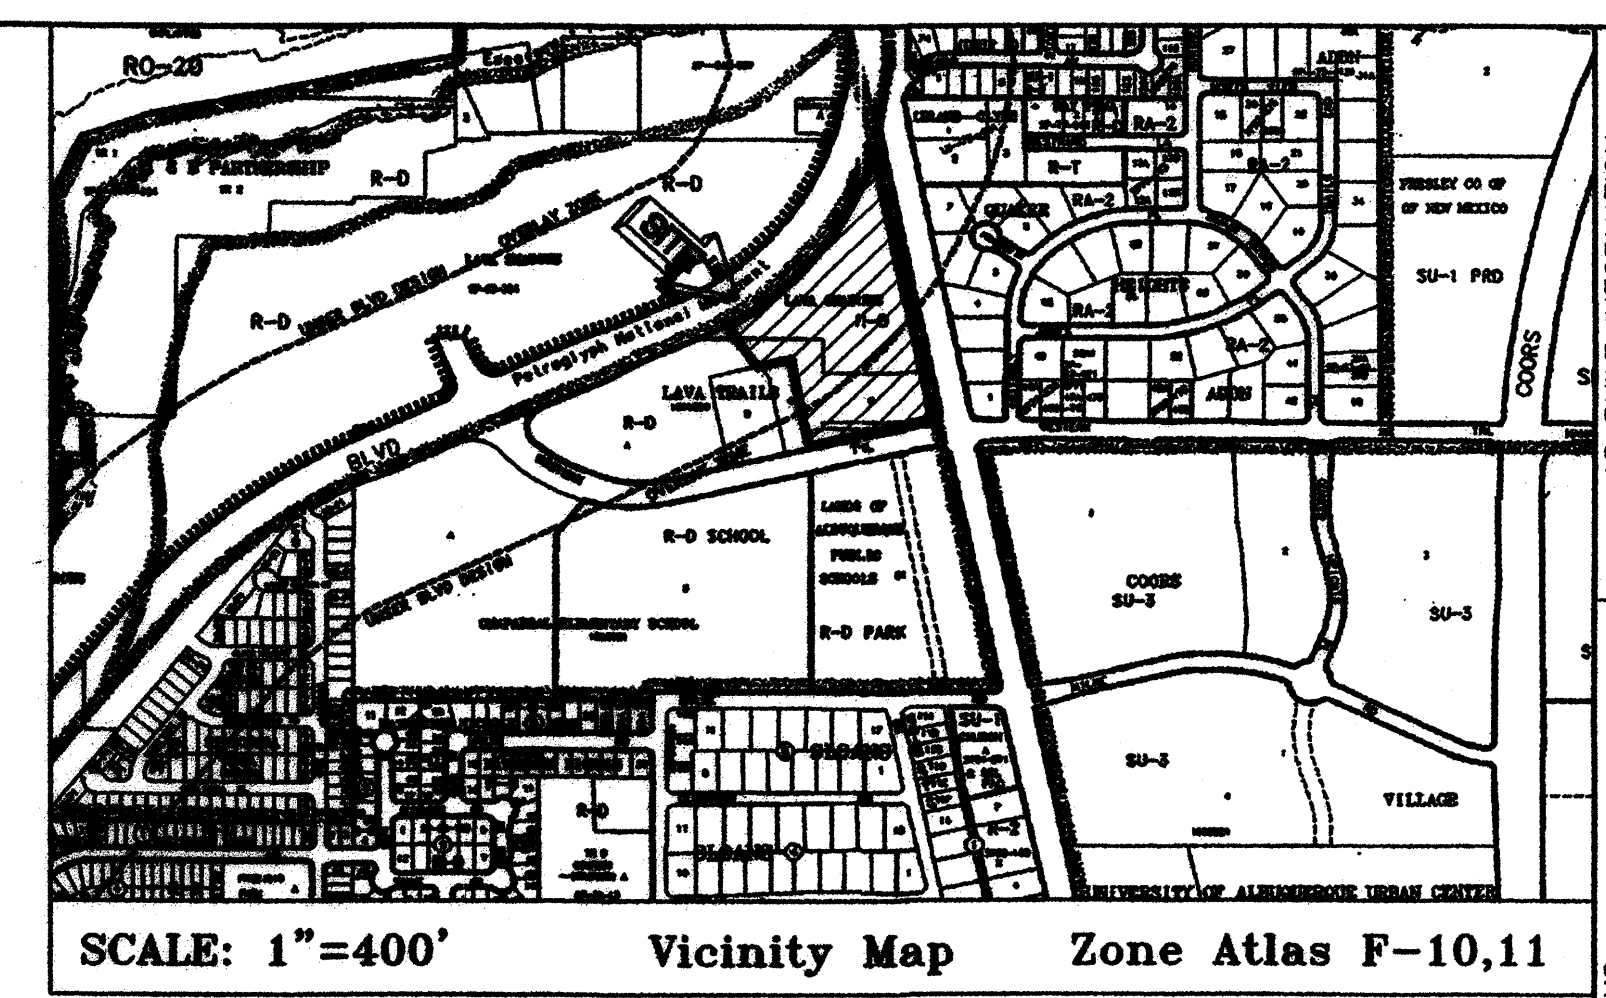

SCALE: 1"=400' Vicinity Map Zone Atlas F-10,11


- LEGEND**
- PROPOSED SPOT ELEVATION
 - EXISTING SPOT ELEVATION (GRND & TC)
 - PROPOSED CONCRETE VALLEY GUTTER
 - PROPOSED CURB & GUTTER
 - EXISTING CONTOUR W/ INDEX ELEVATION
 - PROPOSED MANHOLE
 - EXISTING STORM DRAIN
 - PROPOSED STORM DRAIN
 - PROPOSED STORM SEWER CATCH BASIN
 - BOUNDARY LINE
 - BASIN BOUNDARY
 - RETAINING WALL

SURVEYOR'S CERTIFICATE
I, THOMAS W. PATRICK, A DULY QUALIFIED LICENSED PROFESSIONAL SURVEYOR UNDER THE LAWS OF THE STATE OF NEW MEXICO, DO HEREBY CERTIFY THAT THE AS-BUILT INFORMATION SHOWN ON THESE DRAWINGS WAS OBTAINED FROM FIELD CONSTRUCTION AND "AS-BUILT" SURVEYS PERFORMED BY ME, OR UNDER MY SUPERVISION, THAT THE "AS-BUILT" INFORMATION SHOWN ON THESE DRAWINGS (UNLESS OTHERWISE NOTED) WAS ADDED BY ME, OR BY UNDER MY SUPERVISION, AND THAT THIS "AS-BUILT" INFORMATION IS TRUE AND CORRECT TO THE BEST OF MY KNOWLEDGE AND BELIEF.
THOMAS W. PATRICK
NEW MEXICO PROFESSIONAL SURVEYOR NO. 12651
DATE 12-12-2004

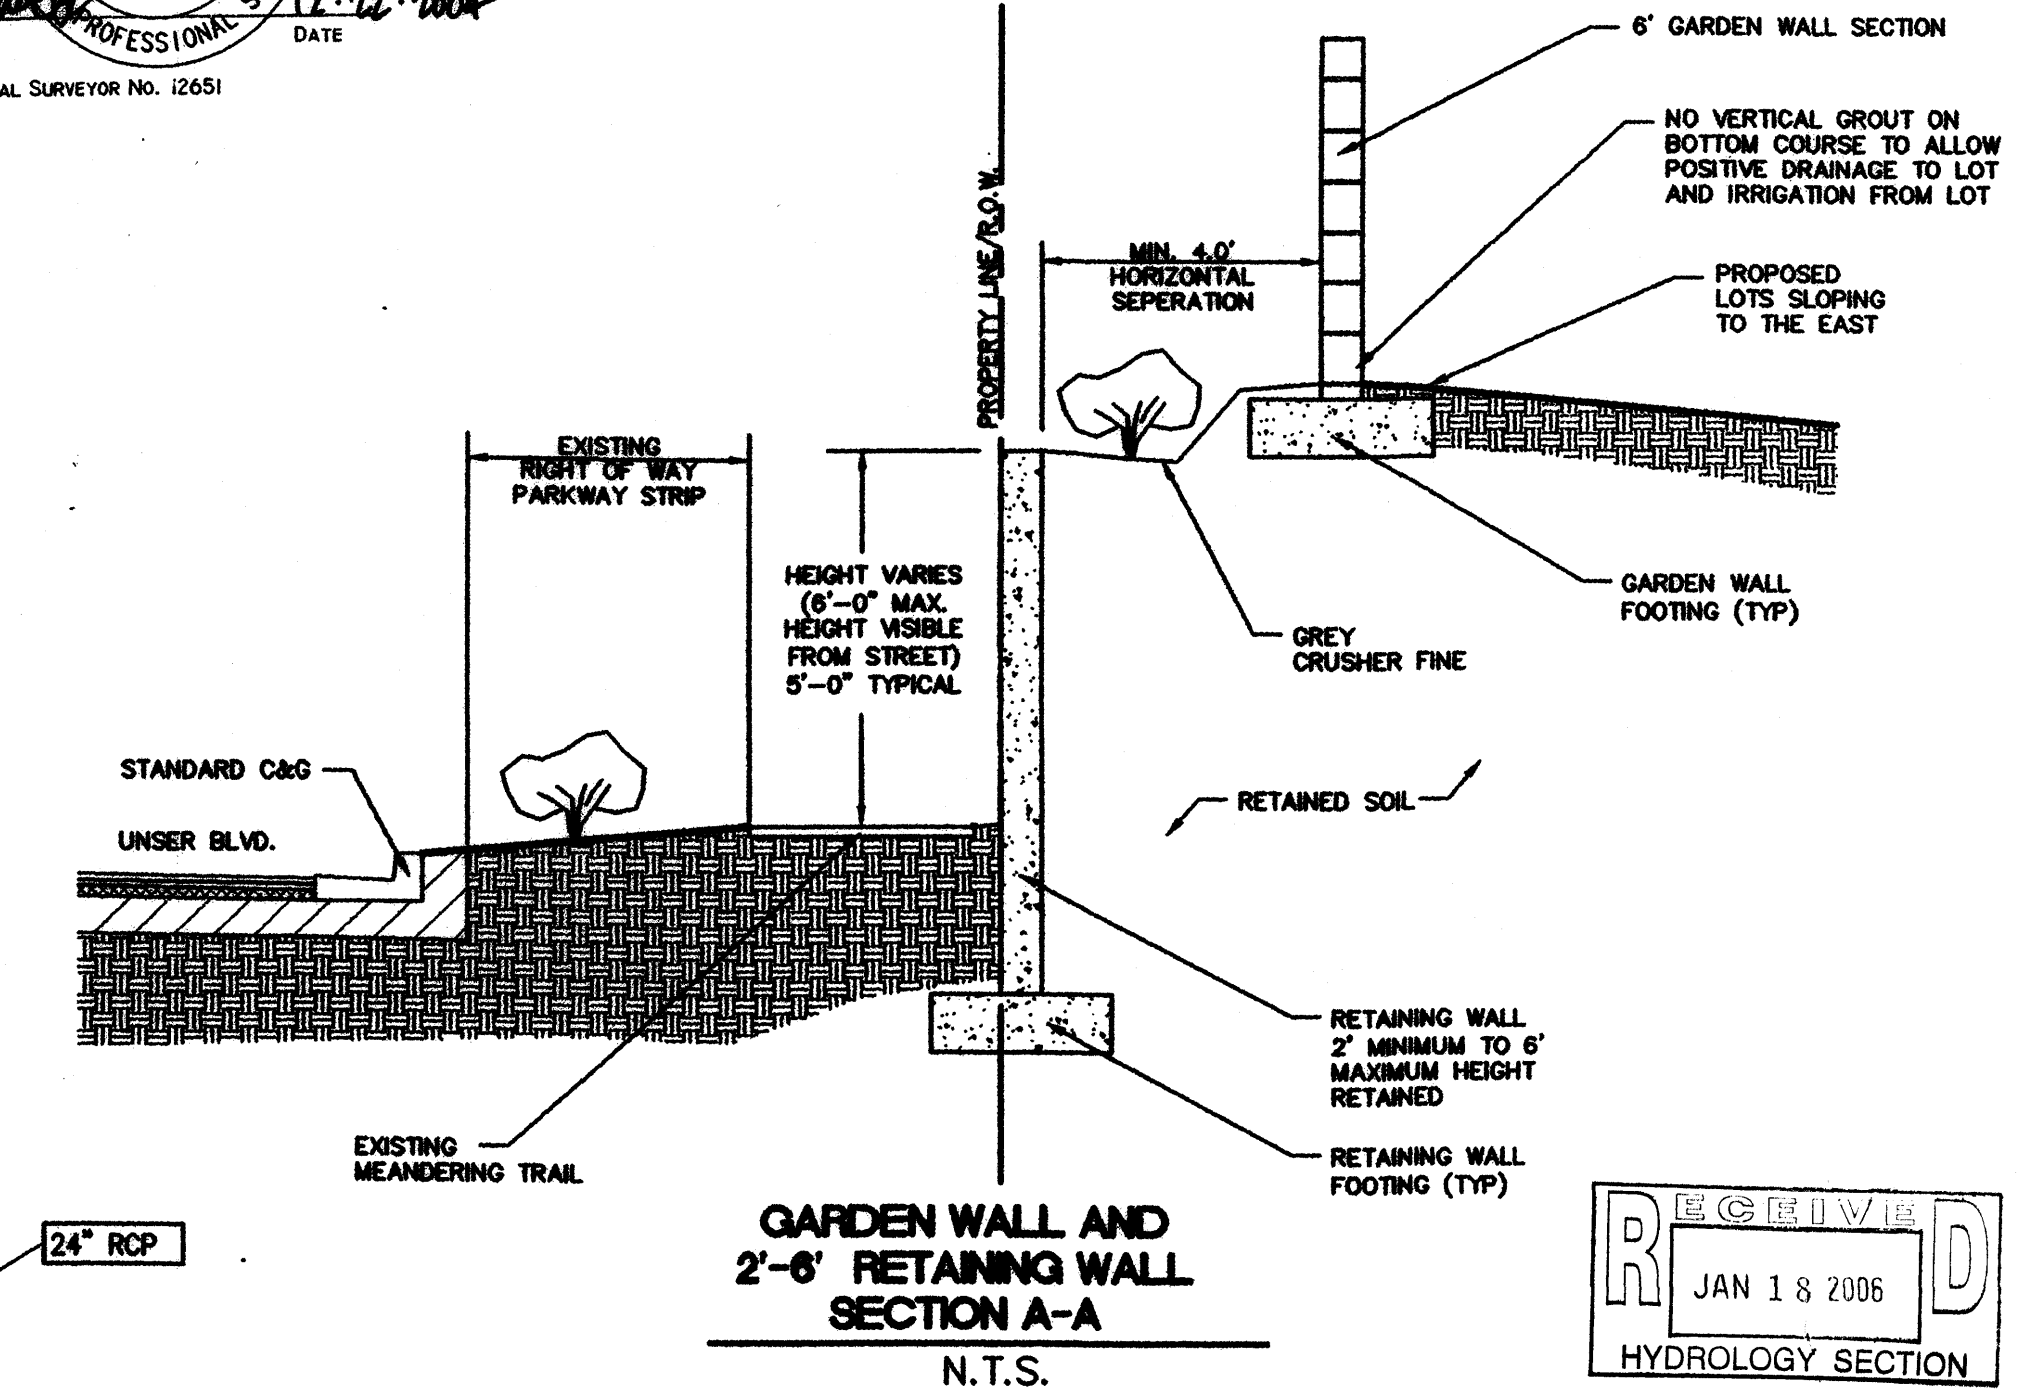


GARDEN WALL AND 2'-6' RETAINING WALL SECTION A-A
N.T.S.

DRAINAGE CERTIFICATION
I, BRIAN L. SPEICHER, NMPE #7292, OF THE FIRM COMMUNITY SCIENCES CORPORATION HEREBY CERTIFY THAT THIS PROJECT HAS BEEN GRADED AND DRAINAGE DESIGN IN SUBSTANTIAL COMPLIANCE WITH AND IN ACCORDANCE WITH THE DESIGN INTENT OF THE APPROVED PLAN DATED 3-8-00. THE RECORD INFORMATION SHOWN ON THE ORIGINAL DESIGN DOCUMENT HAS BEEN OBTAINED BY ME OR UNDER MY DIRECT SUPERVISION AND IS TRUE AND CORRECT TO THE BEST OF MY KNOWLEDGE AND BELIEF. THIS CERTIFICATION IS SUBMITTED IN SUPPORT OF A REQUEST FOR PROJECT ACCEPTANCE.
THE RECORD INFORMATION PRESENTED HEREON IS NOT NECESSARILY COMPLETE AND INTENDED ONLY TO VERIFY SUBSTANTIAL COMPLIANCE OF THE GRADING AND DRAINAGE DESIGNS OF THIS PROJECT. THOSE RELYING ON THIS RECORD DOCUMENT ARE ADVISED TO OBTAIN INDEPENDENT VERIFICATION OF ITS ACCURACY BEFORE USING IT FOR ANY OTHER PURPOSE.
BRIAN L. SPEICHER
NMPE #7292
DATE 12/12/2004

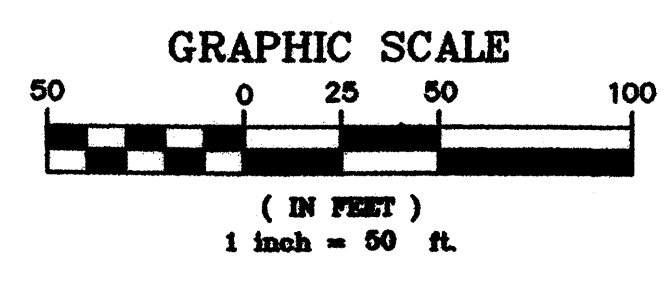

Community Sciences Corporation
LAND PLANNING ENGINEERING SURVEYING
P.O. Box 1328 Corrales, New Mexico 87048
JOB NO.: N494-06
CITY OF ALBUQUERQUE
PUBLIC WORKS DEPARTMENT
ENGINEERING DEVELOPMENT GROUP
RINCONADA TRAILS SUBDIVISION
OVERALL GRADING AND DRAINAGE PLAN
TITLE:
DESIGNED BY: REH
DRAWN BY: MWH
CHECKED BY: WHN
DATE: 03/2004
DATE: 03/2004
DATE: 03/2004
City Project No. 737481
Zone Map No. F-10,11
Sheet 7 of 21

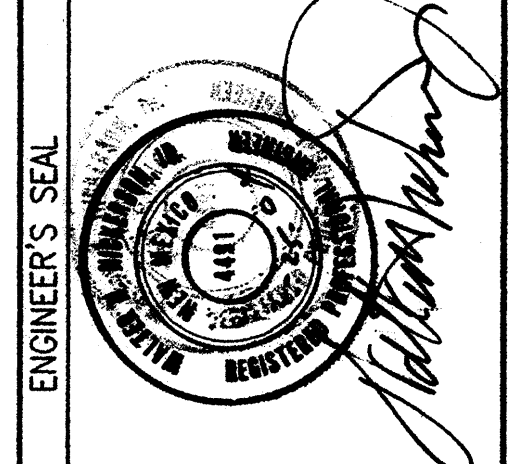

REVISIONS	DATE	BY
DESIGN	03/2004	REH
REVISIONS	03/2004	MWH
REVISIONS	03/2004	WHN