

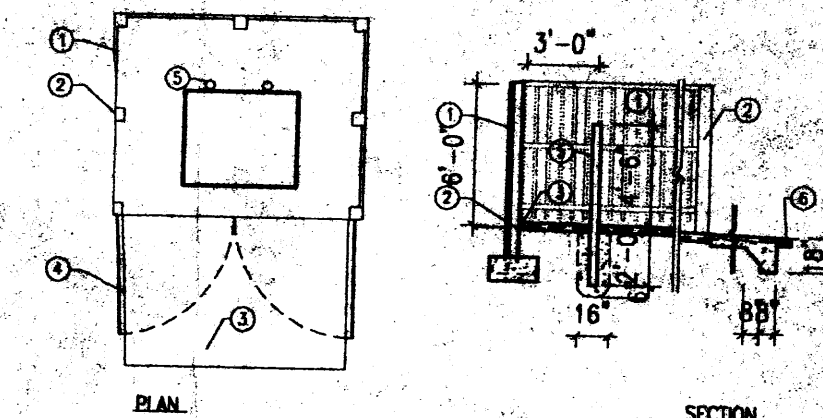


NOTES: NO NEW CHAIN-LINK, RAZOR WIRE (CONCERTINA) OR PLASTIC VINYL FENCING IS PERMITTED.
THE TOP OF ALL ROOFTOP EQUIPMENT SHALL BE BELOW THE TOP OF PARAPET AND SCREENED FROM VIEW FROM THE PROPERTY LINES OF THIS SITE. ROOFTOP EQUIPMENT SHALL BE SCREENED BY ROOFTOP WALLS THAT ARE PAINTED TO MATCH THE PREDOMINANT BUILDING COLOR. ALL GROUND-MOUNTED EQUIPMENT SHALL BE SCREENED BY SCREEN WALLS WITH TOP OF EQUIPMENT BELOW TOP OF SCREEN WALL.

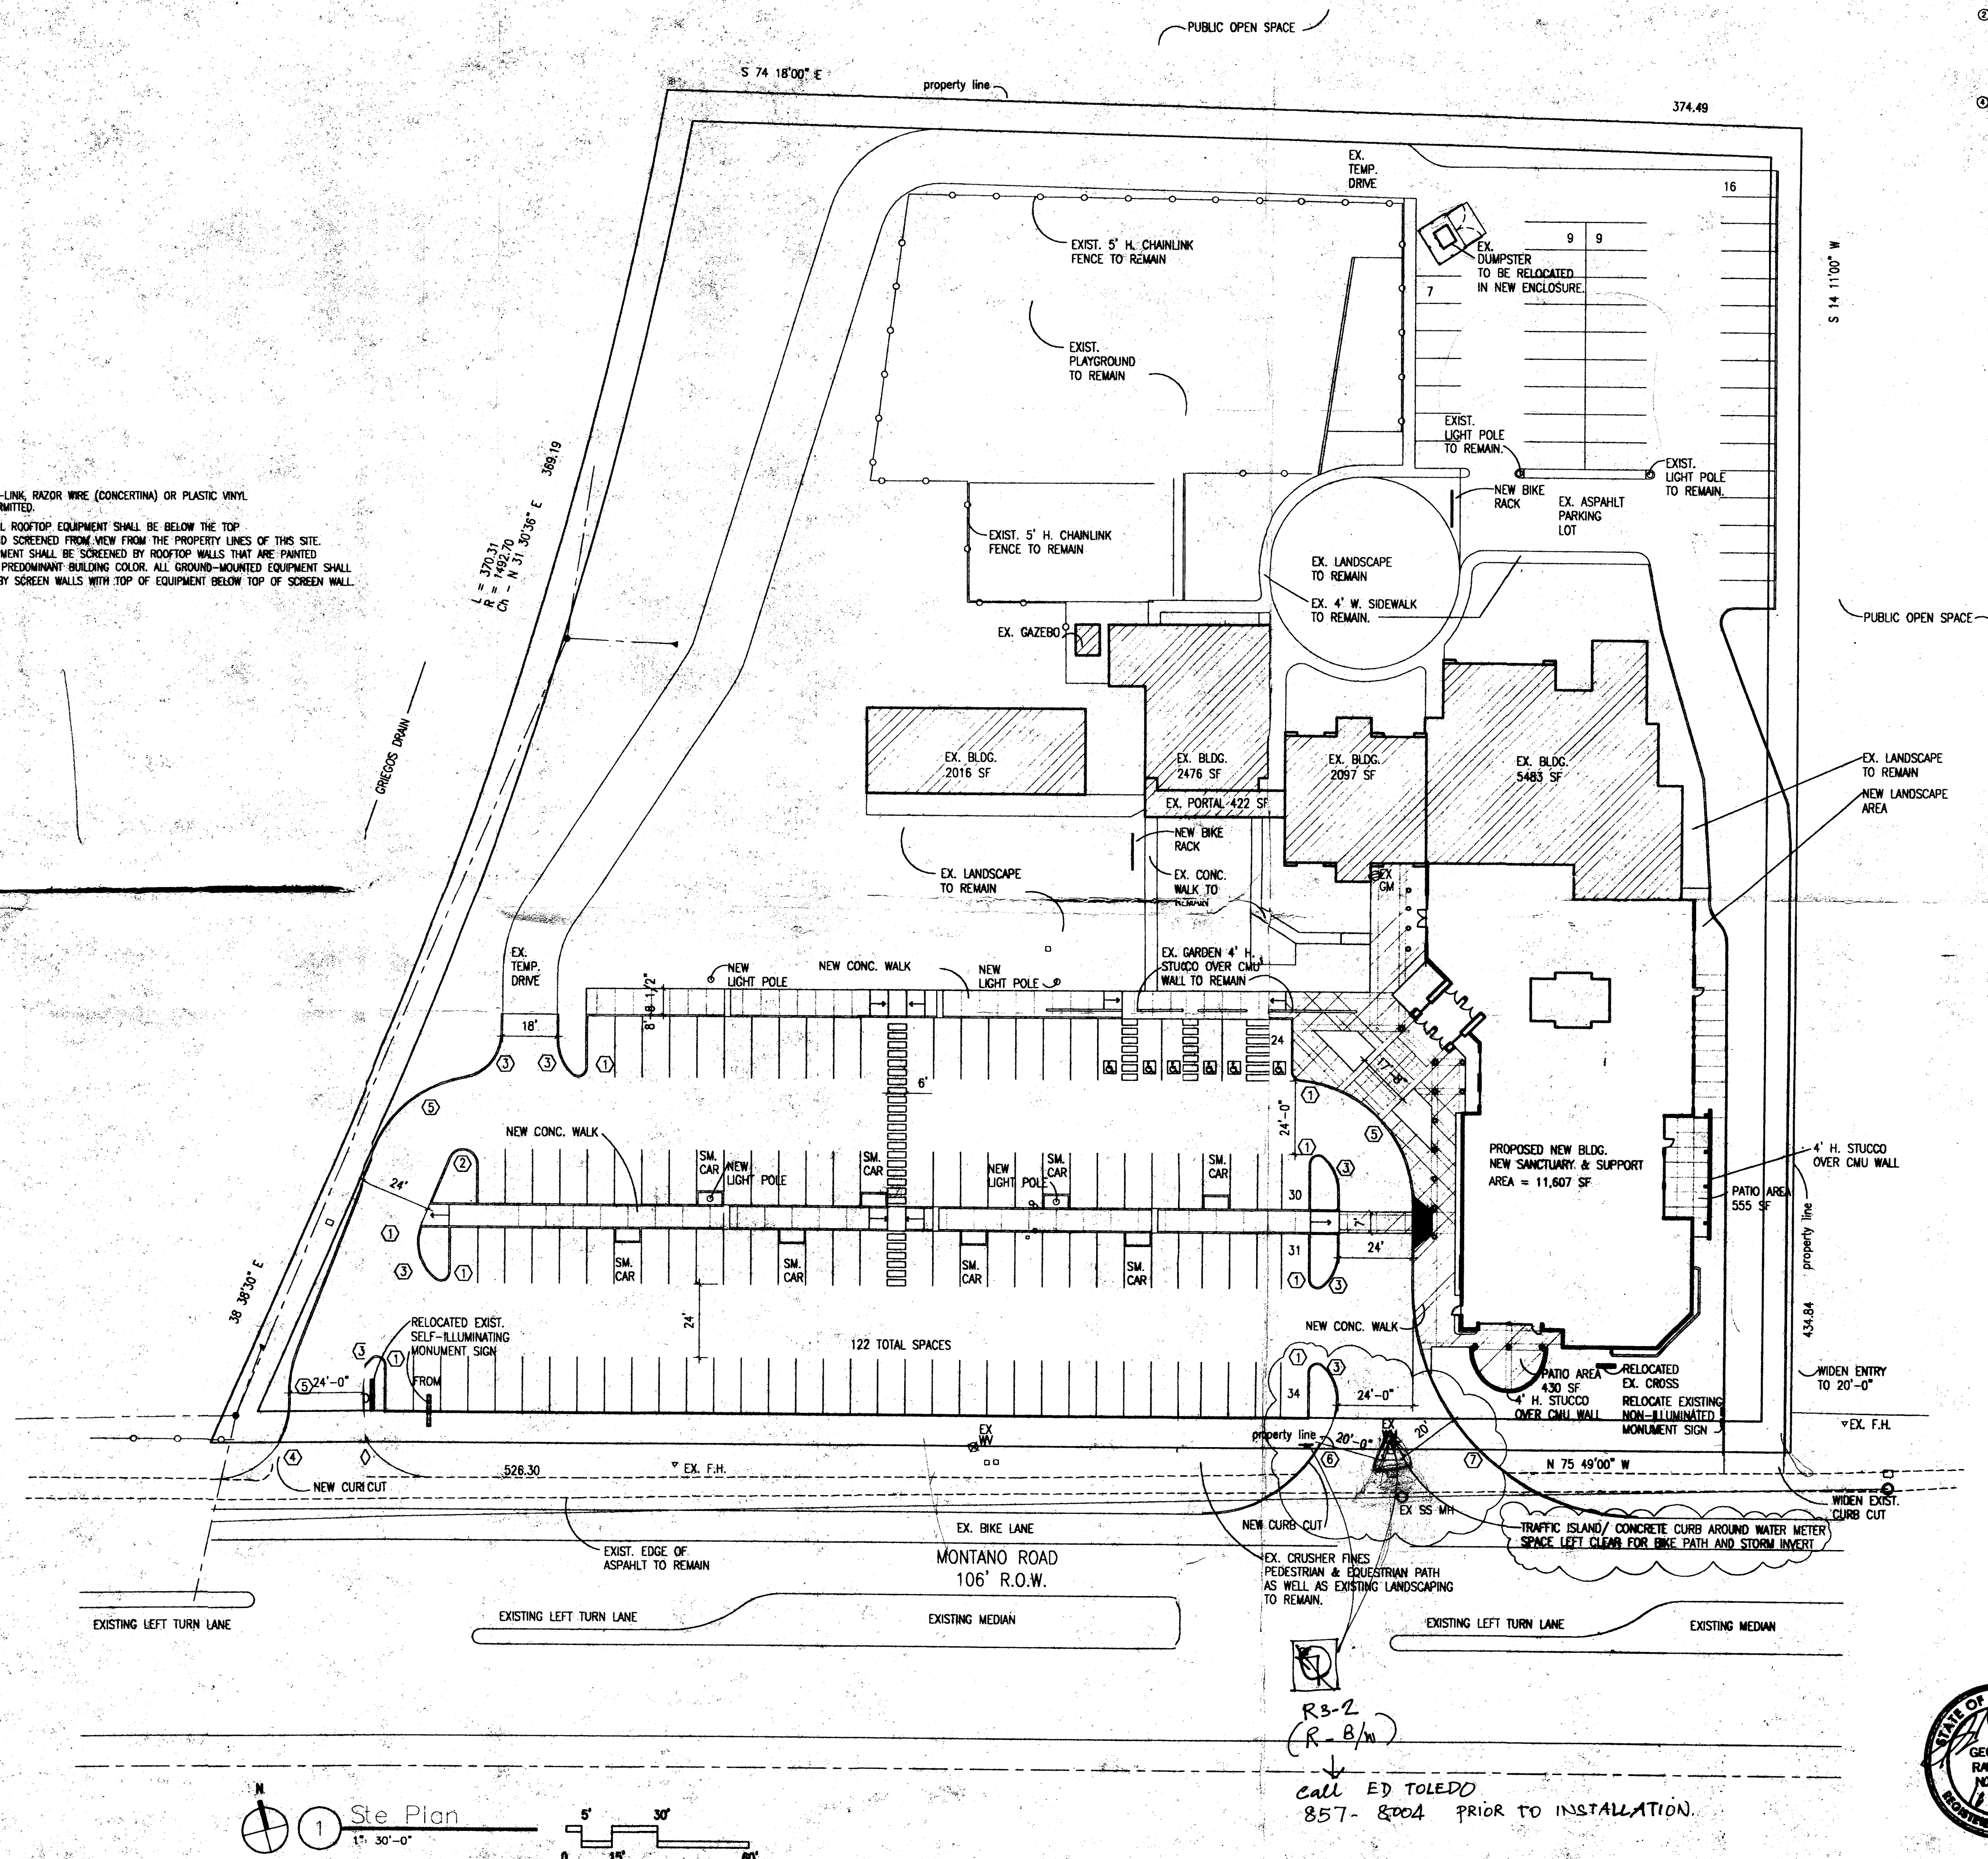

- ① CEDAR FENCE SUPPORTED BY 8x8 WOODEN POSTS
- ② 8" x 8" WOODEN POSTS
- ③ CONC. PLATFORM TO BE LEVEL WITH THE ASPHALT DRIVE
- ④ EACH GATE TO HAVE ONE BELT WITH PAULOWNIA LEAVES
- ⑤ 1 1/2" DIA. BOLLARDS
- ⑥ ADJOINING ASPHALT

3 Trash Enclosure Detail
Scale: Not to Scale

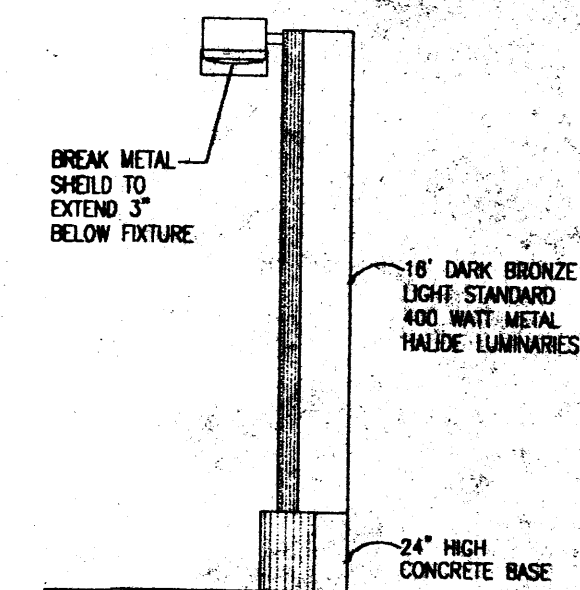

NOTE:
SHORT LIGHTING PROVIDED ON THE BUILDING FACADES SHALL BE ANGLED TO BE NON-INTRUSIVE INTO ADJACENT AREAS.
SITE LIGHTING LOCATIONS: PHOTOMETRIC SITE PLAN WILL BE PROVIDED WITH THE BUILDING PERMIT.

2 Site Lighting Detail
Scale: Not to Scale

SITE UTILITIES

WATER, SANITARY SEWER & GAS CONNECTIONS EXIST. ON THE SITE. NO NEW CITY CONNECTIONS.

PARKING CALCULATIONS

CHURCH USE - 1 PARKING SPACE PER FOUR OCCUPANTS
TOTAL PARKING SPACES REQUIRED: 400 OCCUPANTS / 4 = 100 SPACES


TOTAL HANDICAPPED SPACES REQUIRED: 4 SPACES
TOTAL HANDICAPPED SPACES PROVIDED: 6 SPACES
TOTAL STANDARD EXISTING CAR SPACES PROVIDED: 41 SPACES
TOTAL STANDARD NEW CAR SPACES PROVIDED: 105 SPACES
TOTAL PARKING SPACES PROVIDED: 150 SPACES

TOTAL BIKE SPACES REQUIRED: 4 SPACES
TOTAL BIKE SPACES PROVIDED: 10 SPACES

RADIUS INFORMATION

- ① RADIUS = 3'-0"
- ② RADIUS = 5'-0"
- ③ RADIUS = 15'-0"
- ④ RADIUS = 25'-0"
- ⑤ RADIUS = 40'-0"
- ⑥ RADIUS = 45'-0"
- ⑦ RADIUS = 75'-0"

ADMINISTRATIVE
DEVELOPMENT PLAN AMENDMENT
09/11/09
FILE NO. AA-01189
Approved: 10/10/09
M. J. [Signature]
8/17/02
PLANNING DIRECTOR DATE

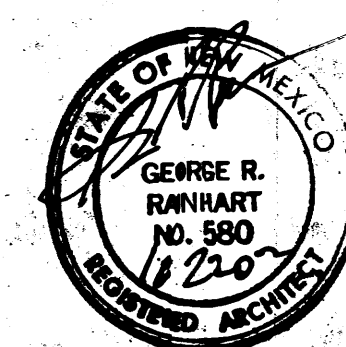


RECEIVED
OCT 24 2002
HYDROLOGY SECTION

REV	DATE	BY	REVISION
1	07/10/02	GS	AS BUILTS
2	07/10/02	GS	PRE COMMENTS
3	04/10/02	GS	EX. DRIVEWAY & NOTES

PLOT DATE: 04/10/02

GEORGE RAINHART, ARCHITECT & ASSOCIATES P.C.
2325 SAN PEDRO NE, SUITE 2B
ALBUQUERQUE, NEW MEXICO 87110
505.884-9110 fax 505.837-9877

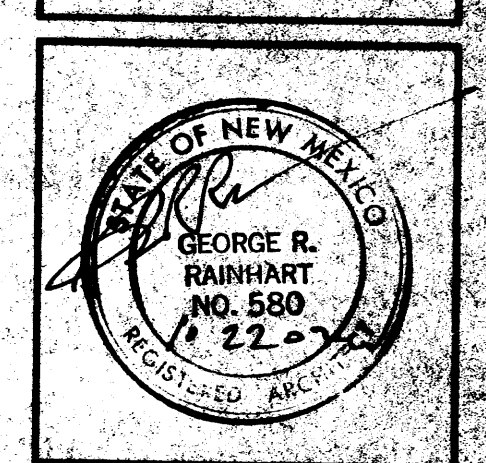

PROJECT TITLE Shepherd of the Valley	PROJECT MANAGER GEORGE RAINHART	JOB NO. 0087	DRAWN BY MMH
DATE	SHEET	SCALE	of
		1" = 30'-0"	A01

R3-2
(R = 8' min)
Call ED TOLEDO
857-8004 PRIOR TO INSTALLATION.

GS
7/11/02