

## 1. AHYMO INPUT DATA

START TIME=0.0

\*\*\*\*\* HYDROGRAPH FOR PHILLIPS 66 PROPOSED IMPROVEMENTS  
\*\*\*\*\* NORTHWEST CORNER OF 4TH STREET AND MONTANO  
\*\*\*\*\* PONDING REQUIREMENT WILL BE THE DIFFERENCE FROM  
\*\*\*\*\* FREE DISCHARGE AND TOTAL DEVELOPED FLOW

RAINFALL TYPE=1 RAIN QUARTER=0.0 IN  
RAIN ONE=2.01 IN RAIN SIX=2.35 IN  
RAIN DAY=2.75 IN DT=0.03333 HR

\*HYDROGRAPH OF DEVELOPED FLOW IN EXISTING BASIN  
COMPUTE NM HYD ID=1 HYD NO=101.1 AREA=0.0012967 SQ MI  
PER A=0.00 PER B=5.00 PER C=0.00 PER D=95.00  
TP=0.1333 HR MASS RAINFALL=-1  
ID=1 CODE=1

\*HYDROGRAPH OF EXISTING BASIN WITH FREE DISCHARGE  
\*THIS HYD WILL DETERMINE THE ALLOWABLE DISCHARGE FROM THE SITE  
COMPUTE NM HYD ID=2 HYD NO=101.2 AREA=0.0011565 SQ MI  
PER A=0.00 PER B=0.00 PER C=0.00 PER D=100.00  
TP=0.1333 HR MASS RAINFALL=-1  
ID=2 CODE=1

PRINT HYD

FINISH

## 2. AHYMO OUTPUT DATA

AHYMO PROGRAM (AHYMO194) - AMAFCA Hydrologic Model - January, 1994  
RUN DATE (MON/DAY/YR) = 05/15/1996  
START TIME (HR:MIN:SEC) = 13:07:09 USER NO. = M\_GOODWIN/D1  
INPUT FILE = PH66-4TH.DAT

START TIME=0.0

\*\*\*\*\* HYDROGRAPH FOR PHILLIPS 66 PROPOSED IMPROVEMENTS  
\*\*\*\*\* NORTHWEST CORNER OF 4TH STREET AND MONTANO  
\*\*\*\*\* PONDING REQUIREMENT WILL BE THE DIFFERENCE FROM  
\*\*\*\*\* FREE DISCHARGE AND TOTAL DEVELOPED FLOW

RAINFALL TYPE=1 RAIN QUARTER=0.0 IN  
RAIN ONE=2.01 IN RAIN SIX=2.35 IN  
RAIN DAY=2.75 IN DT=0.03333 HR

COMPUTED 6-HOUR RAINFALL DISTRIBUTION BASED ON NOAA ATLAS 2 - PEAK AT 1.40 HR  
DT = .033333 HOURS END TIME = 5.999400 HOURS

.0000	.0016	.0033	.0049	.0066	.0084	.0102
.0120	.0139	.0158	.0178	.0199	.0219	.0241
.0263	.0286	.0309	.0333	.0358	.0384	.0411
.0439	.0467	.0497	.0529	.0561	.0596	.0631
.0669	.0709	.0751	.0807	.0866	.0930	.1066
.1371	.1840	.2514	.3434	.4644	.6186	.8106
1.0449	1.2624	1.3533	1.4300	1.4982	1.5602	1.6174
1.6704	1.7200	1.7664	1.8102	1.8514	1.8904	1.9273
1.9622	1.9953	2.0268	2.0566	2.0850	2.0915	2.0976
2.1033	2.1088	2.1140	2.1191	2.1239	2.1285	2.1329
2.1373	2.1414	2.1454	2.1494	2.1531	2.1568	2.1604
2.1639	2.1673	2.1706	2.1739	2.1771	2.1802	2.1832
2.1862	2.1891	2.1919	2.1947	2.1975	2.2002	2.2028
2.2054	2.2080	2.2105	2.2130	2.2154	2.2178	2.2202
2.2225	2.2248	2.2270	2.2293	2.2315	2.2336	2.2358
2.2379	2.2399	2.2420	2.2440	2.2460	2.2480	2.2500
2.2519	2.2538	2.2557	2.2576	2.2594	2.2612	2.2631
2.2648	2.2666	2.2684	2.2701	2.2718	2.2735	2.2752
2.2769	2.2785	2.2802	2.2818	2.2834	2.2850	2.2866
2.2881	2.2897	2.2912	2.2928	2.2943	2.2958	2.2973
2.2987	2.3002	2.3017	2.3031	2.3045	2.3060	2.3074
2.3088	2.3102	2.3115	2.3129	2.3143	2.3156	2.3169
2.3183	2.3196	2.3209	2.3222	2.3235	2.3248	2.3261
2.3273	2.3286	2.3298	2.3311	2.3323	2.3335	2.3348
2.3360	2.3372	2.3384	2.3396	2.3408	2.3419	2.3431
2.3443	2.3454	2.3466	2.3477	2.3488	2.3500	

\*HYDROGRAPH OF DEVELOPED FLOW IN EXISTING BASIN  
COMPUTE NM HYD ID=1 HYD NO=101.1 AREA=0.0012967 SQ MI  
PER A=0.00 PER B=5.00 PER C=0.00 PER D=95.00  
TP=0.1333 HR MASS RAINFALL=-1

K = .072649HR TP = .133300HR K/TP RATIO = .545000 SHAPE CONSTANT, N = 7.106420  
UNIT PEAK = 4.8635 CFS UNIT VOLUME = .9969 B = 526.28 P60 = 2.0100  
AREA = .001232 SQ MI IA = .10000 INCHES INF = .04000 INCHES PER HOUR  
RUNOFF COMPUTED BY INITIAL ABSTRACTION/INFILTRATION NUMBER METHOD - DT = .033330

K = .132088HR TP = .133300HR K/TP RATIO = .990905 SHAPE CONSTANT, N = 3.563124  
UNIT PEAK = .15803 CFS UNIT VOLUME = .9154 B = 324.91 P60 = 2.0100  
AREA = .000065 SQ MI IA = .50000 INCHES INF = 1.25000 INCHES PER HOUR  
RUNOFF COMPUTED BY INITIAL ABSTRACTION/INFILTRATION NUMBER METHOD - DT = .033330

PRINT HYD ID=1 CODE=1

PARTIAL HYDROGRAPH 101.10

RUNOFF VOLUME = 2.04851 INCHES = .1417 ACRE-Feet  
PEAK DISCHARGE RATE = 3.82 CFS AT 1.500 HOURS BASIN AREA = .0013 SQ. MI.

\*HYDROGRAPH OF EXISTING BASIN WITH FREE DISCHARGE  
\*THIS HYD WILL DETERMINE THE ALLOWABLE DISCHARGE FROM THE SITE  
COMPUTE NM HYD ID=2 HYD NO=101.2 AREA=0.0011565 SQ MI  
PER A=0.00 PER B=0.00 PER C=0.00 PER D=100.00  
TP=0.1333 HR MASS RAINFALL=-1

K = .072649HR TP = .133300HR K/TP RATIO = .545000 SHAPE CONSTANT, N = 7.106420  
UNIT PEAK = 4.5659 CFS UNIT VOLUME = .9969 B = 526.28 P60 = 2.0100  
AREA = .001156 SQ MI IA = .10000 INCHES INF = .04000 INCHES PER HOUR  
RUNOFF COMPUTED BY INITIAL ABSTRACTION/INFILTRATION NUMBER METHOD - DT = .033330


PRINT HYD ID=2 CODE=1

PARTIAL HYDROGRAPH 101.20

RUNOFF VOLUME = 2.11537 INCHES = .1305 ACRE-Feet  
PEAK DISCHARGE RATE = 3.49 CFS AT 1.500 HOURS BASIN AREA = .0012 SQ. MI.

FINISH

NORMAL PROGRAM FINISH END TIME (HR:MIN:SEC) = 13:07:10

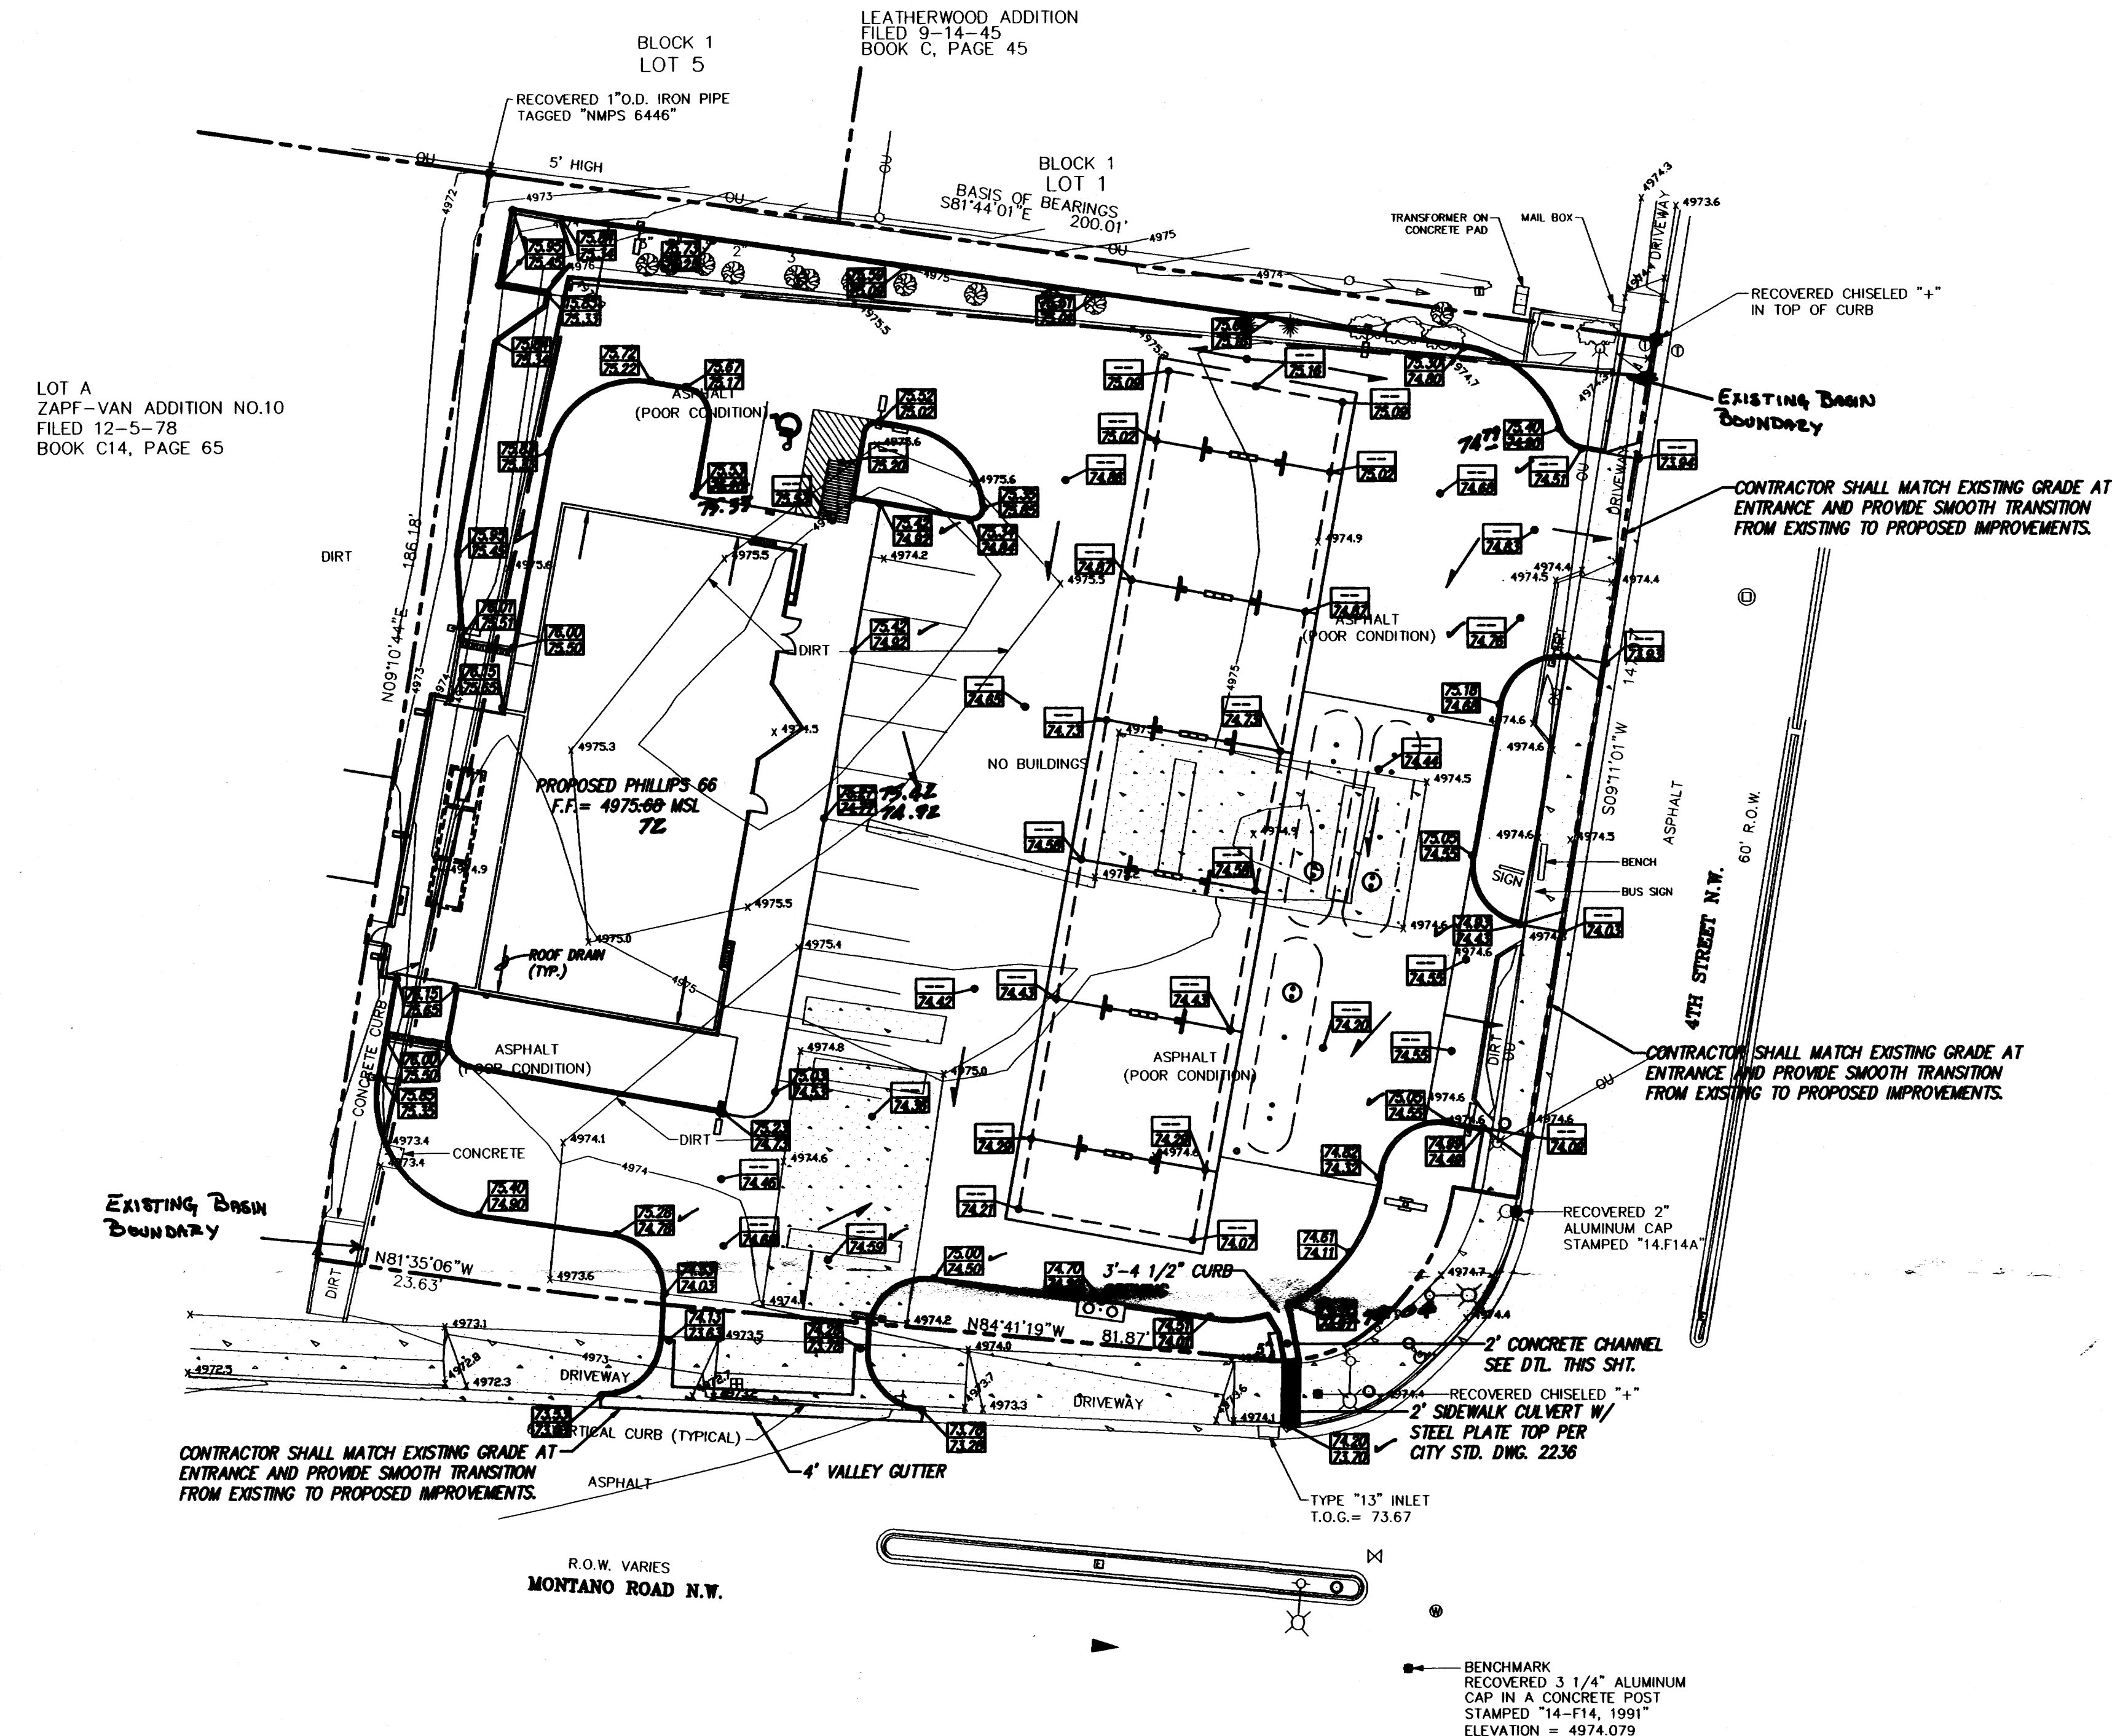

## 3. WEIR SIZING

Q = CWH<sup>3/2</sup>  
Q = 3.49 cfs  
C = 2.9  
H = 0.5  
LENGTH REQUIRED  
L = Q/C H<sup>3/2</sup>  
L = 3.40' = 3'-4 1/2"

## 4. 2' CONCRETE CHANNEL TO CONVEY

DEVELOPED FLOW  
Q = 1.49 CFS  
A = 1.01 ft<sup>2</sup>  
R<sub>h</sub> = 0.333 ft  
S = 1.5%  
Q = 6.75 cfs. CAPACITY  
PROPOSED CONDITIONS  
Q = 3.49 cfs  
FLOW DEPTH = 0.32'  
CHANNEL IS CAPABLE OF CONVEYING  
DEVELOPED FLOW.

## 5. EXISTING SITE CURRENTLY




DISCHARGES Q = 3.49 cfs  
PROPOSED IMPROVEMENTS GENERATE  
Q = 3.82 cfs OF DEVELOPED FLOW.  
WEIR IS SIZED TO DISCHARGE Q = 3.49 cfs  
RETAINED FLOW AND VOLUME.  
Q = 0.33 cfs AND V = 788 ft<sup>3</sup> RESPECTIVELY.  
WILL POND AND ROUTE THROUGH PARKING LOT  
AT SOUTHEAST CORNER TO DISCHARGE INTO  
EXISTING STORM INLET.

## DRAINAGE FACILITIES WITHIN CITY RIGHT OF WAY

Design Approval	HYDROLOGY SECTION	DATE
Inspection Approval	CONSTRUCTION SECTION	DATE
Acceptance	CONSTRUCTION/SECTION/PERMITS	DATE


NOTICE TO CONTRACTOR  
1. An excavation/construction permit will be required before beginning any work within City right of way. An approved copy of these plans must be submitted at the time of application for this permit.  
2. All work detailed on these plans to be performed, except as otherwise stated or provided herein, shall be constructed in accordance with "City of Albuquerque Standard Specifications for Public Works Construction" (1986 Edition).  
3. Two working days prior to any excavation, Contractor must contact the Line Locating Service, 785-1234, for location of existing utilities.  
4. Prior to construction, the Contractor shall excavate and verify the horizontal and vertical locations of all obstructions. Should a conflict exist, the Contractor shall notify the Engineer so that the conflict can be resolved with a minimum of delay.  
5. Backfill compaction shall be according to residential street use.  
6. Maintenance of these facilities shall be the responsibility of the Owner of the property served.  
7. Contractor is responsible for obtaining excavation permit for the S.O. 19 and providing proof of acceptance by the City prior to hydrology sign-off for Certificate of Occupancy.

I hereby certify that the information contained on this drawing has been revised in accordance with information furnished by the contractor, Fluor Daniels, Inc. and by the surveyor, Southwest Surveying, and reflects the construction as actually accomplished. This plan as constructed is in substantial compliance with the Approved Plan.  
Mark Goodwin NMPE 8948

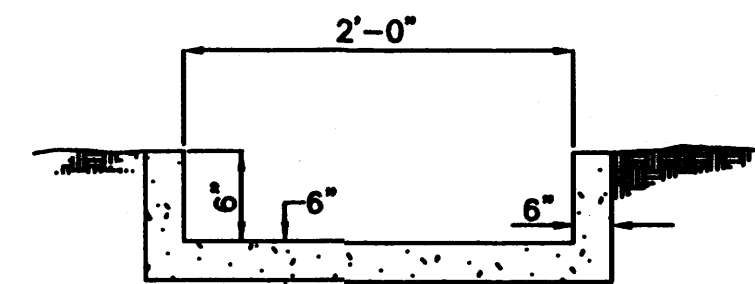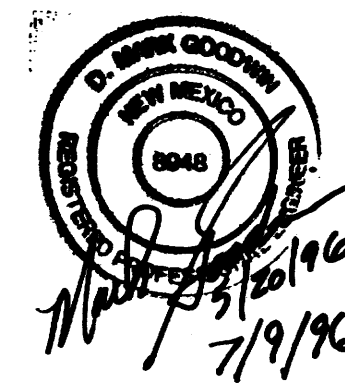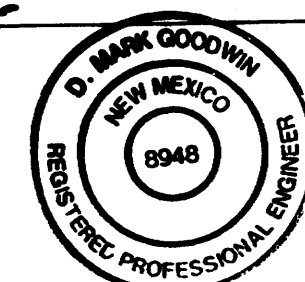


CONCRETE CHANNEL DETAIL

N.T.S.

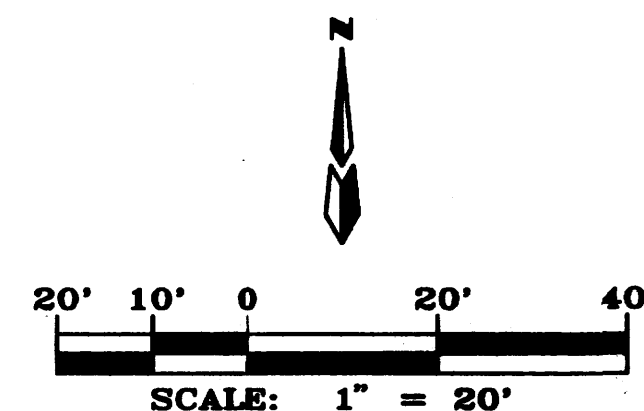

SCALE: 1" = 20'

PH66-4TH-MON-05-20-96

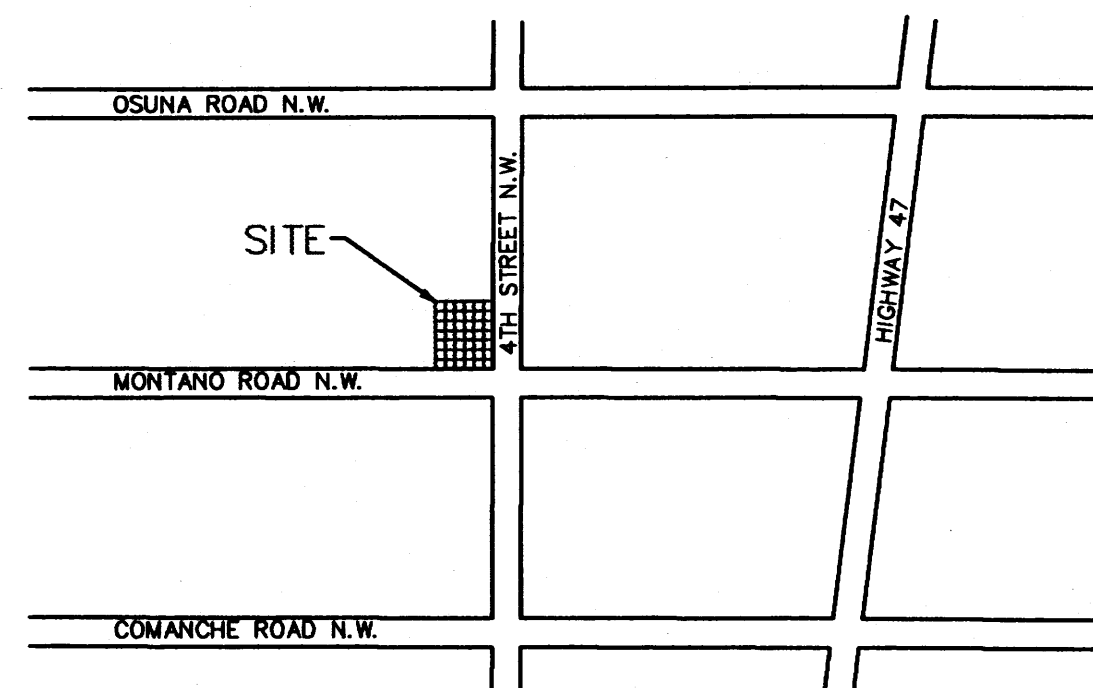

NOT TO SCALE

VICINITY MAP

ZONE MAP: F-14

## ACS BENCHMARK

RECOVERED 3 1/4" ALUMINUM CAP IN A CONCRETE POST STAMPED "14-F14, 1991"  
ELEVATION = 4974.079

## LEGAL DESCRIPTION

LOT 1-A, ZAPF-VAN ADDITION NO.10, RECORDED IN BOOK 91G, PAGE 100  
CITY OF ALBUQUERQUE, COUNTY OF BERNALILLO, STATE OF NEW MEXICO.

## LEGEND

- PROPERTY LINE
- 0- EXISTING CONTOUR
- + 2050 EXISTING SPOT ELEVATION
- As-Built PROPOSED SPOT ELEVATION
- FLOW ARROW, ROOF DRAIN (TYP)

## PROJECT DESCRIPTION

The site is currently an asphalted vacant lot, where the existing storm runoff drains overland into 4th Street and Montano Boulevard. The drainage management plan for the proposed fully developed improvements is to discharge the historical flow through a controlled outlet, concrete channel, into an existing storm inlet in 4th Street. AHYMO was used and fully developed conditions were assumed to calculate and obtain the developed flows.

PHILLIPS 66 - 4th ST. N.W. &amp; MONTANO RD. N.W.

## GRADING &amp; DRAINAGE PLAN

dmg D. MARK GOODWIN & ASSOCIATES, P.A.  
CONSULTING ENGINEERS & SURVEYORS  
P.O. BOX 90606  
ALBUQUERQUE, NEW MEXICO 87199  
(505) 345-2010

Designed: RMJ	Drawn: JMB	Checked: DMG	Sheet 1 of 1
Scale: 1"=20'	Date: 05/96	Job: 96046	