





F.E.M.A. MAP #350002-0015 C

NO SCALE

VALVE SHUT-OFF PLAN

VALVE NUMBERS TO SHUT-OFF:
552, 553 & 551

ACS BRASS CAP
"NM 47-9"
NMSPC
Y=1,503,544.63
X=383,830.72
Δα=-0°13'25"
G-G=0.99967 69
CENTRAL ZONE
EL=4972.038

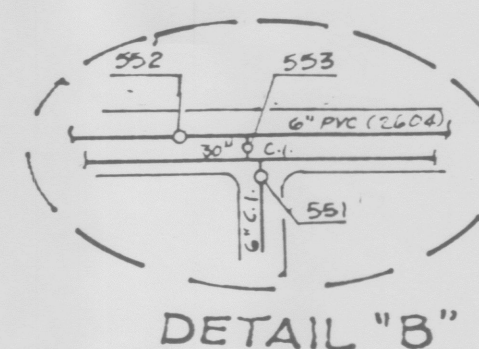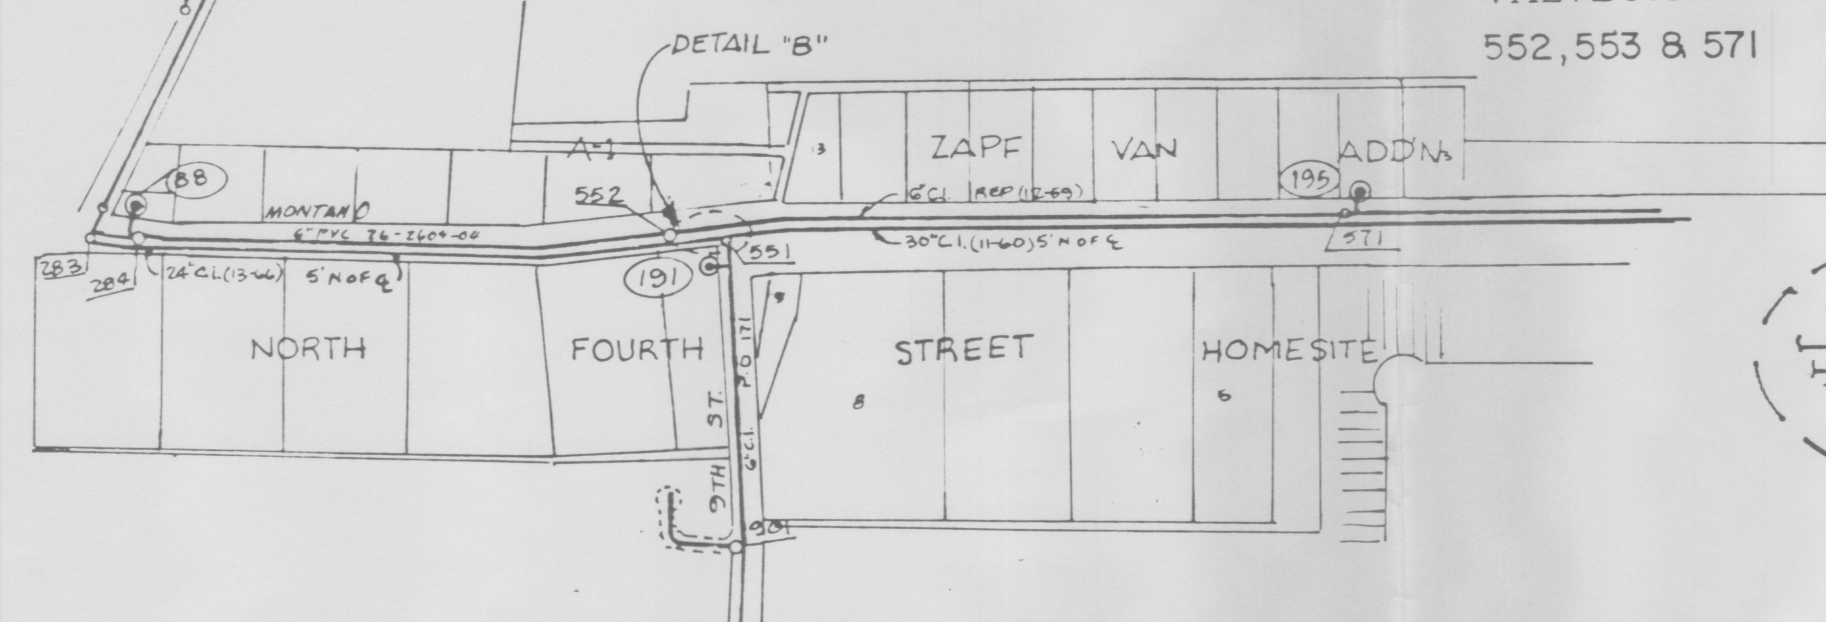

RECORD DRAWING

DATE: 1-21-94 DRAFTER: J.B.


DATE: 9-21-94 SUPERVISOR: BSN SVEV.

THESE RECORD DRAWINGS HAVE BEEN PREPARED IN PART, ON THE BASIS OF INFORMATION COMPILED AND FURNISHED BY OTHERS. THE ENGINEER WILL NOT BE RESPONSIBLE FOR ANY ERRORS OR OMISSIONS WHICH HAVE BEEN INCORPORATED INTO THIS DOCUMENT AS A RESULT.

J.R. HALE CONT.

VICINITY MAP F-14-Z

NO SCALE

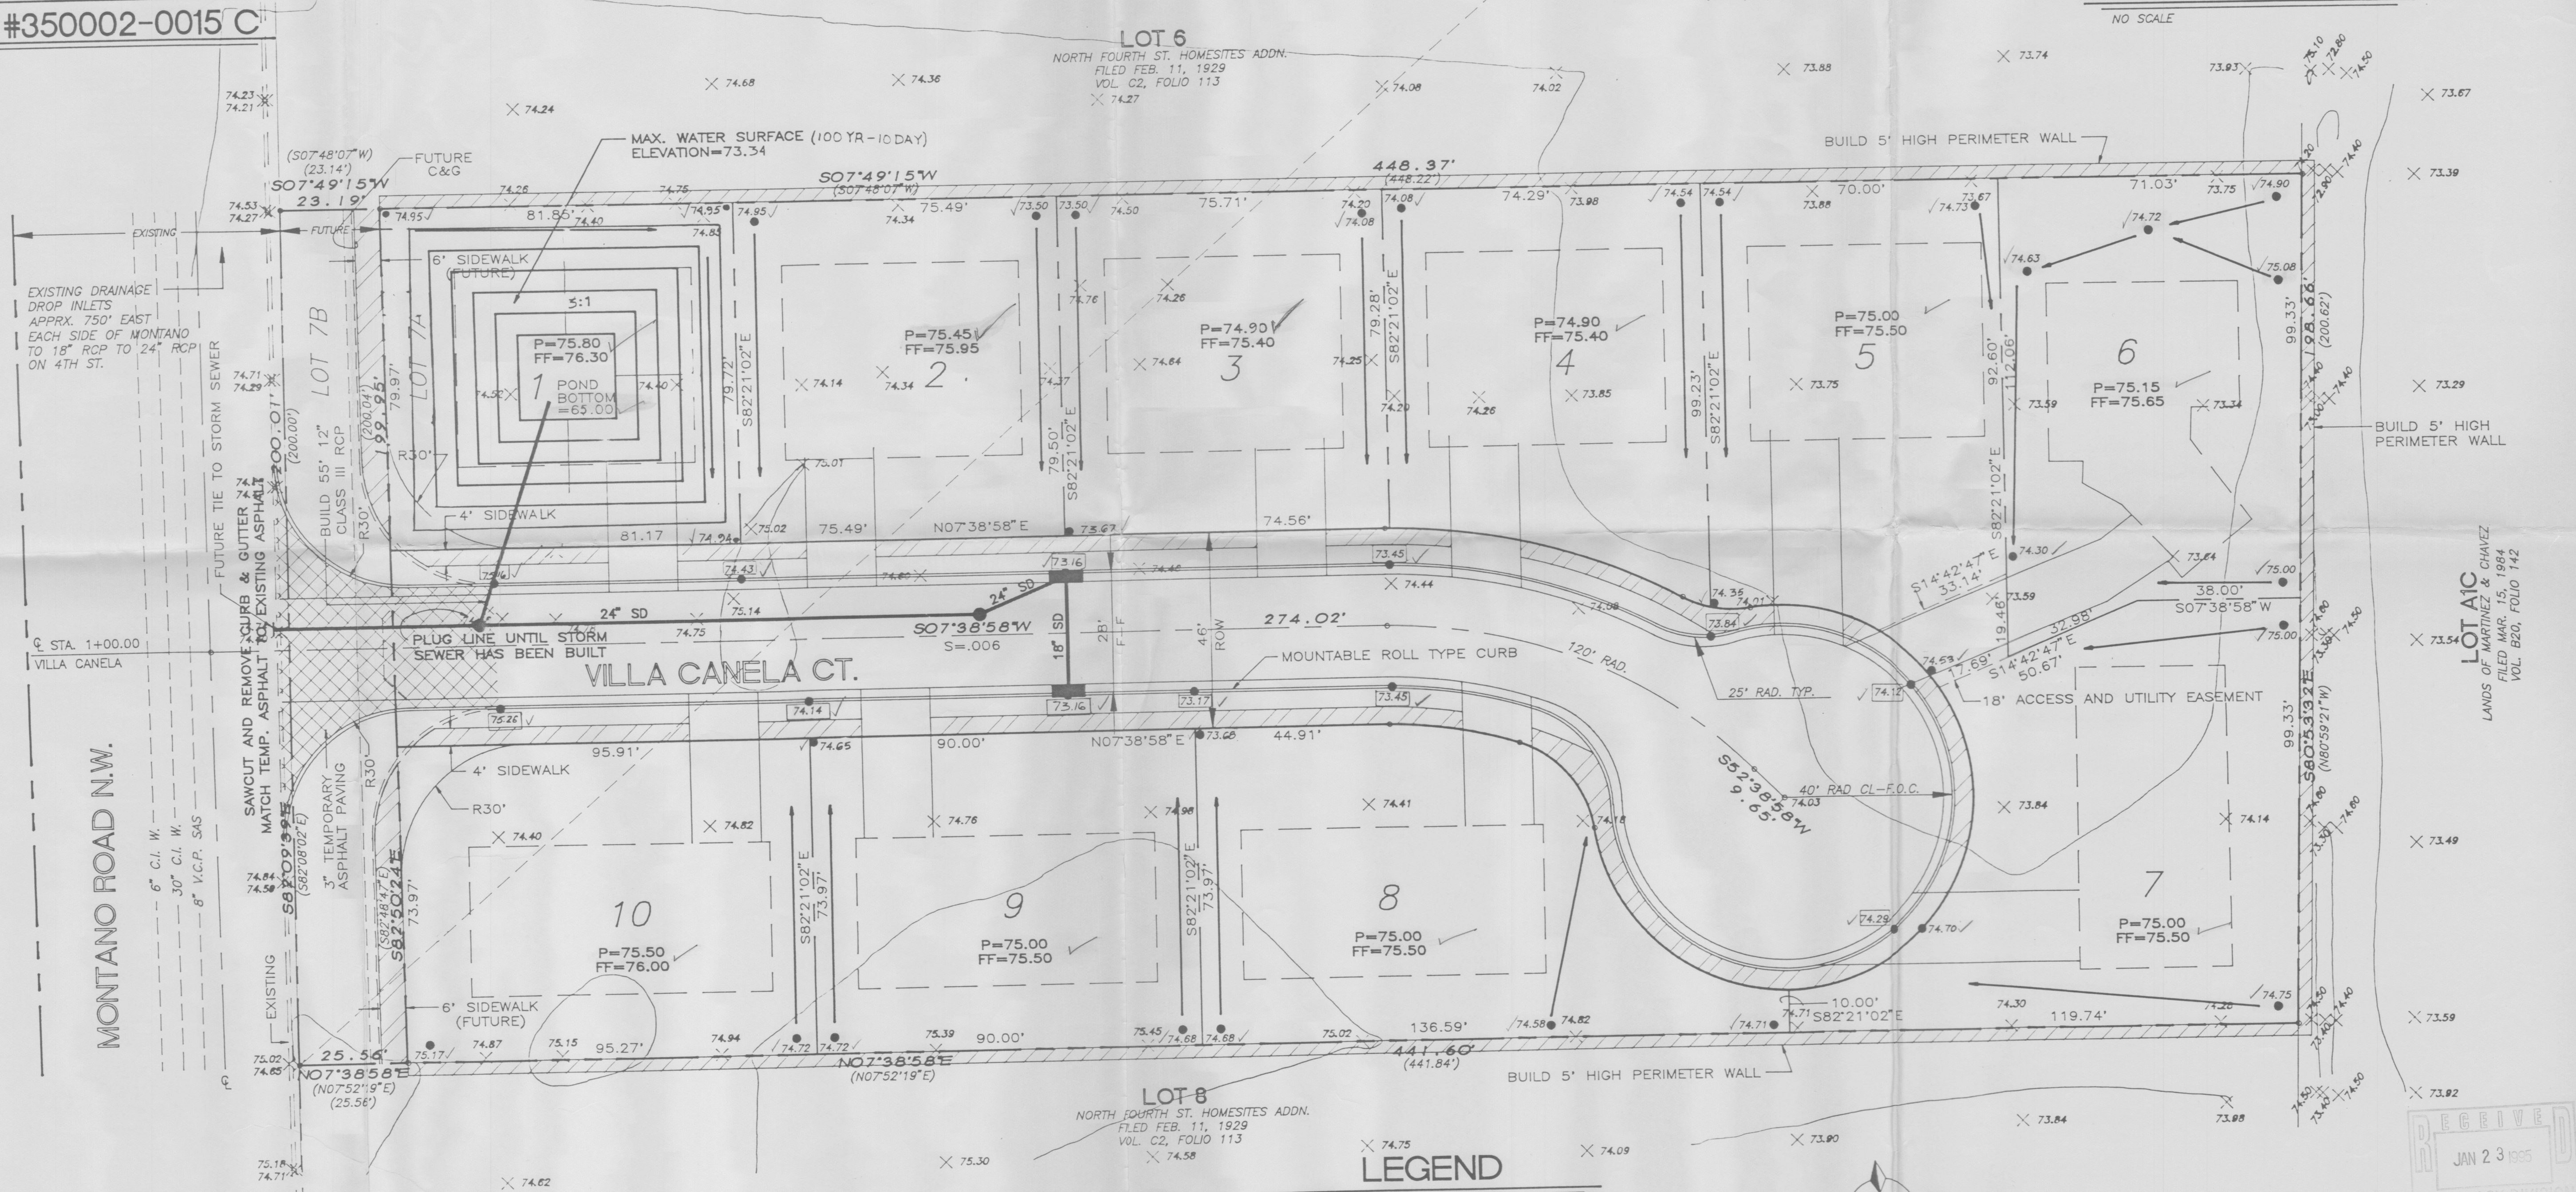

EXISTING DRAINAGE
DROP INLETS
APPRX. 750' EAST
EACH SIDE OF MONTANO
TO 18" RCP TO 24" RCP
ON 4TH ST.

Q STA. 1+00.00
VILLA CANELA

MONTANO ROAD N.W.

6" C.I. W.
30" C.I. W.
8" V.C.P. SAS

SAWCUT AND REMOVE CURB & GUTTER
MATCH TEMP. ASPHALT TO EXISTING ASPHALT

3" TEMPORARY
ASPHALT PAVING

PLUG LINE UNTIL STORM
SEWER HAS BEEN BUILT

4' SIDEWALK
(FUTURE)

6' SIDEWALK
(FUTURE)

5:1

P=75.80
FF=76.30

P=75.45
FF=75.95

P=74.90
FF=75.40

P=74.90
FF=75.40

P=75.00
FF=75.50

P=75.15
FF=75.65

P=75.00
FF=75.50

P=75.00
FF=75.50

GENERAL NOTE:

SPOTS ARE TOP OF CURB ELEVATIONS


GRADING PLAN

LOTS 7A & 7B


2.0464 ACRES
NORTH FOURTH ST. HOMESITES ADDN.
FILED FEB. 26, 1993
VOL. 93-C, FOLIO S1

LEGEND

- CENTER LINE
- PROPERTY LINE
- EASEMENT LINE
- BOUNDARY LINE
- BUILDING FOOTPRINT
- EXISTING CONTOUR
- PROPOSED CONTOUR
- EXISTING SPOT ELEVATION
- PROPOSED SPOT ELEVATION
- DIRECTION OF FLOW
- STORM DRAIN
- CATCH BASIN
- MANHOLE
- PERIMETER WALL
- SIDEWALK
- FLOW LINE ELEV.
- AS BUILT

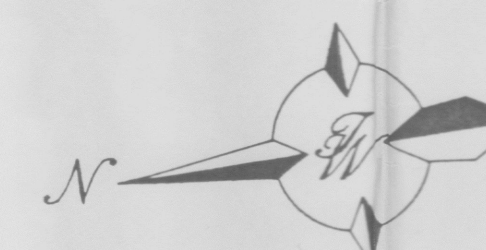

GRAPHIC SCALE

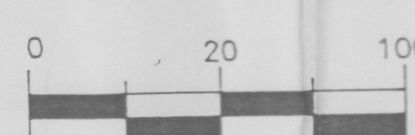


SCALE: 1"= 20.00'

0: 940002\ 9402GR.DWG\ PVC\ 4-12-94

I certify that the grades shown on the plans have been built in substantial accordance with these plans and specifications. September 21, 1994
Survey information was supplied by BSN Surveying in accordance with normal surveying practices.

Ronald R. Bohannon #7828

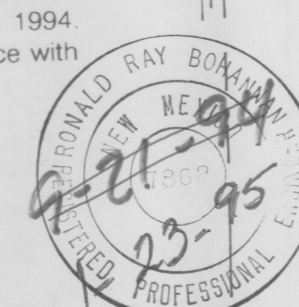

John P. Curtin 5-17-94
ROUGH GRADING APPROVAL

RECEIVED
JAN 23 1995
HYDROLOGY DIVISION

ENGINEER'S SEAL	GRADING PLAN	DRAWN BY NB
	SHELTER GROUP/LIVING QUARTERS	DATE 12/21/94
	LOTS 7A & 7B NORTH FOURTH STREET HOMESITES ADDITION ALBUQUERQUE, NEW MEXICO	9402GR.DWG
	TERRA WEST DEVELOPMENT MANAGEMENT SERVICES	SHEET # 3 OF 6
	4600 MONTGOMERY BLVD. N.E., SUITE 3 ALBUQUERQUE, NEW MEXICO 87109 (505)883-7592	JOB # 940002