



## PARKING CALCULATION

NON-CONFORMING SITE

AMOUNT OF PARKING SPACES NOT DICTATED ON A NON-COMFORMING SITE 2 are handicapped/ADA spaces

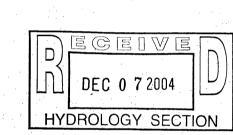

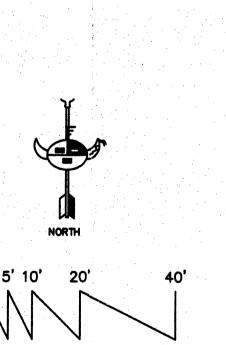

## TRAFFIC CIRCULATION PLAN

SYMBOL LEGEND PROPERTY LINE


DIRECTION OF TRAVEL

LEGAL DESCRIPTION:

LOTS 1-8 BLOCK 14 SANDIA PLAZA CITY OF ALBUQUERQUE BERNALILLO COUNTY


ABBREVIATION LEGEND
TOP OF CON. PAD - TCP
TOP OF CURB - TC
TOP OF ASPHALT - TA
FLOWLINE - FL
TOP OF WALL - TW
ROOF FLOWS - RF

TOP OF SIDEWALK

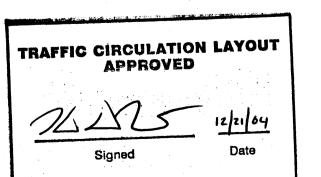

SCALE |"=20"

Public Infrastructure shown on these plans for information only and not part of approval. Separate DRC/Permit approval adn Work Order required.

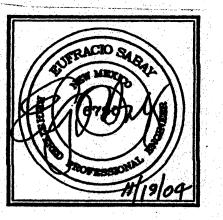



XXXXXXX

**NOVEMBER 2004** REVISIONS

**Popularistan paramena manamena** Visisistan in Saisistan in Saisistan

SHEET NO.

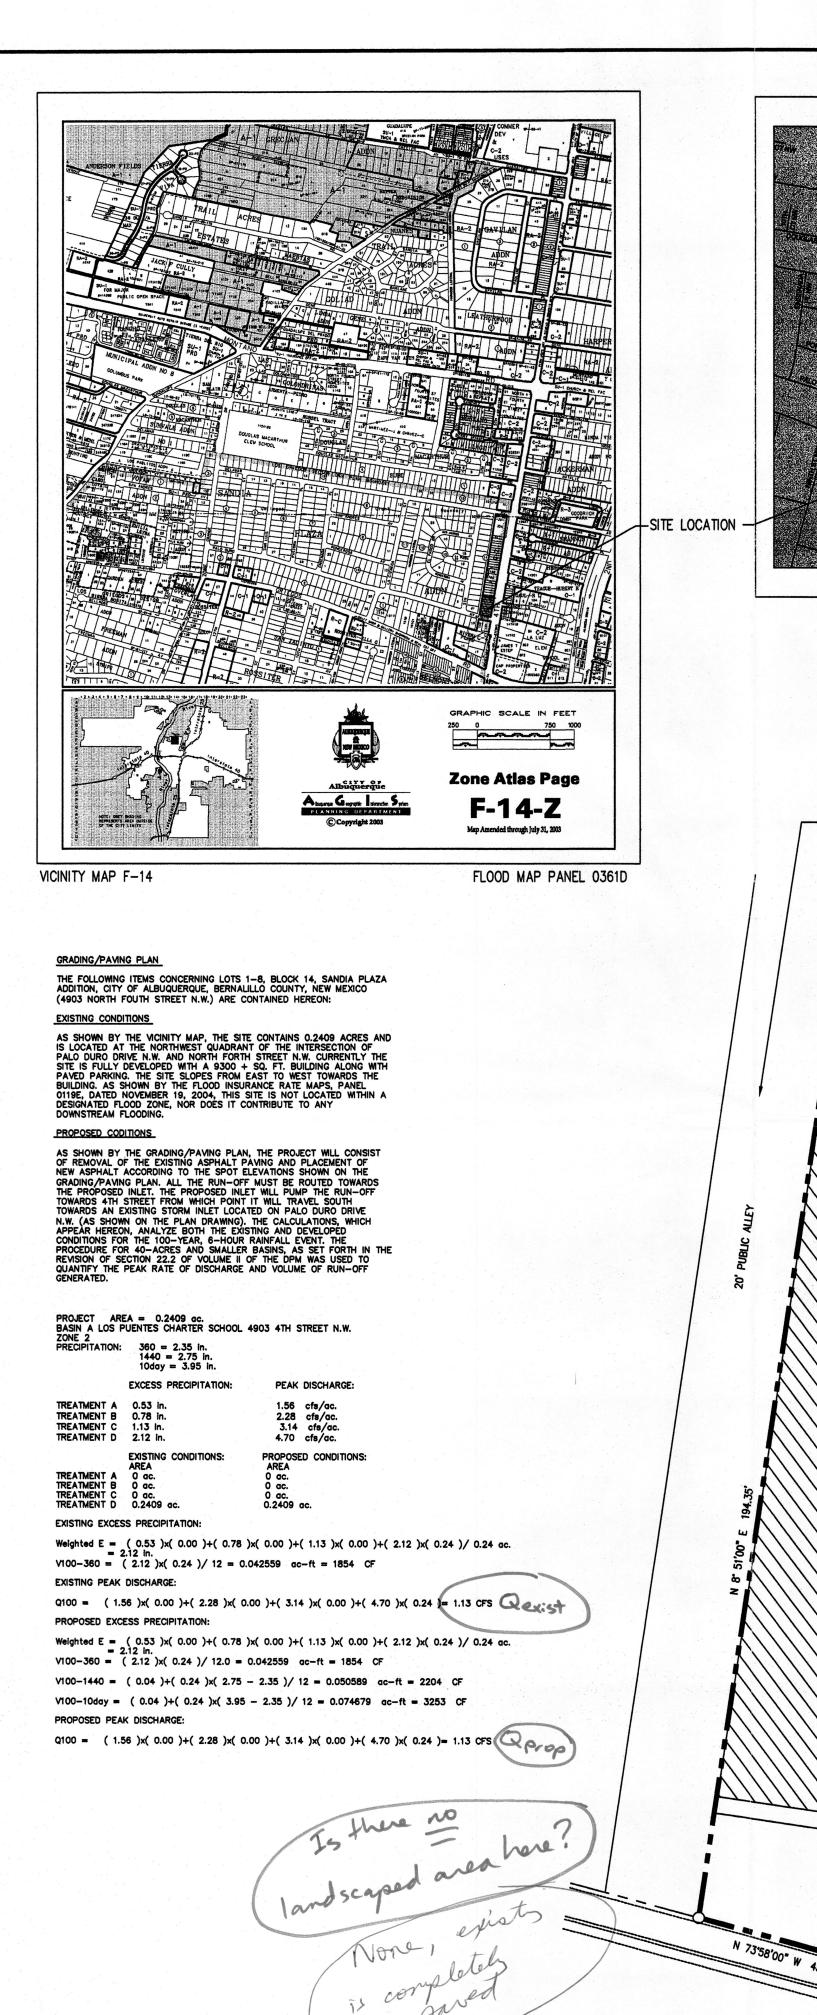

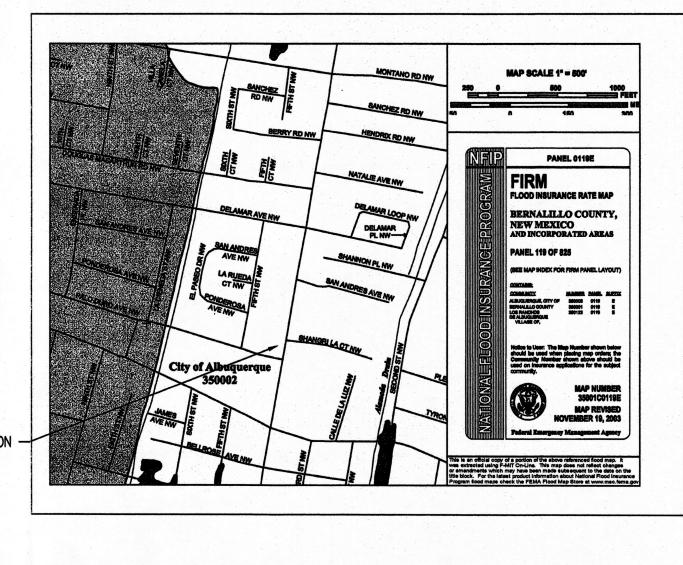

1. BUILDING ROOF DRAINS ALL TO THE ALLEY VIA DOWNSPOUTS 2. MAINTENANCE OF THE PUMP AND SAND TRAP IS IMPORTANT THIS IS THE ONLY SOLUTION THAT WILL WORK BECAUSE OF THE EXISTING FINISH FLOOR ELEVATION, NO LIABLITY TO THE ENGINEER IF THE PUMPS ARE TO FAIL FOR ANY REASON

(SEE DETAILS THIS SHEET) GRATE ELEV 69.90

5"PVC DRAIN

SANDIA PLAZA ADDITION

· 6'-0" SIDEWALK

-DAY LIGHT DRAIN LINE THROUGH CURB PER COA STD DWG 2235

-APPROX LOCATION OF

STREE.

ABBREVIATION LEGEND

TOP OF CON. PAD - TCP TOP OF CURB - TC TOP OF ASPHALT - TA FLOWLINE TOP OF WALL - TW

"ACS BM, 18-G14 EPOXIED ON TOP OF CONCRETE CURB CENTERED ON A DROP INLET NNW QUADRANT OF 4TH & GRIEGOS **ELEVATION: 4970.277** 

SCALE | "= 20"

LEGAL DESCRIPTION:

LOTS 1-8 BLOCK 14 SANDIA PLAZA CITY OF ALBUQUERQUE

EROSION CONTROL MEASURES

1. THE CONTRACTOR SHALL BE HELD RESPONSIBLE FOR MANAGEMENT OF STORM RUN-OFF DURING CONSTRUCTION, HE SHALL ASSURE THAT THE FOLLOWING MEASURES ARE

A. ADJACENT PROPERTY SHALL BE PROTECTED AT ALL TIMES BY TEMPORARY BERMS, DIKES, SWALES, AND OTHER TEMPORARY GRADING AS REQUIRED TO PREVENT STORM RUN-OFF FROM LEAVING THE SITE AND ENTERING ADJACENT PROPERTY.

B. ADJACENT PUBLIC RIGHT-OF-WAY SHALL BE PROTECTED AT ALL TIMES FROM STORM WATER RUN-OFF FROM THE SITE. NO SEDIMENT BEARING WATER SHALL BE PERMITTED TO ENTER THE PUBLIC STREETS.

2. THE CONTRACTOR SHALL IMMEDIATELY AND THOROUGHLY REMOVE ANY OR ALL SEDIMENT WITHIN THE PUBLIC STREETS THAT HAVE BEEN ERODED FROM THE SITE AND DEPOSITED THERE.

APPROVAL	NAME	DATE	TITLE: HOGARES CHARTER SCHOOL
INSPECTOR			
			MAP NUMBER: F14

#### NOTICE TO CONTRACTOR

An excavation/construction permit will be required before beginning any work within the City right—of—way. Approved copy of this plan must be submitted at the time of application for permit.

All work detailed in this plan to be performed, except as otherwise stated or provided hereon, shall be constructed in accordance with City of Albuquerque Standard Specification for Public Works 3. Construction.


Two working days prior to any excavation, contractor must contact 4. line locating Services for locating existing utilities, (260-1990).


Prior to construction, the contractor shall excavate and verify the horizonal and vertical location of all construction. Should a

5. conflict exist, the contractor shall notify the engineer so that 6. the conflict can be resolved with a minimum amount of delay. Backfill compaction shall be according to Commercial use.

7. All work on this project shall be performed in accordance with applicable Federal, State and local laws, rules and regulations concerning construction safty and health.

Maintenance of this facilities shall be the responsibility of the owner of the property served.

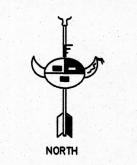

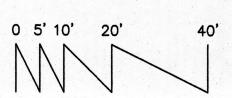

# GRADING/DRAINAGE PLAN

SYMBOL LEGEND

EXISTING CONTOUR PROPOSED CONTOUR EXISTING SPOT ELEVATION

PROPERTY LINE EASEMENT LINE

EXISTING SPOT ELEVATION DOWN SPOUT

NEW SPOT ELEVATION

FLOW DIRECTION

+46.0


<del>------</del> 4970 <del>-----</del>

TOP OF GRATE - TG TOP OF SIDEWALK - TSW

### BENCHMARK:

TOP OF IRON PIPE SHOWN ON PLAN **ELEVATION: 4973.45** 


BERNALILLO COUNTY

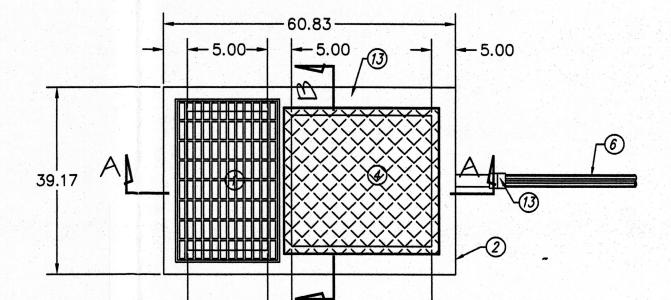

SUMP PUMP STATION PLAN

16.67 - 29.17 ---


SCALE 1/2"=1'-0"

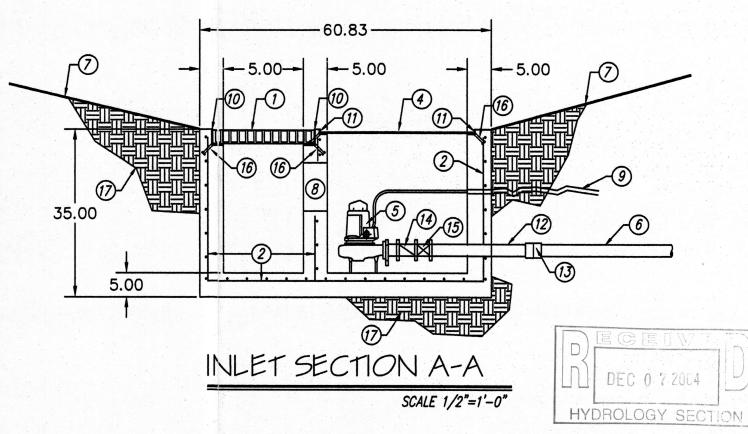

STATIC LIFT: 0 FT. TO 2.2 FT. (POND LEVEL VARIATION) TOTAL EQUIVALENT FEET OF DISCHARGE PIPE = 664' DISCHARGE RATE = 60 gpm (EVACUATION IN 21.0± hrs) SYSTEM HEAD LOSS = 17.0' TOTAL DYNAMIC LOSS = 17.0' TO 19.2'

PUMP SELECTION TO OPERATE BETWEEN 60 gpm AND 65 gpm (APPROX)

AUTOMATED CONTROLS: FLOAT LEVEL SENSORS AND CONTROL PANEL SUPPLIED BY PUMP SUPPLIER.

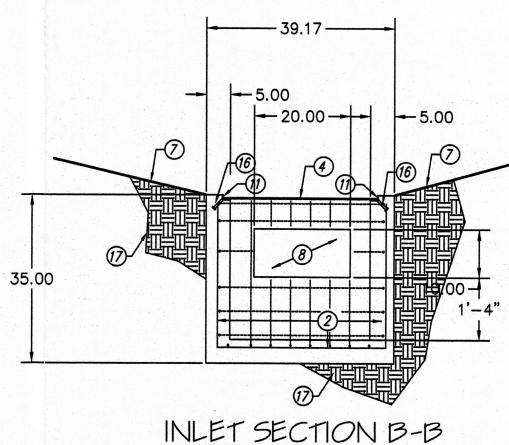

KEYED NOTES:

GRATE PER COA STD DGE 2220(SEE DRAINAGE PLAN FOR GRATE ELEVATION)

SCALE 1/2"=1'-0"

#4 RE-BAR(SCH 40) 6" EACH-WAY

6" 4000# CONCRETE PAD & WALLS

1/4" DIAMOND STEEL PLATE

SUMP PUMP (FLYGT MODEL DF3067, IMP 474, 1-PHASE,115 VOLTS O.A.E.) 2.5" PVC(SCH 40) FORCE MAIN- SEE DRAINAGE PLAN FOR POINT OF DISCHARGE

SLOPE GRADE TO INLET GRATE

OPENING TO ALLOW FLOW CENTER ON PARTITION

18" MIN COVER IN TRAFFIC AREA

FLOAT CONTROL & POWER SUPPLY CONDUIT SEAL WATER TIGHT

4"x3" x 1/4" ANGLE

1"x2"x1/4" ANGEL

2.5"GALV PIPE

TRANSITION COUPLING (FLEXIBLE)DRESSER O.A.E.

CHECK VALVE

GATE VALVE

1/2"x3" BOLT WITH SQ HEAD WELDED TO ANGLE(1 ON ALL SIDES)

COMPACTED EARTH



XXXXXXX NOVEMBER 2004 REVISIONS

PAVING

SHEET NO. 5